


MATCHLINE STA 182+00.00
SEE DWG No. C17

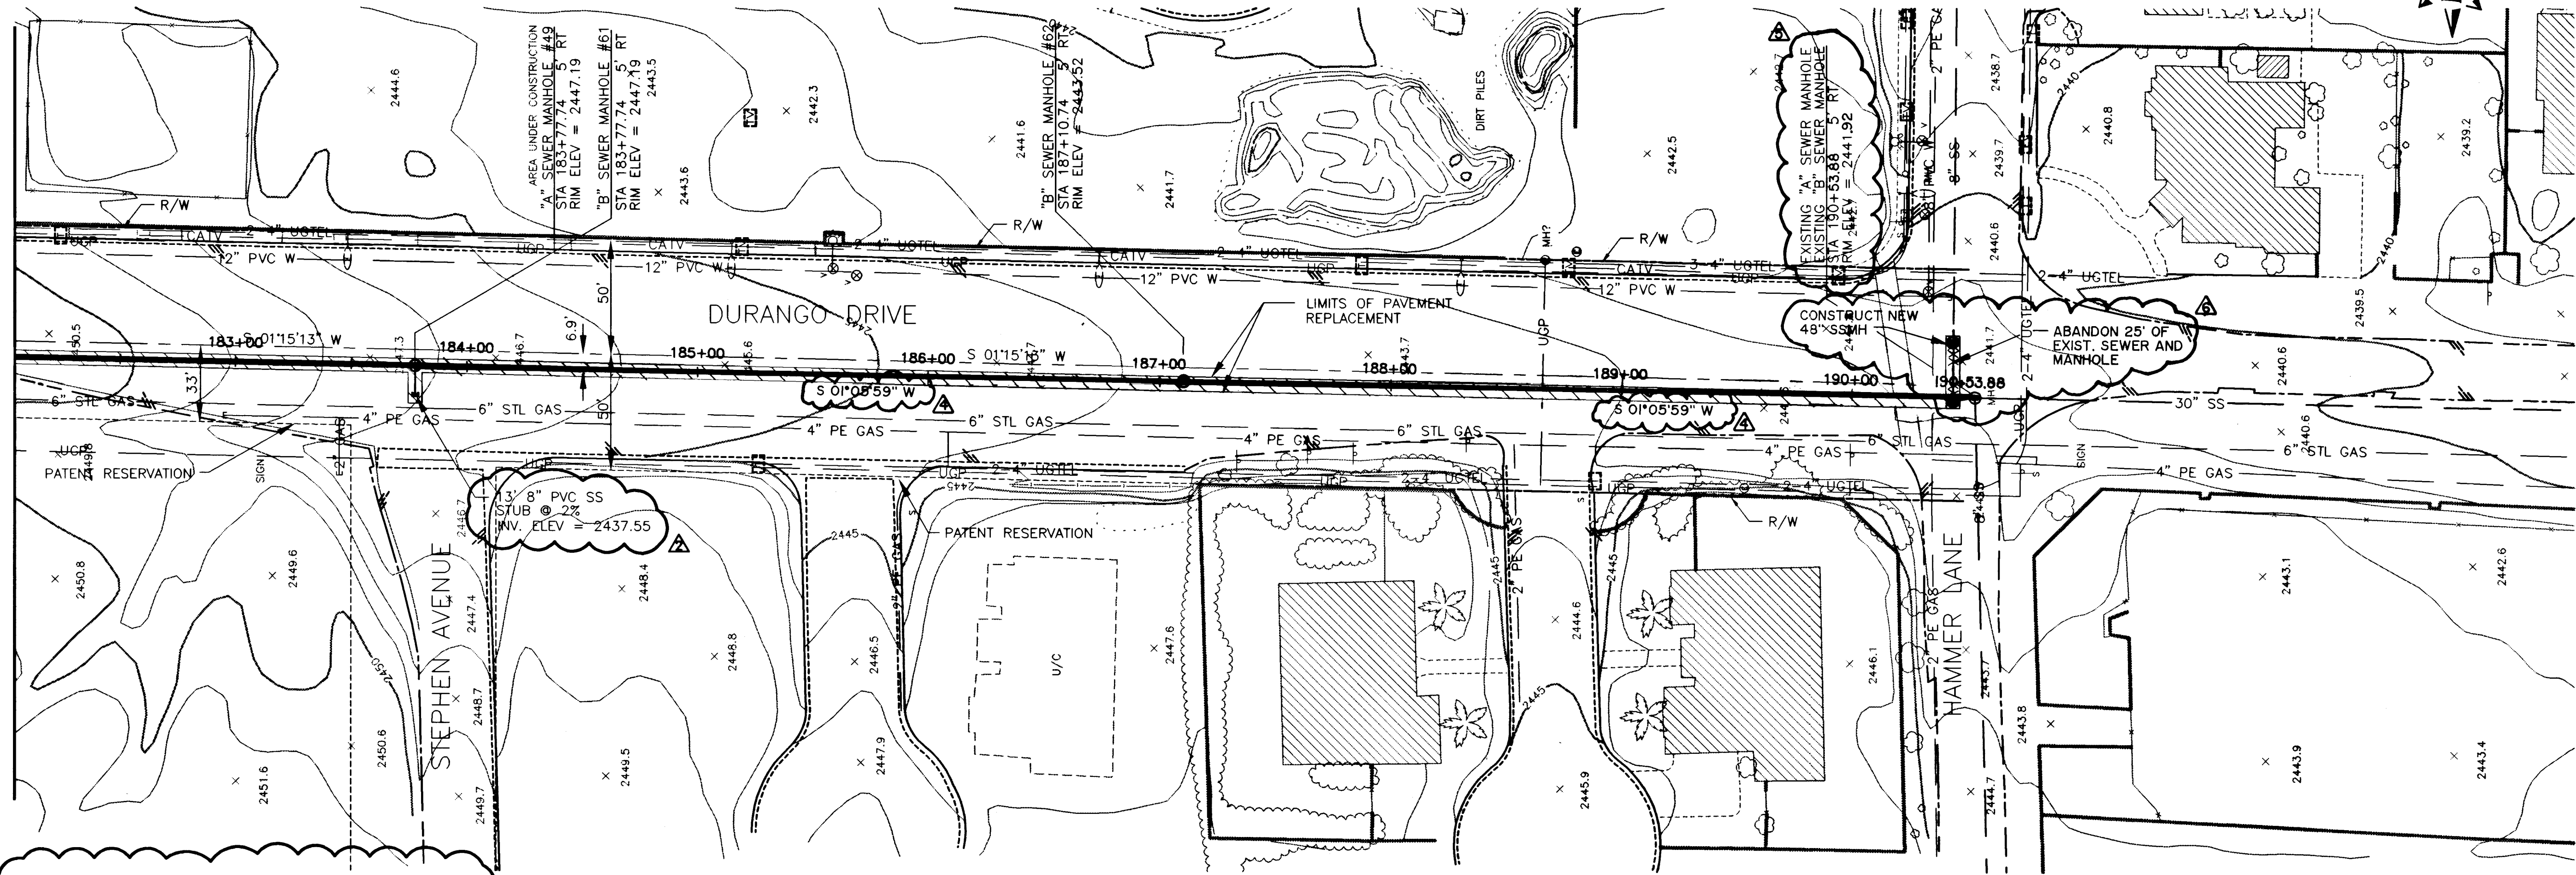

SANITARY SEWER ALTERNATIVES

- ALT "A" - 8" SEWER STA 1+03.75 TO STA 18+80.47
- 10" SEWER STA 18+80.47 TO STA 98+90.83
- 27" SEWER STA 98+90.83 TO STA 125+20.39
- 30" SEWER STA 125+20.39 TO STA 156+66.01
- 36" SEWER STA 156+66.01 TO STA 190+44.26
- ALT "B" - 8" SEWER STA 1+03.75 TO STA 190+44.26
(FOR BIDDING PURPOSES ONLY)


NOTE:

ALL EXISTING UTILITY LOCATIONS SHOWN HEREON ARE APPROXIMATE ONLY. IT SHALL BE THE CONTRACTOR'S RESPONSIBILITY TO DETERMINE THE EXACT VERTICAL AND HORIZONTAL LOCATION OF ALL EXISTING UNDERGROUND UTILITIES PRIOR TO CONSTRUCTION AND RELOCATE THESE UTILITIES AS NECESSARY. NO REPRESENTATION IS MADE THAT ALL UTILITIES ARE SHOWN HEREON. THE ENGINEER ASSUMES NO LIABILITY FOR UTILITIES NOT SHOWN OR UTILITIES NOT SHOWN IN THEIR PROPER LOCATIONS.

SCALE: HORIZ. 1"=40'
VERT. 1"=4'


Call before you Dig
1-800-227-2600

MATCHLINE STA 182+00.00
SEE DWG No. C17

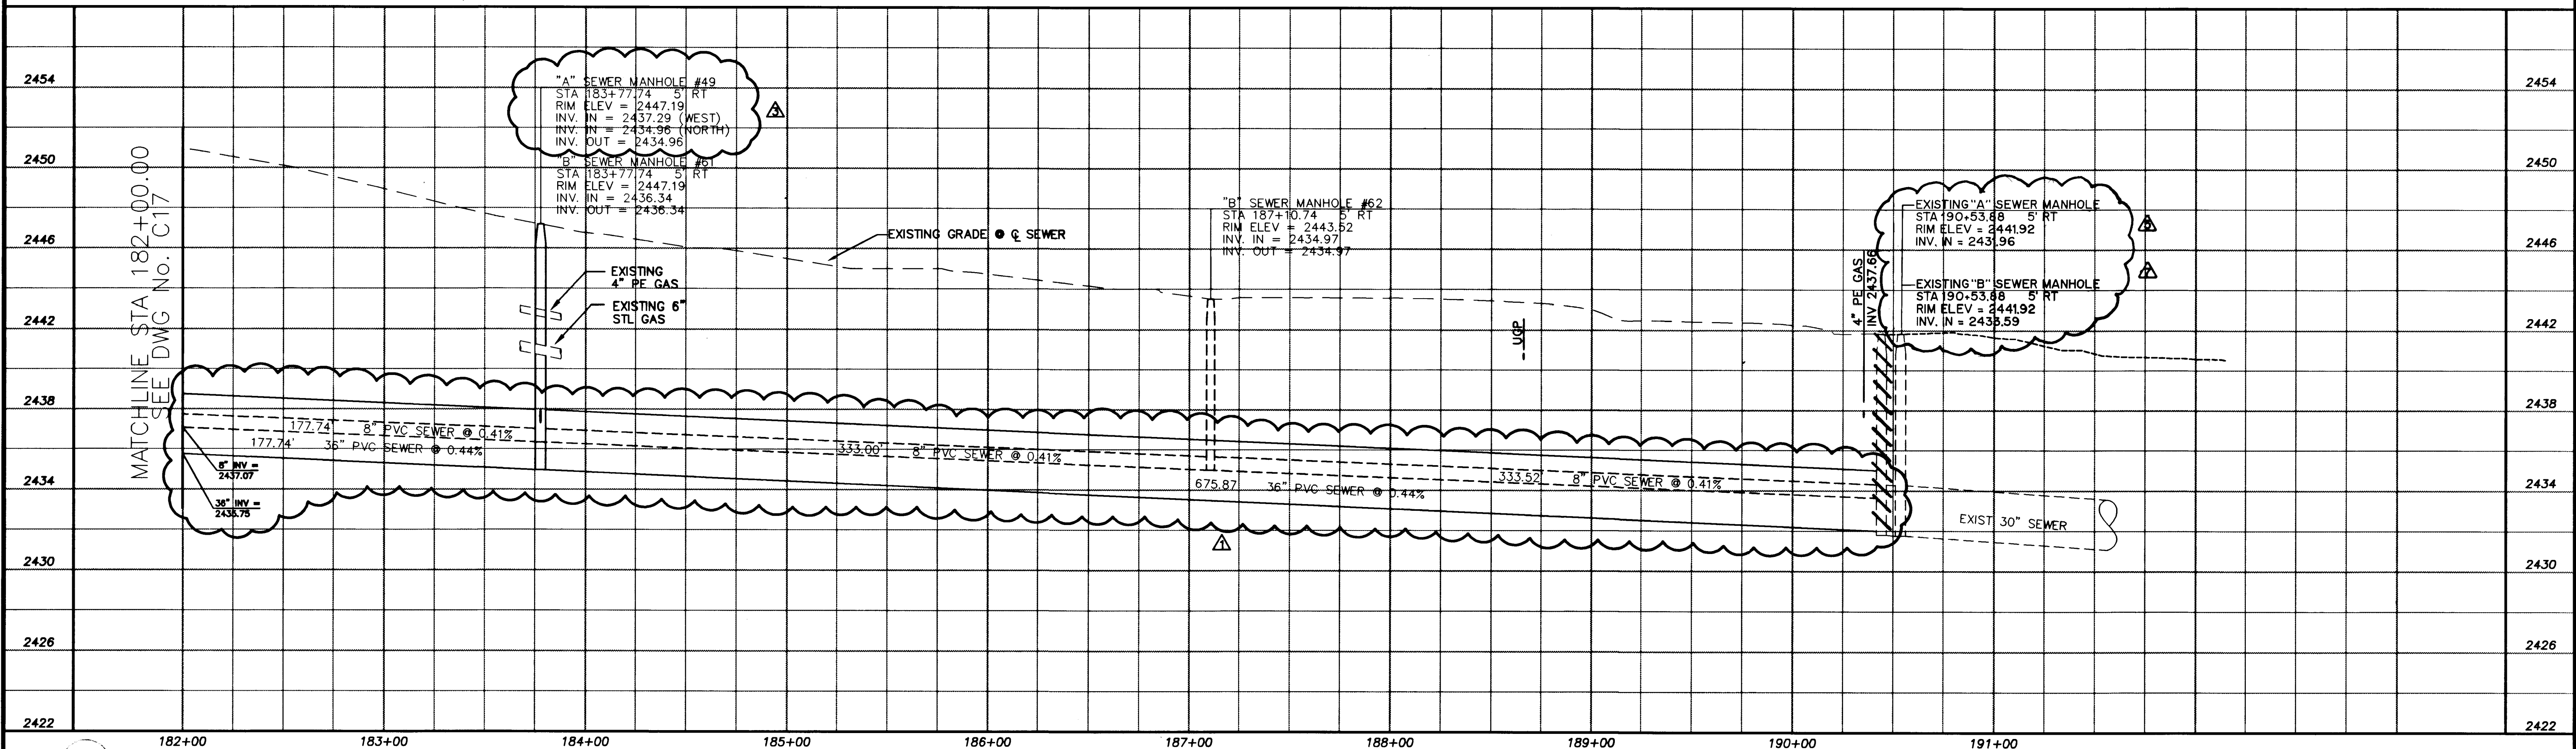

NO.	DATE	DESCRIPTION
1	1/8/99	Address Change from 152 to 153 Main Street
2	1/8/99	Changed Inv. in Elev. from "A" 2432.00, "B" 2433.83 to "A" 2431.96, "B" 2433.99
3	10/7/98	Changed Box Size from 33" to 36"
4	10/7/98	Discussed Box Invert Elevation
5	10/7/98	Changed Invert from 2432.30 to 2437.05
6	1/8/99	Changed Box Size from 36" to 48"
7	1/8/99	Changed Box Size from 36" to 48"
8	1/8/99	Changed Box Size from 36" to 48"
9	1/8/99	Changed Box Size from 36" to 48"
10	1/8/99	Changed Box Size from 36" to 48"

DURANGO INTERCEPTOR SEWER
 DRAWN BY: J. ARROYO
 DESIGNED BY: J. LUSTIG
 CHECKED BY: L. ATWELL
 DATE: 8-31-98
 JOB NO.: 51449
 801 N. Green Valley Rd.
 Suite 300
 Henderson, NV 89015-7074
 Telephone: 702/263-7274
 Facsimile: 702/263-7260

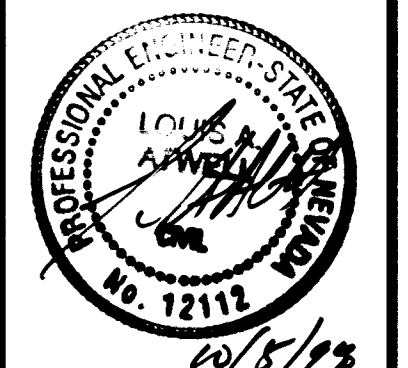


Department of Public Works
**DURANGO INTERCEPTOR SEWER
 PLAN AND PROFILE**
 STA 182+00.00 TO STA 190+44.26



DRAWING No. 23
 C18


MATCHLINE STA. 182+00.00
SEE Dwg. No. C-7

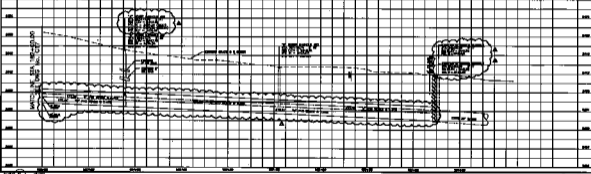

MATCHLINE STA. 182+00.00
SEE Dwg. No. C-7

SPECIAL NOTES & CONDITIONS	
1.	SEE SPECIFICATIONS FOR MATERIALS AND METHODS OF CONSTRUCTION.
2.	ALL DIMENSIONS ARE TO CENTERLINE UNLESS OTHERWISE NOTED.
3.	ALL ELEVATIONS ARE TO MEAN SEA LEVEL UNLESS OTHERWISE NOTED.
4.	ALL DISTANCES ARE TO CENTERLINE UNLESS OTHERWISE NOTED.
5.	ALL ANGLES ARE TO BE SHOWN BY DIMENSION LINES.
6.	ALL CURVES ARE TO BE SHOWN BY DIMENSION LINES.
7.	ALL TANGENTS ARE TO BE SHOWN BY DIMENSION LINES.
8.	ALL RADIUS ARE TO BE SHOWN BY DIMENSION LINES.
9.	ALL CHORDS ARE TO BE SHOWN BY DIMENSION LINES.
10.	ALL CHORDS ARE TO BE SHOWN BY DIMENSION LINES.
11.	ALL CHORDS ARE TO BE SHOWN BY DIMENSION LINES.
12.	ALL CHORDS ARE TO BE SHOWN BY DIMENSION LINES.
13.	ALL CHORDS ARE TO BE SHOWN BY DIMENSION LINES.
14.	ALL CHORDS ARE TO BE SHOWN BY DIMENSION LINES.
15.	ALL CHORDS ARE TO BE SHOWN BY DIMENSION LINES.
16.	ALL CHORDS ARE TO BE SHOWN BY DIMENSION LINES.
17.	ALL CHORDS ARE TO BE SHOWN BY DIMENSION LINES.
18.	ALL CHORDS ARE TO BE SHOWN BY DIMENSION LINES.
19.	ALL CHORDS ARE TO BE SHOWN BY DIMENSION LINES.
20.	ALL CHORDS ARE TO BE SHOWN BY DIMENSION LINES.

ALL DIMENSIONS ARE TO CENTERLINE UNLESS OTHERWISE NOTED.
ALL ELEVATIONS ARE TO MEAN SEA LEVEL UNLESS OTHERWISE NOTED.
ALL DISTANCES ARE TO CENTERLINE UNLESS OTHERWISE NOTED.
ALL ANGLES ARE TO BE SHOWN BY DIMENSION LINES.
ALL CURVES ARE TO BE SHOWN BY DIMENSION LINES.
ALL TANGENTS ARE TO BE SHOWN BY DIMENSION LINES.
ALL RADIUS ARE TO BE SHOWN BY DIMENSION LINES.
ALL CHORDS ARE TO BE SHOWN BY DIMENSION LINES.

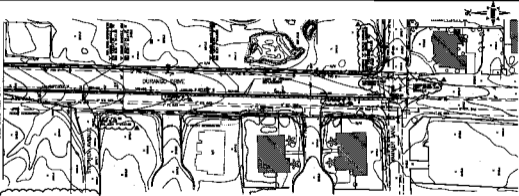

Department of Public Works
DURANGO INTERCEPTOR SEWER
PLAN AND PROFILE
STA 182+00.00 TO STA 190+44.28



REVISIONS	
NO.	DATE
1	10/1/00
2	10/1/00
3	10/1/00
4	10/1/00
5	10/1/00
6	10/1/00
7	10/1/00
8	10/1/00
9	10/1/00
10	10/1/00