


SHEET INDEX

- COVER SHEET
- PLAN & PROFILE FROM STA. 7+00 TO STA. 10+00
- PLAN & PROFILE FROM STA. 10+00 TO STA. 20+00
- PLAN & PROFILE FROM STA. 20+00 TO STA. 41+00
- PLAN & PROFILE FROM STA. 41+00 TO STA. 63+00
- PLAN & PROFILE FROM STA. 63+00 TO STA. 66+00
- PLAN & PROFILE FROM STA. 66+00 TO STA. 75+00
- PLAN & PROFILE FROM STA. 75+00 TO STA. 87+00
- PLAN & PROFILE FROM STA. 4+71.75 TO STA. 10+18.05
- PLAN & PROFILE FROM STA. 10+18.05 TO STA. 21+10.85
- PLAN & PROFILE FROM STA. 21+10.85 TO STA. 28+78.04

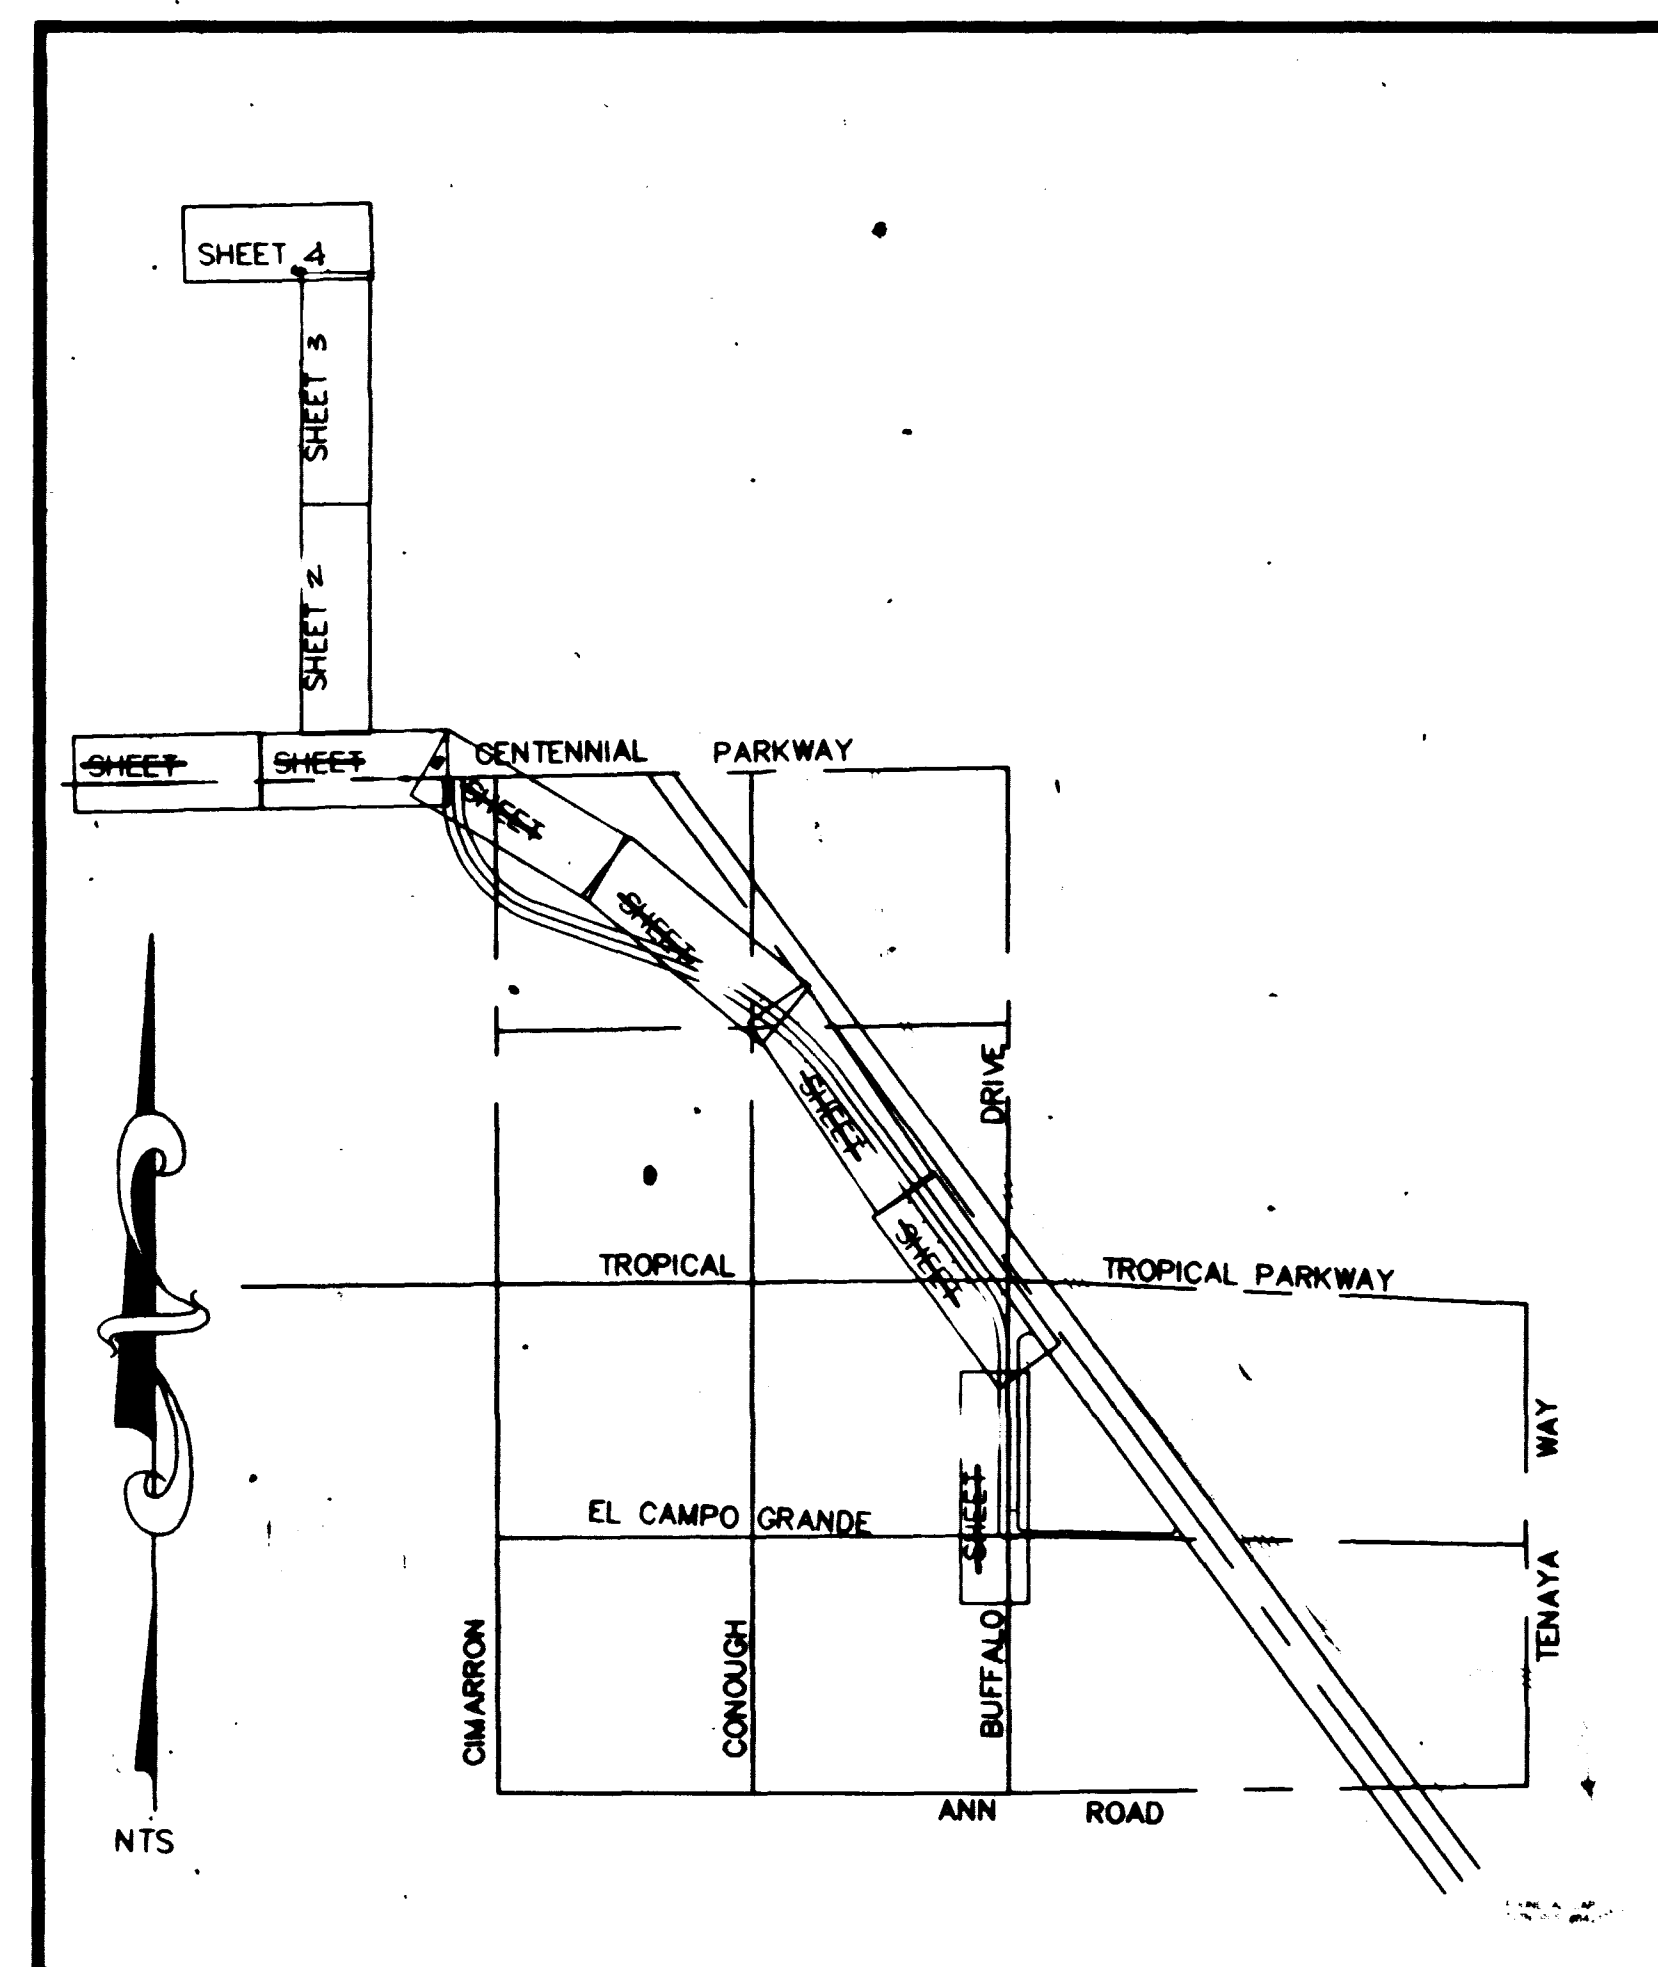

KEY MAP

BASIS OF BEARINGS

SOUTH 89°53'1" WEST, BEING THE SOUTH LINE OF THE SOUTHWEST QUARTER (SW 1/4) OF SECTION 21, T. 18 S., R. 40 E., M.D.M., CLARK COUNTY, NEVADA, COINCIDENT WITH THE CENTERLINE OF CENTENNIAL PARKWAY, AS SHOWN ON THAT CERTAIN MAP ON FILE IN THE OFFICE OF THE COUNTY RECORDER IN FILE 51 OF PARCEL MAPS AT PAGE 28.

BENCHMARK

CLARK COUNTY BM # 0090 - 219188

IRVET AND SQUARE ALUMINUM PLATE IN TOP OF CENTER OF HEAD WALL ON THE WEST SIDE OF HIGHWAY - 95, NEAR MILE MARKER 88.66


ELEVATION = 764.787 METERS (NAVD'83)
ELEVATION = 2508.14 U.S. SURVEY FEET (NAVD'83)

Call
before you
Dig
1-800-227-2600

IMPROVEMENT PLANS

FOR

DEER SPRINGS RANCH OFF-SITE SANITARY SEWER MAIN EXTENSION PHASE I CITY OF LAS VEGAS STATE OF NEVADA

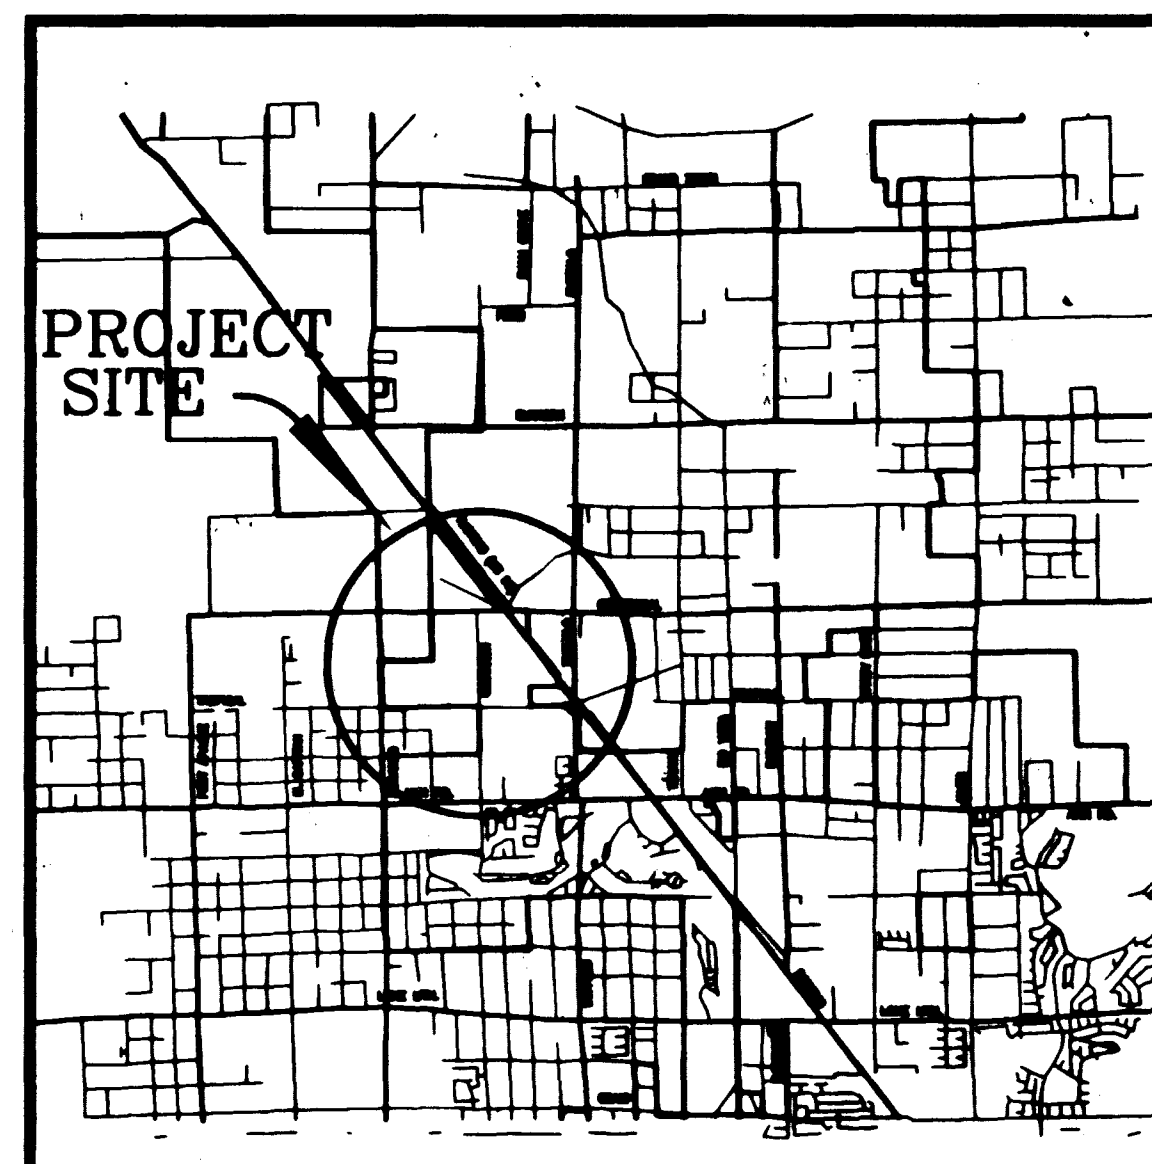

VICINITY MAP

GENERAL NOTES

- ALL CONSTRUCTION AND MATERIALS SHALL BE IN ACCORDANCE WITH THE "UNIFORM STANDARD SPECIFICATION FOR PUBLIC WORKS CONSTRUCTION OFF-SITE IMPROVEMENTS, CLARK COUNTY AREA NEVADA", LATEST ISSUE, THE "UNIFORM STANDARD DRAWINGS FOR PUBLIC WORKS CONSTRUCTION CLARK COUNTY AREA NEVADA", LATEST ISSUES, AND OTHER APPLICABLE APPROVED STANDARD ISSUE BY THE CONTROLLING AGENCY; THE UNIFORM BUILDING CODE; AND ALL LOCAL CITY CODES AND ORDINANCES APPLICABLE, EXCEPT AS NOTED ON THIS SHEET AS DEVIATIONS FROM STANDARDS.
- THE EXISTENCE AND LOCATION OF ANY OVERHEAD OR UNDERGROUND UTILITY LINES, PIPES, OR STRUCTURES SHOWN ON THESE PLANS ARE OBTAINED BY A RESEARCH OF THE AVAILABLE RECORDS. EXISTING UTILITIES ARE LOCATED ON PLANS ONLY FOR THE CONVENIENCE OF THE CONTRACTOR. EXISTING UTILITY SERVICE LATERALS MAY NOT BE SHOWN ON THE PLANS. THE CONTRACTOR SHALL, AT HIS OWN EXPENSE, LOCATE ALL UNDERGROUND AND OVERHEAD INTERFERENCES WHICH MAY AFFECT HIS OPERATION DURING CONSTRUCTION AND SHALL TAKE ALL NECESSARY PRECAUTIONS TO AVOID DAMAGE TO SAME. THE CONTRACTOR SHALL USE EXTREME CAUTION WHEN WORKING NEAR OVERHEAD OR UNDERGROUND POWER, GAS AND/OR OTHER UTILITIES SO AS TO SAFELY PROTECT ALL PERSONNEL AND EQUIPMENT, AND SHALL BE RESPONSIBLE FOR ALL COSTS AND LIABILITY IN CONNECTION THEREWITH.
- THE CONTRACTOR SHALL TAKE ALL PRECAUTIONARY MEASURES NECESSARY TO PROTECT EXISTING UTILITY LINES, STRUCTURES, AND STREET IMPROVEMENTS WHICH ARE TO REMAIN IN PLACE, FROM DAMAGE, AND ALL SUCH IMPROVEMENTS OR STRUCTURES DAMAGED BY THE CONTRACTOR'S OPERATIONS SHALL BE REPAIRED OR REPLACED SATISFACTORY TO THE CITY ENGINEER OR OWNING UTILITY COMPANY AT THE EXPENSE OF THE CONTRACTOR.
- ALL CONSTRUCTION SHALL BE AS SHOWN ON THESE PLANS, ANY REVISIONS SHALL HAVE THE PRIOR WRITTEN APPROVAL OF THE CITY ENGINEER.
- TYPE V CEMENT SHALL BE USED IN ALL OFF-SITE CONCRETE WORK. CONCRETE TO BE 3000 P.S.I. MINIMUM @ 28 DAYS. MIX DESIGN TO BE APPROVED BY THE QUALITY CONTROL DIVISION PRIOR TO USE ON THE PROJECT.
- PERMITS ARE REQUIRED FOR ANY WORK IN THE PUBLIC RIGHT-OF-WAY. THE CONTRACTOR SHALL SECURE ALL PERMITS AND INSPECTIONS REQUIRED FOR THIS CONSTRUCTION.
- EXPANSION JOINTS REQUIRED, MAXIMUM EVERY 300' IN EXTRUDED TYPE CURB.
- AC PAVEMENT TO BE 1/2" ABOVE LIP OF ALL GUTTERS AFTER COMPACTION, EXCEPT AT SIDEWALK RAMPS.
- APPLY FOG SEAL ONLY AFTER ALL CORRECTIONS AND ADJUSTMENTS HAVE BEEN MADE.
- CURB & GUTTER WITH A GRADE OF LESS THAN FOUR TENTHS OF ONE PERCENT SHALL BE WATER TESTED AS SOON AS POSSIBLE AFTER CONSTRUCTION. ANY CURB AND GUTTER FOUND TO BE UNACCEPTABLE TO THE CITY SHALL BE REMOVED AND REPLACED.

NOTE
ALTERNATE "A" IS FOR BIDDING ONLY.
ALTERNATE "B" IS TO BE CONSTRUCTED

DEVELOPER

AMERICAN WEST HOMES, INC.
2700 E. SUNSET ROAD, STE. 5
LAS VEGAS, NV 89120
PHONE (702)736-7970

QUANTITY ESTIMATES

OVERSIZED SEGMENT FROM STA. 10+00 TO STA. 70+00	
ALTERNATIVE "A"	ALTERNATIVE "B" (COVER SIZE)
8" SEWER MAIN 55 LF	8" SEWER MAIN 55 LF
STD. SEWER MANHOLES 10 BA	10" SEWER MAIN 1066 LF
	12" SEWER MAIN 2740 LF
	15" SEWER MAIN 1628 LF
	18" SEWER MAIN 900 LF
	STD. 48" DIA. SEWER MANHOLES 16
	STD. 60" DIA. SEWER MANHOLES 2
NON-OVERSIZED SEGMENT	
STA. 70+00 TO STA. 84+42.88	STA. 0+00 TO STA. 84+42.88
8" SEWER MAIN 1333 LF	8" SEWER MAIN 2893 LF
STD. SEWER MANHOLES 3	STD. SEWER MANHOLES 10

DEVIATION FROM STANDARDS

NONE
CITY OF LAS VEGAS SEWER NOTES

- ALL CONSTRUCTION AND MATERIALS SHALL BE IN ACCORDANCE WITH THE LATEST EDITION OF THE DESIGN AND CONSTRUCTION STANDARDS FOR WASTEWATER COLLECTION SYSTEMS AND THE UNIFORM STANDARD SPECIFICATIONS FOR PUBLIC WORKS CONSTRUCTION OFF-SITE IMPROVEMENTS, CLARK COUNTY AREA, NEVADA, AS AMENDED. IN ALL CASES, THESE STANDARDS SHALL SUPERSEDE THE UNIFORM STANDARD SPECIFICATIONS. IT WILL BE THE RESPONSIBILITY OF THE CONTRACTOR TO BE AWARE OF THE CONTENTS OF THE ABOVE SPECIFICATION BOOKS.
- IT SHALL BE THE CONTRACTOR'S RESPONSIBILITY TO PERFORM CONSTRUCTION AS PER PLANS. ANY ADDITIONS, DELETIONS, OR CHANGES SHALL FIRST MEET WITH THE APPROVAL OF THE CONTROLLING AGENCY.
- CHISEL "S" OR "G" IN CURBS WHERE SEWER OR GAS LATERALS PASS UNDER THE CURB.
- POLYVINYL (PVC) SEWER PIPE SHALL MEET ASTM D-3034 SDR 35 SPECIFICATIONS, INSTALLED WITH SAND BEDDING AND BACKFILL OF TYPE II GRAVEL.
- ALL MANHOLES IN PAVED STREETS 80' R/W AND LARGER, SHALL HAVE CONCRETE COLLARS.
- TEE SADDLES SHALL BE USED TO CONNECT SEWER LATERALS TO EXISTING MAIN LINES UP TO 12" DIA. SIZE. CONNECTIONS TO 15" OR LARGER MAINS SHALL REQUIRE SPECIAL PROCEDURES.
- A SEWER MAIN CROSSING OVER A WATER MAIN OR LESS THAN 18" UNDER A WATER MAIN, MUST BE REINFORCED CONCRETE ENCASED FOR A DISTANCE NOT LESS THAN TEN FEET (10') TO EACH SIDE OF THE CENTERLINE OF THE WATER MAIN.
- ALL CONTRACTORS INSTALLING SEWER MAINS THAT WILL BE UNDER THE JURISDICTION OF THE CONTROLLING AGENCY MUST BE CLASS "A" CONTRACTORS.
- THE CITY OF LAS VEGAS WILL NOT ACCEPT ANY SEWER MAINS WHICH HAVE A VERTICAL DEFLECTION OF MORE THAN ON TENTH (0.1) OF A FOOT FROM THE PRE-APPROVED CONSTRUCTION PLANS. SEWER MAINS FOUND TO EXCEED THIS TOLERANCE WILL HAVE TO BE REPAIRED OR REMOVED AND REPLACED TO THE SATISFACTION OF THE CITY ENGINEER PRIOR TO ACCEPTANCE BY THE CITY.

WATER CROSSING NOTE

THE FOLLOWING ARE THE REQUIREMENTS THAT MUST BE MET WHEN THERE IS A WATER-SEWER CROSSING:

WHEN PROTECTION OF THE WATERLINE IS CONSIDERED, THE MINIMUM VERTICAL DISTANCE OF 18 INCHES MUST BE MAINTAINED WHEN THE WATER LINE IS INSTALLED OVER THE SEWER/STORM LINE. IF THIS DISTANCE CANNOT BE MAINTAINED BECAUSE OF PHYSICAL OBSTRUCTIONS OR THE WATERLINE MUST BE PLACED UNDER THE SEWER/STORM LINE, THE SEWER/STORM LINE MUST BE CONSTRUCTED WITH ANY ONE OF THE FOLLOWING:

- EXTRA HEAVY CAST IRON OR DUCTILE IRON PIPE.
- WATER SUPPLY QUALITY MATERIAL.
- ENCASEMENT WITH 4 INCHES MINIMUM OF CONCRETE OR SLEEVING WITH WATER QUALITY PIPE.

EACH OF THESE PROVISIONS MUST BE EXTENDED FOR 10 FEET ON EITHER SIDE OF THE WATERLINE AT 90 DEGREES TO THE CROSSING.

- SIDEWALK RAMPS SHALL BE CONSTRUCTED IN EACH QUADRANT OF AN INTERSECTION PER STANDARD DRAWING 235. EXACT LOCATION OF RAMPS MAY BE ADJUSTED IN THE FIELD BY THE CITY INSPECTOR.
- CONTRACTOR SHALL PROVIDE ALL NECESSARY HORIZONTAL AND VERTICAL TRANSITIONS BETWEEN NEW CONSTRUCTION AND EXISTING SURFACES TO PROVIDE FOR PROPER DRAINAGE AND FOR INGRESS AND EGRESS TO NEW CONSTRUCTION. THE EXTENT OF TRANSITIONS TO BE AS SHOWN ON PLANS, OR AS DESIGNATED IN THE FIELD BY A CITY INSPECTOR.
- ALL GRADING WORK SHALL CONFORM TO THE SOILS REPORT AS PREPARED BY THE SOILS ENGINEER AND APPROVED BY THE CITY ENGINEER, AND AS SHOWN ON THESE PLANS.
- EXACT LOCATION OF ALL SAW CUT LINES MAY BE DETERMINED IN THE FIELD BY A CITY OF LAS VEGAS INSPECTOR IF LOCATION ON PLANS IS NOT CLEARLY SHOWN, OR EXISTING PAVEMENT CONDITION REQUIRES RELOCATION.
- THE CONTRACTOR SHALL TAKE ALL PRECAUTIONS NECESSARY TO PROTECT EXISTING PERMANENT SURVEY MONUMENTS. ANY MONUMENTS DISTURBED SHALL BE REPLACED AND ADJUSTED PER AVAILABLE RECORDS IN ACCORDANCE WITH N.R.S. STATUTE NO. 625.550.
- UTILITY COMPANY METER BOXES, MANHOLE LIDS, VALVE COVERS, ETC. SHALL BE LOCATED OUT OF DRIVEWAYS, DRIVEWAY APRONS, FLOW LINES, AND CROSS GUTTERS UNLESS WRITTEN APPROVAL IS GRANTED BY THE UTILITY COMPANY AND THE CITY ENGINEER.

- WALL NOTES:
A. ALL WALLS, NEW OR EXISTING, ARE ONLY SHOWN FOR THE PURPOSE OF GRADING RELATIONSHIPS.
B. THE STRUCTURAL AND ARCHITECTURAL DESIGN OF ALL WALLS (RETAINING OR NON-RETAINING) MUST BE APPROVED BY THE CLV BUILDING DEPARTMENT.
- ASPHALT MIX DESIGN MUST BE SUBMITTED AND APPROVED BY THE CITY ENGINEER TO THE PLACEMENT OF ASPHALT ON CITY STREETS.

APPROVAL

DENNIS ANDERSON, P.E.
LAS VEGAS CITY ENGINEER

APPROVAL OF THESE PLANS BY THE CITY ENGINEER IS LIMITED TO THOSE IMPROVEMENTS CONSTRUCTED IN THE DEDICATED RIGHTS-OF-WAY AND/OR DEDICATED EASEMENTS. UNDER CLV JUDICIAL THIS APPROVAL DOES NOT AUTHORIZE THE CONSTRUCTION ON ANY IMPROVEMENTS THAT DEVIATE FROM ADOPTED STANDARDS AND/OR SPECIFICATIONS EXCEPT THOSE SPECIFICALLY LISTED UNDER "DEVIATIONS FROM STANDARDS". THE ENGINEER SHALL RESOLVE ANY DEVIATION OTHER THAN THOSE LISTED IN "DEVIATIONS FROM STANDARDS" IN FAVOR OF THE UNIFORM STANDARDS DRAWINGS AND SPECIFICATIONS CLARK COUNTY AREA NEVADA.

AMERICAN WEST HOMES, INC.

CITY OF LAS VEGAS, NEVADA

CONSULTING ENGINEERS • PLANNERS • LAND SURVEYORS

2727 SOUTH RAINBOW BOULEVARD
LAS VEGAS, NEVADA 89146-4148 PHONE (702) 875-7800 FAX (702) 382-8867

COVER SHEET

As-Built

DEER SPRINGS RANCH

PHASE I OFF-SITE SEWER

NO. 4884

BY FK

DATE 6-20-98

SCALE HORIZ. NONE

VERT. NONE

SHEET 1 of 4


8884

As-Built 307Y-4478-OS

WHAT NEW

4. CONCLUSIONS

1. **FLOR & PEOPLE FROM 2004-2005** 2004-2005 2004-2005 2004-2005
2. **FLOR & PEOPLE FROM 2006-2007** 2006-2007 2006-2007 2006-2007
3. **FLOR & PEOPLE FROM 2008-2009** 2008-2009 2008-2009 2008-2009
4. **FLOR & PEOPLE FROM 2010-2011** 2010-2011 2010-2011 2010-2011
5. **FLOR & PEOPLE FROM 2012-2013** 2012-2013 2012-2013 2012-2013
6. **FLOR & PEOPLE FROM 2014-2015** 2014-2015 2014-2015 2014-2015
7. **FLOR & PEOPLE FROM 2016-2017** 2016-2017 2016-2017 2016-2017
8. **FLOR & PEOPLE FROM 2018-2019** 2018-2019 2018-2019 2018-2019
9. **FLOR & PEOPLE FROM 2020-2021** 2020-2021 2020-2021 2020-2021
10. **FLOR & PEOPLE FROM 2022-2023** 2022-2023 2022-2023 2022-2023

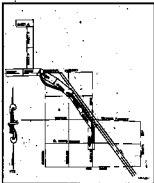

***KEY MAP**

BASE OF SELECTION

— 11 —

100

THEORY OF THE GROUND STATE

DE: 25177

Call before you Dig
1-800-372-5898


IMPROVEMENT PLANS

FOR

**DEER SPRINGS RANCH OFF-SITE
SANITARY SEWER MAIN EXTENSION**

PHASE I

CITY OF LAS VEGAS
STATE OF NEVADA

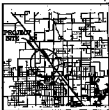

VENTIL MAP

GENERAL REVIEW

1. ~~THE INFORMATION ON THIS FORM IS FOR THE USE OF THE FBI ONLY. IT IS NOT TO BE RELEASED TO ANY OTHER AGENCY OR INDIVIDUAL WITHOUT THE WRITTEN AUTHORIZATION OF THE FBI. IT IS THE POLICY OF THE FBI TO MAINTAIN THE CONFIDENTIALITY OF THE INFORMATION ON THIS FORM.~~
2. ~~THIS FORM IS TO BE USED TO REPORT THE RESULTS OF A FIELD INVESTIGATION OF A SUBJECT'S ACTIVITY IN THE UNITED STATES OR ABROAD. IT IS TO BE COMPLETED BY THE FIELD OFFICE OF THE FBI TO WHICH THE SUBJECT IS ASSIGNED.~~
3. ~~THE INFORMATION ON THIS FORM IS TO BE USED TO REPORT THE RESULTS OF A FIELD INVESTIGATION OF A SUBJECT'S ACTIVITY IN THE UNITED STATES OR ABROAD. IT IS TO BE COMPLETED BY THE FIELD OFFICE OF THE FBI TO WHICH THE SUBJECT IS ASSIGNED.~~
4. ~~THE INFORMATION ON THIS FORM IS TO BE USED TO REPORT THE RESULTS OF A FIELD INVESTIGATION OF A SUBJECT'S ACTIVITY IN THE UNITED STATES OR ABROAD. IT IS TO BE COMPLETED BY THE FIELD OFFICE OF THE FBI TO WHICH THE SUBJECT IS ASSIGNED.~~
5. ~~THE INFORMATION ON THIS FORM IS TO BE USED TO REPORT THE RESULTS OF A FIELD INVESTIGATION OF A SUBJECT'S ACTIVITY IN THE UNITED STATES OR ABROAD. IT IS TO BE COMPLETED BY THE FIELD OFFICE OF THE FBI TO WHICH THE SUBJECT IS ASSIGNED.~~
6. ~~THE INFORMATION ON THIS FORM IS TO BE USED TO REPORT THE RESULTS OF A FIELD INVESTIGATION OF A SUBJECT'S ACTIVITY IN THE UNITED STATES OR ABROAD. IT IS TO BE COMPLETED BY THE FIELD OFFICE OF THE FBI TO WHICH THE SUBJECT IS ASSIGNED.~~
7. ~~THE INFORMATION ON THIS FORM IS TO BE USED TO REPORT THE RESULTS OF A FIELD INVESTIGATION OF A SUBJECT'S ACTIVITY IN THE UNITED STATES OR ABROAD. IT IS TO BE COMPLETED BY THE FIELD OFFICE OF THE FBI TO WHICH THE SUBJECT IS ASSIGNED.~~
8. ~~THE INFORMATION ON THIS FORM IS TO BE USED TO REPORT THE RESULTS OF A FIELD INVESTIGATION OF A SUBJECT'S ACTIVITY IN THE UNITED STATES OR ABROAD. IT IS TO BE COMPLETED BY THE FIELD OFFICE OF THE FBI TO WHICH THE SUBJECT IS ASSIGNED.~~
9. ~~THE INFORMATION ON THIS FORM IS TO BE USED TO REPORT THE RESULTS OF A FIELD INVESTIGATION OF A SUBJECT'S ACTIVITY IN THE UNITED STATES OR ABROAD. IT IS TO BE COMPLETED BY THE FIELD OFFICE OF THE FBI TO WHICH THE SUBJECT IS ASSIGNED.~~
10. ~~THE INFORMATION ON THIS FORM IS TO BE USED TO REPORT THE RESULTS OF A FIELD INVESTIGATION OF A SUBJECT'S ACTIVITY IN THE UNITED STATES OR ABROAD. IT IS TO BE COMPLETED BY THE FIELD OFFICE OF THE FBI TO WHICH THE SUBJECT IS ASSIGNED.~~

CRIMINALITY: SUMMARY

DESIGN AND CONSTRUCTION STANDARDS

THE UNIVERSITY OF CHICAGO PRESS

- [illegible]

CALL TODAY NOW

THE UNIVERSITY OF CHICAGO PRESS

1. **THE STATE OF TEXAS, COUNTY OF DALLAS, ss. I, _____, Clerk of the County Court, do hereby certify that the within and foregoing is a true and correct copy of the original as the same appears from the records of the County Court of the County of Dallas, State of Texas.**
2. **IN WITNESS WHEREOF, I have hereunto set my hand and the seal of said County Court at Dallas, Texas, this _____ day of _____, 19____.**
3. **CLERK OF COUNTY COURT**
4. **NOTARY PUBLIC**
5. **NOTARY PUBLIC**
242. **NOTARY PUBLIC</**

COVER SHEET

HOWY'S BOOKS: JOHN JAY'S REPLY



DATE	10/10/2010
BY	100
TIME	10:10:10
LOCATION	100
REMARKS	100