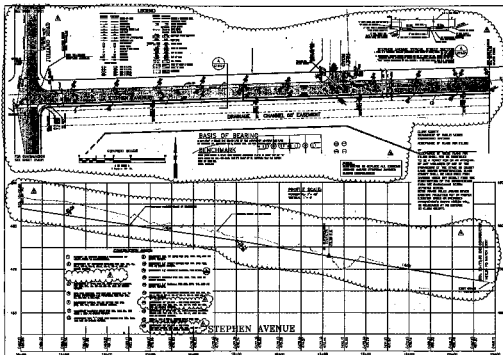


[illegible]

RECORD DRAWING

— K. S. Salovey — 12/04/80

[illegible][illegible]

SCHOOL DISTRICT
ALLEN
SCHOOL 0823
STEPHEN AVENUE

CLARK COUNTY SCHOOL DISTRICT

DEAN LAMAR ALLEN
ELEMENTARY SCHOOL 0623

PLAN AND PROFILE-STEPHEN AVENUE

C19.01
19 OF 21