

SEE SHEET No. C11.01
MATCHLINE STA. 18+00

S 89°44'20" W BEING THE SOUTH LINE OF THE NORTHEAST QUARTER (NE 1/4)
OF SECTION 32, TOWNSHIP 19 S. RANGE 60E. AS PER PARCEL MAP FILE 42 PAGE

1C90 29S4 BEING A RIVET AND SQUARE ALUMINUM PLATE IN WEST TOP OF "A"
TYPE CURB ON CUL-DE-SAC, 190 FT. EAST OF EL CAPITAN WAY ON NORTH
SIDE OF ANN RD.
ELEV: 2505.90

[illegible]

BY: *K. R. S. Chelvan* DATE: 12/10/99

THIS DRAWING WAS PREPARED FROM AS-BUILT INFORMATION PROVIDED BY THE CONTRACTOR AND THEREFORE WE ASSUME NO RESPONSIBILITY FOR ITS ACCURACY.


LAB AND MODERNIZATION SERVICES 4260 EUCALYPTUS ANNEX, LAS VEGAS, NV. 89121 - 702-799-5258/5431

PLAN AND PROFILE- DURANGO DRIVE

SHEET NO.

C12.01
12 OF 21

H: \CAD\1495\40PRO

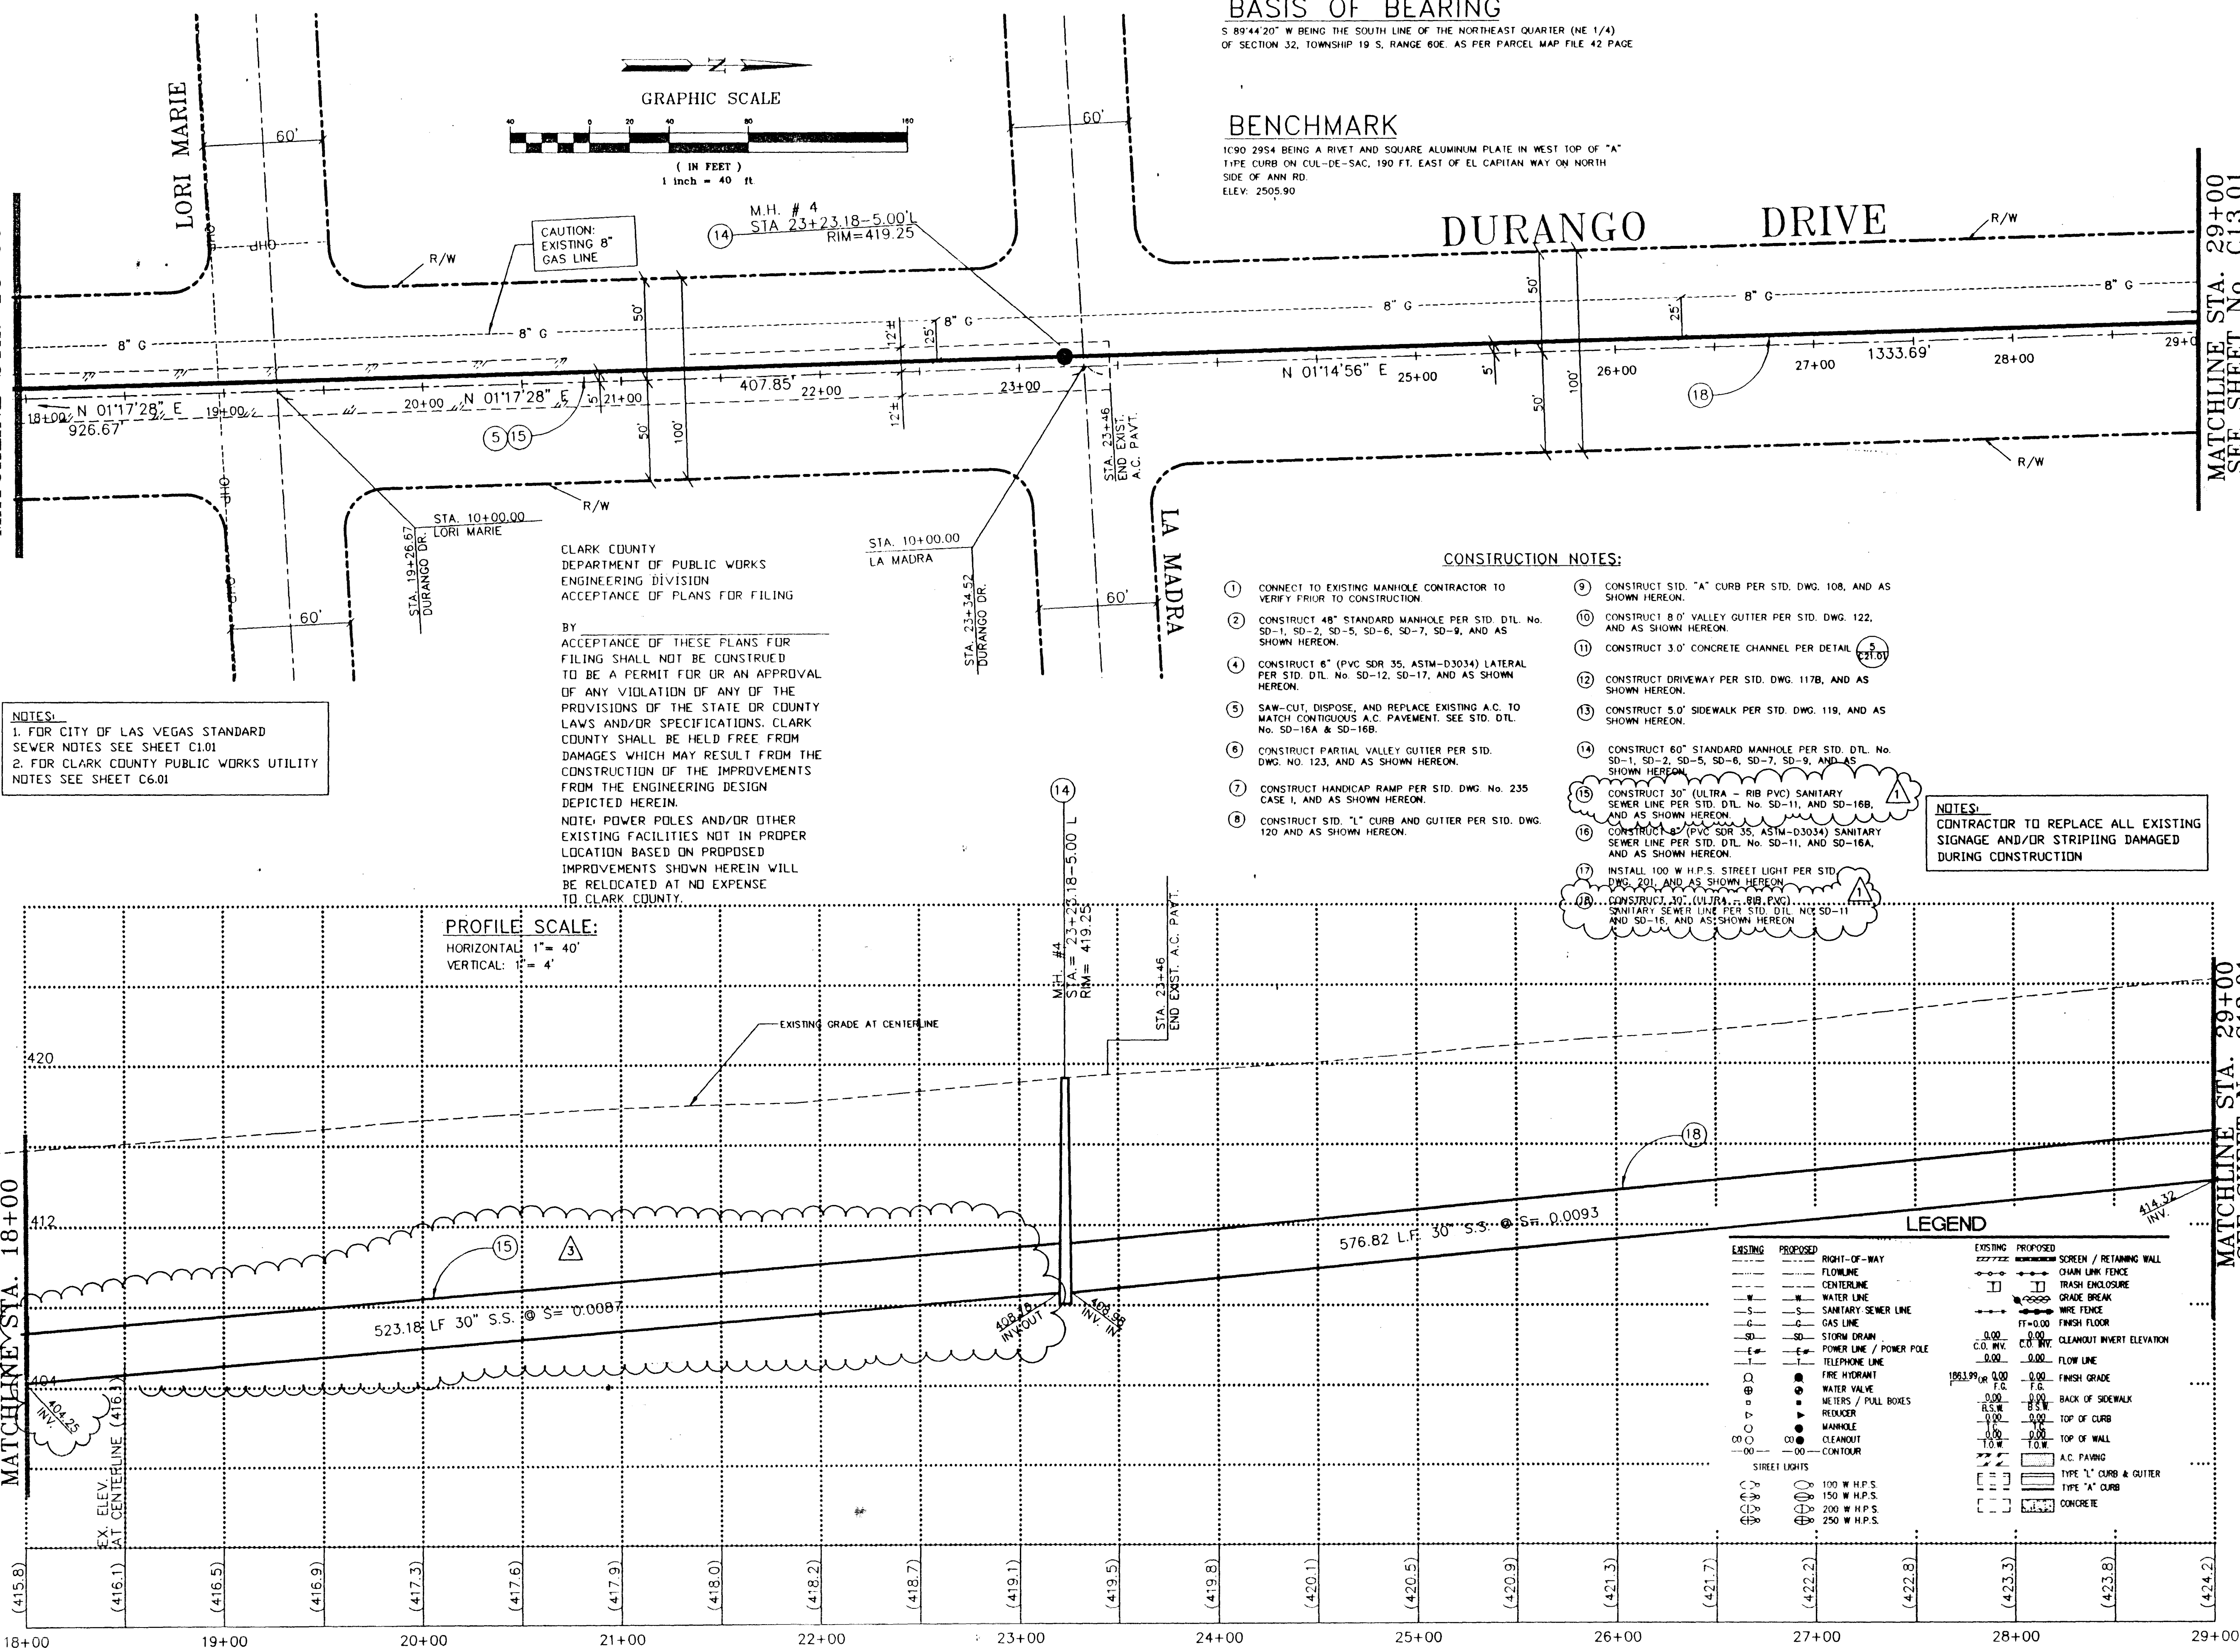

AVOID CUTTING UNDERGROUND
UTILITY LINES. IT'S COSTLY.
Call
before you
Dig—
1-800-227-2600
UNDERGROUND SERVICE ALERT (U.S.A.)

MARKIN & MARTIN ASSUMES NO RESPONSIBILITY FOR EXISTING UTILITY LOCATIONS AND ELEVATIONS. THE UTILITIES SHOWN ON THIS DRAWING HAVE BEEN PLOTTED FROM THE BEST AVAILABLE INFORMATION. IT IS, HOWEVER, THE CONTRACTOR'S RESPONSIBILITY TO FIELD VERIFY THE LOCATION AND ELEVATION ALL UTILITIES PRIOR TO THE COMMENCEMENT OF ANY CONSTRUCTION. CONTRACTOR TO FIELD VERIFY ALL EXISTING SITE CONDITIONS PRIOR TO CONSTRUCTION. IF A CONFLICT EXISTS BETWEEN WHAT IS SHOWN ON THESE DRAWINGS AND WHAT EXISTS IN THE FIELD, CONTRACTOR IS TO NOTIFY THE ARCHITECT OR ENGINEER IMMEDIATELY.

AA
ARCHITECTS, INC.

Architects • Planning • Engineers
Interior Design • Environmental Graphics
Landscape Architecture • Urban Design

1000 West 10th Street, Suite 1010
San Francisco, CA 94118
415-771-5033

MARTIN & MARTIN
CIVIL ENGINEERS
1909 South Jones Blvd.
Suite B
Las Vegas, Nevada 89102
Phone: (702) 248-9000
Fax: (702) 248-9070

These Drawings are for the
Design Professionals Only



Not Scale This Drawing

These Drawings, as Instruments of Service, are and Shall Remain the Property of the Design Professional.

Plot Scale Title Drawing

SHEET NO. C12.01
MATCHING STA. 18+00

SHEET NO. C12.01
MATCHING STA. 18+00

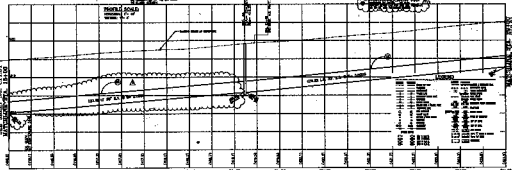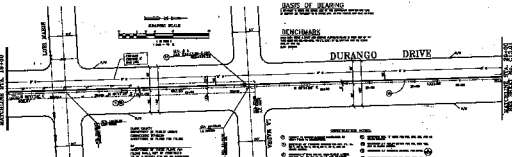

REVISION	DATE	BY	CHKD
1			
2			
3			
4			
5			
6			
7			
8			
9			
10			

RECORD DRAWING
BY *RSAB* DATE 12/01/01
FOR RECORD ON EXISTING ROAD PROFILE

NO.	DATE	BY	CHKD
1			
2			
3			
4			
5			
6			
7			
8			
9			
10			

CLARK COUNTY SCHOOL DISTRICT
DEAN LAMAR ALLEN
ELEMENTARY SCHOOL 0823
PLAN AND PROFILE - DURANGO DRIVE

C12.01
12 OF 21