
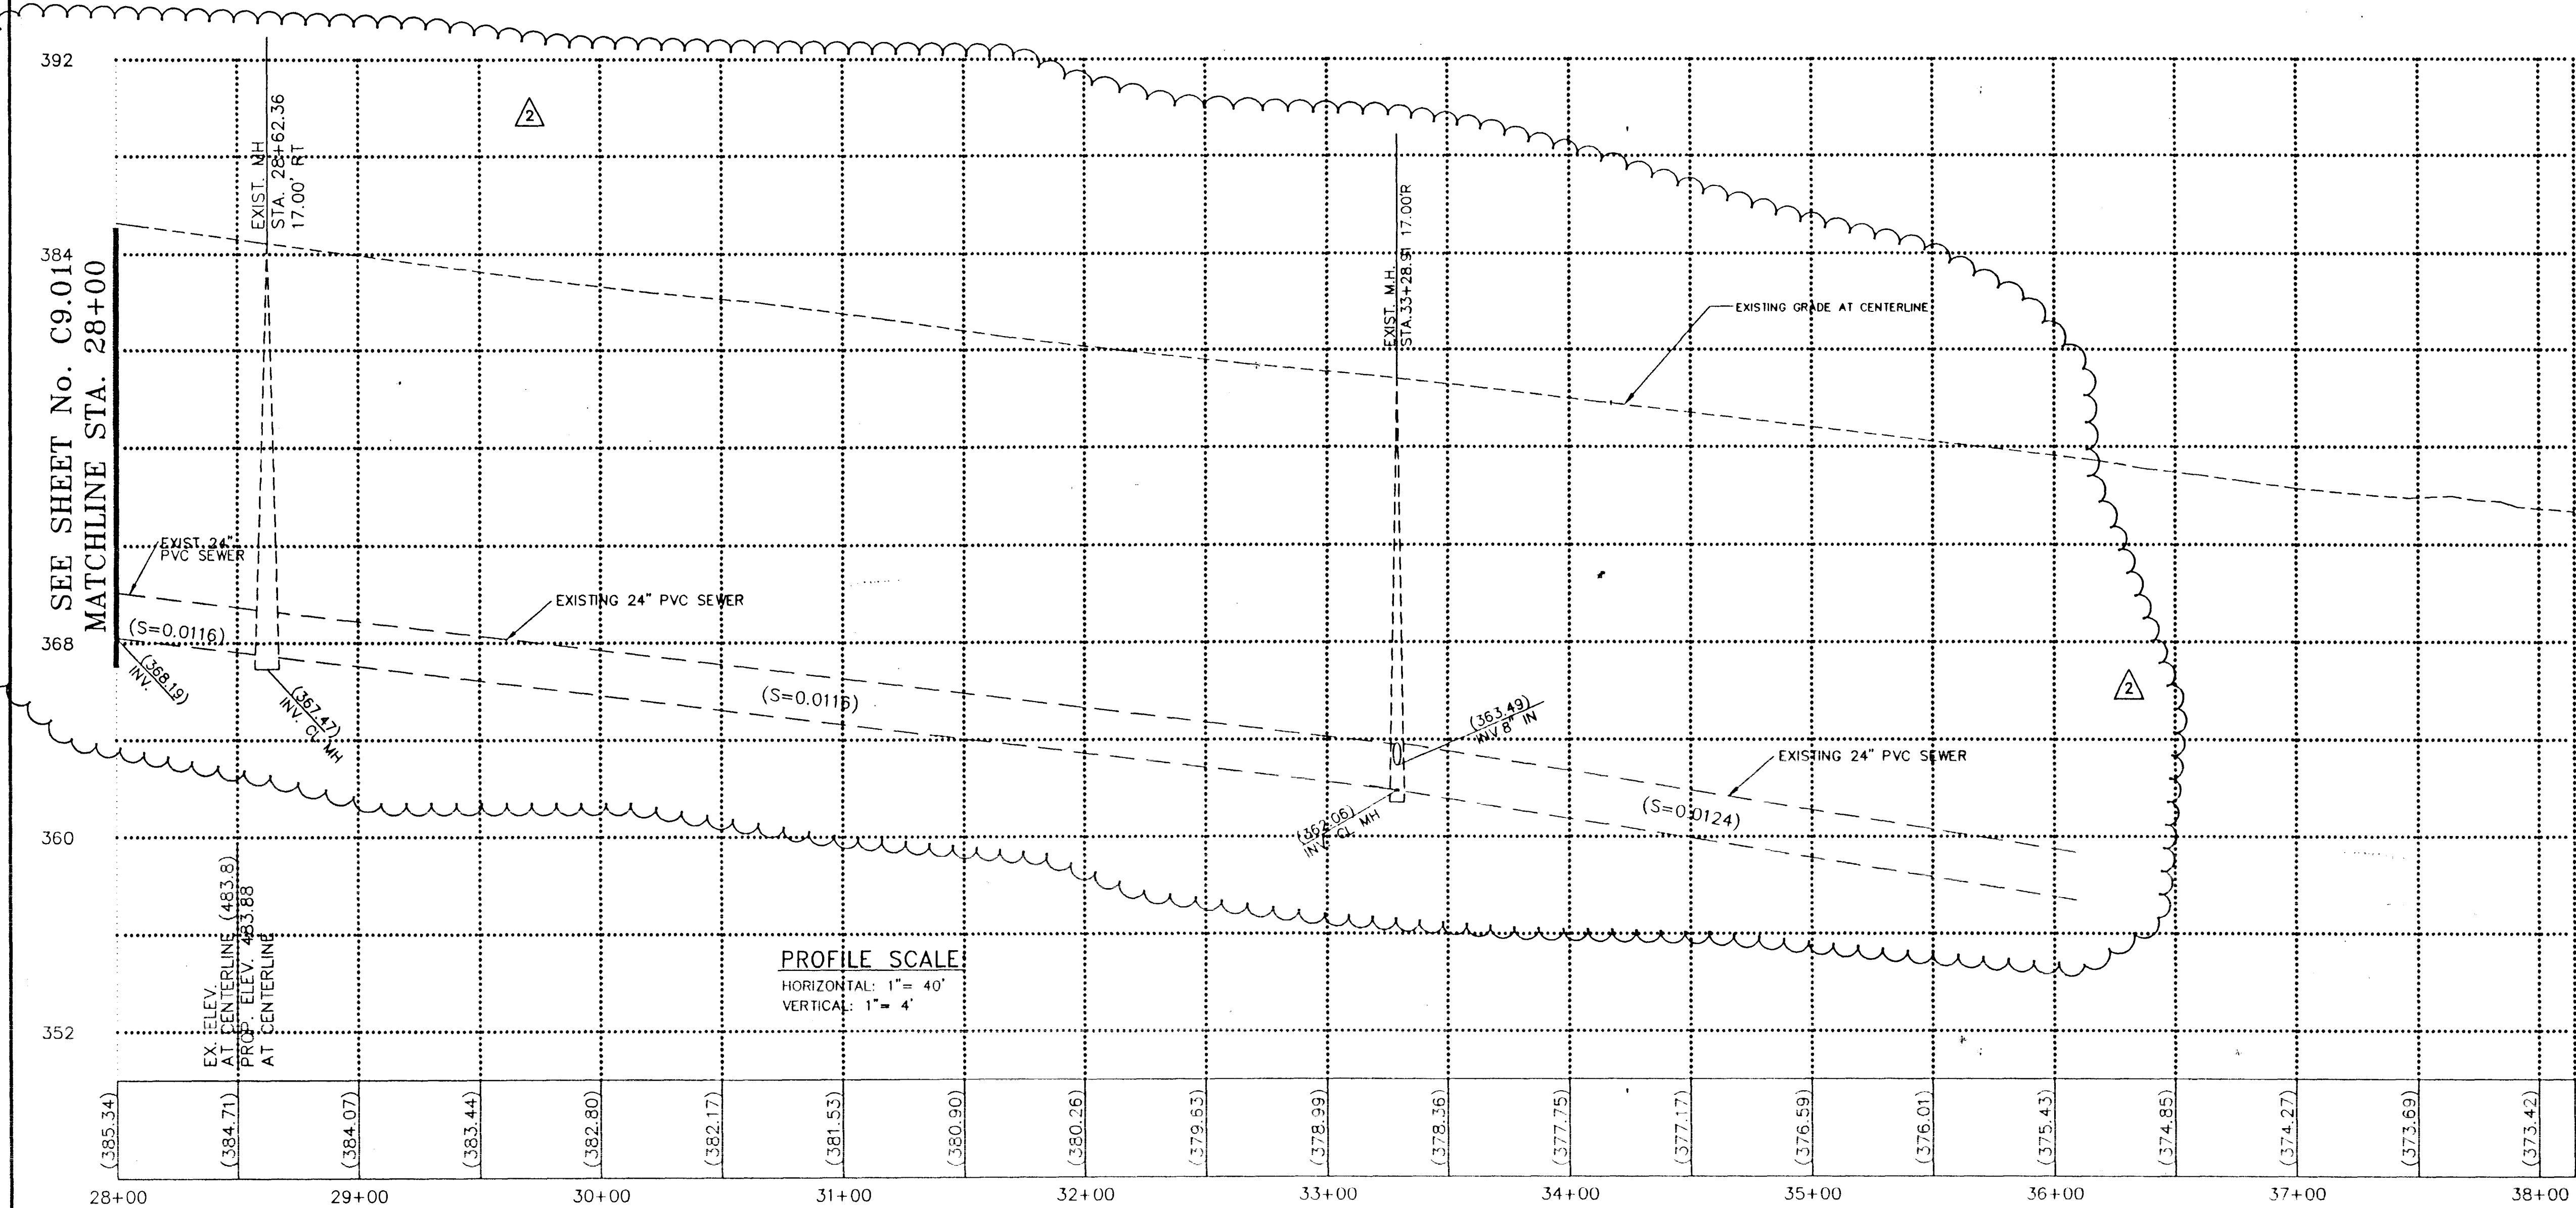


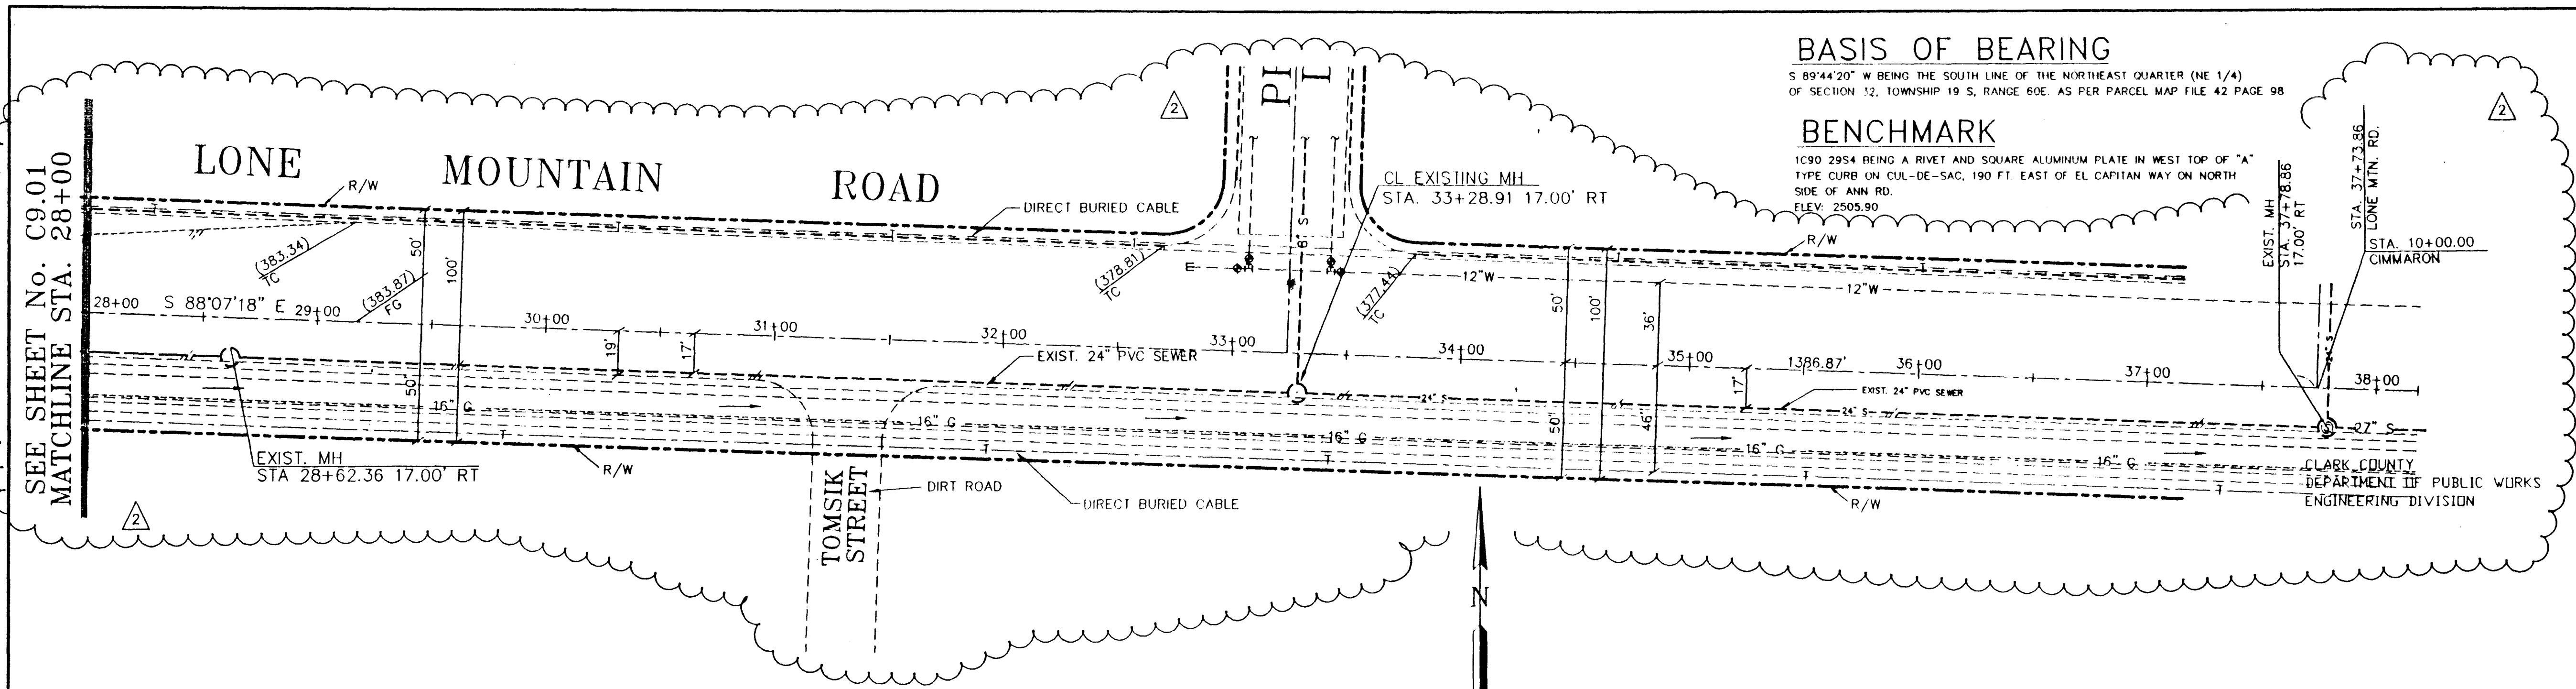

REVISIONS			
REV	DESCRIPTION	DATE	BY
1	DELETED SS PER CLV	9/16/98	WSC

RECORD DRAWING

BY: *Kurt S. Chelera* DATE: 12/10/97

THIS DRAWING WAS PREPARED FROM AS-BUILT INFORMATION PROVIDED BY THE CONTRACTOR AND THEREFORE WE ASSUME NO RESPONSIBILITY FOR ITS ACCURACY.

PLANS DATE AREA REVIEW DATE CODE COMPLIANCE DATE SITE ADMINISTRATION DATE FACILITY PLANNING DATE PROJECT MANAGER DATE FINAL REVIEW DATE	DESIGN PROJECT NO. 95134 DESIGN REVIEW DATE APPROVED BY DATE DRAWN BY DATE CHECKED BY DATE SUBMITTAL DATE PROJECT NO. 1495.00	CLARK COUNTY SCHOOL DISTRICT REHAB AND MODERNIZATION SERVICES 4260 EUCALYPTUS AVENUE, LAS VEGAS, NV 89121 - 702-799-5259/5401 DEAN LAMAR ALLEN ELEMENTARY SCHOOL 0823 PLAN AND PROFILE - LONE MTN. ROAD
---	---	---

JMA ARCHITECTS, INC.
1900 South Jones Blvd.
Suite 100
Las Vegas, NV 89102
Phone: (702) 248-8000
Fax: (702) 248-8070

These Drawings are Instruments of Service, and shall remain the Property of
The Design Professionals.

SHEET NO.

C8.01 8 OF 21

