



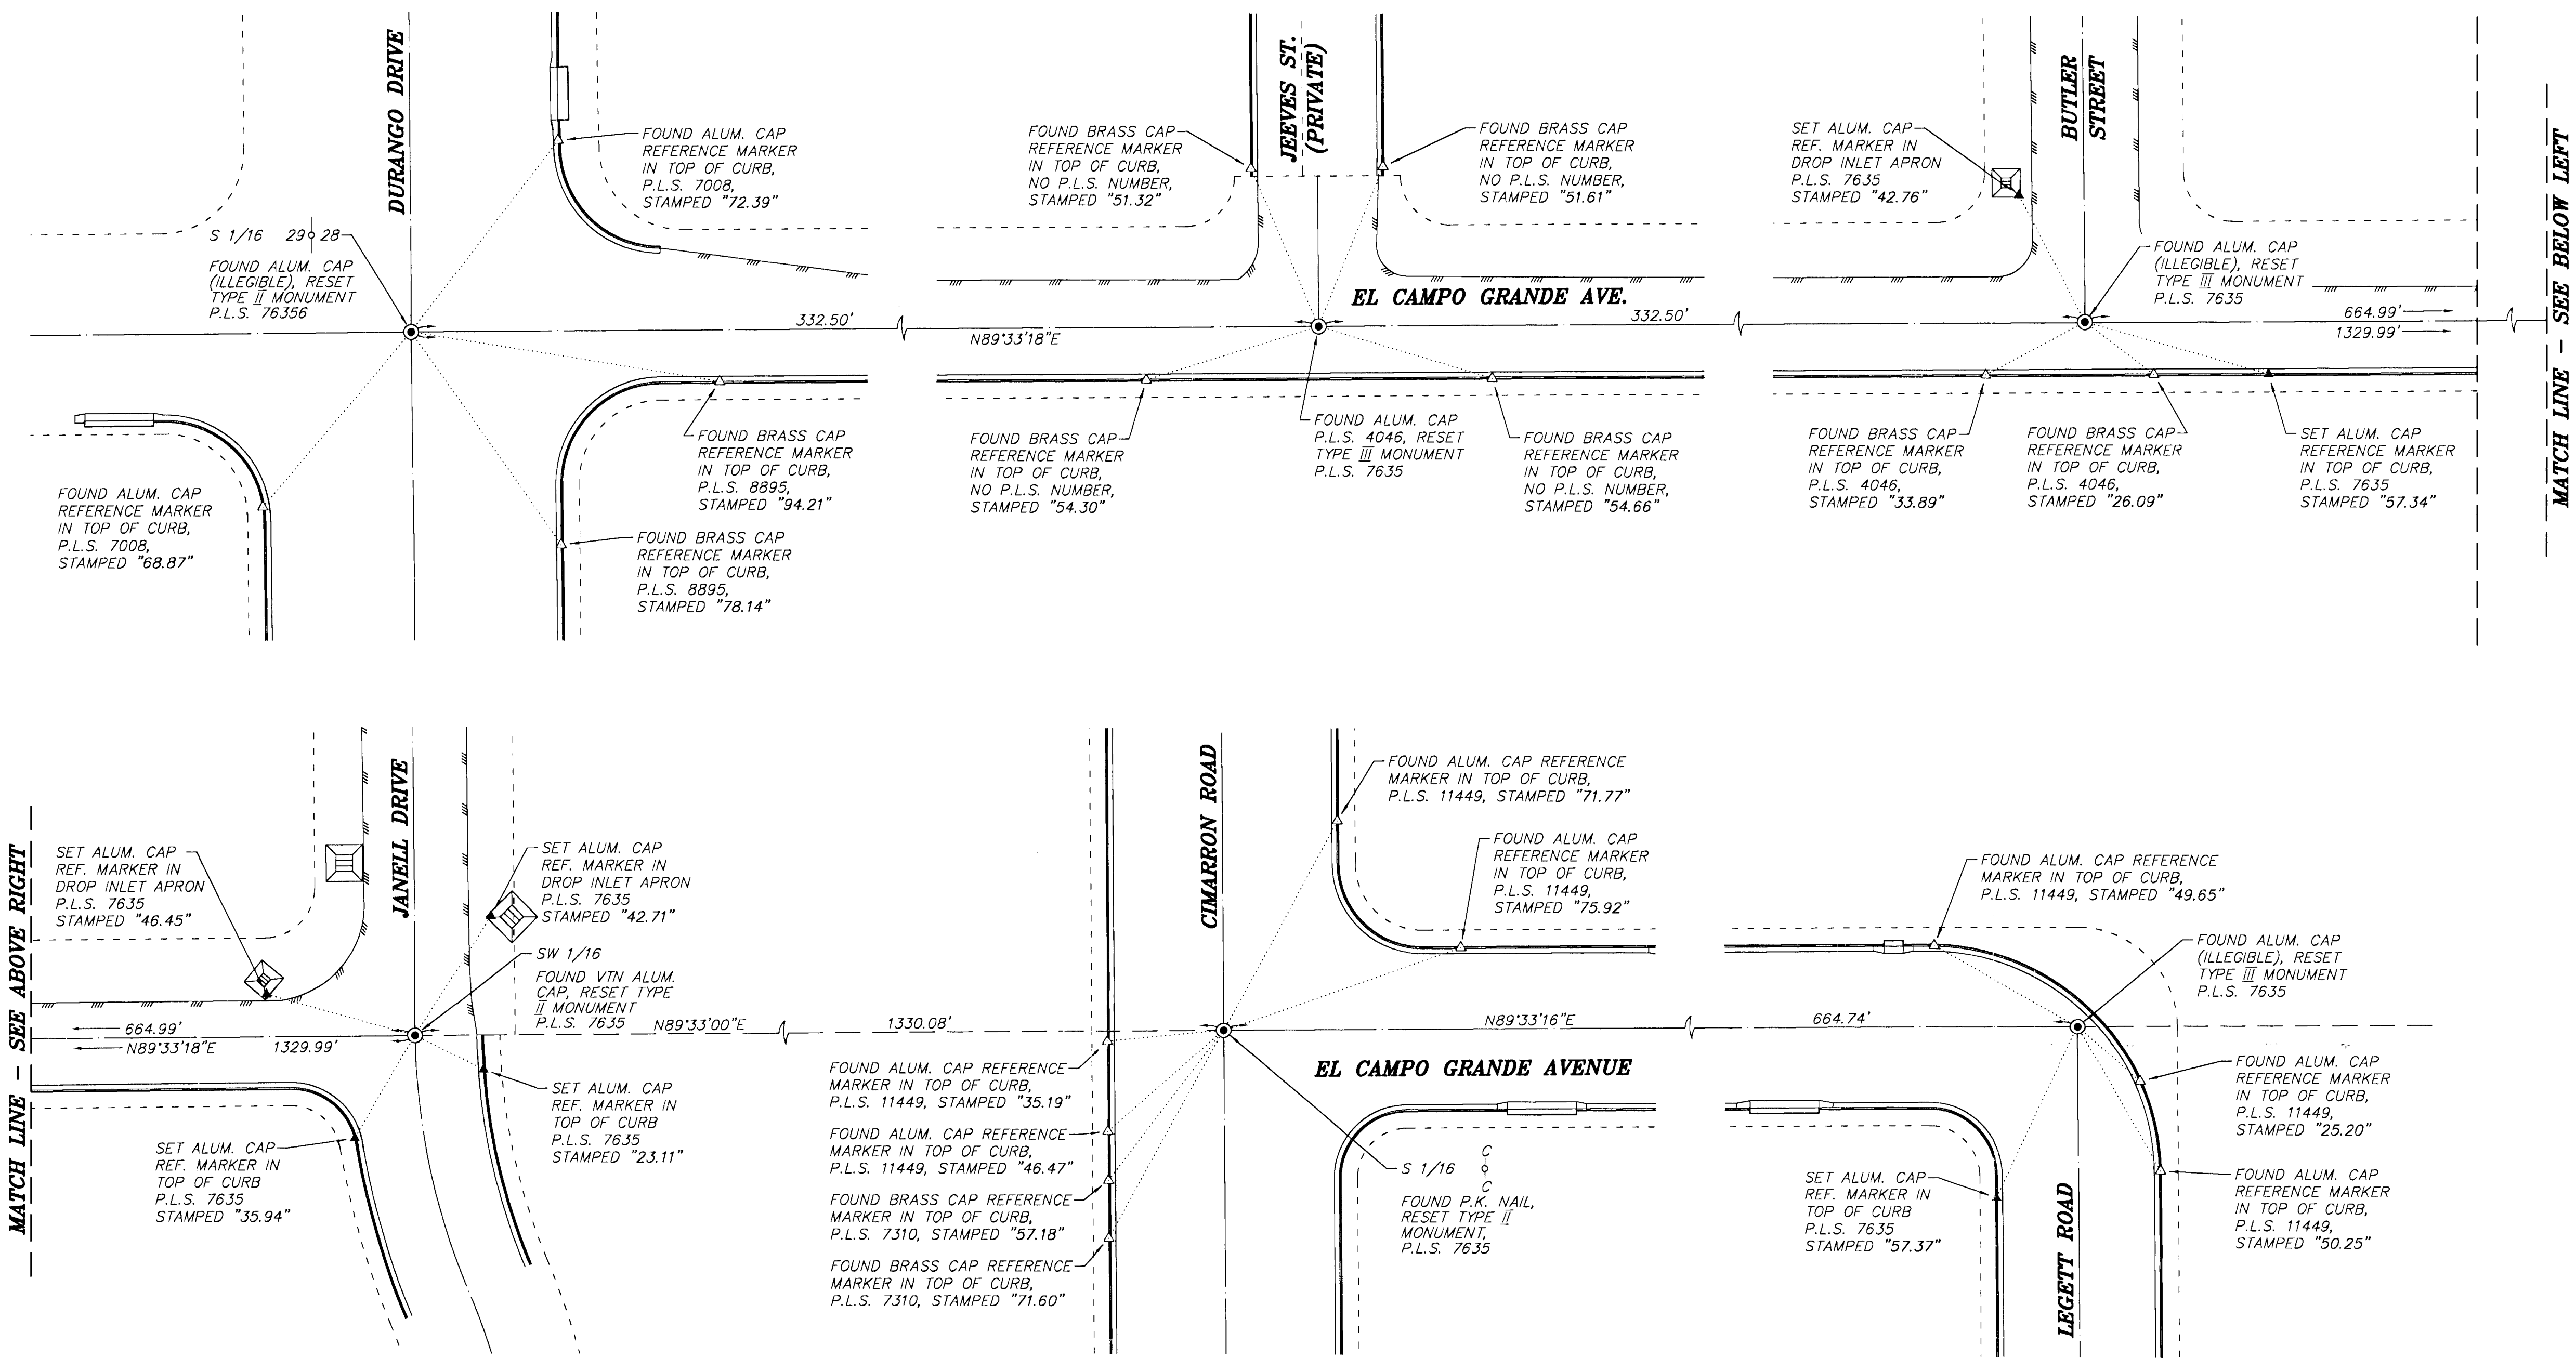

SURVEYOR'S CERTIFICATE


- I, R. GUY DOTY, A PROFESSIONAL LAND SURVEYOR LICENSED IN THE STATE OF NEVADA, CERTIFY THAT:
1. THIS MAP IS AN ACCURATE REPRESENTATION OF THE LANDS SURVEYED UNDER MY DIRECT SUPERVISION AT THE INSTANCE OF: WELLS CARGO, INC.
 2. THE LANDS SURVEYED LIE WITHIN THE SOUTH HALF (S 1/2) OF SECTION 28, TOWNSHIP 19 SOUTH, RANGE 60 EAST, M.D.M., CLARK COUNTY, NEVADA, AND THE SURVEY WAS COMPLETED ON JULY 2, 2009.
 3. THE MONUMENTS DEPICTED ON THE MAP ARE OF THE CHARACTER SHOWN, OCCUPY THE POSITIONS INDICATED AND ARE OF SUFFICIENT NUMBER AND DURABILITY.
 4. THIS SURVEY PLAT DOES NOT CONSTITUTE A SUBDIVISION AS DEFINED BY NEVADA STATE LAW.

R. GUY DOTY
PROFESSIONAL LAND SURVEYOR
NEVADA CERTIFICATE NO. 7635
EXPIRES DECEMBER 31, 2010

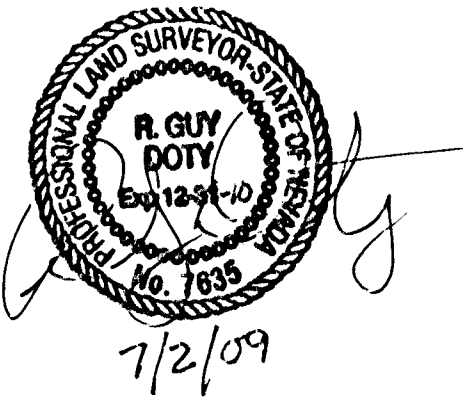

LEGEND

- STREET CENTERLINE
- - - SIXTEENTH SECTION LINE
- - - ADJOINING RIGHT-OF-WAY
- FOUND MONUMENTATION AS SHOWN AND DESCRIBED
- ▲ SET 2" ALUMINUM REFERENCE MARKER AS NOTED W/ STAMPED TIE DISTANCE P.L.S. 7635
- △ FOUND REFERENCE MARKER AS NOTED
- CONCRETE CURB & GUTTER
- /// EDGE OF ASPHALT PAVING

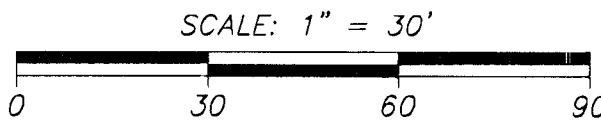

NOTE

ANY SUBSEQUENT CHANGES TO THIS MAP SHOULD BE EXAMINED AND MAY BE DETERMINED BY REFERENCE TO THE COUNTY RECORDER'S CUMULATIVE MAP INDEX. N.R.S. 278.5695.

THIS SURVEY IS FOR THE PURPOSE OF RESTORING MONUMENTATION ON THE "RANCHO ROAD SYSTEM - EL CAMPO GRANDE STORM DRAIN", AFTER ROAD IMPROVEMENT CONSTRUCTION.

BASIS OF BEARINGS

THE BASIS OF BEARINGS FOR THIS PROJECT IS GRID NORTH AS DEFINED BY THE NEVADA COORDINATE SYSTEM OF 1983 (NCS83), EAST ZONE, (2701), DETERMINED BY CLARK COUNTY GIS CONTROL POINTS "CC-GIS 801" & "CC-GIS 803", AS SHOWN ON THE MAP THEREOF IN FILE 88 OF SURVEYS, PAGE 53, OFFICIAL RECORDS, CLARK COUNTY, NEVADA.

SIP 12832

RECORD MAP of SURVEY FOR WELLS CARGO, INC. EL CAMPO GRANDE STORM DRAIN		INSTRUMENT NO. _____ FILED AT THE REQUEST OF RGD Surveying LLC DATE _____ AT _____ FILE _____ PAGE _____ OF SURVEYS OFFICIAL RECORDS BOOK NO. _____
A PORTION OF THE SOUTH HALF (S 1/2) OF SECTION 28, TOWNSHIP 19 SOUTH, RANGE 60 EAST, M.D.M., CLARK COUNTY, NEVADA		CLARK COUNTY, NEVADA RECORDS DEBBIE CONWAY, RECORDER FEE \$ _____ DEPUTY _____
RGD RGD SURVEYING LLC P. O. Box 148 Logandale, NV 89021 Tele: 016-397-8250 Fax: 397-8257 Mobile: 429-5224		