



A7.11

5-13-96


95260

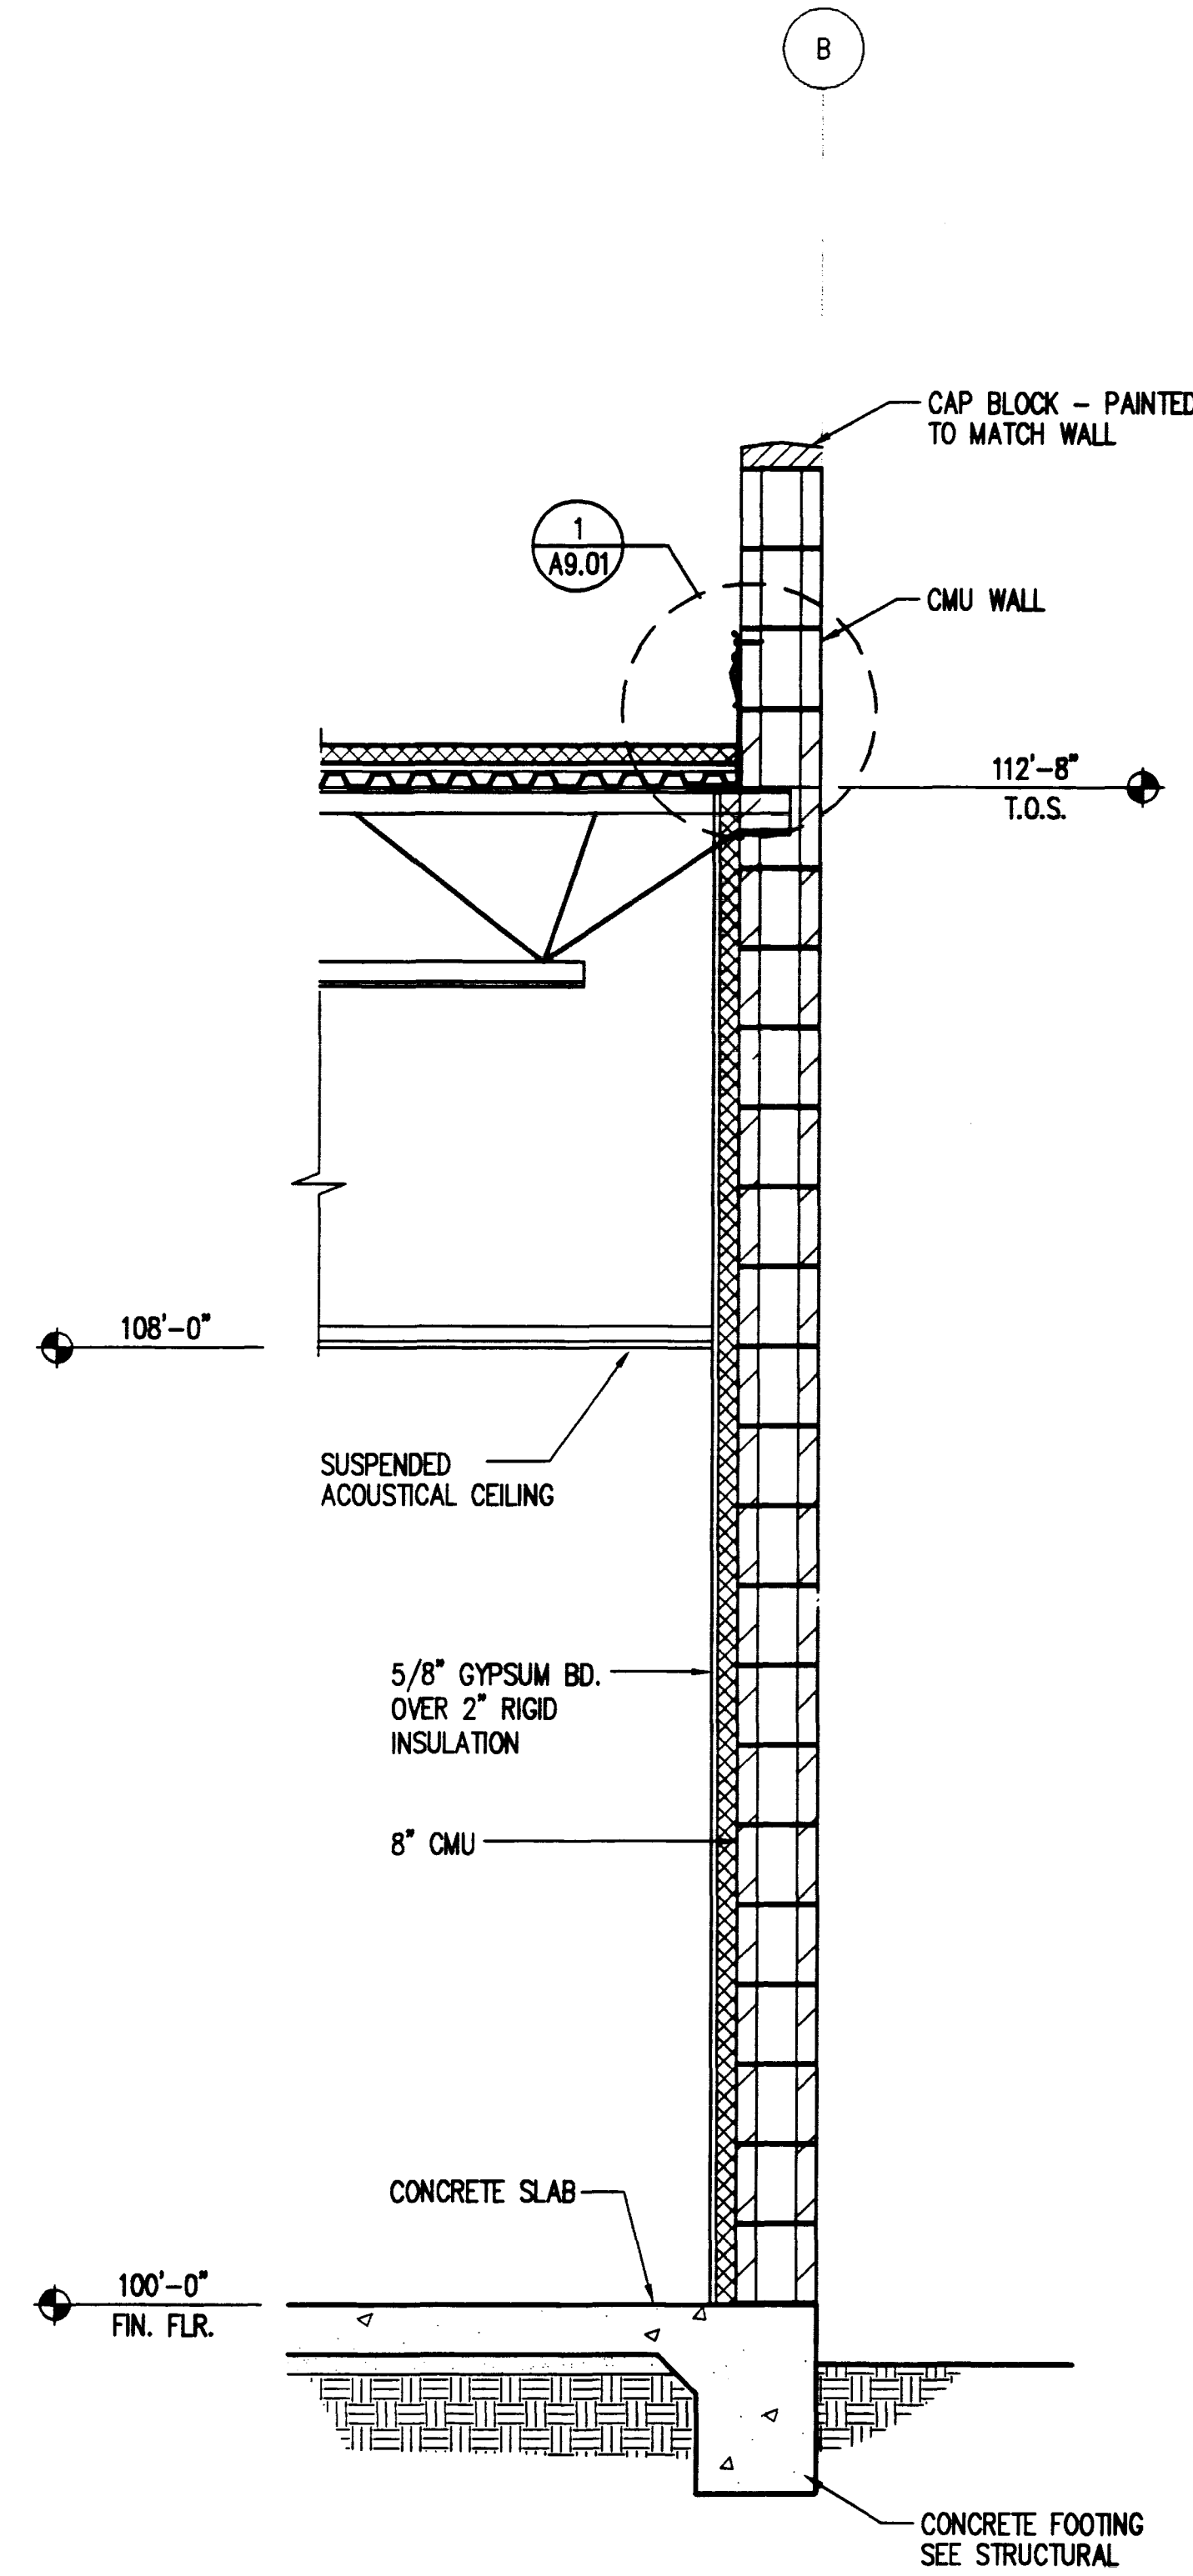


EXTERIOR WALL SECTION
SCALE: 3/4"=1'-0" (BRIEFING/LOCKER ROOM) **5**

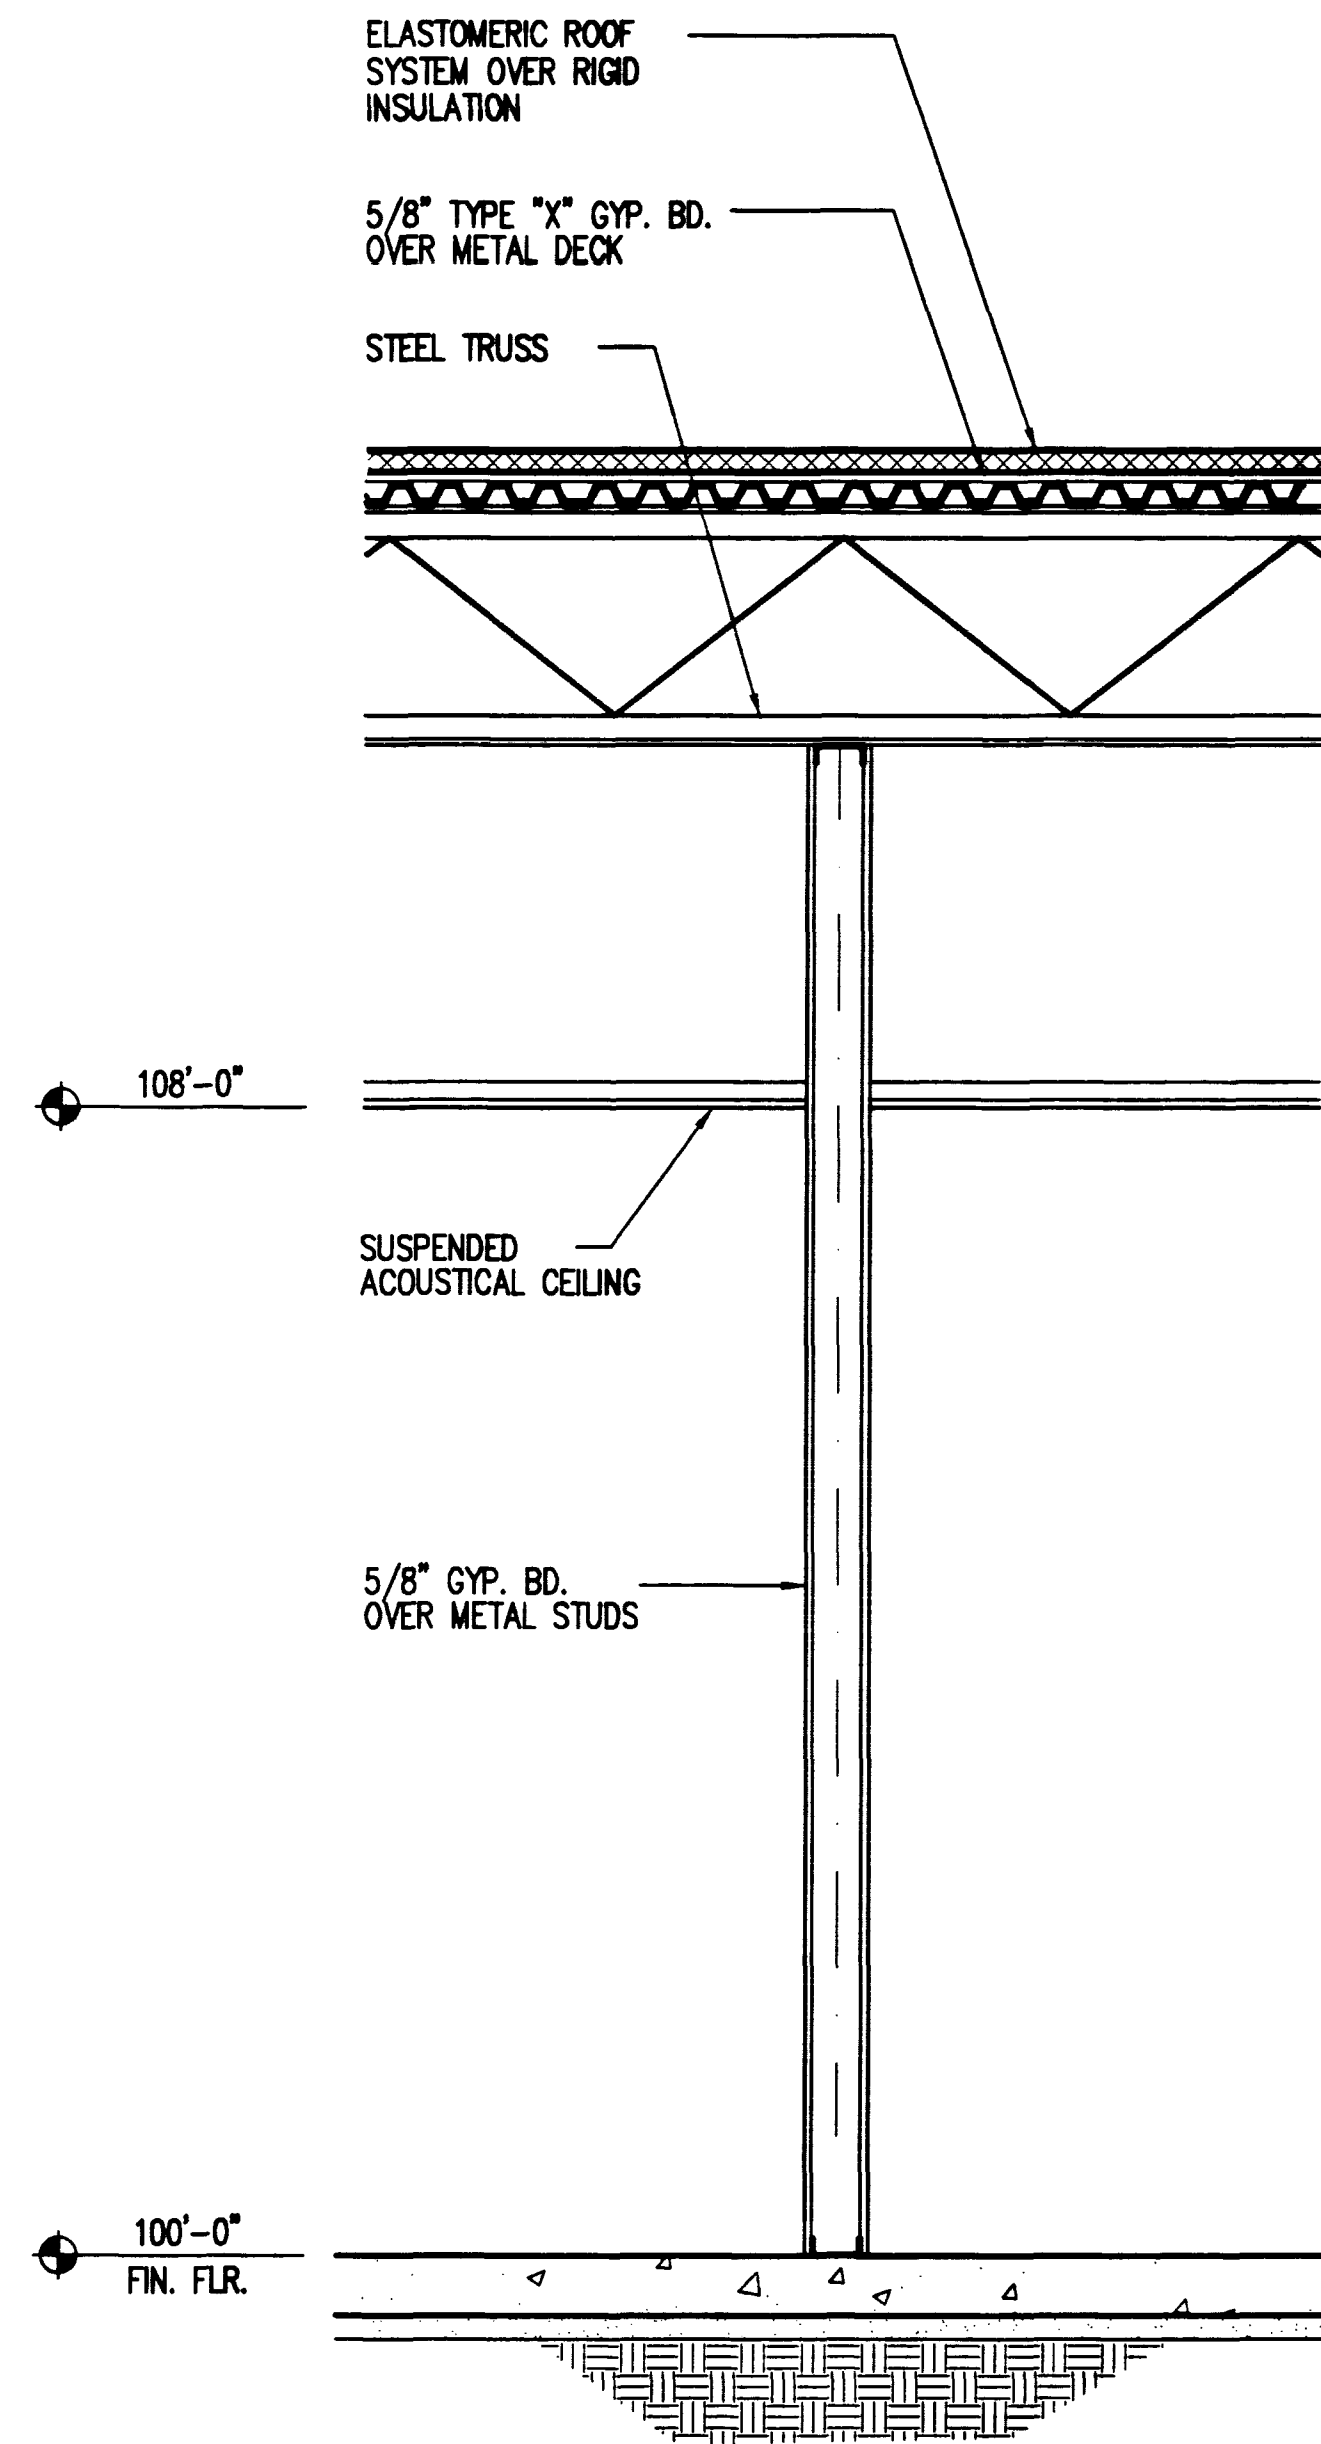


INTERIOR WALL SECTION
SCALE: 3/4"=1'-0" (BRIEFING/LOCKER ROOM) **4**

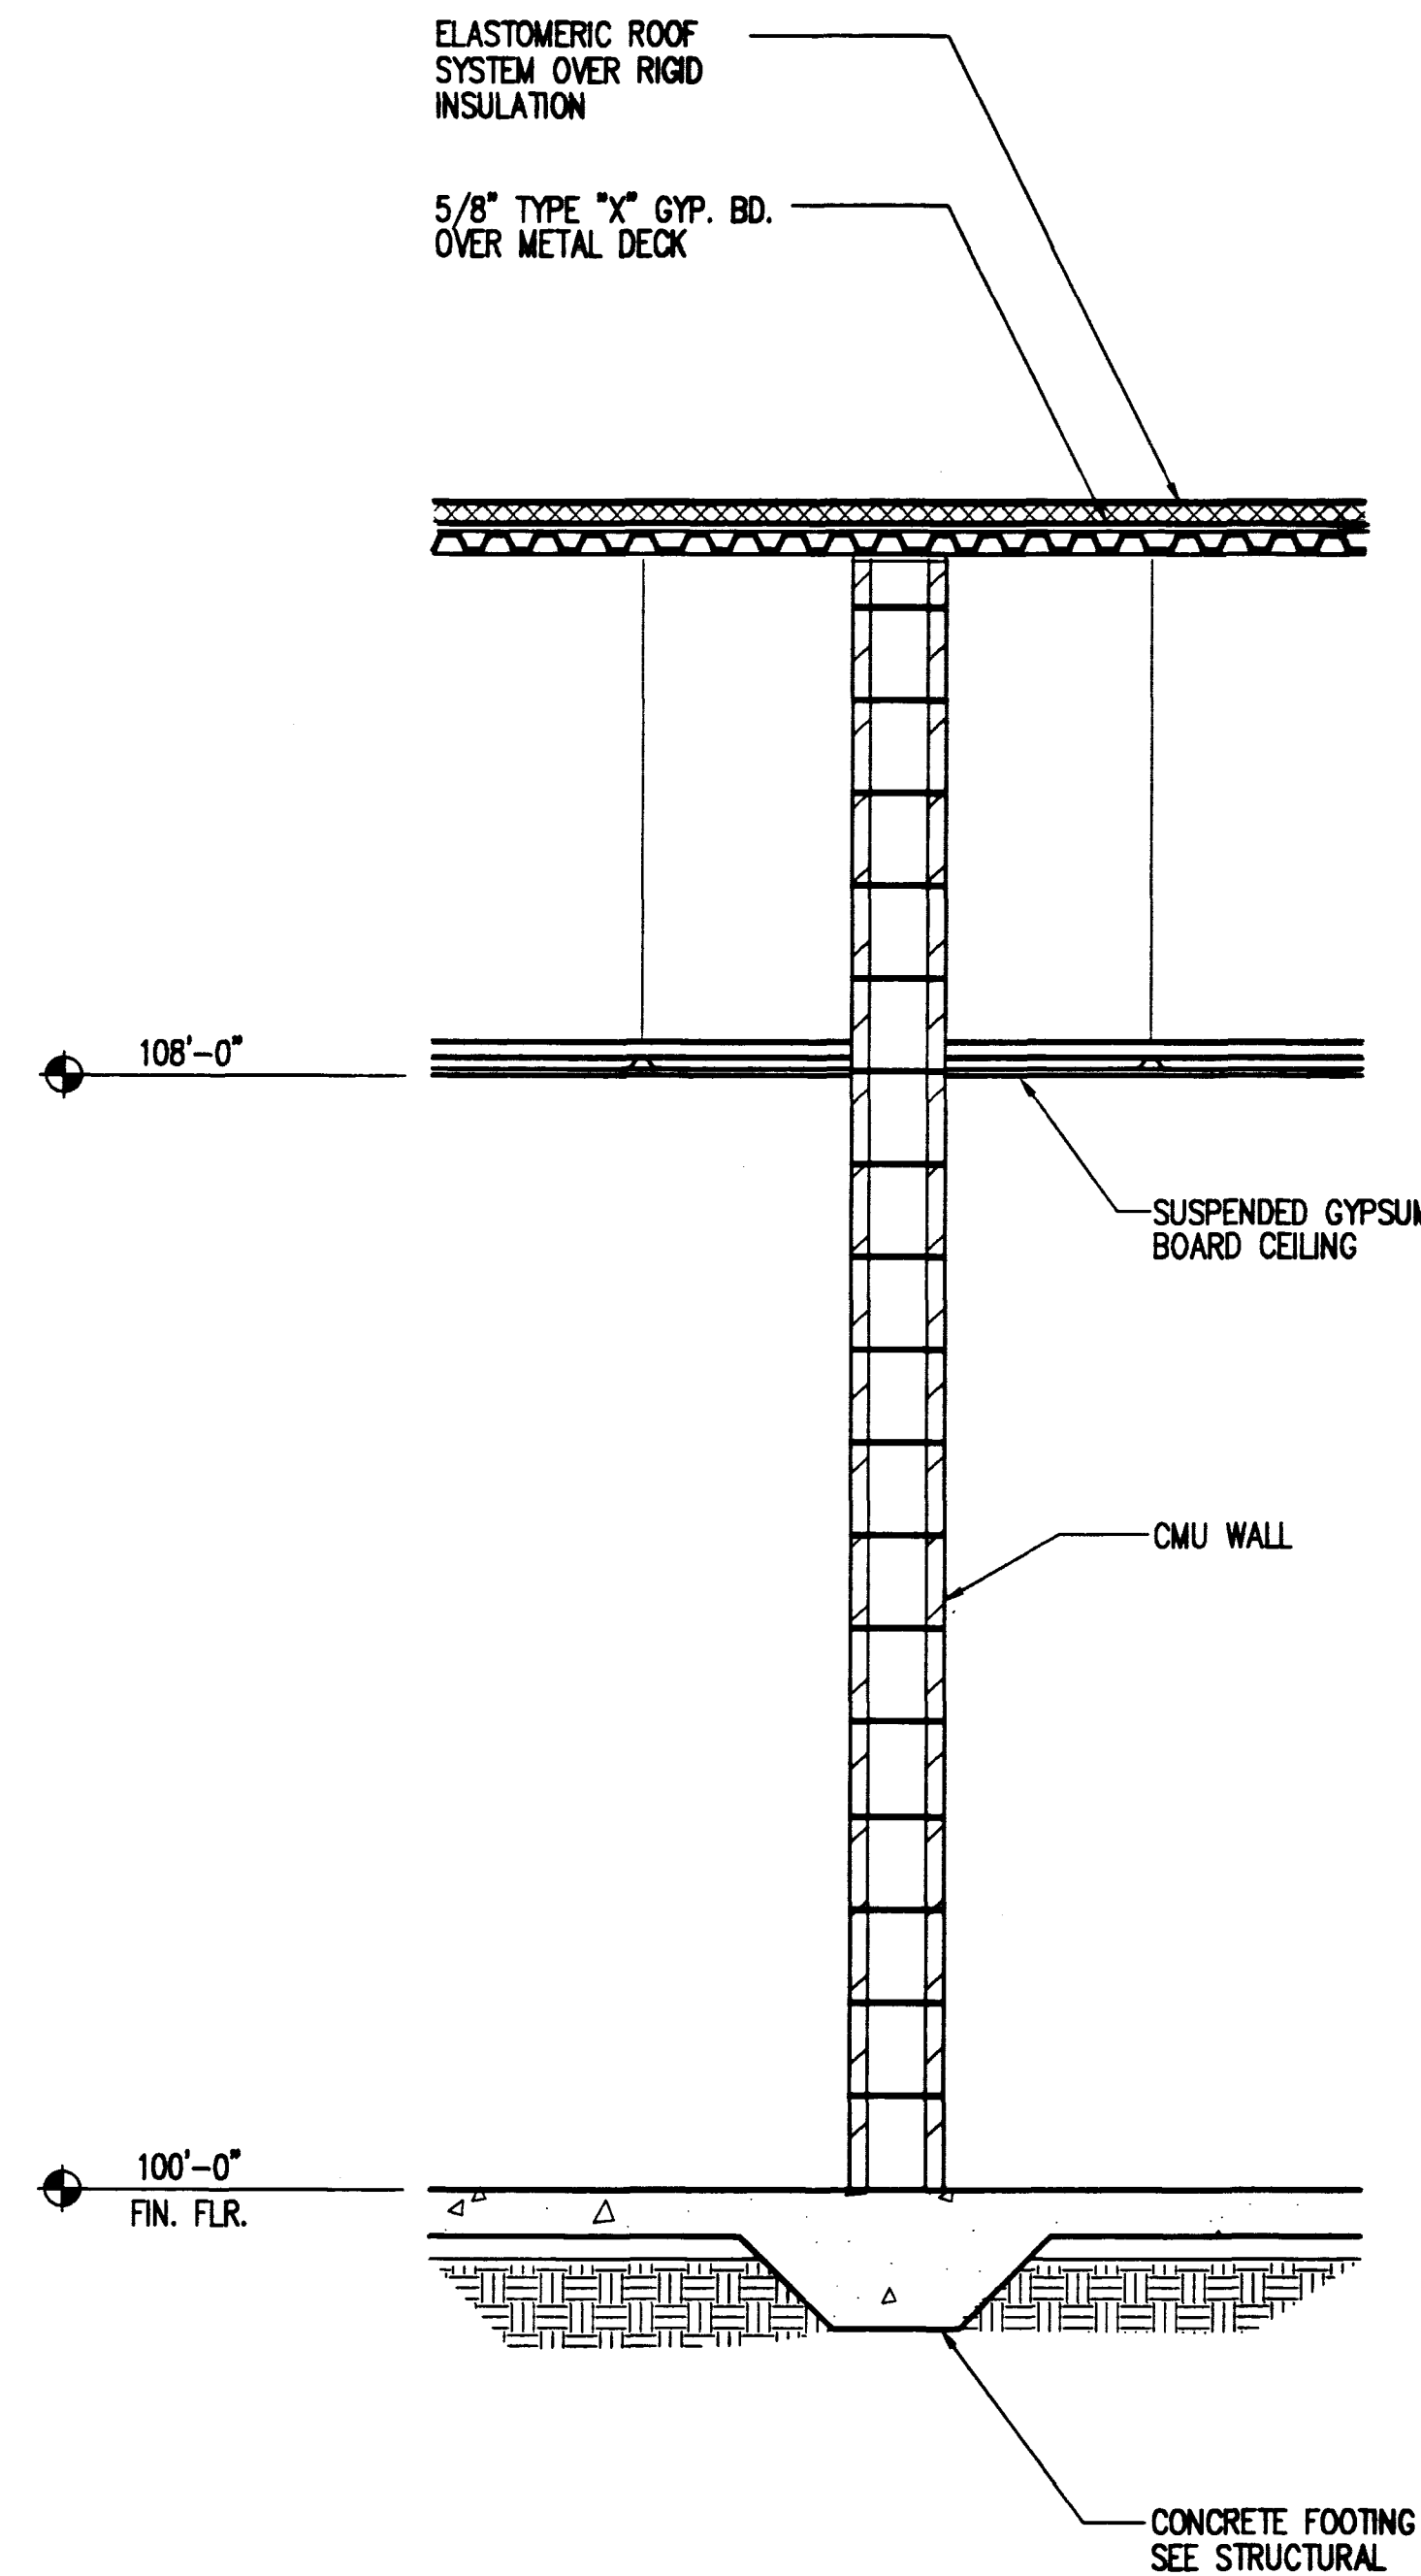

INTERIOR WALL SECTION
SCALE: 3/4"=1'-0" (MALE HOUSING UNIT) **3**

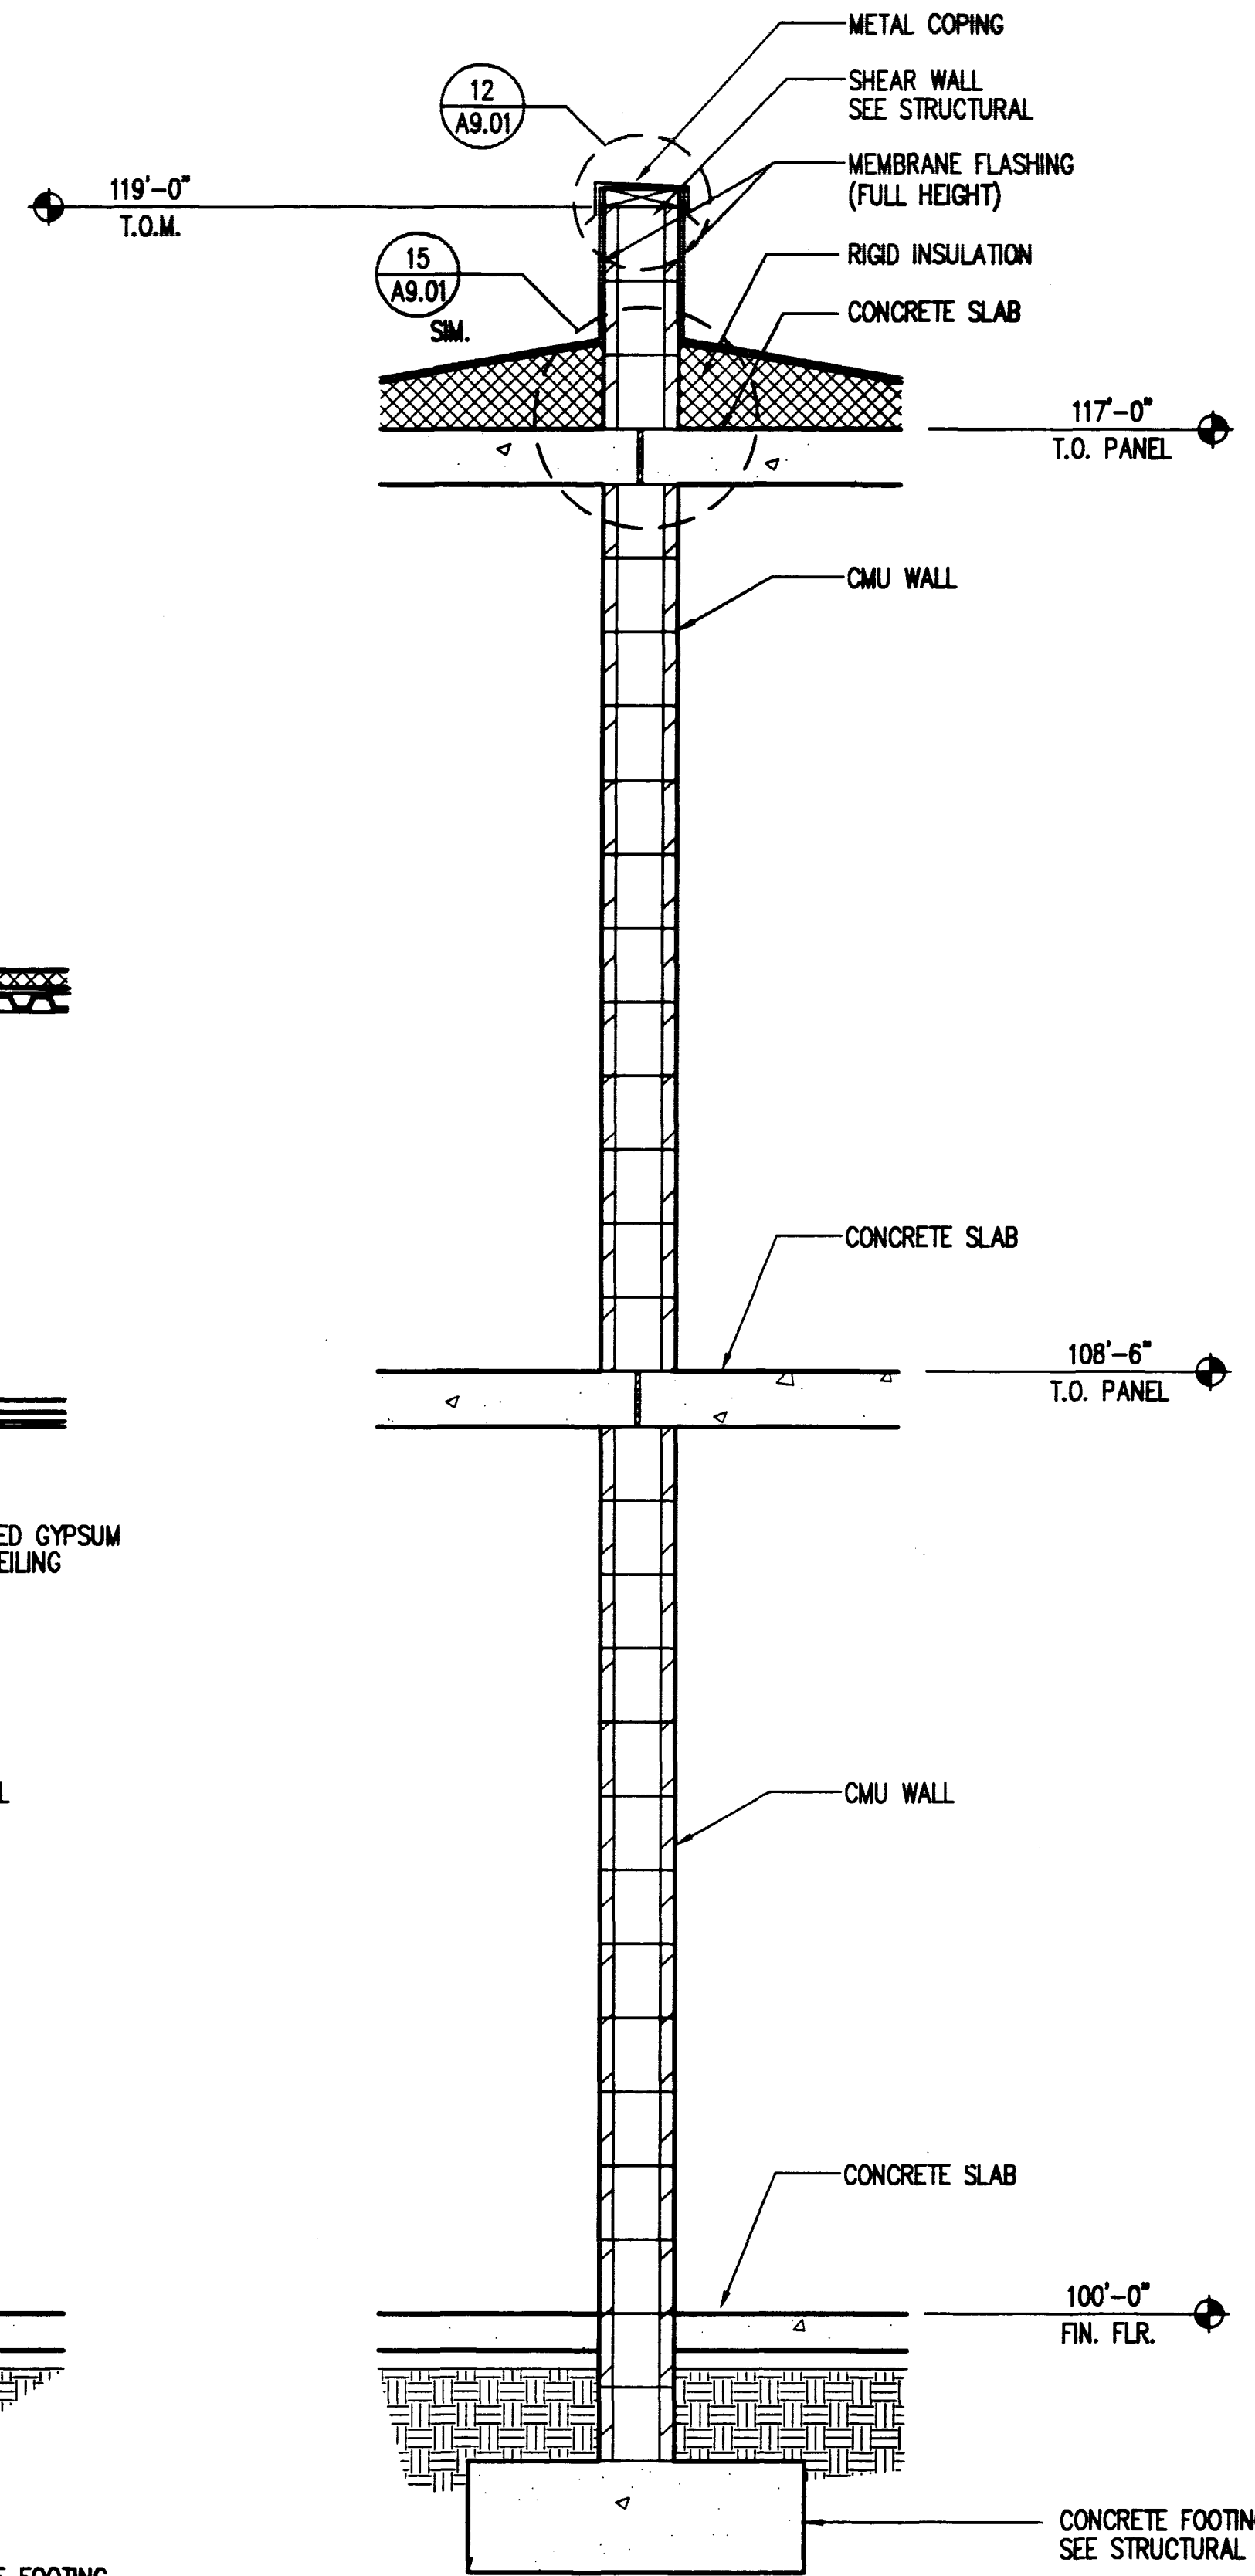

INTERIOR WALL SECTION
SCALE: 3/4"=1'-0" (MALE HOUSING UNIT) **2**

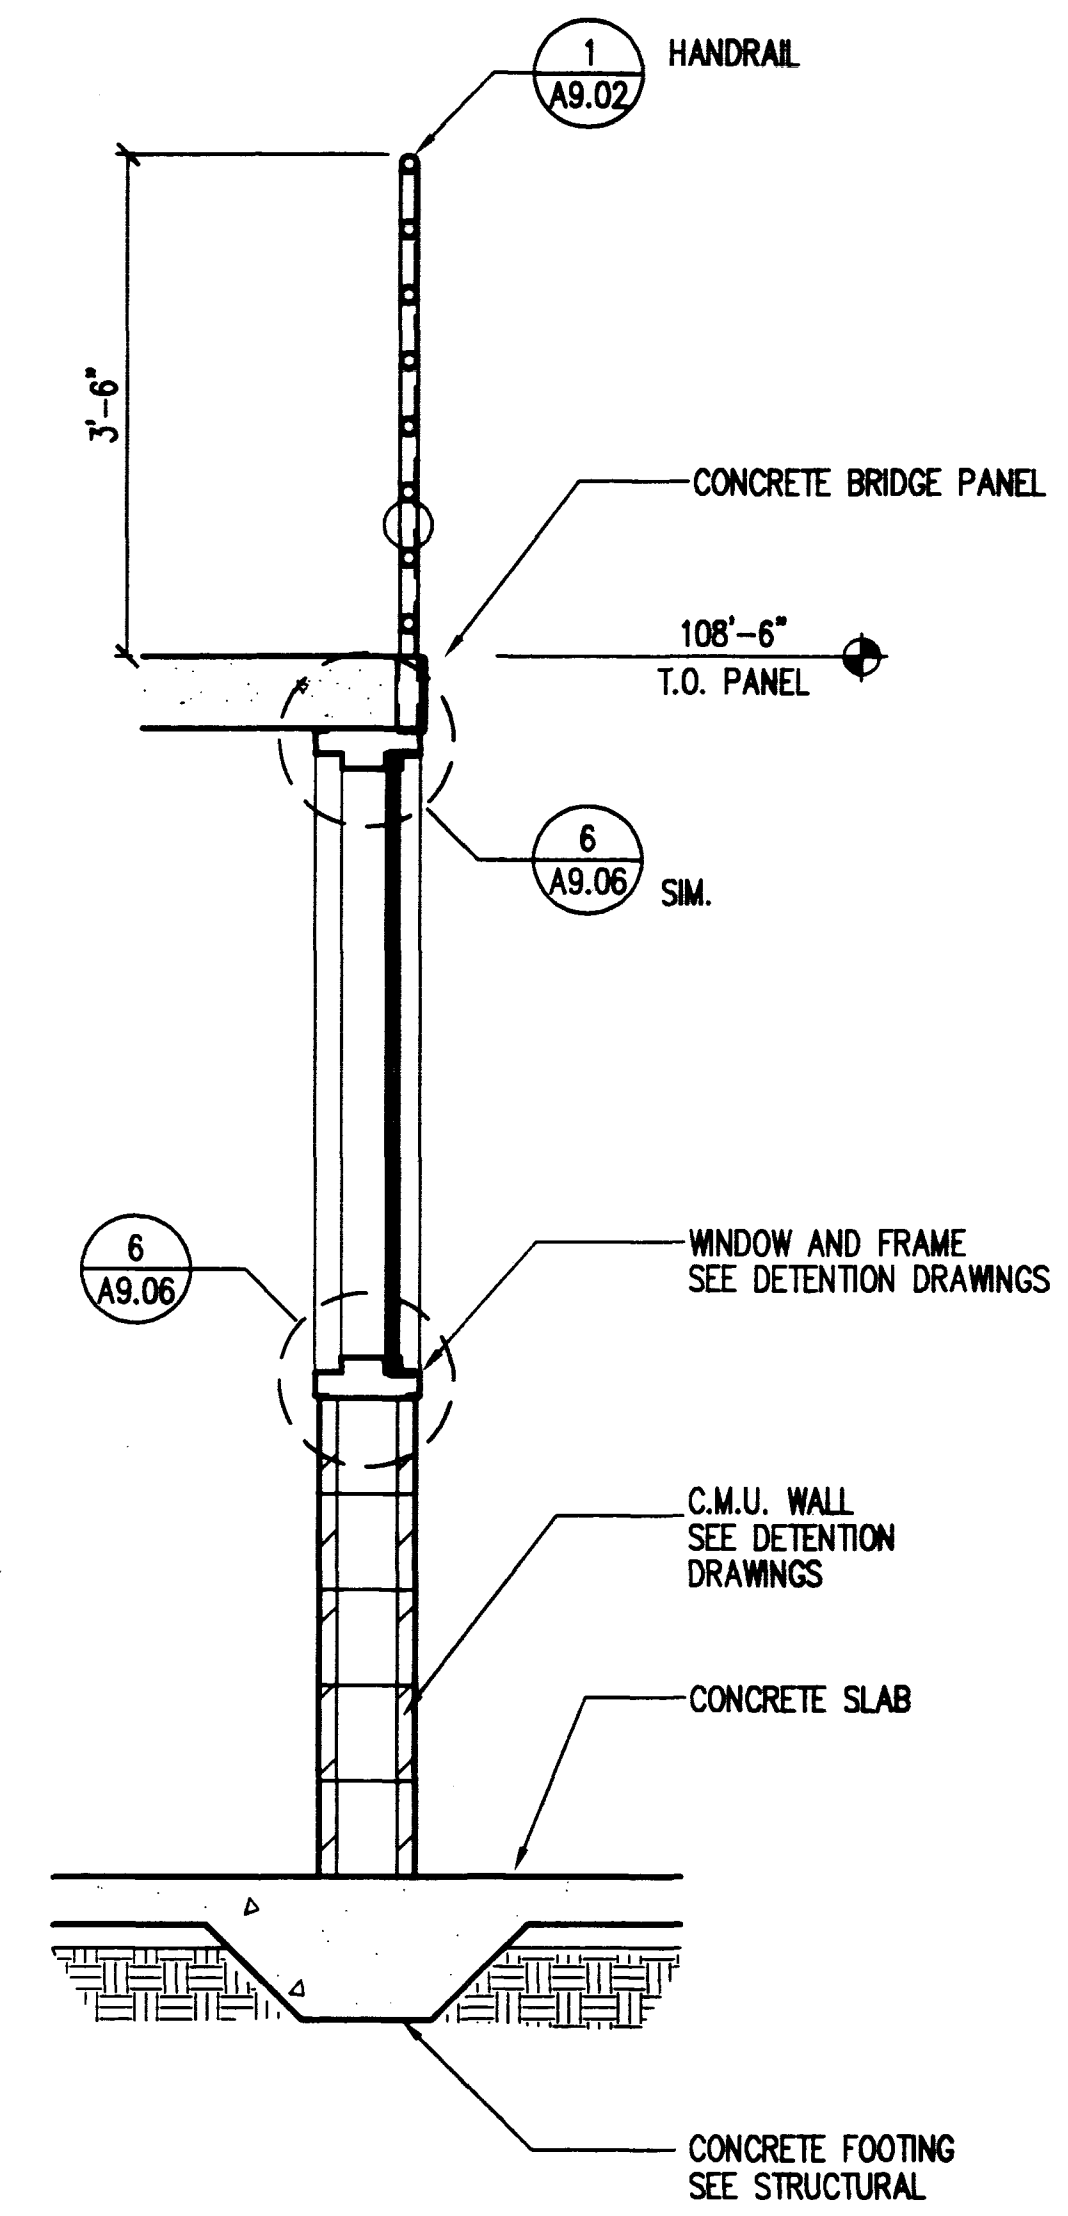

INTERIOR WALL SECTION
SCALE: 3/4"=1'-0" (MALE HOUSING UNIT) **1**


AS BUILT DRAWING
DATE 10/1/97

DRAWING ISSUE LOG			
SYM.	DESCRIPTION	DATE	BY
DO NOT SCALE DRAWINGS			

All designs, arrangements and plans indicated or presented by this drawing, as instruments of service, are owned by and the property of DOMINGO CAMBEIRO CORPORATION. To alter these documents for any project by anyone other than the original architect is a violation of NRS 623. The plans and/or specifications shall be restricted to the original site for which they were prepared and publication thereof is expressly limited to such use. Reproduction, publication or re-use by any method in whole or in part, is prohibited. None of such designs, arrangements or plans shall be used by or disclosed to any person, firm, agency, or corporation without the written permission of DOMINGO CAMBEIRO CORPORATION. Verbal contact with these plans and specifications shall constitute prima facie evidence of acceptance of these restrictions.

© DOMINGO CAMBEIRO CORPORATION 1996

SEAL

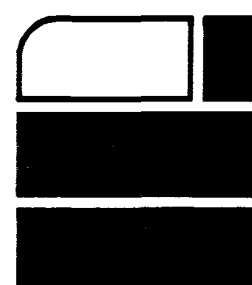

Domingo Cambeiro Corporation
ARCHITECTURE • ENGINEERING • PLANNING • INTERIORS
3555 PECOS-MCLEOD IC. LAS VEGAS, NEVADA 89121-3805 (702) 732-0084 FAX 732-9802

REVISIONS			
REV	DESCRIPTION	DATE	BY

PROJECT

**CITY OF LAS VEGAS
DETENTION FACILITY HOUSING EXPANSION**

3100 EAST STEWART AVENUE
LAS VEGAS, NEVADA

INTERIOR WALL SECTIONS

DRAWING NO.
A7.11

DATE
5-13-96

JOB NO. 95260
FILE NO. 9280A711.DWG

