


## NOTES

\*1 SEE GENERAL NOTES ON SHEET E-1.

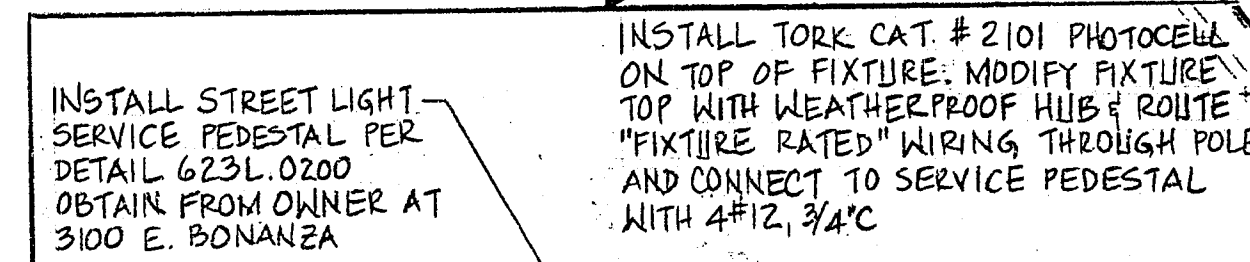

INSTALL STREET LIGHT -  
SERVICE PEDESTAL PER  
DETAIL 623L.0200  
OBTAIN FROM OWNER AT  
3100 E. BONANZA

INSTALL TORK CAT. # 2101 PHOTOCELL  
ON TOP OF FIXTURE. MODIFY FIXTURE  
TOP WITH WEATHERPROOF HUB & ROUTE  
"FIXTURE RATED" WIRING THROUGH POLE  
AND CONNECT TO SERVICE PEDESTAL  
WITH 4#12, 3/4"

-INTERCEPT EXISTING FEED TO SITE LIGHTS  
AND INSTALL HANDHOLE

EXISTING POLE  
TOP LIGHT (TYP.)

EXISTING STREET  
LIGHTING CONTROL  
TO BE REMOVED  
BY CITY.

EXISTING PANEL LPI  
INSTALL TIME CLOCK  
AND CONTACTOR FOR  
CKT LPI-27

2 POLE TO BE  
REMOVED BY NPC.

EXTEND 2#8, 1#10 IN  
EXISTING CONDUIT TO  
PANEL LPI, CKT-27

IRRIGATION  
CONTROLLER,  
SEE LANDSCAPE  
DWGS.

EXISTING J-BOX

NEW FIXTURE  
TYPE 3 SEE DETAIL  
2

STAIRWAY  
EXISTING RETAINING WALL

FIXTURE TYPE "F"  
(TYPE OF 4) CKT. 3

INSTALL NEW PULL BOXES  
FOR PEDESTRIAN MALL LTG.

NOTE II - SEE DETAILS FOR CIRCUITS - TYPE "B" CIRCUIT - I

NOTE  
TYPE 1 (TYP. 4)  
CKT. 1/2 C

TYPE A

IRRIGATION CONTROLLER CKT 9C

NOTE II  
TYPE "A" (TYP. 3)  
EKT. 1

ROUTING CONDUIT & WIRING  
ABANDONED AND REM

9 TO  
LOVED

INSTALL MYER STAT.# MEUGQ-M125 LVC STREET LIGHTING  
SERVICE PEDESTAL W/ CU BUS -120/240, 1# 3 WIRE  
PER DETAIL 623L 0200. INSTALL OWNER-FURNISHED  
TIME CLOCK CONNECTED TO LTG. CONTACTOR.  
INSTALL 120V 20A BKR AHEAD OF CONTACTOR  
(UNSWITCHED) FOR POWER TO IRRIGATION CONTROLLER

- INTERCEPT EXISTING, SITE LIGHTING CONDUIT  
AND EXTEND TO NEW LIGHTING SERVICE PEDESTAL  
WITH 2#2, 1#6, 1/4" C

-3#10, 1 1/4" C

SEE SHEET  
47

10, 3/4" C  
STALL IN CASING  
E SECTION A-A  
FEET 46

3#10,  
3/4" C

KWALL NOT

EXISTING  
RETAINING WALL

~~FIXTURE TYPE "F" (TYP)~~  
~~SEE LANDSCAPE~~  
~~DETAILS.~~

~~3#10, 3/4" C (1.1)~~

IRRIGATION  
CONTROLLER  
SEE LANDSCAPE  
DWGS.

INSTALL #10 IN EXISTING CONDUIT.  
COIL SUFFICIENT LENGTH INSIDE TRAFFIC  
CONTROLLER ON SOUTH SIDE OF STEWART  
TO EXTEND TO LIGHTING SERVICE PEDESTAL  
CONNECTION AT PEDESTAL WILL BE BY OTHERS

CONTRACT  
DRAWING  
APRIL 25, 1986

Drawing no. 48  
590-2D 5

# WORKS Engineering Design Division

## ELECTRICAL SITE LIGHTING PLAN

**Department of Public  
DOWNTOWN TRANSPORTATION CENTER  
OFFSITE IMPROVEMENTS**



Drawing no. 48  
590-2D 5

3-4-86

|                                   | Revisions | Date    |
|-----------------------------------|-----------|---------|
| △ REMOVE TYPE F FIXTURE AT ISLAND |           | 4-21-86 |
| △ ADD TYPE J FIXTURE              |           | 7-22-88 |
| △ REVISE NOTE                     |           |         |

30-13-99