
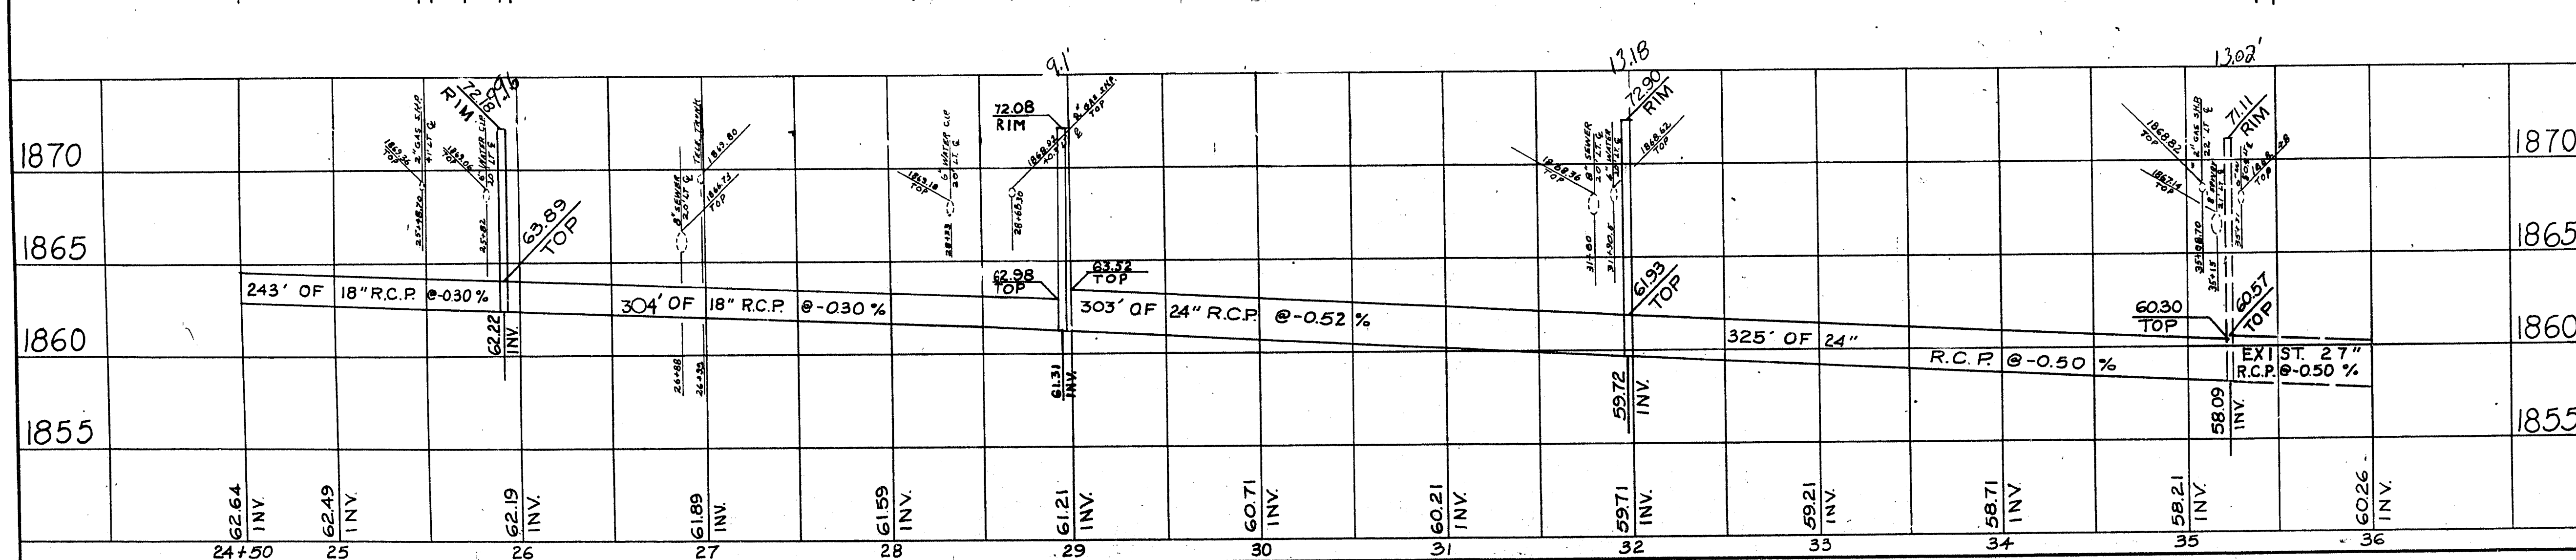


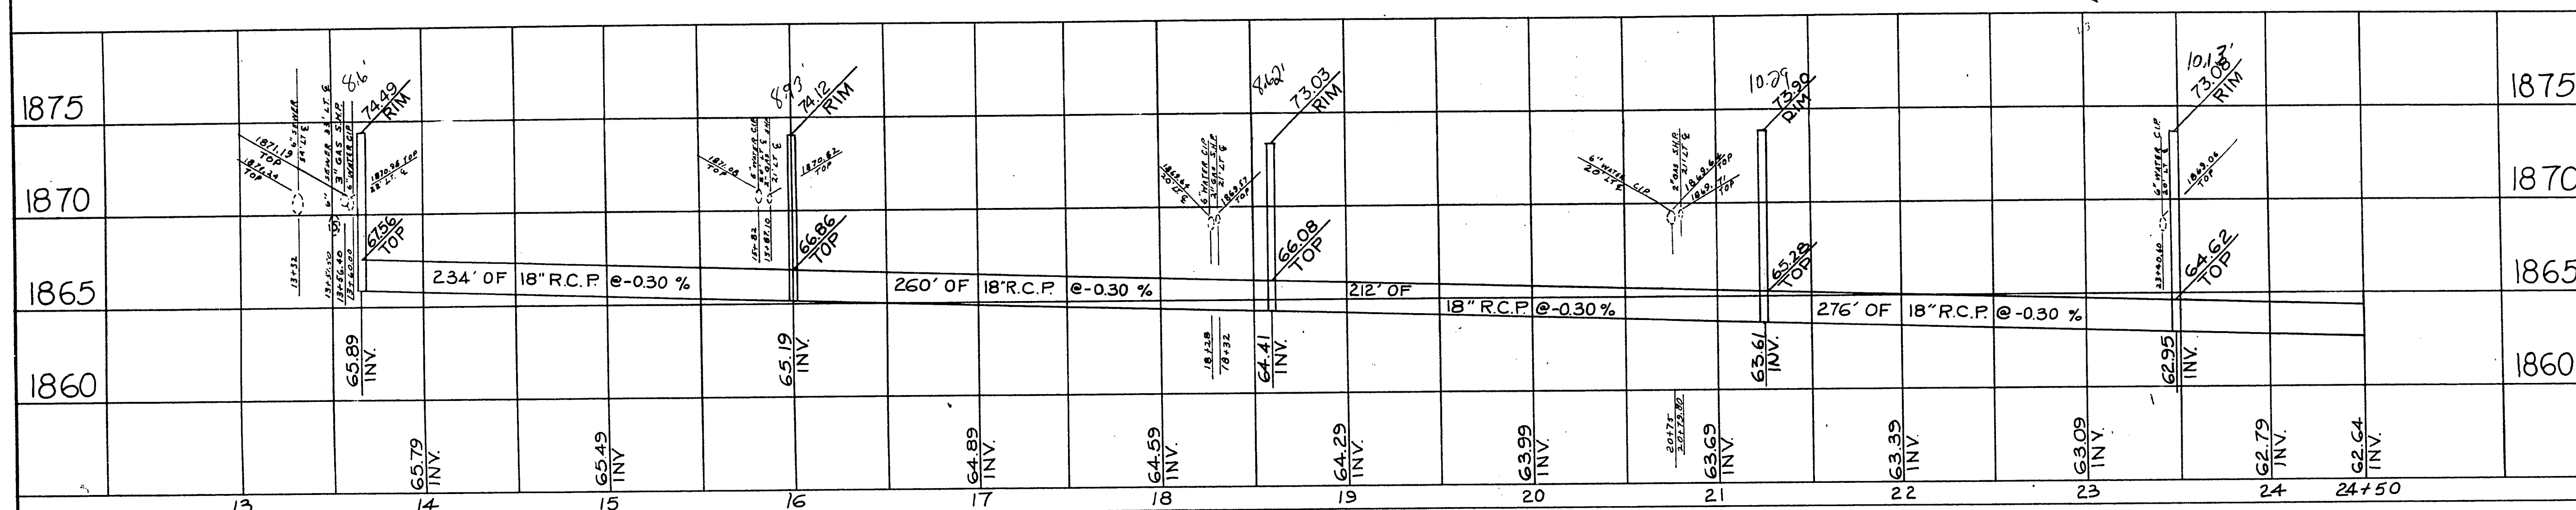

As Built Print.
TWS Const.
13 Dec 74
J. A. Alkner

EXISTING UTILITIES ARE LOCATED ON THE PLANS FOR THE CONVENIENCE OF THE CONTRACTOR ONLY. THE CONTRACTOR SHALL BEAR FULL RESPONSIBILITY FOR PROTECTION OF UTILITIES AND THE CITY BEARS NO RESPONSIBILITY FOR UTILITIES NOT SHOWN ON THE PLANS OR NOT IN THE LOCATION SHOWN ON THE PLANS.

**CONTRACT
DRAWING**

CITY OF LAS VEGAS NEVADA
DEPARTMENT OF PUBLIC WORKS
SERVICES DIVISION

STORM DRAIN PLAN & PROFILE
EASTERN AVENUE

W.O. NO. 7672		F.BK. NO. 68-4X	DATE	DRAWING NO.
SC.(H) "1" = 50'		SC.(V) "1" = 5'	11-9-72	107-V835A
DR. P. MEELY				FILE NO.
DR. E. R. BUSKIRK /				
APPROVED BY DIRECTOR OF PUBLIC WORKS				
<i>E. R. Buskirk</i>				
				SHEET 15 OF 30

SHEET 15 OF 30

17-4-4