


CONDUCTOR SCHEDULE		RUN									
CONDUCTOR TYPE	FUNCTION	1	2	3	4	5	6	7*	8		
#8 AWG	GROUND (GREEN)	1	1	1			2	1	1		
#2 AWG	TREE PIT LIGHTING ELECTRICAL SERVICE	2	2				4		2		
PULL ROPE	FUTURE CONDUCTORS		1	1	1	1					
#6 AWG	TREE PIT LIGHTING ELECTRICAL SERVICE			2							
#4 AWG	IRR. CTR. ELEC. SERVICE							2	2		
	CONDUIT SIZE	1 1/4"	2"	1 1/4" (E)	2" (E)	1 1/4"	1"	1 1/4"	2"	1 1/4" (E)	2" (E)

(E) EXISTING
 * CONDUIT RUN 7 SHALL BE PUSHED THRU EXIST. 4" PVC SLEEVE UNDER EXIST. DRIVEWAY. AND SHALL HAVE SEPARATE PULLBOXES SPACED AT INTERVALS NOT EXCEEDING 270'.

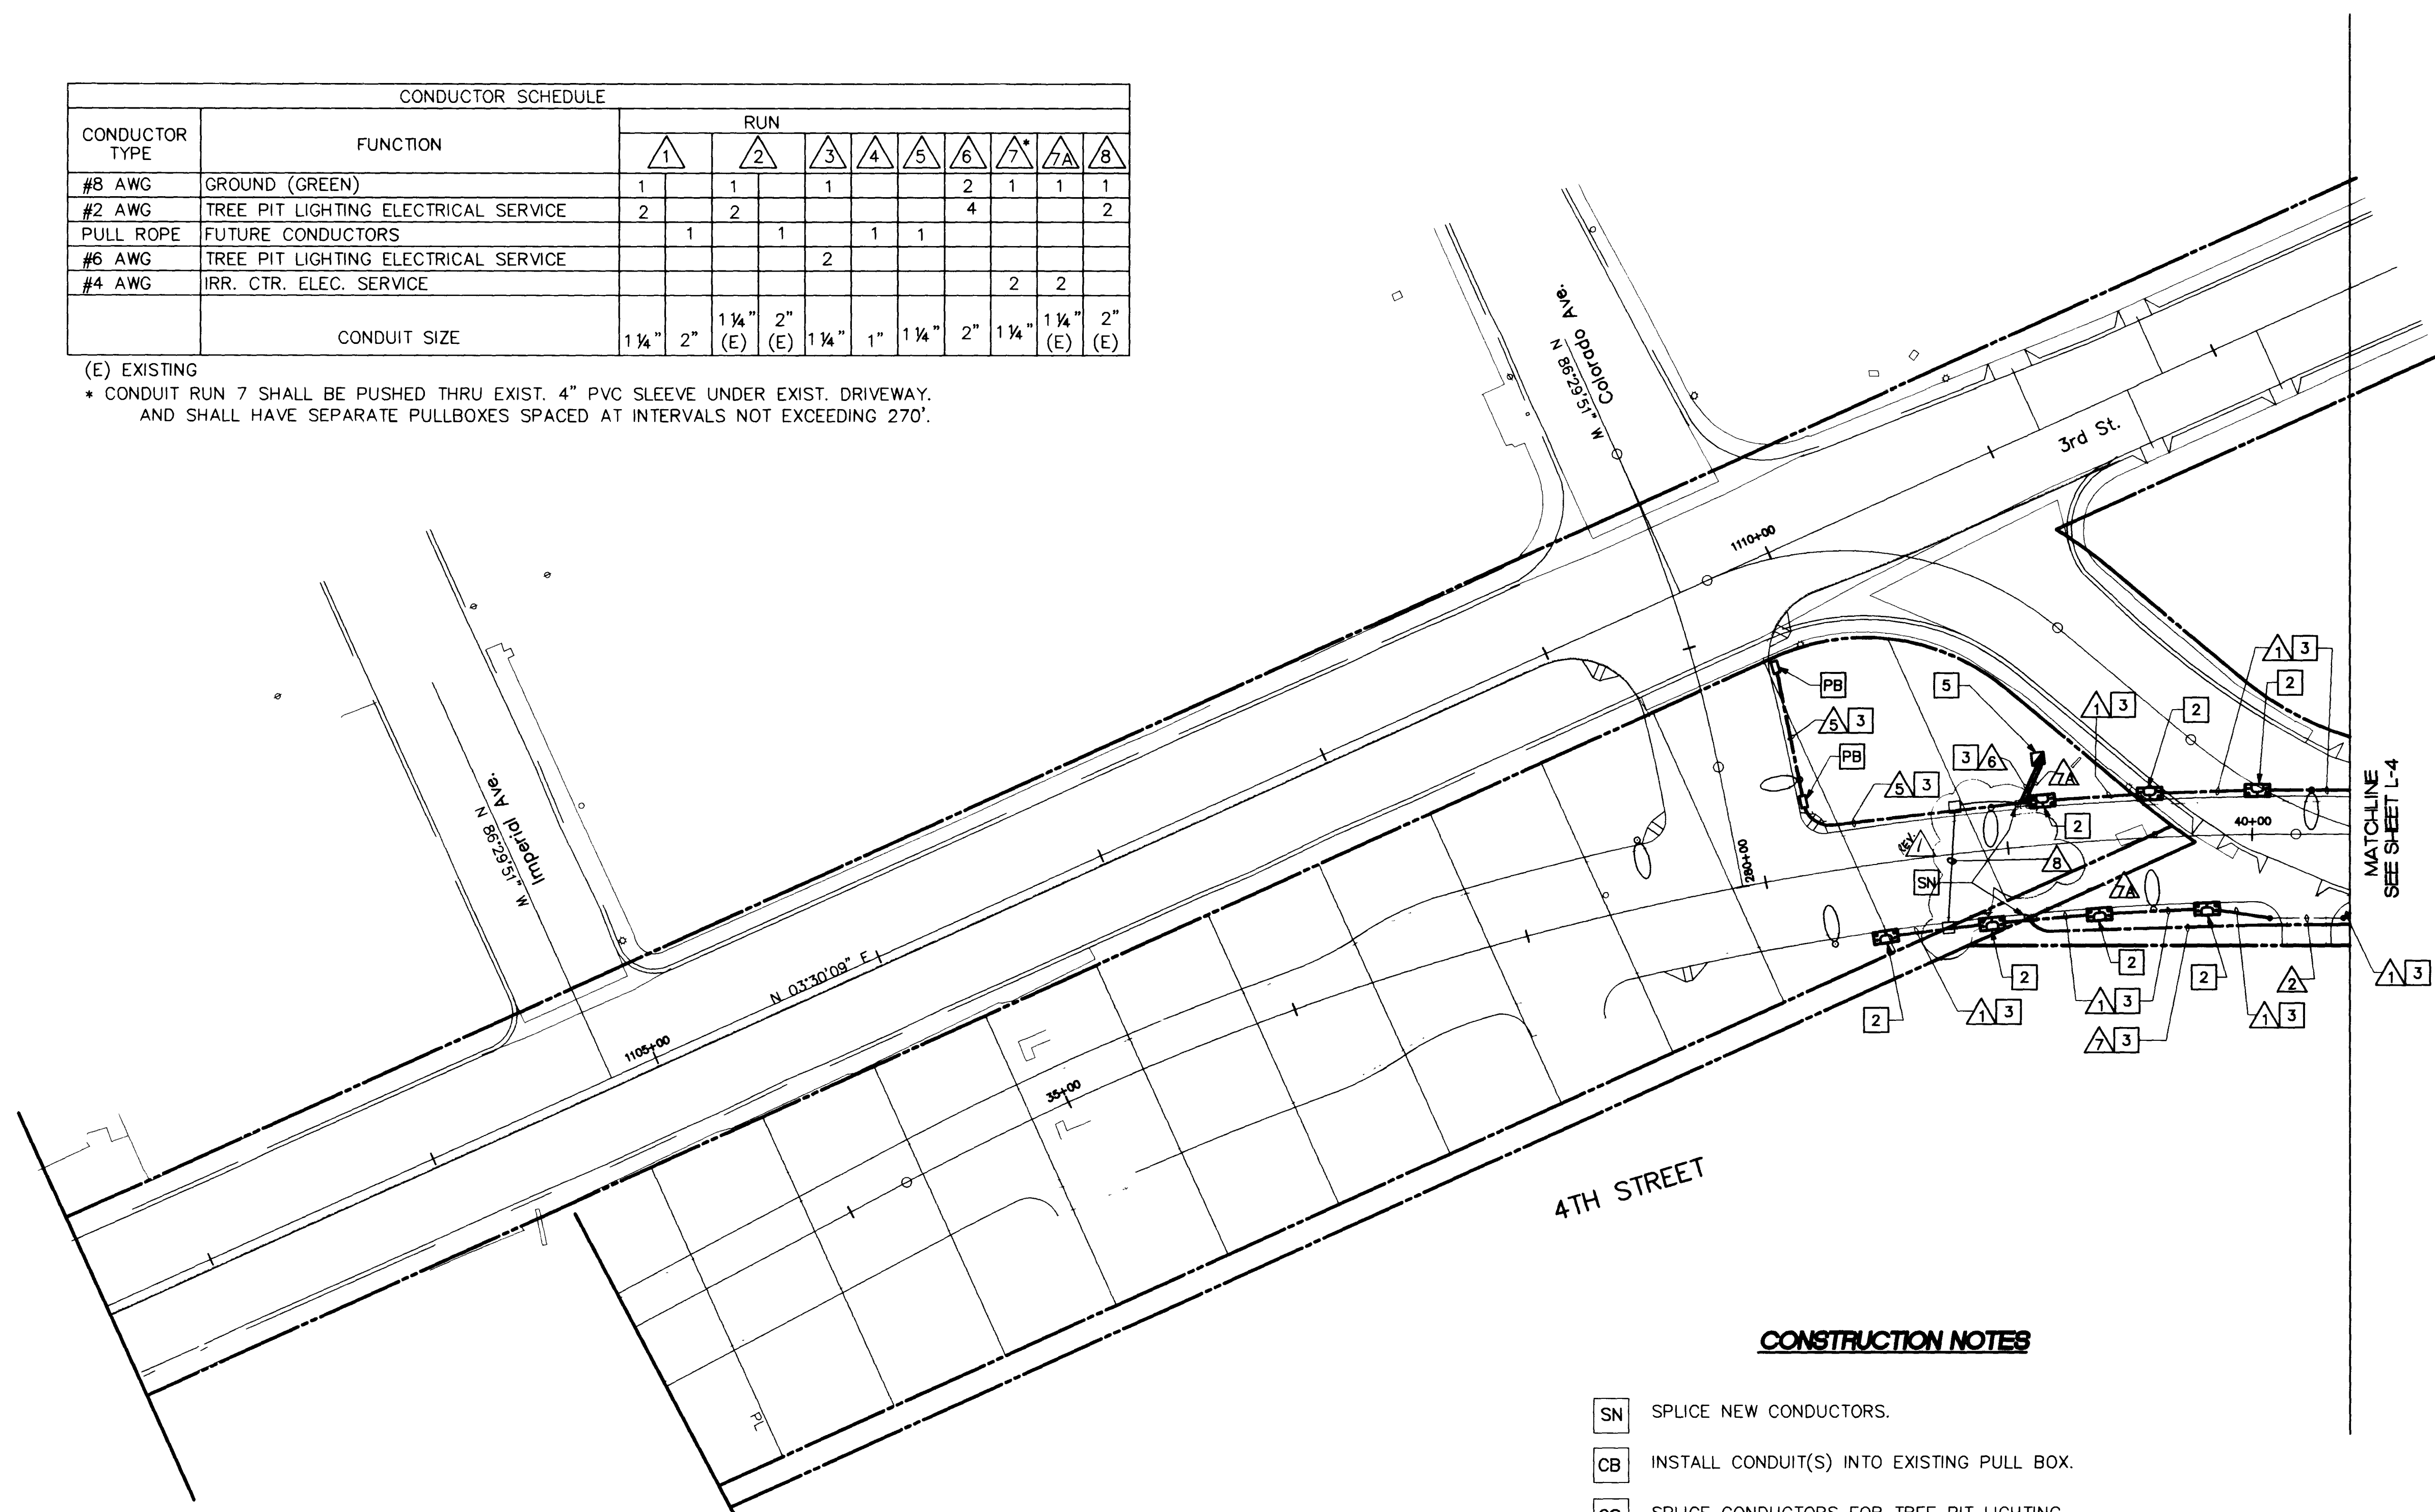


CONSTRUCTION NOTES

- SN SPLICE NEW CONDUCTORS.
- CB INSTALL CONDUIT(S) INTO EXISTING PULL BOX.
- CS SPLICE CONDUCTORS FOR TREE PIT LIGHTING.
- PB INSTALL NO. 3 1/2 PULL BOX UNLESS OTHERWISE SPECIFIED ON PLANS.
- ST STUB AND CAP CONDUIT.
- 2 REFER TO "CONDUIT AND PULL BOX LAYOUT DETAIL FOR TREE PIT LOCATIONS".
- 3 TRENCH CONDUIT(S) IN SOIL.
- 5 EXISTING 120V/240V, 1Ø, 3 WIRE, SINGLE METERED SERVICE WITH A 200A, 240V, 2P MAIN CB IN A PAD MOUNTED NEMA TYPE 3R ENCLOSURE. INSTALL THE FOLLOWING: ONE 20A, 120V, 1P BRANCH CB FOR IRRIGATION.



NO.	REVISIONS	DATE	BY
	REVISED CONDUIT AND PULL BOX LOCATIONS TO REFLECT AS-BUILTS.	7-28-97	CLV

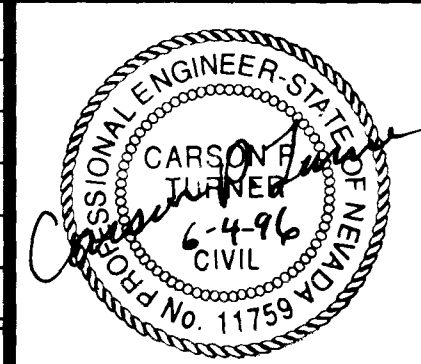

Kimley-Horn and Associates, Inc.
 Las Vegas, Nevada © 1996

DESIGNED BY JBF/JIO
 DRAWN BY JBF
 CHECKED BY JTC
 NOTE BOOK NO.



DOWNTOWN CORRIDOR IMPROVEMENTS
 CITY OF LAS VEGAS DEPT. OF PUBLIC WORKS
 LAS VEGAS, NEVADA
 CONTRACT 4 - 4TH STREET
 CHARLESTON BLVD. TO COLORADO AVE.

DATE 6/96
 SCALE 1" = 40'


DECORATIVE LIGHTING
 STA.37+50 TO STA.51+25

DWG. NO. 107-V-2288C
 FILE NO. 9903.02
 SHEET L-3
 SHEET 21 OF 22

269

SYMBOL		FUNCTION	NO.
1	▲	STREET LIGHT	1
2	▲	STREET LIGHT	2
3	▲	STREET LIGHT	3
61	▲	STREET LIGHT	61
62	▲	STREET LIGHT	62 </td
63	▲	STREET LIGHT	63
64	▲	STREET LIGHT	64
65	▲	STREET LIGHT	65
100	▲	STREET LIGHT	100

1. SYMBOL NO. 7 SHALL BE PLACED 8' FROM THE SIDEWALK EDGE OF THE STREET.
2. SYMBOL NO. 8 SHALL BE PLACED 12' FROM THE SIDEWALK EDGE OF THE STREET.

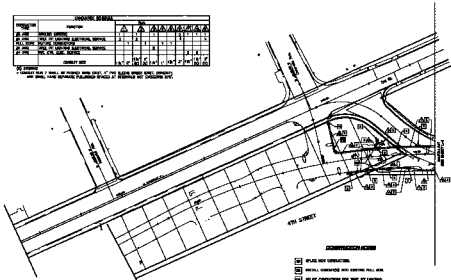

CONSTRUCTION NOTES

- 1. PLACE NEW CONNECTIONS.
- 2. INSTALL CONNECTIONS AND WIRING PER PLAN.
- 3. PLACE CONNECTIONS FOR WIRE FIT LIGHTING.
- 4. INSTALL NO. 8 1/2 P.W. BULB HOLDERS SPECIFIC LISTED IN PLAN.
- 5. STUB AND CAP SHORTS.
- 6. REFER TO SYMBOL AND PULL BOX LOCATED PER PLAN FOR WIRE FIT LIGHTING.
- 7. WIRING CONNECTED IN BOX.
- 8. EXISTING LIGHTING IS TO BE REMOVED BETWEEN STREET SIDE AND 20' FROM THE SIDE OF THE STREET. ALL EXISTING LIGHTING IS TO BE REMOVED PER PLAN. THE REMAINING LIGHTING IS TO BE REWired PER PLAN.



DATE	BY	REVISION



City-Vision and Associates, Inc.
 1400 La Jolla Village Drive, Suite 200
 San Diego, CA 92161
 (619) 594-1100

DESIGNED BY JAF/LSB
 DRAWN BY JAF
 CHECKED BY JAF
 DATE 08/10/00



DOWNTOWN CORRIDOR IMPROVEMENTS
 CITY OF SAN DIEGO DEPT. OF PUBLIC WORKS
 1415 VICTORIA AVENUE
 SAN DIEGO, CA 92161
 CONTRACT # - 4TH STREET
 CHARLESTON BLVD. TO COLLEGE AVE.

DATE 1/16
 SCALE 1" = 40'

DECORATIVE LIGHTING
 STA. 37+00 TO STA. 61+25

FILE NO. 157-10-25000
 FILE NO. 157000
 SHEET L-3
 TOTAL 8 OF 25