



MATCHLINE STA 59+00  
(SEE SHEET 3)

MATCHLINE STA 64+00  
(SEE SHEET 6)

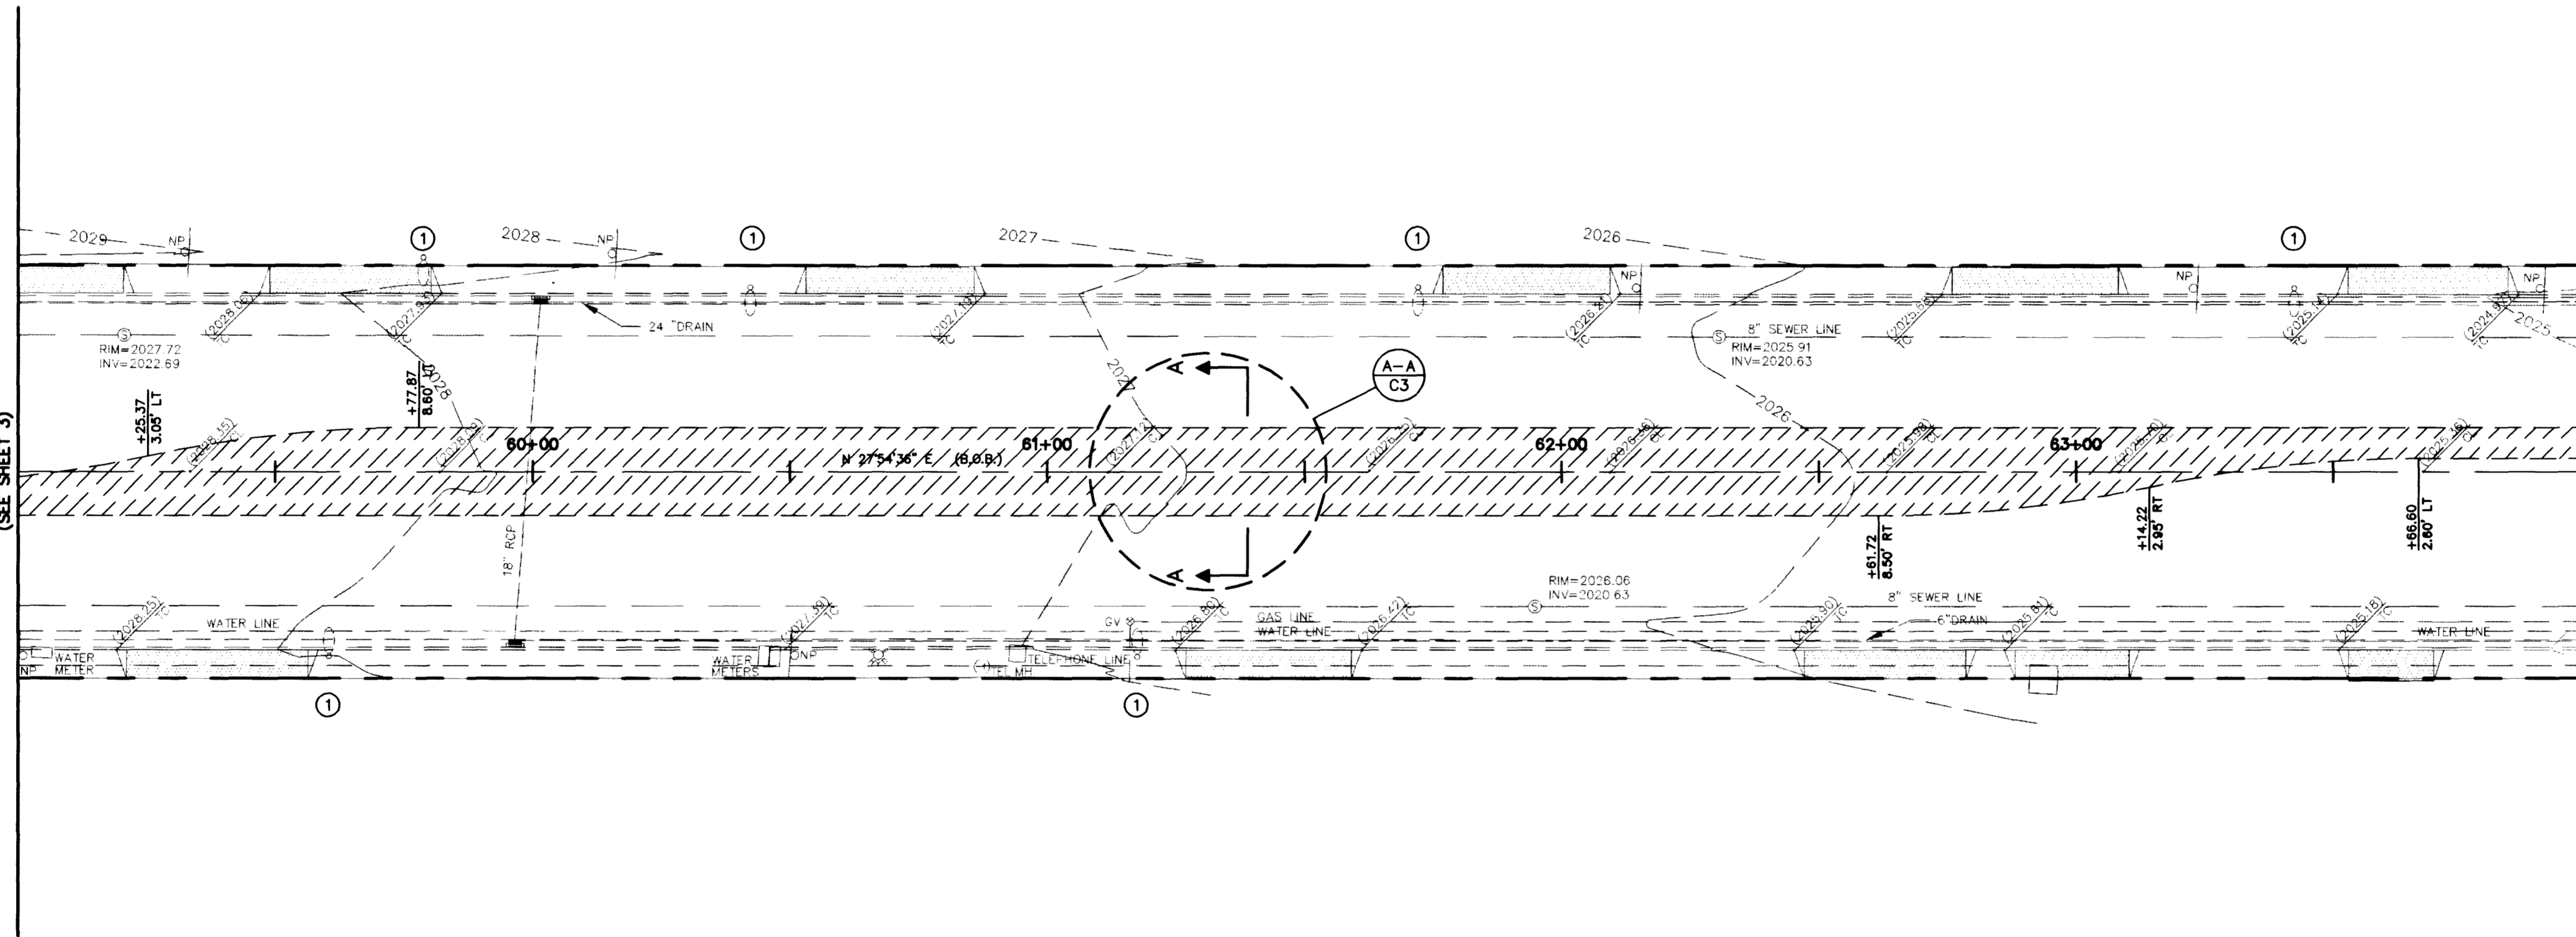


**LAS VEGAS BOULEVARD**

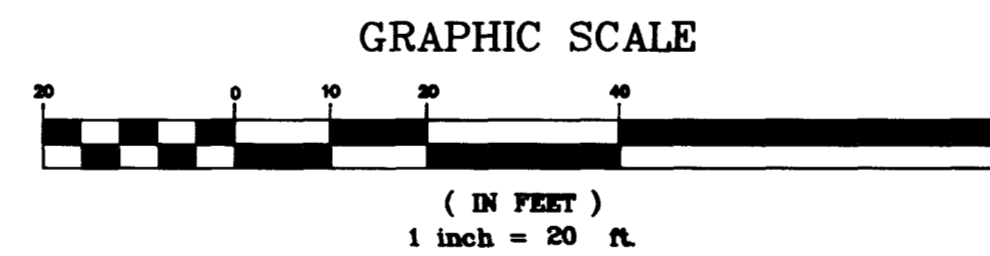

**UTILITY NOTE:**

THE LOCATION OF UNDERGROUND UTILITIES SHOWN HEREON HAS BEEN DETERMINED FROM SURFACE EVIDENCE OF THEIR EXISTENCE OR FROM INFORMATION OBTAINED FROM THE UTILITY COMPANIES. THE ENGINEER ACCEPTS NO LIABILITY FOR THE EXISTENCE OR NON-EXISTENCE OF UTILITY LINES. CONTRACTORS AND OTHERS USING THIS DRAWING MUST CONFIRM THE LOCATION OF UNDERGROUND LINES OR STRUCTURES WITH THE UTILITY COMPANIES PRIOR TO COMMENCING ANY EXCAVATION OR ORDERING OF MATERIALS.

CALL 1-800-227-2600 BEFORE ANY EXCAVATION TAKES PLACE.

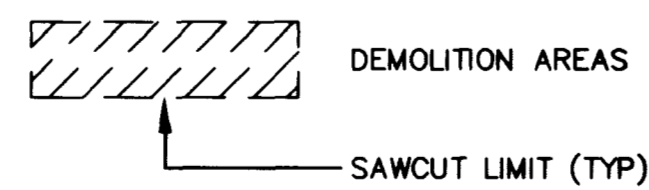


- ① STREET LIGHT ARM AND LUMINAIRE REMOVAL:  
REMOVE STREET LIGHT ARM AND LUMINAIRE, PULL FUSE IN BASE OF POLE AND BOLT PLATE OVER ARM OPENING

ANY INFORMATION OR DATA ON THIS DRAWING IS NOT INTENDED TO BE SUITABLE FOR CONSTRUCTION OR FOR ANY OTHER PURPOSE. ANY USER OF THIS DRAWING SHALL BE RESPONSIBLE FOR OBTAINING ALL NECESSARY PERMITS AND WITHOUT LIABILITY TO THE ENGINEER.


REVISIONS	DATE

JOB No. 10030002	DESIGNED BY RP/TEP	DRAWN BY DRF
SHEET No. C-4	DATE 10-28-96	CHECKED BY TEP
ENGINEERS		SURVEYORS
PLANNERS		PLANNERS
<b>POGGEMEYER DESIGN GROUP</b>		
2601 NORTH TENAYA WAY LAS VEGAS, NEVADA 89128 (702) 255-8100		

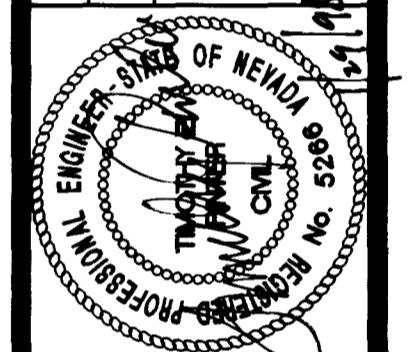

DEPARTMENT OF PUBLIC WORKS  
PROJECT: DOWNTOWN ENTRY CORRIDOR IMPROVEMENTS  
LAS VEGAS BLVD. REAURATION  
4TH STREET TO CHARLESTON BLVD.


DEMOLITION PLAN  
STA 59+00 TO 64+00

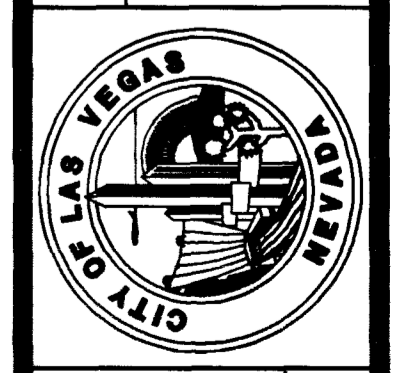

Call before you Dig.  
1-800-227-2600

RECORD DRAWING

DRAWING NO. C-4 4/28

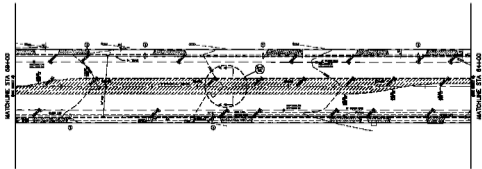

**LAS VEGAS BOULEVARD**



- ① SEE PLAN FOR ALL UTILITY SYMBOLS.  
② SEE PLAN FOR ALL UTILITY SYMBOLS.  
③ SEE PLAN FOR ALL UTILITY SYMBOLS.

**UTILITY NOTES**

1. ALL UTILITIES SHOWN ARE BASED ON RECORD DRAWINGS AND FIELD SURVEY DATA.  
2. THE LOCATION AND DEPTH OF UTILITIES ARE APPROXIMATE.  
3. THE DEPTH OF UTILITIES IS BASED ON RECORD DRAWINGS AND FIELD SURVEY DATA.  
4. THE DEPTH OF UTILITIES IS BASED ON RECORD DRAWINGS AND FIELD SURVEY DATA.  
5. THE DEPTH OF UTILITIES IS BASED ON RECORD DRAWINGS AND FIELD SURVEY DATA.

ISSUED DRAWING



DATE	BY	CHECKED BY	APPROVED BY
01/15/10	J. L. ...	J. L. ...	J. L. ...
<p>DEPARTMENT OF PUBLIC WORKS          UTILITY MAIN CHANGES          INTERSECTION          LAS VEGAS BOULEVARD          AND STATE STREET</p>			
<p>ISSUED DRAWING          01/15/10</p>			

NO.	DATE	BY	REVISION
1	01/15/10	J. L. ...	ISSUED DRAWING