


LAS VEGAS BOULEVARD

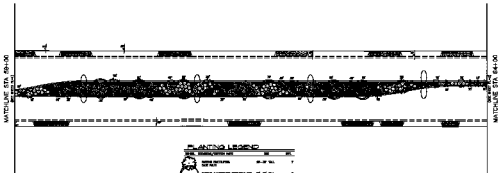

NOTE: ALL PLANTING SHALL BE DONE IN ACCORDANCE WITH THE CITY OF LAS VEGAS PLANTING SPECIFICATIONS AND THE STANDARD SPECIFICATIONS FOR PUBLIC WORKS, LATEST EDITION. PLANTING SHALL BE DONE IN ACCORDANCE WITH THE CITY OF LAS VEGAS PLANTING SPECIFICATIONS AND THE STANDARD SPECIFICATIONS FOR PUBLIC WORKS, LATEST EDITION. PLANTING SHALL BE DONE IN ACCORDANCE WITH THE CITY OF LAS VEGAS PLANTING SPECIFICATIONS AND THE STANDARD SPECIFICATIONS FOR PUBLIC WORKS, LATEST EDITION.

PLANTING LEGEND

SYMBOL	DESCRIPTION	QUANTITY	UNIT
	10" DBH PALM TREE	10	EA
	8" DBH PALM TREE	10	EA
	6" DBH PALM TREE	10	EA
	10" DBH PALM TREE	10	EA
	8" DBH PALM TREE	10	EA
	6" DBH PALM TREE	10	EA
	10" DBH PALM TREE	10	EA
	8" DBH PALM TREE	10	EA
	6" DBH PALM TREE	10	EA
	10" DBH PALM TREE	10	EA
	8" DBH PALM TREE	10	EA
	6" DBH PALM TREE	10	EA

DEPARTMENT OF PUBLIC WORKS
 PLANNING DIVISION
 225 N. LAS VEGAS BLVD.
 LAS VEGAS, NV 89101

PROJECT NO. 10-10-10
 DRAWING NO. 10-10-10-10
 DATE: 10-10-10

PREPARED BY: [Name]
 CHECKED BY: [Name]
 APPROVED BY: [Name]

TITLE: [Title]

RECORD DRAWING