

ESTIMATE OF QUANTITIES

(QUANTITIES, SHOWN HEREON, ARE APPROXIMATE ONLY AND ARE SUBJECT TO INCREASE OR DECREASE)

TO BE CONTRACTED


REVISIONS
 DATE
 AS BUILT

ITEM NO.	TOTAL	UNIT	ITEM
202 0120	2.00	EACH	REMOVE AND RESET FIRE HYDRANT ASSEMBLY
202 0128	3 4.00	EACH	REMOVAL OF WATER METER ASSEMBLY
202 0316	36.00	EACH	REMOVAL OF LIGHT POLE
202 0328	2.00	EACH	REMOVAL OF DROP INLET
202 1152	26,325.00	SQ. YD.	REMOVAL OF BITUMINOUS SURFACE (COLD MILLING)
202 1212	160.00	SQ. YD.	REMOVAL OF SIDEWALK
202 1350	40,120.00	SQ. FT.	CLEAN SIDEWALK
203 0508	3,890.00	CU. YD.	ROADWAY EXCAVATION
212 0020	2,420.00	EACH	PLANTS (GROUP A-1)
212 0028	1,506.00	EACH	PLANTS (GROUP A-5)
212 0088	1.00	LS	PLANT ESTABLISHMENT WORK
212 0200	31.00	EACH	PALM TREE (A)
212 0201	55.00	EACH	PALM TREE (B)
212 0202	19.00	EACH	PALM TREE (C)
212 0203	22.00	EACH	PALM TREE (D)
212 0207	15.00	EACH	PALM TREE (E)
212 1000	1.00	ACRE	SITE PREPARATION
212 1060	2,337.00	SQ. YD.	GRANITE MULCH
213 0036	4,502.00	EACH	SOAKER VALVE
213 0104	1.00	EACH	CENTRAL CONTROL COMPUTER
213 0136	1.00	EACH	TWENTY-FOUR (24) STATION AUTOMATIC CONTROLLER
213 0142	23.00	EACH	DRIP VALVE ASSEMBLY
213 0204	1.00	LS	ADJUST SPRINKLER SYSTEM
213 1004	27,000.00	LIN. FT.	1/2-INCH POLYVINYL CHLORIDE PIPE (FLEXIBLE)
213 1032	3,000.00	LIN. FT.	3/4-INCH POLYVINYL CHLORIDE PIPE
213 1052	2,900.00	LIN. FT.	2-INCH POLYVINYL CHLORIDE PIPE
213 1376	22.00	EACH	1-INCH TWO-PIECE QUICK-COUPLER VALVE
213 1476	23.00	EACH	1-INCH ELECTRIC CONTROL VALVE
213 1488	1.00	EACH	2-INCH ELECTRIC CONTROL VALVE
213 1546	1.00	EACH	WATER METER ASSEMBLY (2-INCH)
213 1624	1.00	EACH	2-INCH BACKFLOW PREVENTER ASSEMBLY (TYPE B)
213 1648	1.00	EACH	60-INCH BACKFLOW PREVENTER COVER

ITEM NO.	TOTAL	UNIT	ITEM
302 0500	900 940.00	TON	TYPE 1 CLASS B AGGREGATE BASE
401 0500	30.00	TON	MINERAL FILLER
402 0572	440.00	TON	PLANTMIX BITUMINOUS SURFACE AGGREGATE (TYPE 2)
402 0648	87.00	TON	ASPHALT CEMENT, GRADE AC-30 PG 70-16 TYPE II AC-30 OPEN GRADE
402 0660	1,510.00	SQ. YDS.	PLANTMIX MISCELLANEOUS AREA
403 0548	1,119.00	TON	PLANTMIX BITUMINOUS OPEN-GRADED SURFACE AGGREGATE
405 0516	77.00	TON	EMULSIFIED ASPHALT, TYPE SS-1H (DILUTED)
603 0520	79.00	LIN. FT.	18-INCH REINFORCED CONCRETE PIPE, CLASS III
609 0116	26.00	EACH	ADJUSTING COVERS (METHOD B)
609 0162	2.00	EACH	DROP INLET, TYPE 11
609 0544	2.00	EACH	48-INCH PRECAST REINFORCED CONCRETE MANHOLE (TYPE 1)
613 0588	5,030.00	LIN. FT.	CLASS A CONCRETE CURB (TYPE 3)
613 0732	760.00	LIN. FT.	CLASS A CONCRETE CURB AND GUTTER (TYPE 5)
613 0864	670.00	SQ. YD.	CLASS A CONCRETE SIDEWALK (4-INCH)
613 0956	20.00	SQ. YD.	CLASS A CONCRETE RAMP (4-INCH)
613 0988	224.00	LIN. FT.	CLASS A CONCRETE VALLEY GUTTER (SPECIAL)
613 0996	630.00	LIN. FT.	6-FOOT TEMPORARY FENCE
623 0072	28.00	EACH	NO. 3-1/2 PULL BOX
623 0076	16.00	EACH	NO. 5 PULL BOX
623 0080	5.00	EACH	NO. 7 PULL BOX
623 0088	1.00	EACH	JUNCTION BOX
623 0136	52.00	EACH	SODIUM VAPOR LUMINAIRE, 250 WATT
623 0168	110.00	EACH	RECESSED UPLIGHT, METAL HALIDE FLOOD, 100 WATT
623 0172	68.00	EACH	RECESSED UPLIGHT, METAL HALIDE SPOT, 100 WATT
623 0290	26.00	EACH	SPECIAL POLE
623 0804	2.00	EACH	REMOVE AND RESET SIGNAL POLE
623 0888	3 4.00	EACH	UNDERGROUND ELECTRICAL SERVICE
623 1008	2,550.00	LIN. FT.	1 1/4-INCH CONDUIT
623 1012	3,480.00	LIN. FT.	1 1/2-INCH CONDUIT
623 1020	4,280.00	LIN. FT.	2-INCH CONDUIT
623 1028	780.00	LIN. FT.	3-INCH CONDUIT
623 1032	1,170.00	LIN. FT.	4-INCH CONDUIT
623 1132	6,240.00	LIN. FT.	NO. 4 CONDUCTOR

ITEM NO.	TOTAL	UNIT	ITEM
623 1136	2,980.00	LIN. FT.	NO. 6 CONDUCTOR
623 1140	8,250.00	LIN. FT.	NO. 8 CONDUCTOR
623 1724	91 73.00	EACH	LOOP DETECTOR (6-FOOT X 6-FOOT)
623 1732	2,320.00	LIN. FT.	LEAD-IN CABLE FOR LOOP DETECTORS
624 0004	400.00	HOUR	FLAGGER
624 0052	40.00	HOUR	RENT EQUIPMENT (LOADER)
624 0068	40.00	HOUR	RENT EQUIPMENT (DUMP TRUCK)
625 0004	275.00	EACH	RENT TRAFFIC CONES
625 0020	35.00	EACH	RENT BARRICADE WARNING LIGHTS (TYPE B)
625 0036	21.00	EACH	RENT CONSTRUCTION BARRICADES (TYPE IIB)
625 0044	3.00	EACH	RENT CHANGEABLE MESSAGE SIGN
625 0080	4.00	EACH	RENT ARROW BOARD (TYPE C)
625 0072	95.00	EACH	RENT TRAFFIC DRUMS
625 0500	1,373.00	SQ. FT.	RENT CONSTRUCTION SIGNS
627 0508	34.00	SQ. FT.	PERMANENT SIGNS (GROUND MOUNTED) (METAL SUPPORT)
627 0532	46.00	SQ. FT.	PERMANENT SIGNS, REMOVE
627 0540	46.00	SQ. FT.	PERMANENT SIGNS, RESET
628 0004	107,800.00	LS	MOBILIZATION
633 0000	2,712.00	EACH	NON-REFLECTIVE PAVEMENT MARKERS
633 0004	335.00	EACH	REFLECTIVE PAVEMENT MARKERS
634 0620	3,000.00	SQ. FT.	PERMANENT PAVEMENT MARKING FILM (TYPE 2) (VARIES)
634 0640	805.00	LIN. FT.	PERMANENT PAVEMENT MARKING FILM (TYPE 2) (12-INCH)
634 0646	370.00	LIN. FT.	PERMANENT PAVEMENT MARKING FILM (TYPE 2) (24-INCH)
635 0548	130.00	LIN. FT.	TYPE 1 TEMPORARY STRIPING TAPE (8-INCH WIDTH)
650 0070	2.00	EACH	WET TAP

JOB No. 84144
 SHEET No. 3E
 DESIGNED BY DWS
 CHECKED BY TEP
 DATE 01-08-08
 ENGINEER SURVEYOR PLANNER
POGGEMEYER DESIGN GROUP
 2801 NORTH TENAYA WAY LAS VEGAS, NEVADA 89128 (702) 255-8100

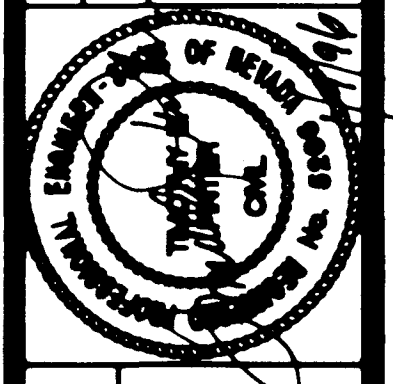

DEPARTMENT OF PUBLIC WORKS
 PROJECT: DOWNTOWN ENTRY CORRIDOR IMPROVEMENTS
 ESTIMATE OF QUANTITIES

SHEET:



DRAWING NO. 3E

AS BUILT

