


FED. RD. REG. NO.	STATE	PROJECT NO.	COUNTY	SHEET NO.
9	NEVADA	STP-604 (3)	CLARK	IR-1

REVISIONS	DATE


DESIGNED BY SWS	ENGINEERS	DRAWN BY GCL	PLANNERS
CHECKED BY SWS	SURVEYORS	CHECKED BY SWS	PLANNERS
DATE 06-10-96			

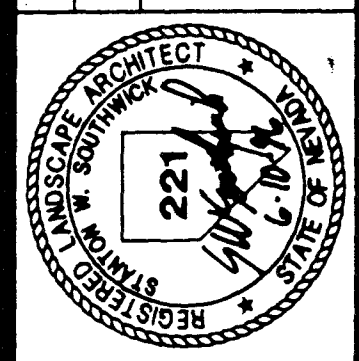


DEPARTMENT OF PUBLIC WORKS  
 IRRIGATION PLAN  
 SAHARA AVE. TO OAKLEY BLVD.  
 STA 10+00 TO STA 14+00  
 PROJECT:  
 DOWNTOWN ENTRY CORRIDOR  
 IMPROVEMENTS  
 SHEET:



DRAWING NO. IR-1  
 23/52

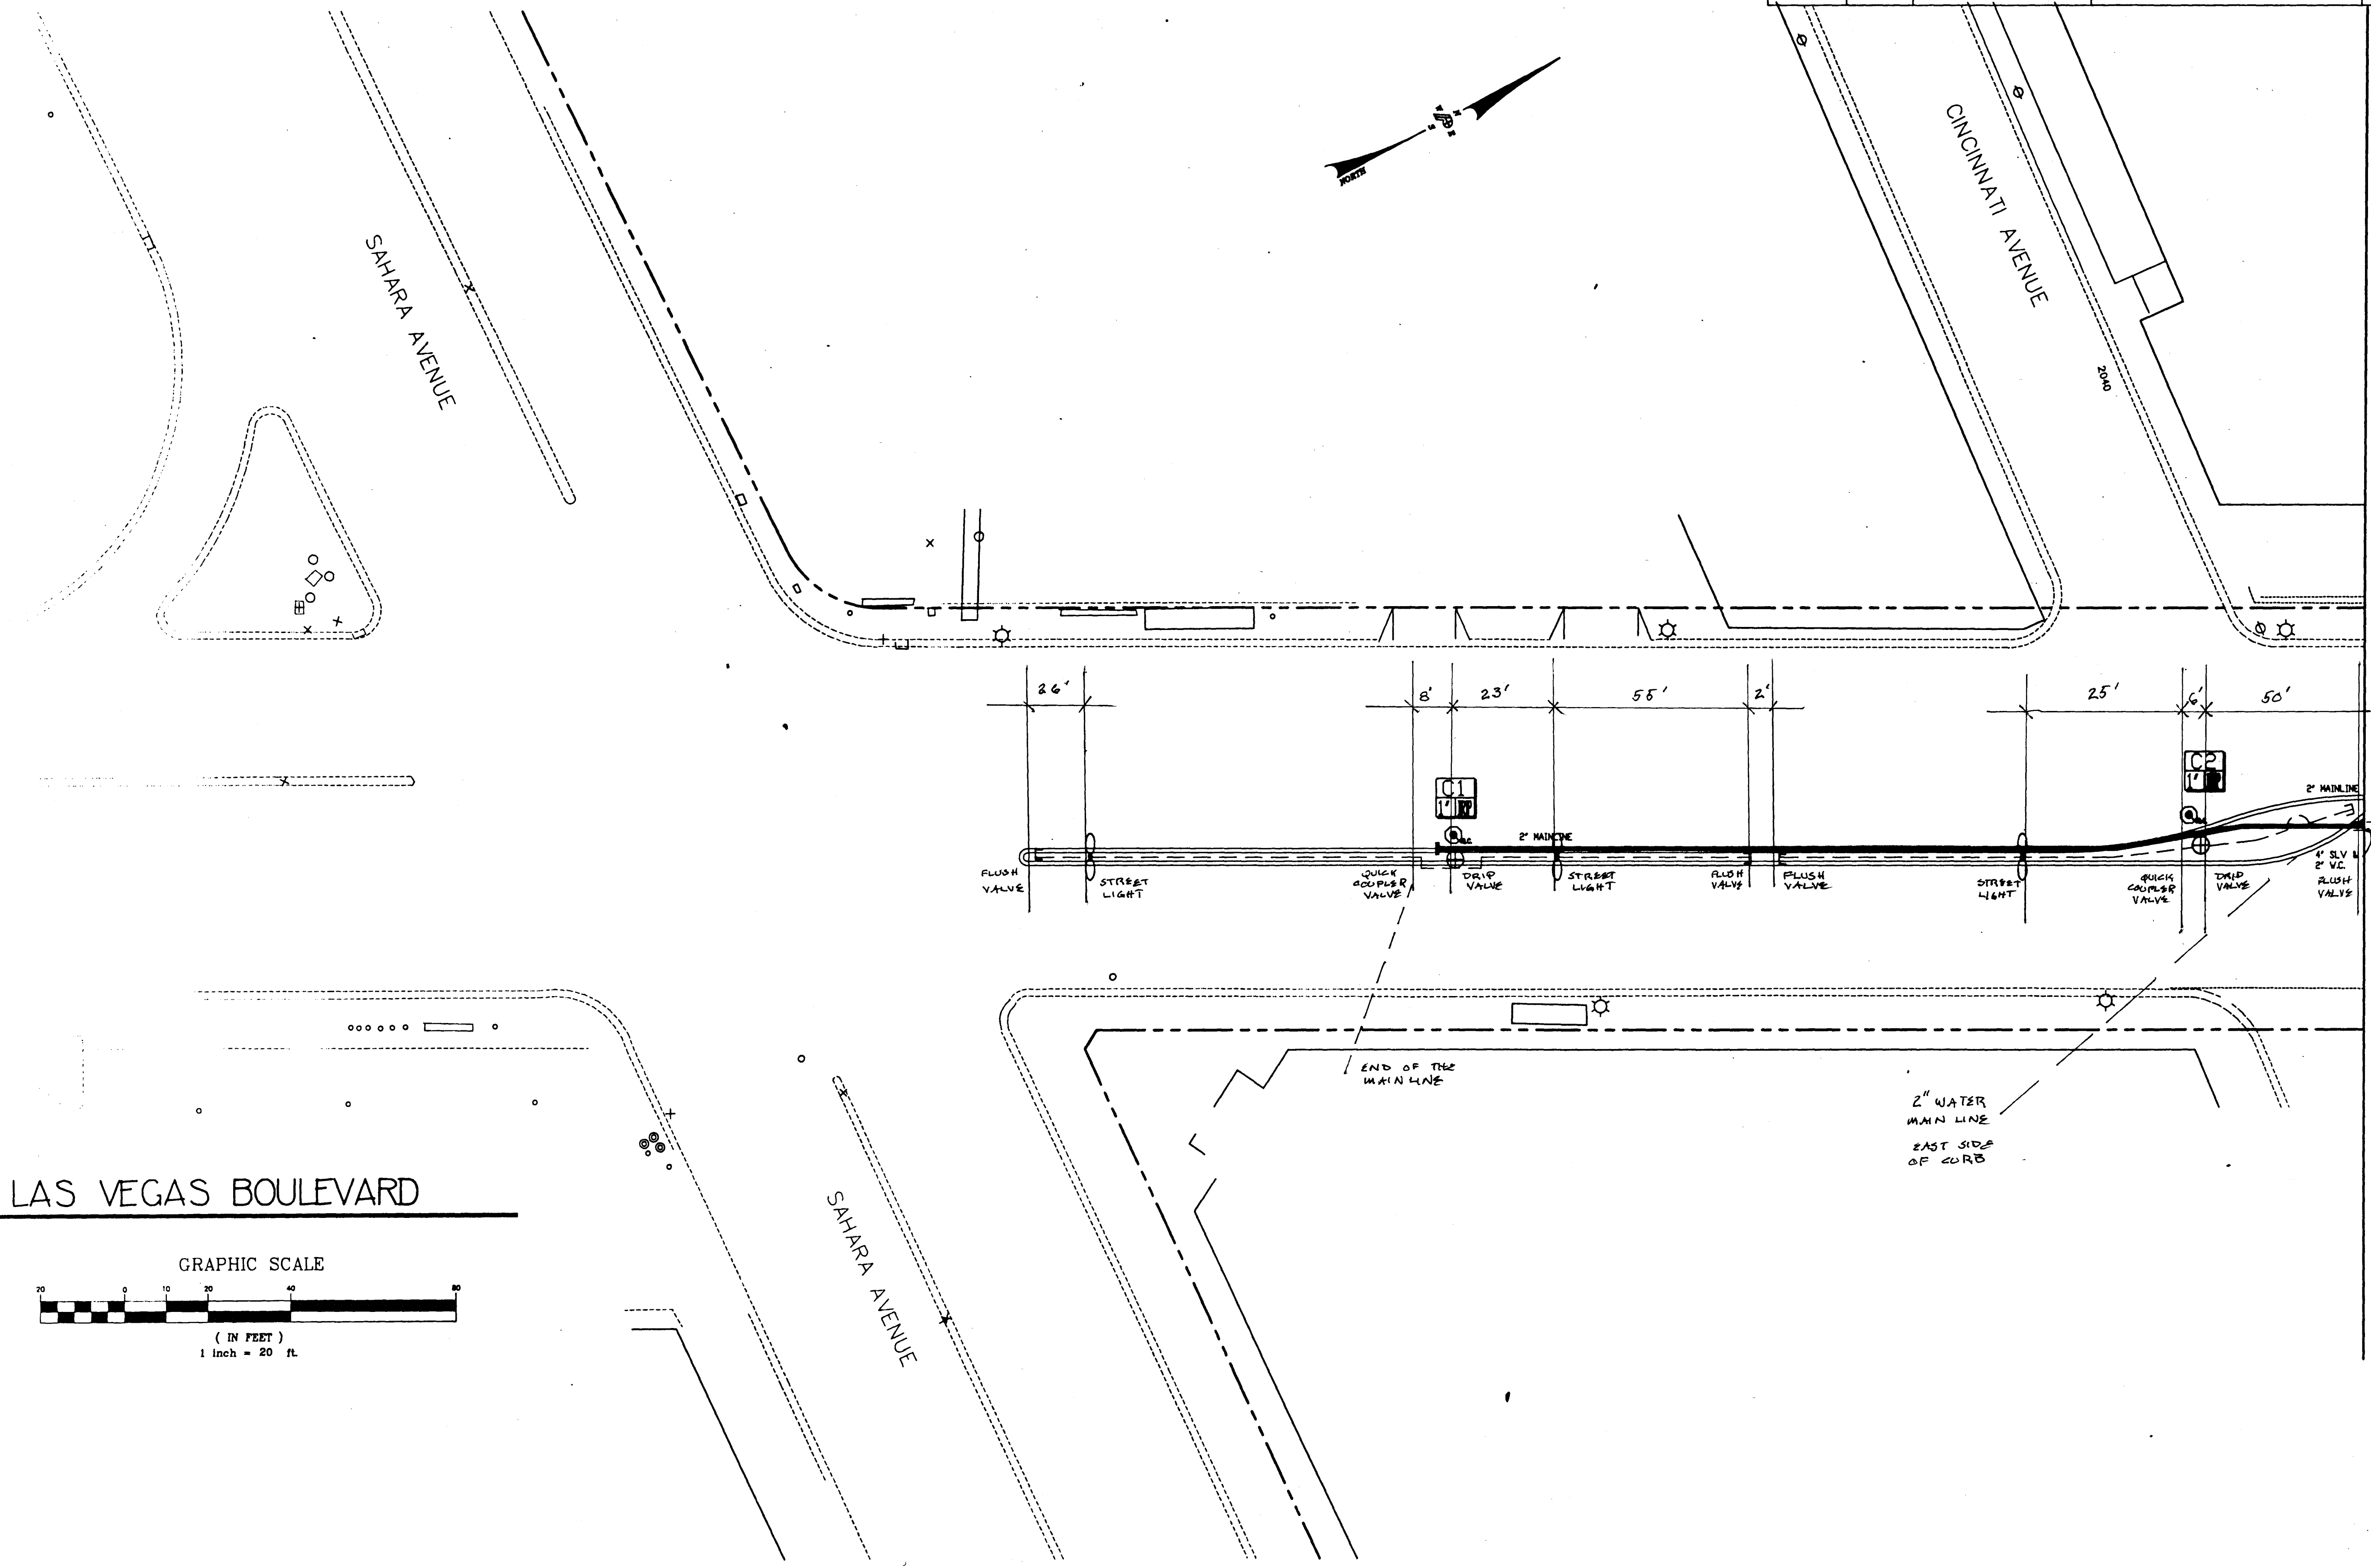

LAS VEGAS BOULEVARD

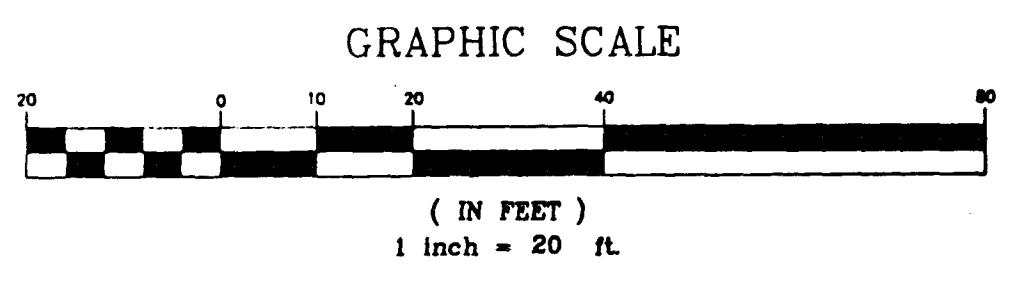

**AS BUILT**

Call before you Dig.  
 1-800-227-2600

