


FED. RD. REG. NO.	STATE	PROJECT NO.	COUNTY	SHEET NO.
9	NEVADA	STP-604 (3)	CLARK	IR-5


DATE	REVISIONS

MATCHLINE STA 32+00  
(SEE SHEET IR-4)

MATCHLINE STA 38+00  
(SEE SHEET IR-6)

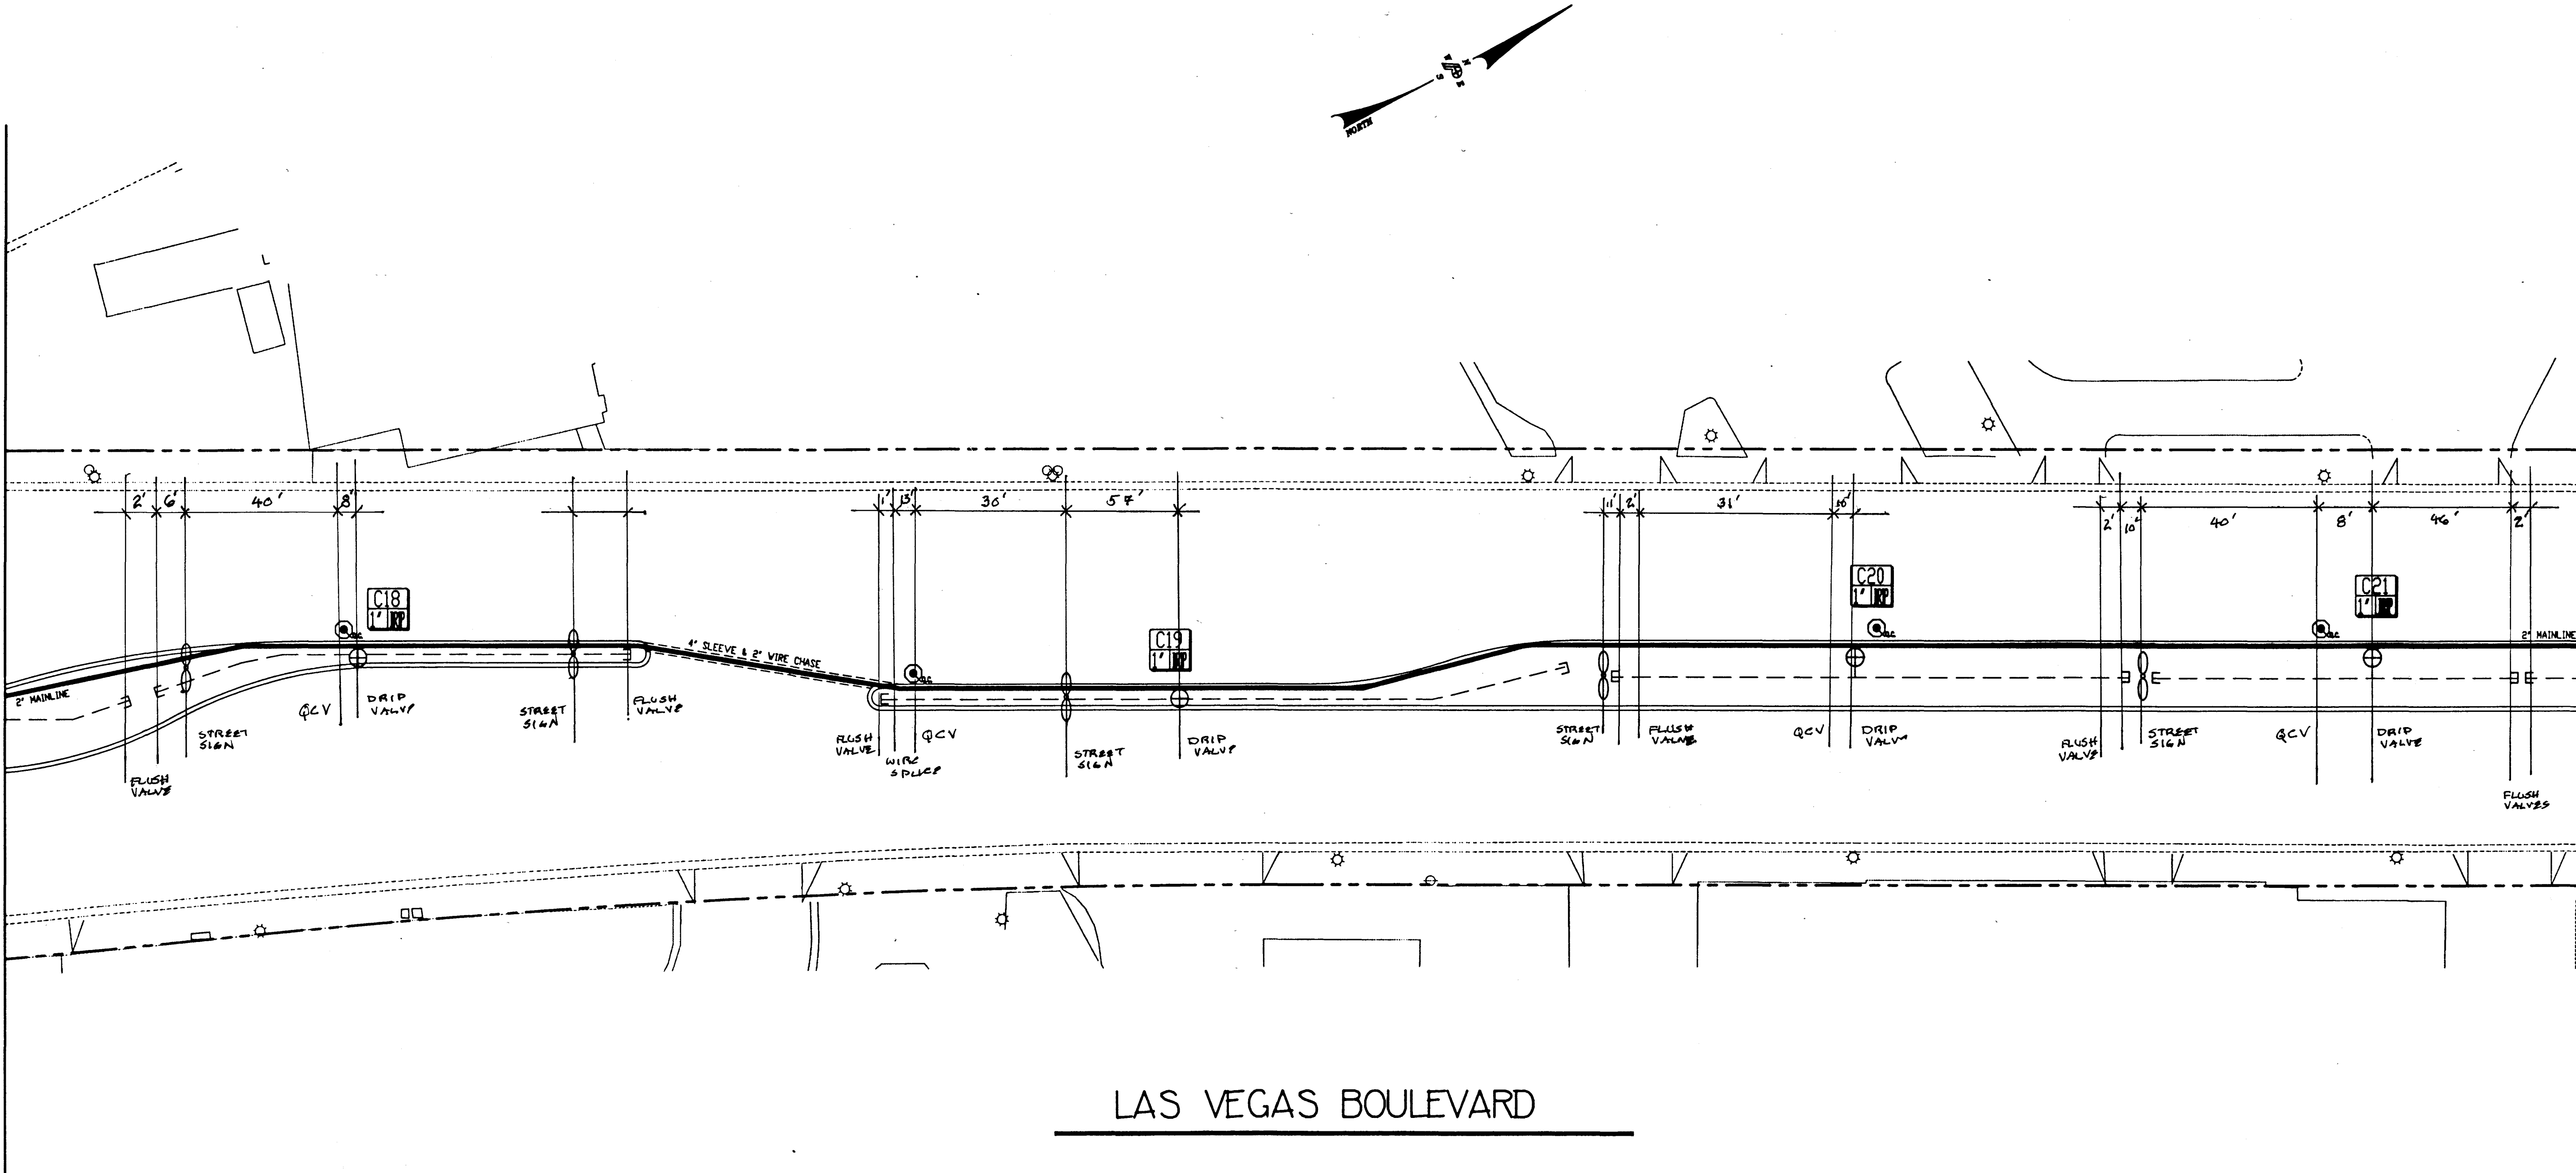


LAS VEGAS BOULEVARD

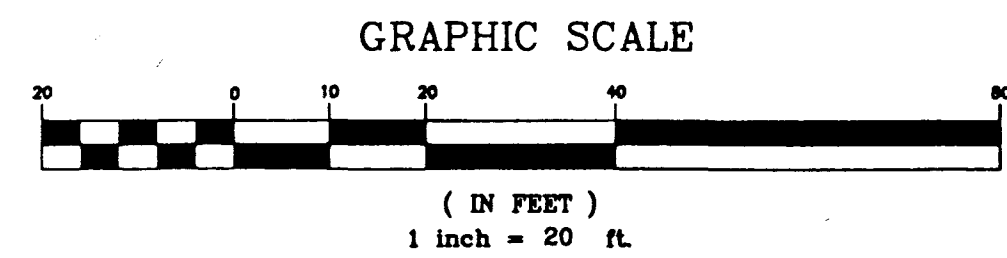

**AS BUILT**

JOB No. 94144	DESIGNED BY SWS	DATE 06-10-96	ENGINEERS	DRAWN BY GCL
SHEET No. IR-5	CHECKED BY SWS		SURVEYORS	
			PLANNERS	

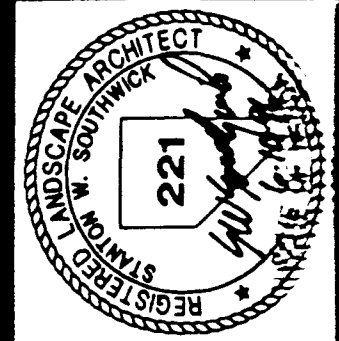

DEPARTMENT OF PUBLIC WORKS  
PROJECT: DOWNTOWN ENTRY CORRIDOR IMPROVEMENTS

IRRIGATION PLAN  
SAHARA AVE. TO OAKLEY BLVD.  
STA 32+00 - STA 38+00




DRAWING NO.	27
IR-5	52

Call before you Dig.  
1-800-227-2800

DATE	BY	PROJECT NO.	CITY
9	MOORE	27-000 (2)	LVAS

MATCHLINE STA. 32+00

MATCHLINE STA. 36+00

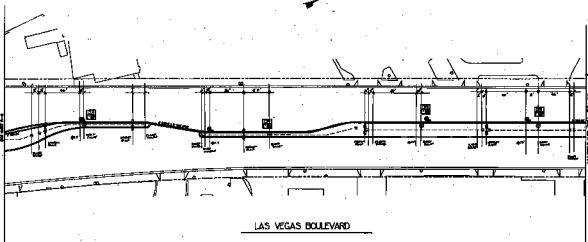

LAS VEGAS BOULEVARD



**AS BUILT**

DEPARTMENT OF PUBLIC WORKS  
 DIVISION OF STREET DESIGN  
 MANHOLES  
 1525 SOUTH MAIN STREET, SUITE 200  
 LAS VEGAS, NEVADA 89102  
 PHONE: 792-3100

PROJECT NUMBER: 27-000 (2)  
 SHEET NO.: 10

DATE: 10/15/10  
 DRAWN BY: [Signature]  
 CHECKED BY: [Signature]

