


FED. RD. REG. NO.	STATE	PROJECT NO.	COUNTY	SHEET NO.
9	NEVADA	STP-604 (3)	CLARK	PL-1

DATE	REVISIONS
1-2-96	ADD PALMS PER CLV REQUEST

JOB No. 94144	DESIGNED BY SWS	DRAWN BY GCL
SHEET No. PL-1	DATE 04-21-95	CHECKED BY SWS
ENGINEERS		SURVEYORS
PLANNERS		PLANNERS
POGGEMEYER DESIGN GROUP		
		
2601 NORTH TENAYA WAY LAS VEGAS, NEVADA 89128 (702) 255-8100		

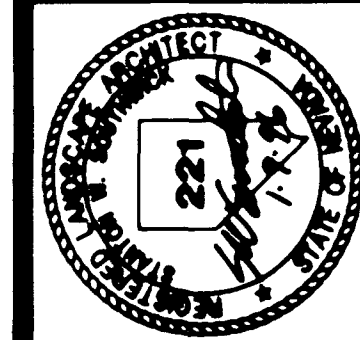

PROJECT:
DEPARTMENT OF PUBLIC WORKS
DOWNTOWN ENTRY CORRIDOR IMPROVEMENTS

SHEET:
PLANTING PLAN
SAHARA AVE. TO OAKLEY BLVD.
STA 10+00 TO STA 14+00



DRAWING NO.
PL-1


Call before you Dig.
1-800-227-2800

AS BUILT


PLANTING LEGEND

SYMBOL	BOTANICAL/COMMON NAME	SIZE	QTY.
	PHOENIX CANARIENSIS-PINEAPPLE TOP CANARY ISLAND DATE PALM	20'-30' TALL	1
	WASHINGTONIA FILIFERA-SHINNED CALIFORNIA FAN PALM	16'-20' TALL	3
	LEUCOPHYLLUM LAEVIGATUM CHIHUAHUA SAGE	5 GAL	5
	MYRTUS COMMUNIS 'COMPACTA' DWARF MYRTLE	5 GAL	5
	YUCCA RECURVIFOLIA CURVE LEAF YUCCA	5 GAL	4
	HEMEROCALLIS HYBRID DAYLILY	1 GAL	9
	SALVIA GREGGII 'SIERRA LINDA' SIERRA LINDA AUTUMN SAGE	5 GAL	3
	MUHLENBERGIA CAPILLARIS 'REGAL MIST' REGAL MIST DEER GRASS	1 GAL • 24" O.C.	±116
	GAZANIA HYBRID 'FIESTA RED' GAZANIA-CLUMPING	1 GAL • 12" O.C.	±150
	BACCHARIS 'CENTENNIAL' CENTENNIAL HYBRID BROOM	5 GAL • 36" O.C.	±17

MATCHLINE STA 14+00
(SEE SHEET PL-2)

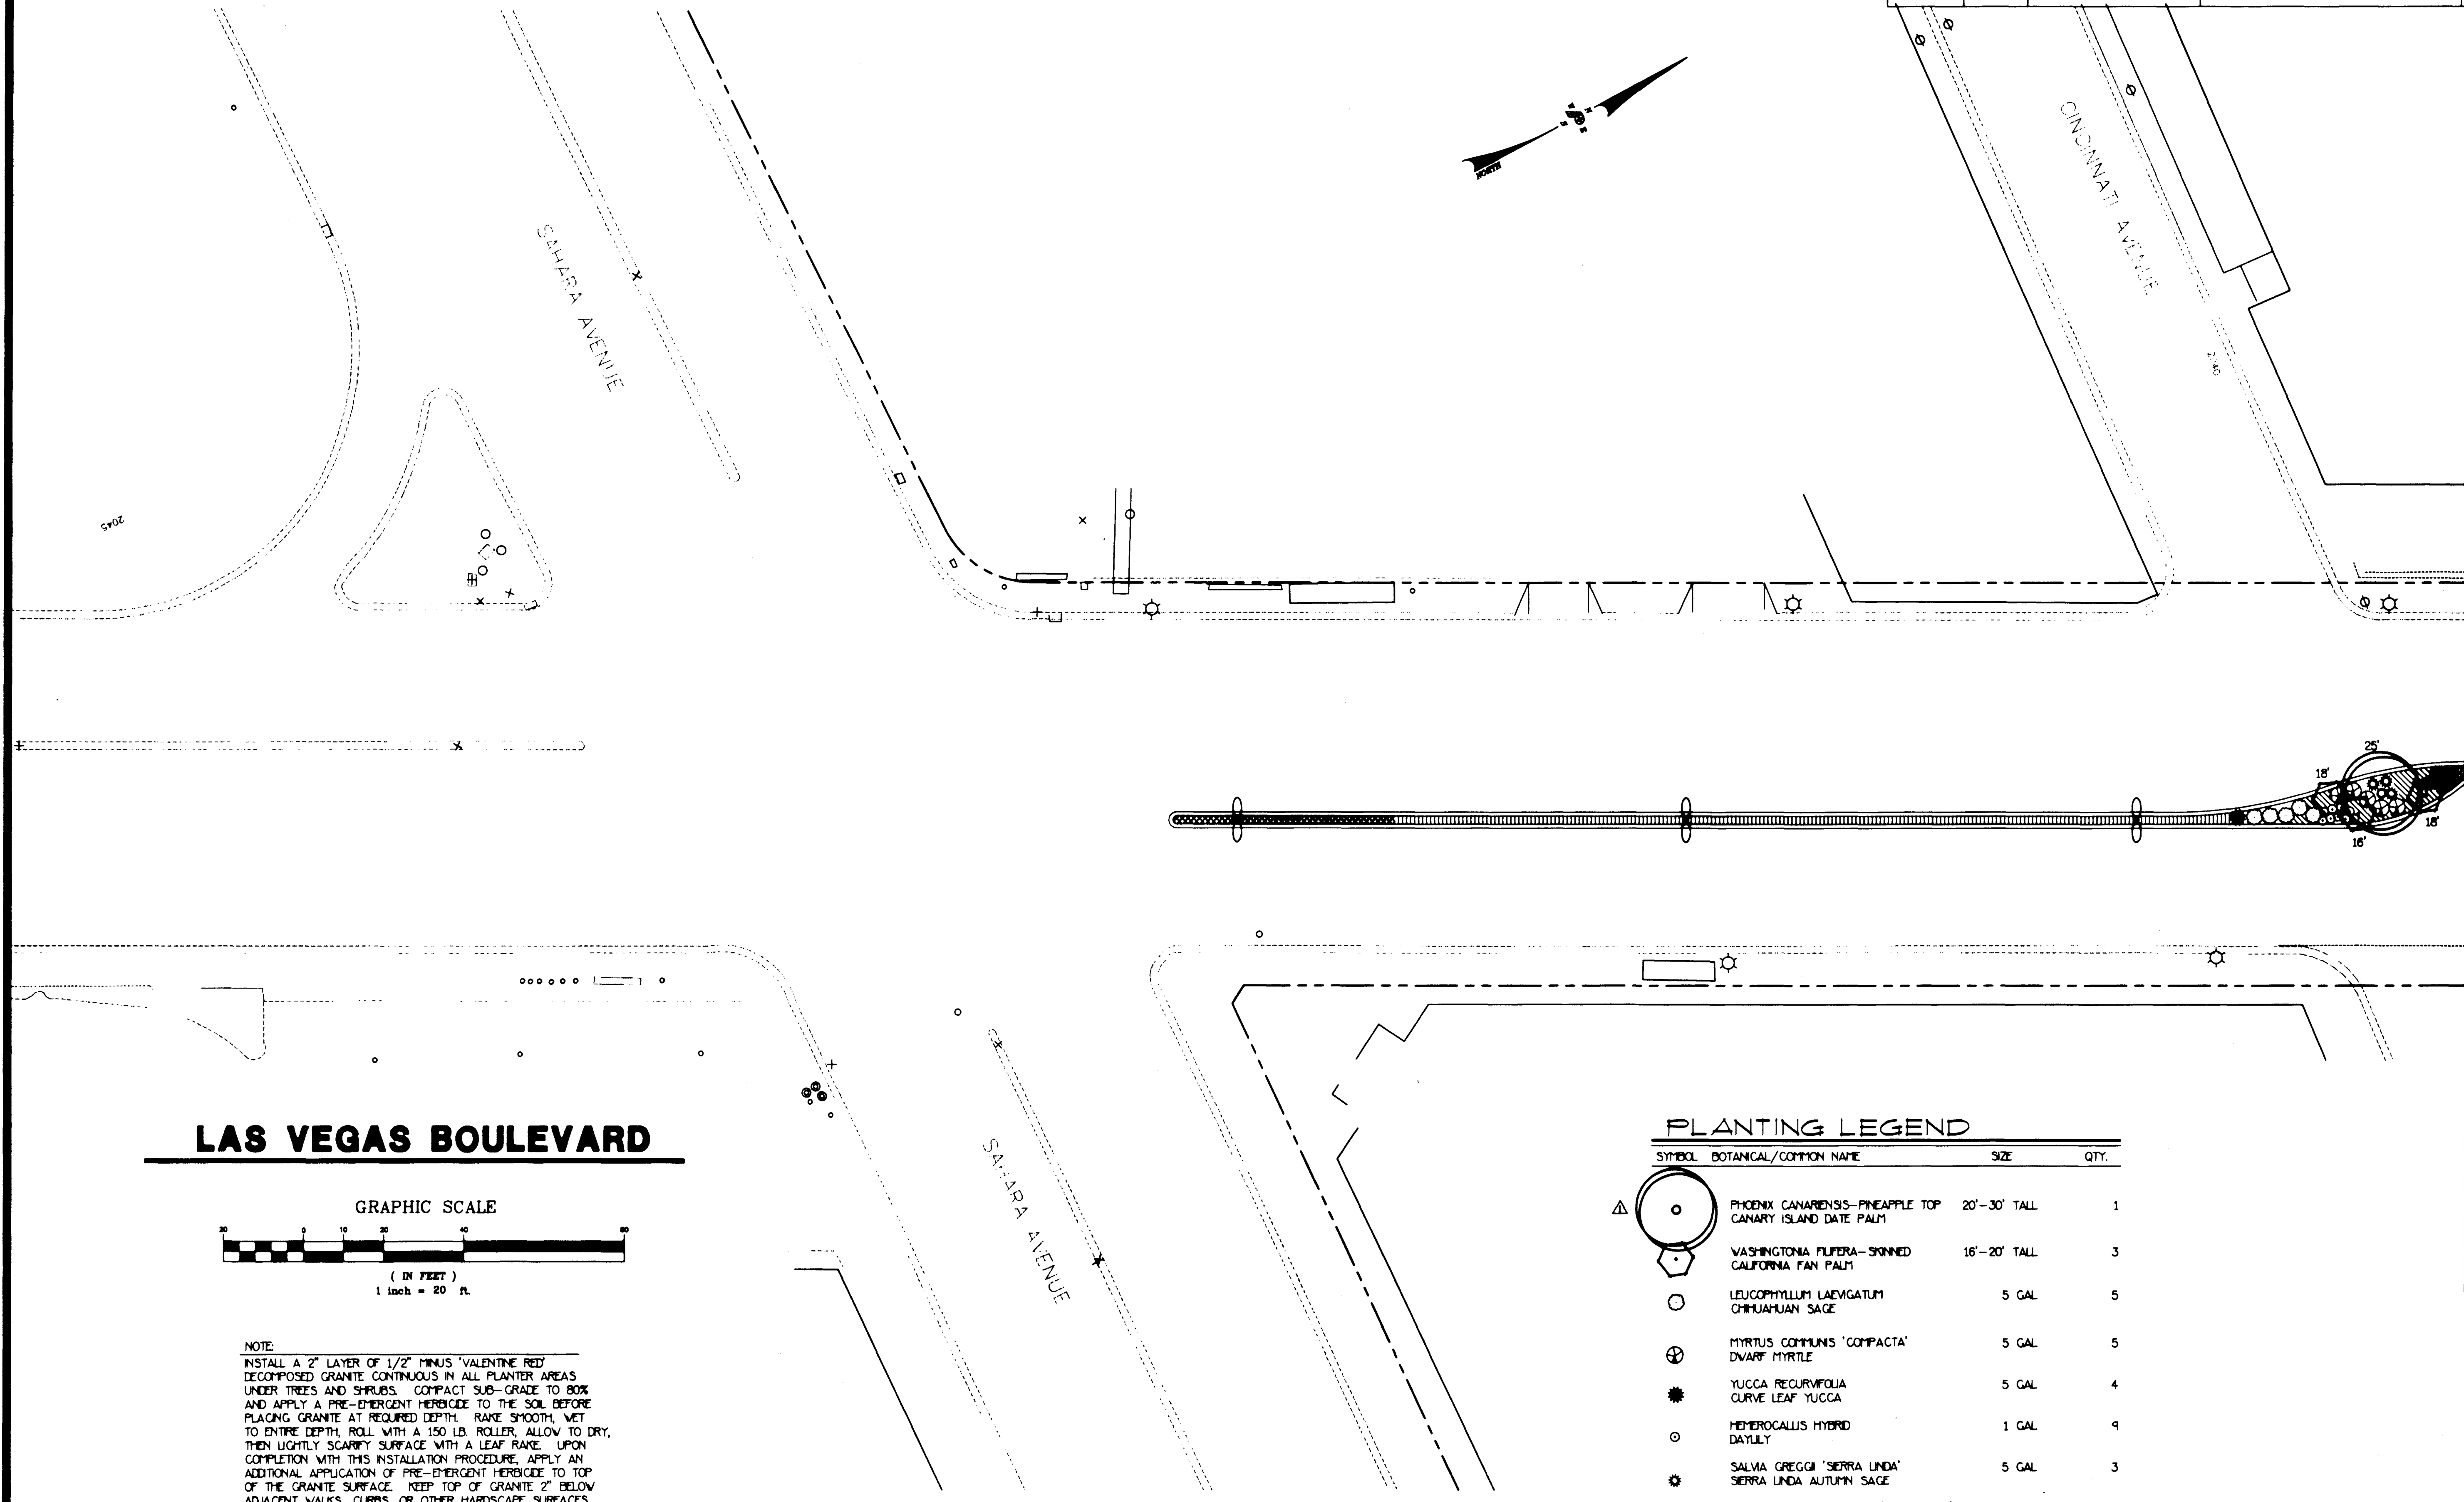

LAS VEGAS BOULEVARD

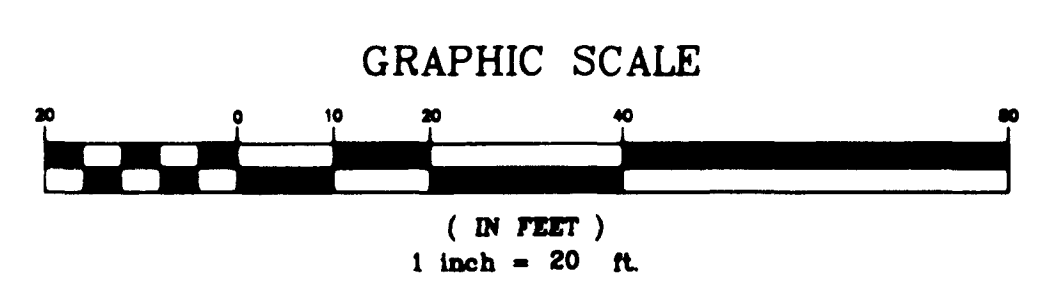

NOTE:
INSTALL A 2" LAYER OF 1/2" MINUS 'VALENTINE RED' DECOMPOSED GRANITE CONTINUOUS IN ALL PLANTER AREAS UNDER TREES AND SHRUBS. COMPACT SUB-GRADE TO 80% AND APPLY A PRE-EMERGENT HERBICIDE TO THE SOIL BEFORE PLACING GRANITE AT REQUIRED DEPTH. RAKE SMOOTH, VET TO ENTIRE DEPTH, ROLL WITH A 150 LB. ROLLER, ALLOW TO DRY, THEN LIGHTLY SCARIFY SURFACE WITH A LEAF RAKE. UPON COMPLETION WITH THIS INSTALLATION PROCEDURE, APPLY AN ADDITIONAL APPLICATION OF PRE-EMERGENT HERBICIDE TO TOP OF THE GRANITE SURFACE. KEEP TOP OF GRANITE 2" BELOW ADJACENT WALKS, CURBS, OR OTHER HARDSCAPE SURFACES. DECOMPOSED GRANITE IS AVAILABLE THROUGH KALAMAZOO MATERIALS, INC. (702) 798-5910.

