


FED. RD. REG. NO.	STATE	PROJECT NO.	COUNTY	SHEET NO.
9	NEVADA	STP-604 (3)	CLARK	PL-4


DATE	1-2-94	REVISIONS	
DESIGNED BY SWS	94144	DRAWN BY GCL	
CHECKED BY SWS	04-21-95	DATE	04-21-95
ENCLOSURES		SURVEYORS	
PLANNERS		POGGEMEYER DESIGN GROUP	
2801 NORTH TROYA WAY, LAS VEGAS, NEVADA 89128	(702) 255-8100		

MATCHLINE STA 26+00
(SEE SHEET PL-3)

MATCHLINE STA 32+00
(SEE SHEET PL-5)

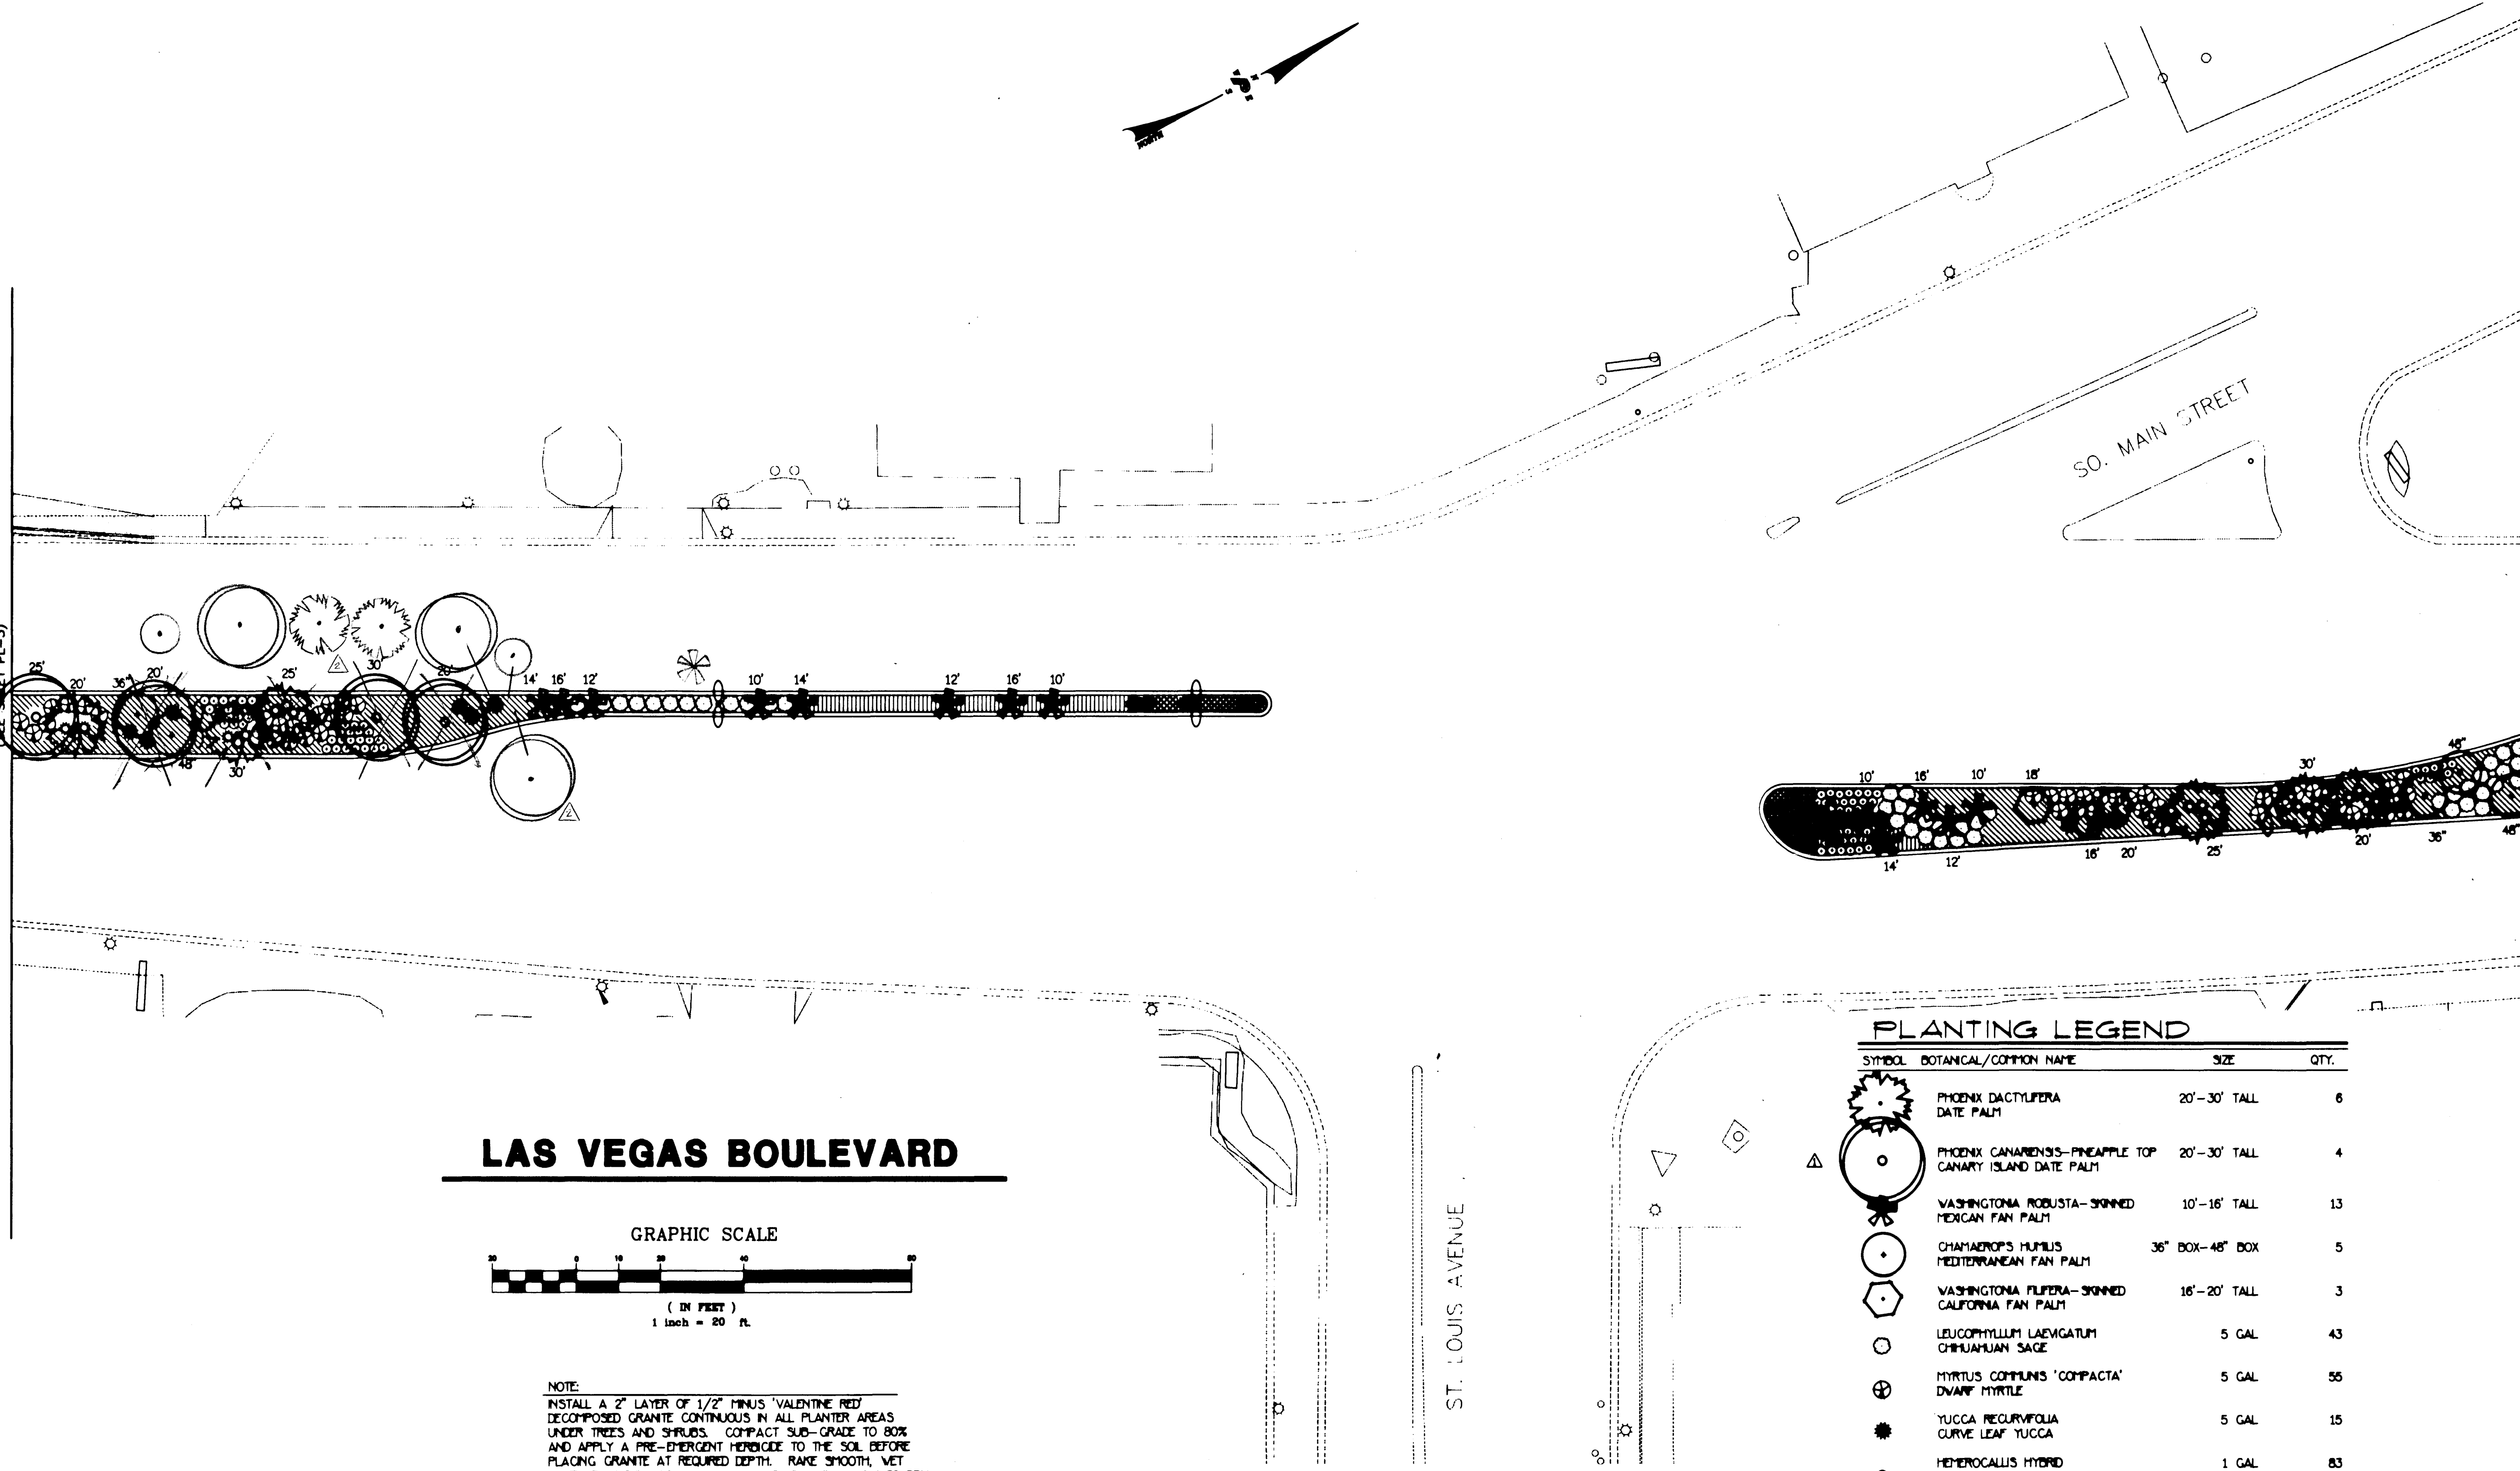

LAS VEGAS BOULEVARD

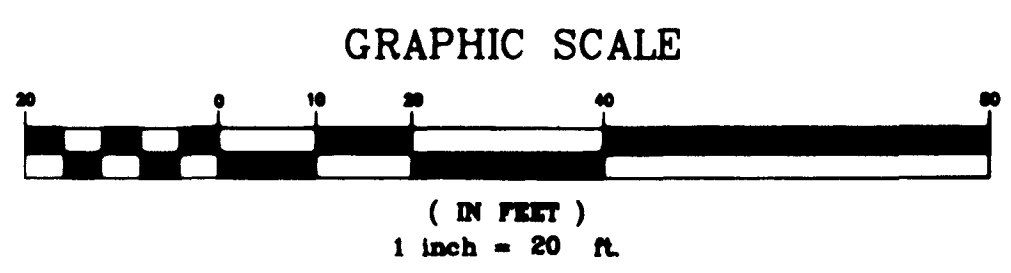


NOTE:
INSTALL A 2" LAYER OF 1/2" FINUS VALENTINE RED DECOMPOSED GRANITE CONTINUOUS IN ALL PLANTER AREAS UNDER TREES AND SHRUBS. COMPACT SUB-GRADE TO BOX AND APPLY A PRE-EMERGENT HERBICIDE TO THE SOIL BEFORE PLACING GRANITE AT REQUIRED DEPTH. RAKE SMOOTH, VET TO ENTIRE DEPTH. ROLL WITH A 150 LB. ROLLER. ALLOW TO DRY, THEN LIGHTLY SCARIFY SURFACE WITH A LEAF RAKE. UPON COMPLETION WITH THIS INSTALLATION PROCEDURE, APPLY AN ADDITIONAL APPLICATION OF PRE-EMERGENT HERBICIDE TO TOP OF THE GRANITE SURFACE. KEEP TOP OF GRANITE 2" BELOW ADJACENT WALKS, CURBS, OR OTHER HARDSCAPE SURFACES. DECOMPOSED GRANITE IS AVAILABLE THROUGH KALAMAZOO MATERIALS, INC. (702) 798-5910.

PLANTING LEGEND

SYMBOL	BOTANICAL/COMMON NAME	SIZE	QTY.
	PHOENIX DACTYLIFERA DATE PALM	20'-30' TALL	6
	PHOENIX CANARIENSIS-PINEAPPLE TOP CANARY ISLAND DATE PALM	20'-30' TALL	4
	WASHINGTONIA ROBUSTA-SKINNED MEXICAN FAN PALM	10'-16' TALL	13
	CHAMAEROPS HUMULUS MEDITERRANEAN FAN PALM	36" BOX-48" BOX	5
	WASHINGTONIA FILIFERA-SKINNED CALIFORNIA FAN PALM	16'-20' TALL	3
	LEUCOPHYLLUM LAEVIGATUM CHIHUAHUAN SAGE	5 GAL	43
	MYRTUS COMPACTA DWARF MYRTLE	5 GAL	56
	YUCCA RECURVIFOLIA CURVE LEAF YUCCA	5 GAL	15
	HEPEROCALLIS HYBRID DAYLILY	1 GAL	83
	SALVIA GREGGII-'SIERRA LINDA' SIERRA LINDA AUTUMN SAGE	5 GAL	18
	MULHENDERGIA CAPILLARIS 'REGAL MIST' REGAL MIST DEER GRASS	1 GAL ● 24" O.C.	±92
	GAZANIA HYBRID 'PISTA RED' GAZANIA-CLIPPING	1 GAL ● 12" O.C.	±274
	BACCHARIS 'CENTENNIAL' CENTENNIAL HYBRID BROOM	5 GAL ● 36" O.C.	±236

AS BUILT
Call before you Dig.
1-800-227-2800

DEPARTMENT OF PUBLIC WORKS
PROJECT: DOWNTOWN ENTRY CORRIDOR IMPROVEMENTS
PLANTING PLAN
SAHARA AVE. TO OAKLEY BLVD.
STA 28+00 - STA 32+00
SHEET:

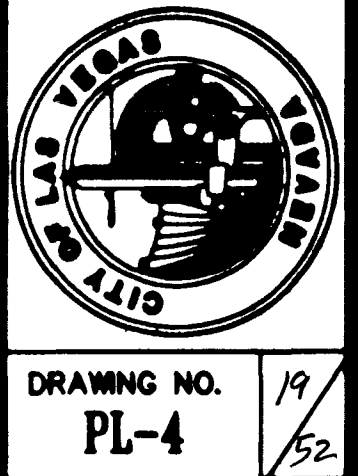

DRAWING NO. PL-4
19/52

