


FED. RD. REG. NO.	STATE	PROJECT NO.	COUNTY	SHEET NO.
9	NEVADA	STP-604 (3)	CLARK	PL-5


DATE	REVISIONS

MATCHLINE STA 32+00  
(SEE SHEET PL-4)

MATCHLINE STA 38+00  
(SEE SHEET PL-6)

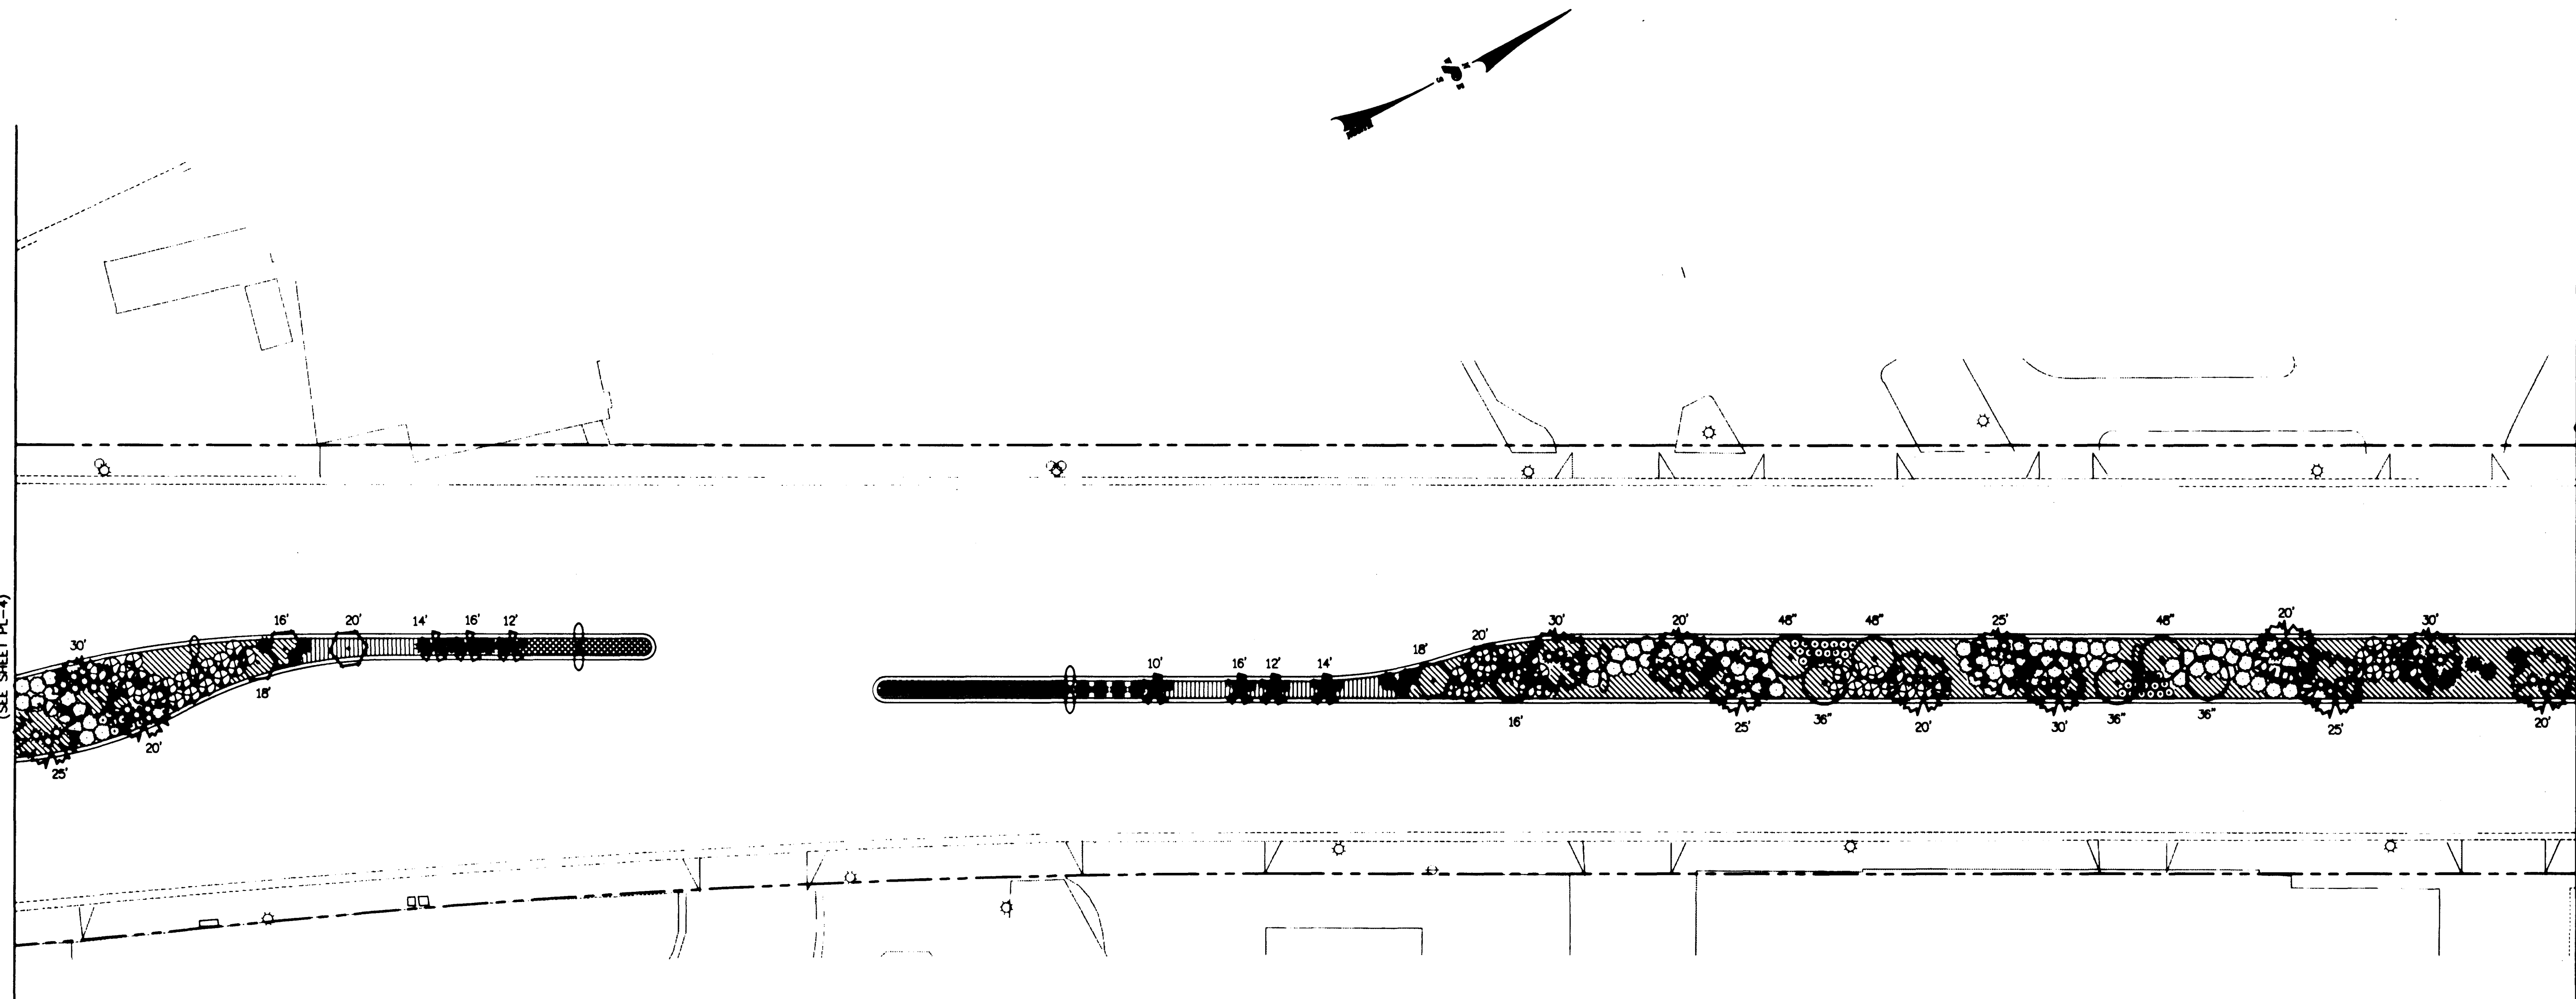

### LAS VEGAS BOULEVARD

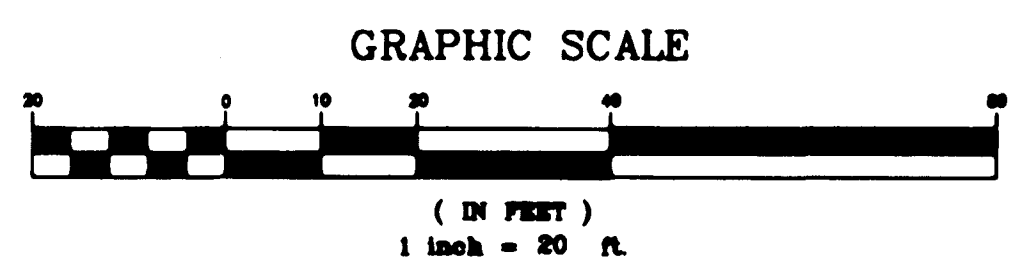

**NOTE:**  
 INSTALL A 2" LAYER OF 1/2" MINUS 'VALENTINE RED' DECOMPOSED GRANITE CONTINUOUS IN ALL PLANTER AREAS UNDER TREES AND SHRUBS. COMPACT SUB-GRADE TO BOX AND APPLY A PRE-EMERGENT HERBICIDE TO THE SOIL BEFORE PLACING GRANITE AT REQUIRED DEPTH. RAKE SMOOTH, WET TO ENTIRE DEPTH, ROLL WITH A 150 LB. ROLLER, ALLOW TO DRY, THEN LIGHTLY SCARIFY SURFACE WITH A LEAF RAKE. UPON COMPLETION WITH THIS INSTALLATION PROCEDURE, APPLY AN ADDITIONAL APPLICATION OF PRE-EMERGENT HERBICIDE TO TOP OF THE GRANITE SURFACE. KEEP TOP OF GRANITE 2" BELOW ADJACENT WALKS, CURBS, OR OTHER HARDSCAPE SURFACES. DECOMPOSED GRANITE IS AVAILABLE THROUGH KALAMAZOO MATERIALS, INC. (702) 798-5910.

### PLANTING LEGEND

SYMBOL	BOTANICAL/COMMON NAME	SIZE	QTY.
	PHOENIX DACTYLIFERA DATE PALM	20'-30' TALL	13
	WASHINGTONIA ROBUSTA-SKINNED MEXICAN FAN PALM	10'-16' TALL	7
	CHAMAEOROPIS HUMILIS MEDITERRANEAN FAN PALM	36" BOX-48" BOX	6
	WASHINGTONIA FLUFERA-SKINNED CALIFORNIA FAN PALM	16'-20' TALL	6
	LEUCOPHYLLUM LAEVIGATUM CHIHUAHUAN SAGE	5 GAL	85
	MYRTUS COMMUNIS 'COMPACTA' DWARF MYRTLE	5 GAL	58
	YUCCA RECURVIFOLIA CURVE LEAF YUCCA	5 GAL	22
	HEBEROCALLIS HYBRID DAYLILY	1 GAL	42
	SALVIA GREGGII-'SIERRA LINDA' SIERRA LINDA AUTUMN SAGE	5 GAL	44
	MULLEBERGIA CAPILLARIS 'REGAL MIST' REGAL MIST DEER GRASS	1 GAL ● 24" O.C.	±87
	GAZANIA HYBRID 'FIESTA RED' GAZANIA-CLIPPING	1 GAL ● 12" O.C.	±215
	BACCHARIS 'CENTENNIAL' CENTENNIAL HYBRID BROOM	5 GAL ● 36" O.C.	±247

DESIGNED BY SWS  
 DATE 04-21-85  
 CHECKED BY SWS  
 SURVEYORS  
 ENGINEERS  
 DRAWN BY GCL  
 CHECKED BY SWS  
 PLANNERS  
**POGGEMEYER DESIGN GROUP**  
 2601 NORTH TENAYA WAY LAS VEGAS, NEVADA 89128 (702) 255-8100



DEPARTMENT OF PUBLIC WORKS  
 PROJECT: DOWNTOWN ENTRY CORRIDOR IMPROVEMENTS  
 SHEET: PLANTING PLAN SAHARA AVE. TO OAKLEY BLVD. STA 32+00 - STA 38+00

DEPARTMENT OF PUBLIC WORKS  
 PROJECT: DOWNTOWN ENTRY CORRIDOR IMPROVEMENTS  
 SHEET: PLANTING PLAN SAHARA AVE. TO OAKLEY BLVD. STA 32+00 - STA 38+00



DRAWING NO. PL-5  
 SHEET NO. 20/52

**AS BUILT**  
 Call before you Dig.  
 1-800-227-2000

