

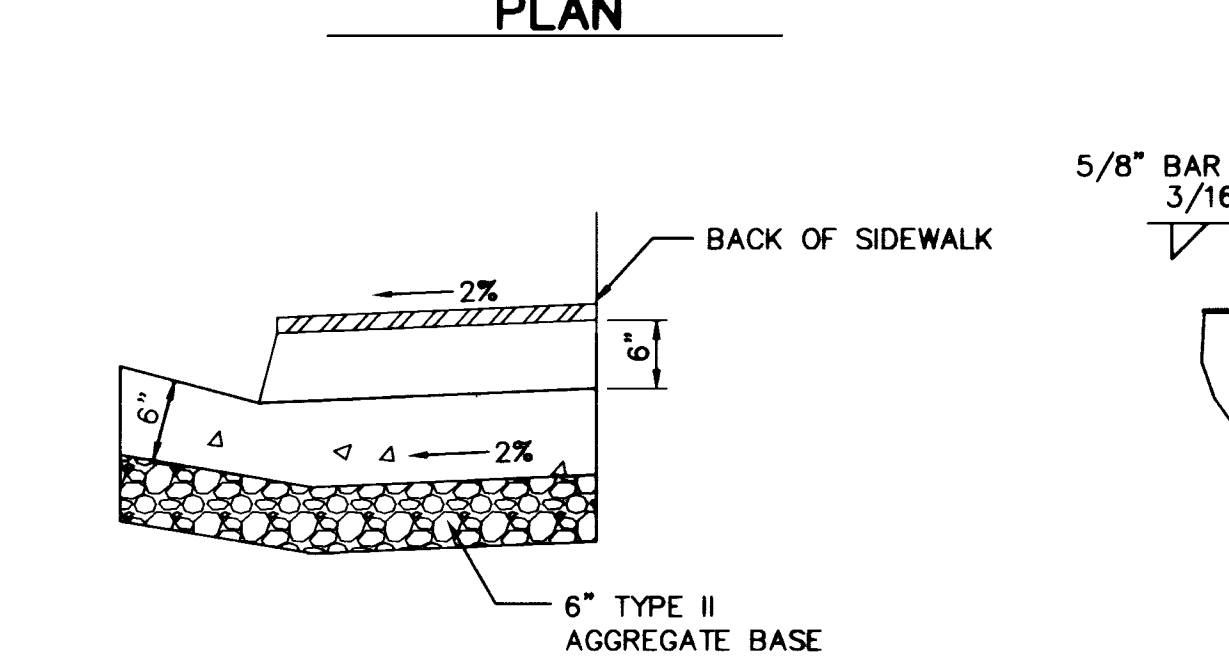
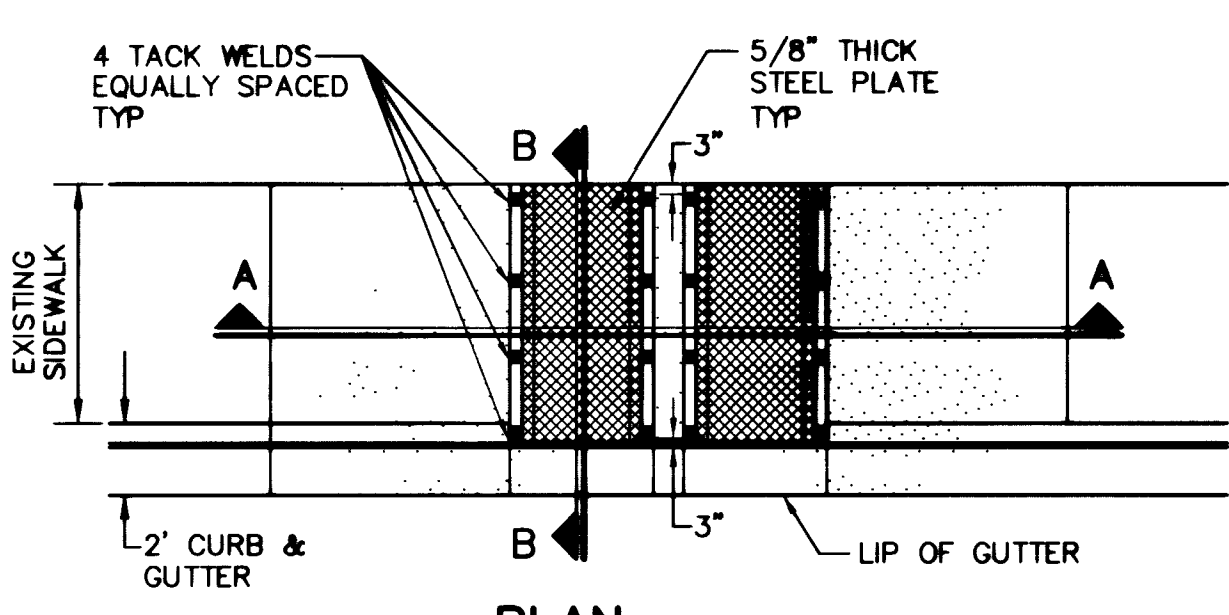



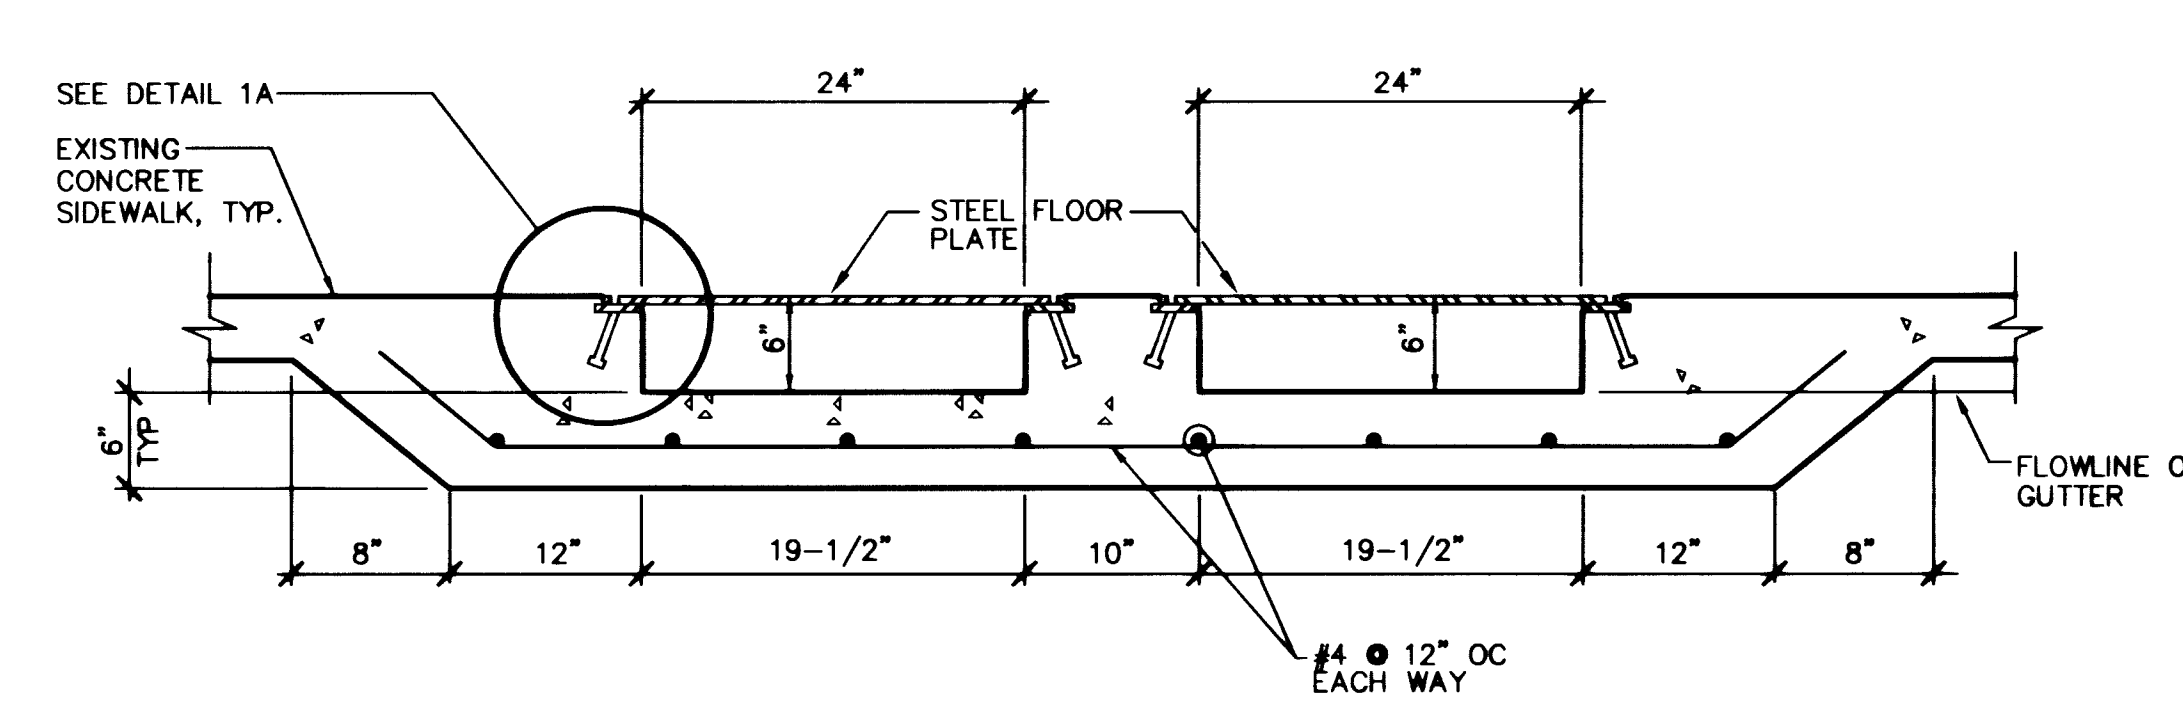


NOTE:
ALL EXPOSED METAL PARTS SHALL
BE GALVANIZED AND ALL GALVANIZING
DAMAGED BY FABRICATION OR
INSTALLATION SHALL RECEIVE TWO
COATS OF ALUMINUM PAINT (GALVONOX
OR EQUAL)

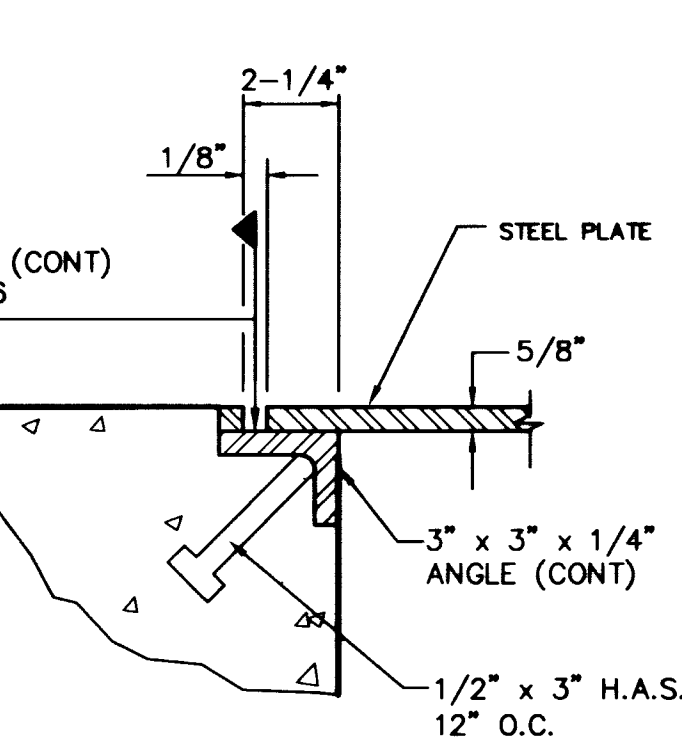

DOUBLE SIDEWALK UNDERDRAIN
NO SCALE STA 15+32

2

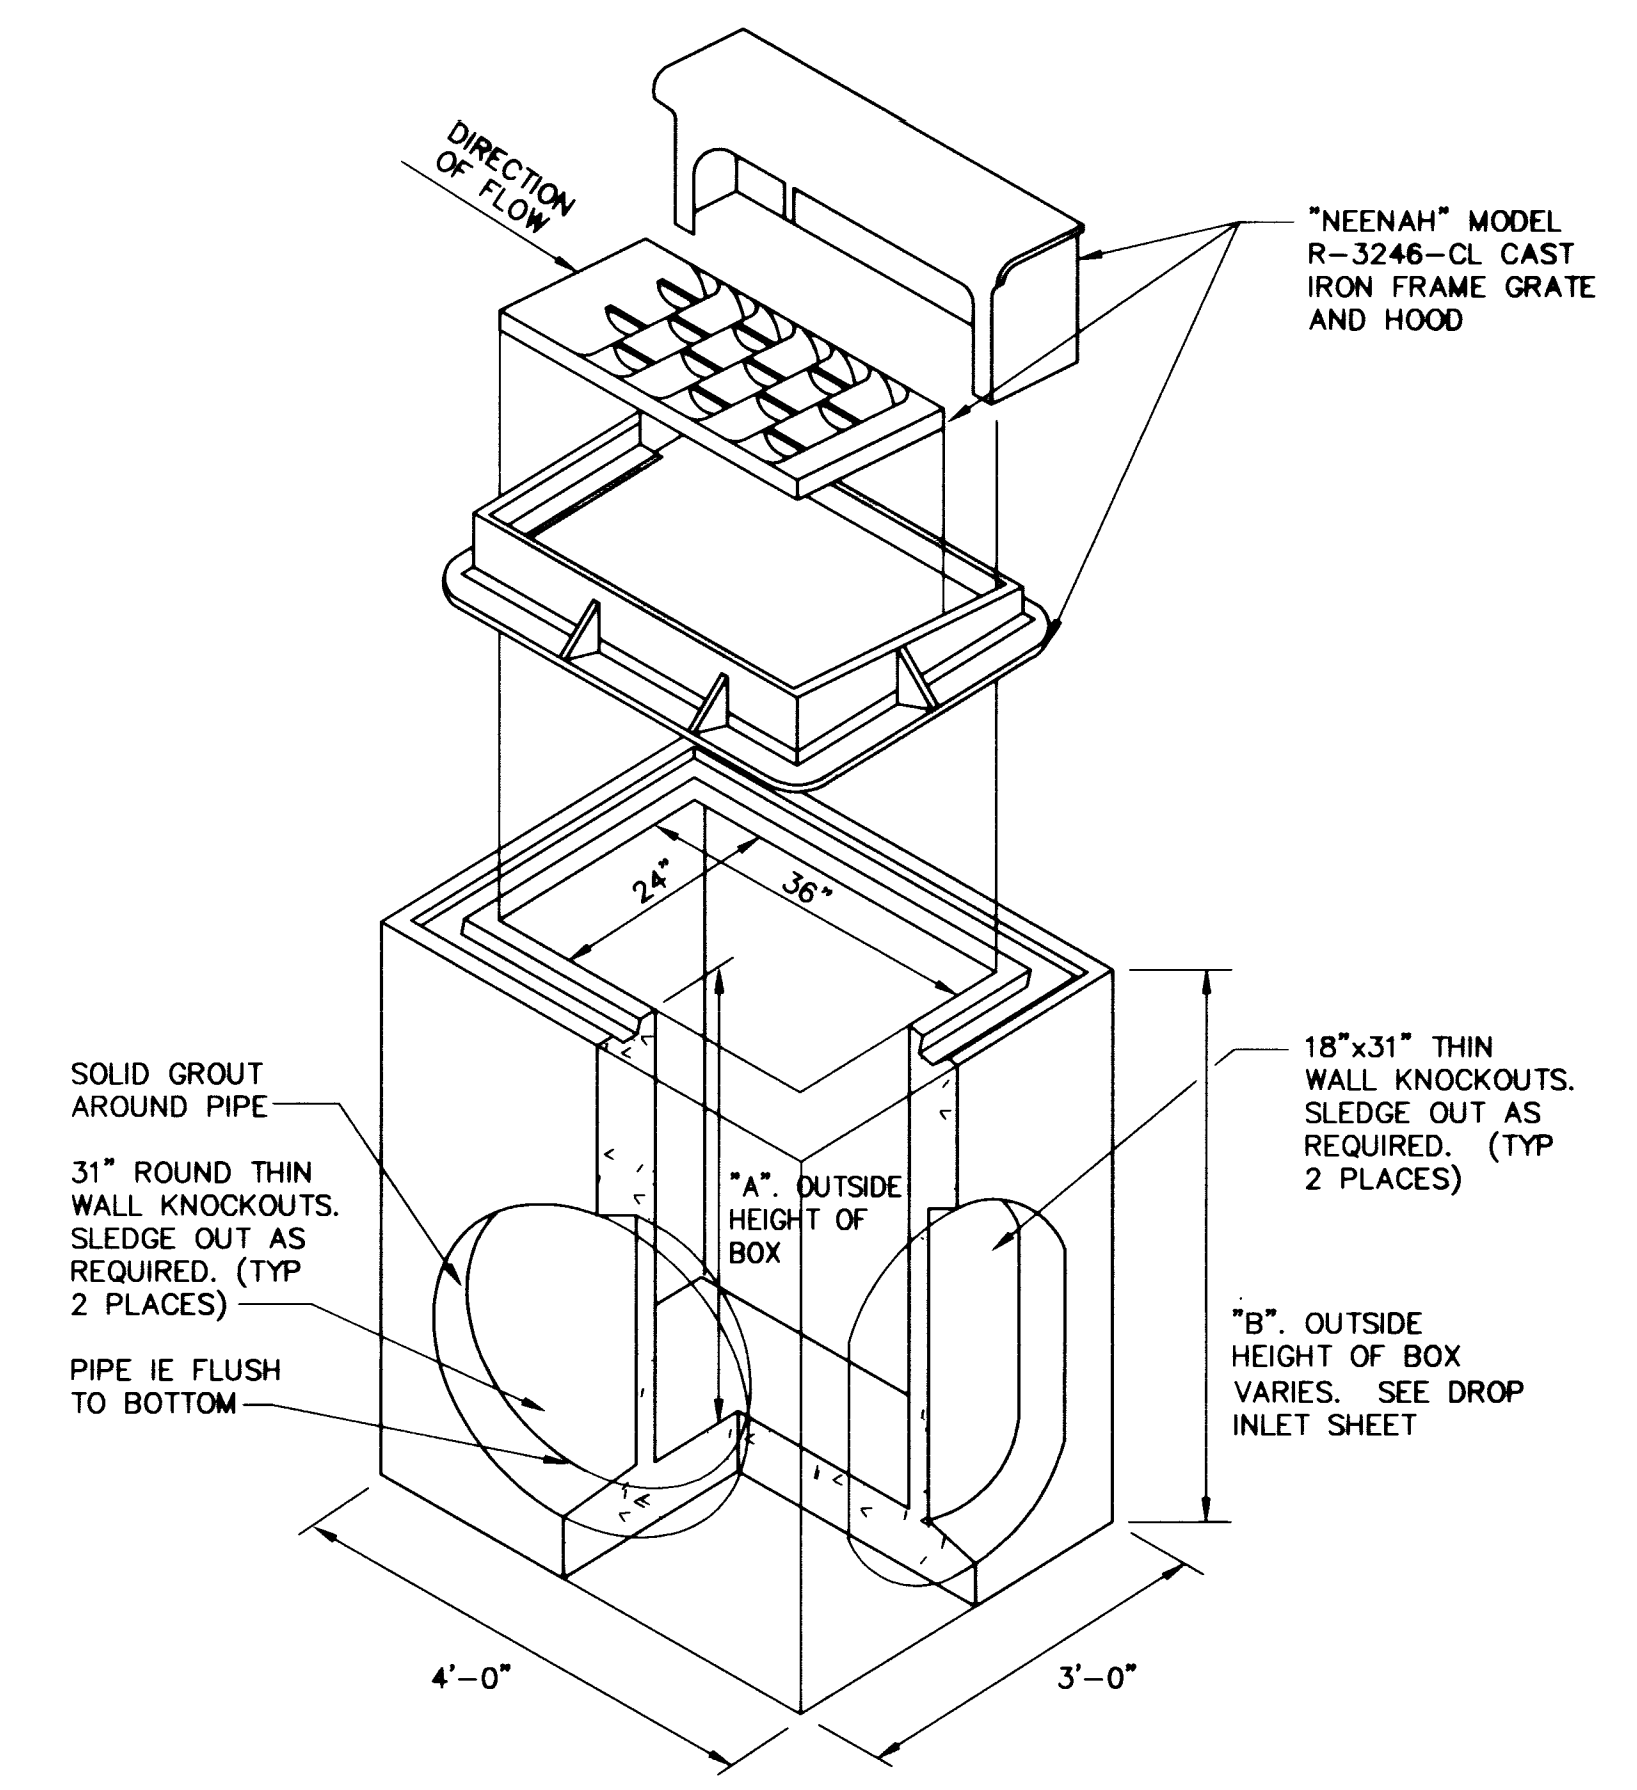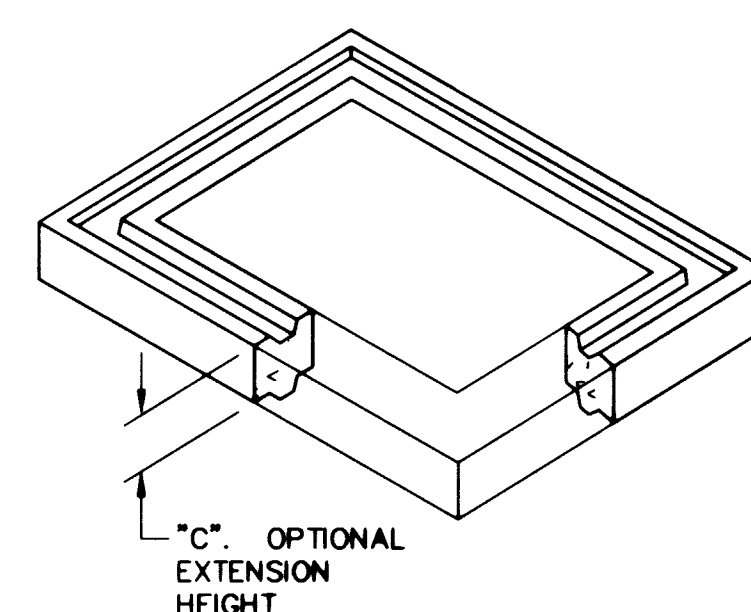

DROP INLET		
MODEL NO.	A	B
D/243636-4R	36"	42"
D/243648-4R	48"	54"
D/243660-4R	60"	66"
D/243672-4R	72"	78"

EXTENSION	
MODEL NO.	C
RS243606	6"
RS243612	12"

- NOTES:
- BOX DESIGN LOAD: H-20 FULL TRAFFIC.
 - FOR COMPLETE DESIGN AND PRODUCT INFORMATION, CONTACT JENSEN PRECAST

24"x36" CURB INLET
NO SCALE

1

RECORD DRAWINGS
NOT FOR CONSTRUCTION

- TO ALTER THESE DOCUMENTS FOR ANOTHER PROJECT BY ANYONE OTHER THAN THE ORIGINAL ARCHITECT IS A VIOLATION OF NRS 633.
- THIS RECORD DRAWING HAS BEEN PREPARED IN PART, BASED UPON INFORMATION FURNISHED BY THE GENERAL CONTRACTOR, WHILE THIS INFORMATION IS BELIEVED TO BE RELIABLE, THE DESIGN PROFESSIONAL CANNOT ASSURE ITS ACCURACY, AND THIS IS NOT RESPONSIBLE FOR THE ACCURACY OF THIS RECORD DRAWING OR FOR ANY ERRORS OR OMISSIONS WHICH MAY HAVE BEEN INCORPORATED INTO IT AS A RESULT, THE DESIGN PROFESSIONAL CANNOT AND DOES NOT WARRANT THEIR ACCURACY.
- INFORMATION THAT MAY BE INCLUDED WOULD BE SIGNIFICANT CHANGES TO ROOM ARRANGEMENTS ON THE FLOOR PLANS AND ASSOCIATED DRAWINGS, MINOR DIMENSION OR CONSTRUCTION DETAIL CHANGES MAY NOT BE INCLUDED.

CONTRACTOR _____ DATE _____

FILE: 040-000 SCALE: 1:1, 03/20, 10/07, 01/09, 04/14 - 0400-000-013-044

POGGEMEYER DESIGN GROUP
ENGINEERS PLANNERS SURVEYORS
LANDSCAPE ARCHITECTS
2601 NORTH TENAYA WAY
LAS VEGAS, NEVADA 89128 (702) 255-8100

GREELEY AND HANSEN
ENGINEERS
4625 SOUTH POLARIS AVENUE, SUITE 210
LAS VEGAS, NEVADA 89103 (702) 736-7062
32237

DESIGNED	SW	APPROVED	
DRAWN	FT		
CHECKED	MBH		
NO.	DATE	APPD	REVISION

CITY OF LAS VEGAS, NEVADA
DEPARTMENT OF PUBLIC WORKS
NORTHWEST WATER RESOURCE CENTER
100% DESIGN

TYPICAL DETAILS

PROJ. NO.	7190
DWG	PDG 13
SHEET	13 OF 13
DATE	07.21.98
REV	0