


NOTE:
1. CAP ALL LATERALS AT TERMINATION.

MATCHLINE
STA. 18+50.00
SEE SHEET SS3

MATCHLINE
STA. 18+50.00
SEE SHEET SS3

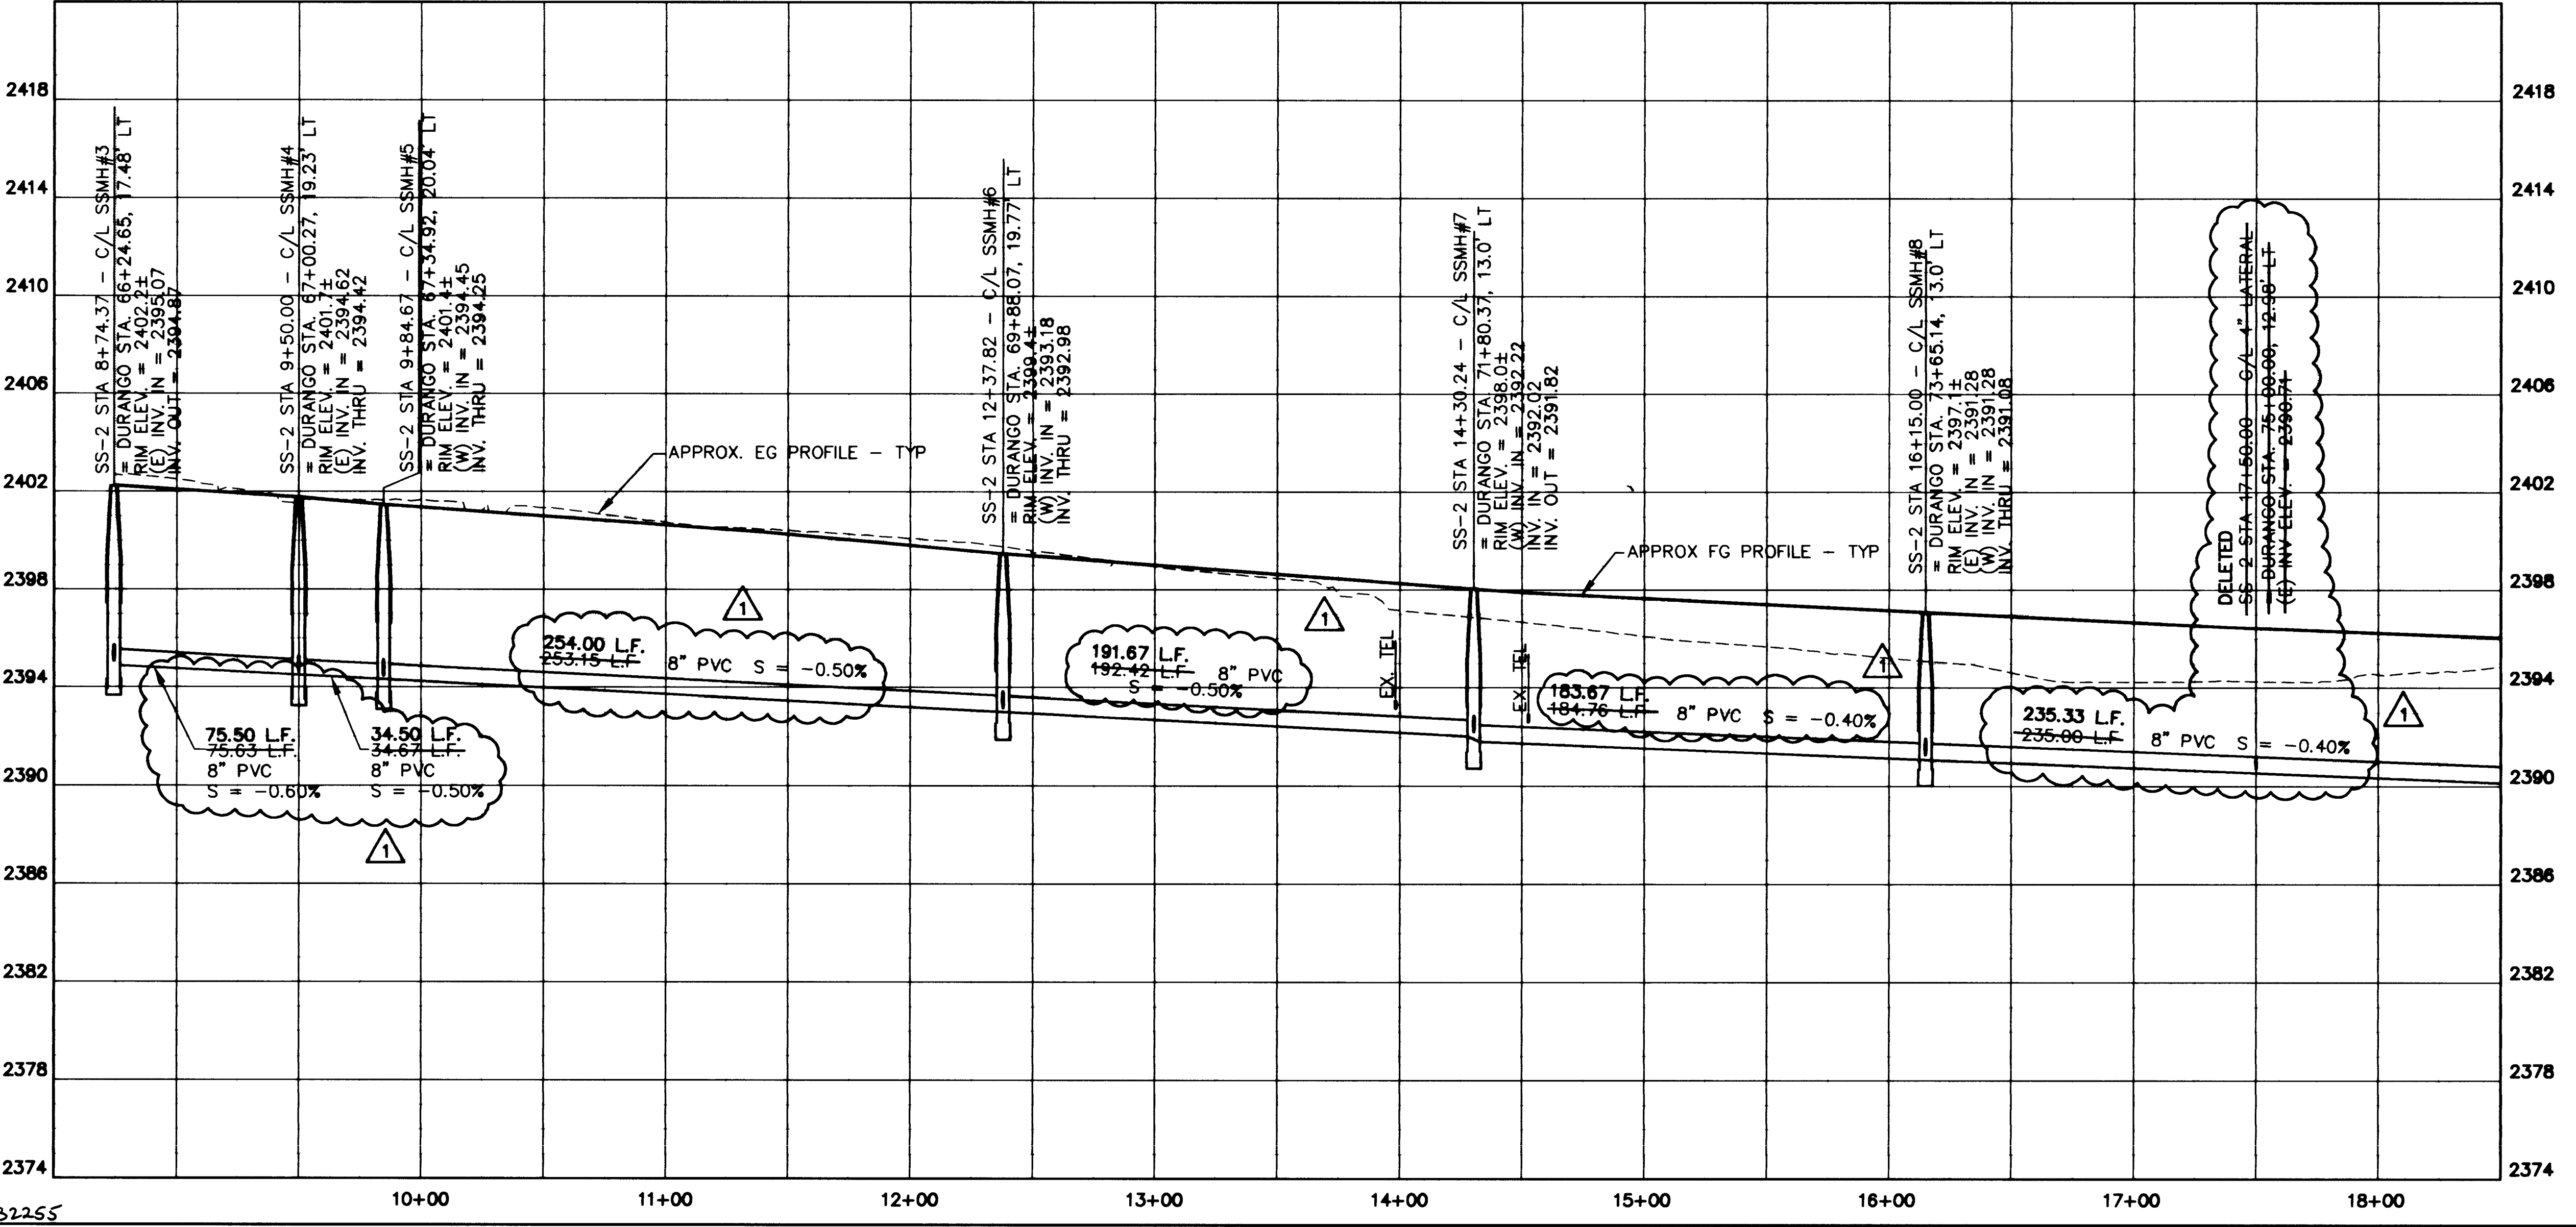

REVIEWS: MS = "C", PS = "PLT"
I:\CAD\PLANS\13249\13249-SS.DWG

DEPARTMENT OF PUBLIC WORKS
CITY OF LAS VEGAS, NEVADA

03/16/01 LMW CHANGED PER AS-BUILTS

REV	DATE	BY	REVISION

CONSULTING ENGINEERS • PLANNERS • LAND SURVEYORS
2727 SOUTH RAINBOW BOULEVARD
LAS VEGAS, NEVADA 89102-5148 PHONE (702) 873-7550 FAX (702) 362-2597

vtn nevada

SANITARY SEWER PLAN & PROFILE
SS2 STA. 10+00 TO STA. 18+50
DURANGO DRIVE

PROJECT
DURANGO DRIVE IMPROVEMENTS
CHEYENNE AVENUE TO LONE MOUNTAIN ROAD

SEAL

NO. NO. 5249

BY JL/LMW
DATE 07/17/98
SCALE HORIZ. 1"=40'
VERT. 1"=4'
DRAWING SS2 SHEET 71 OF 106 SHEETS