

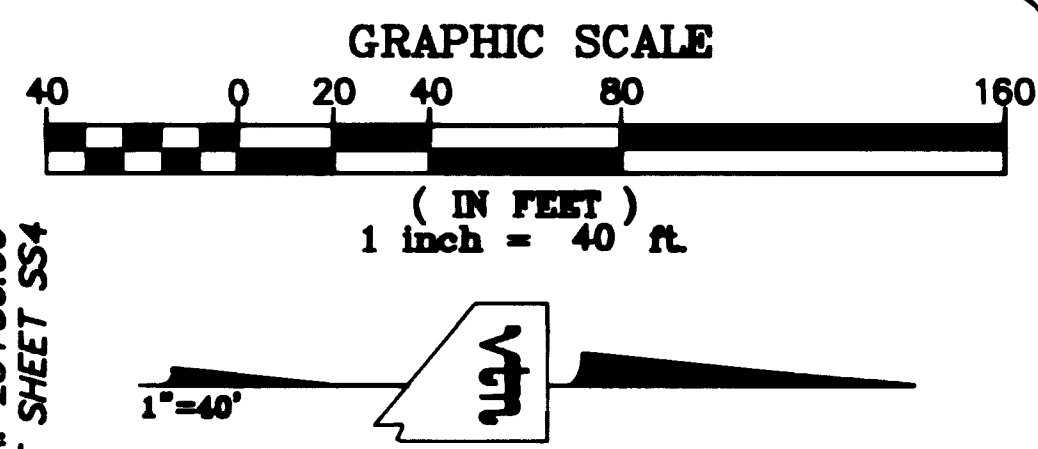


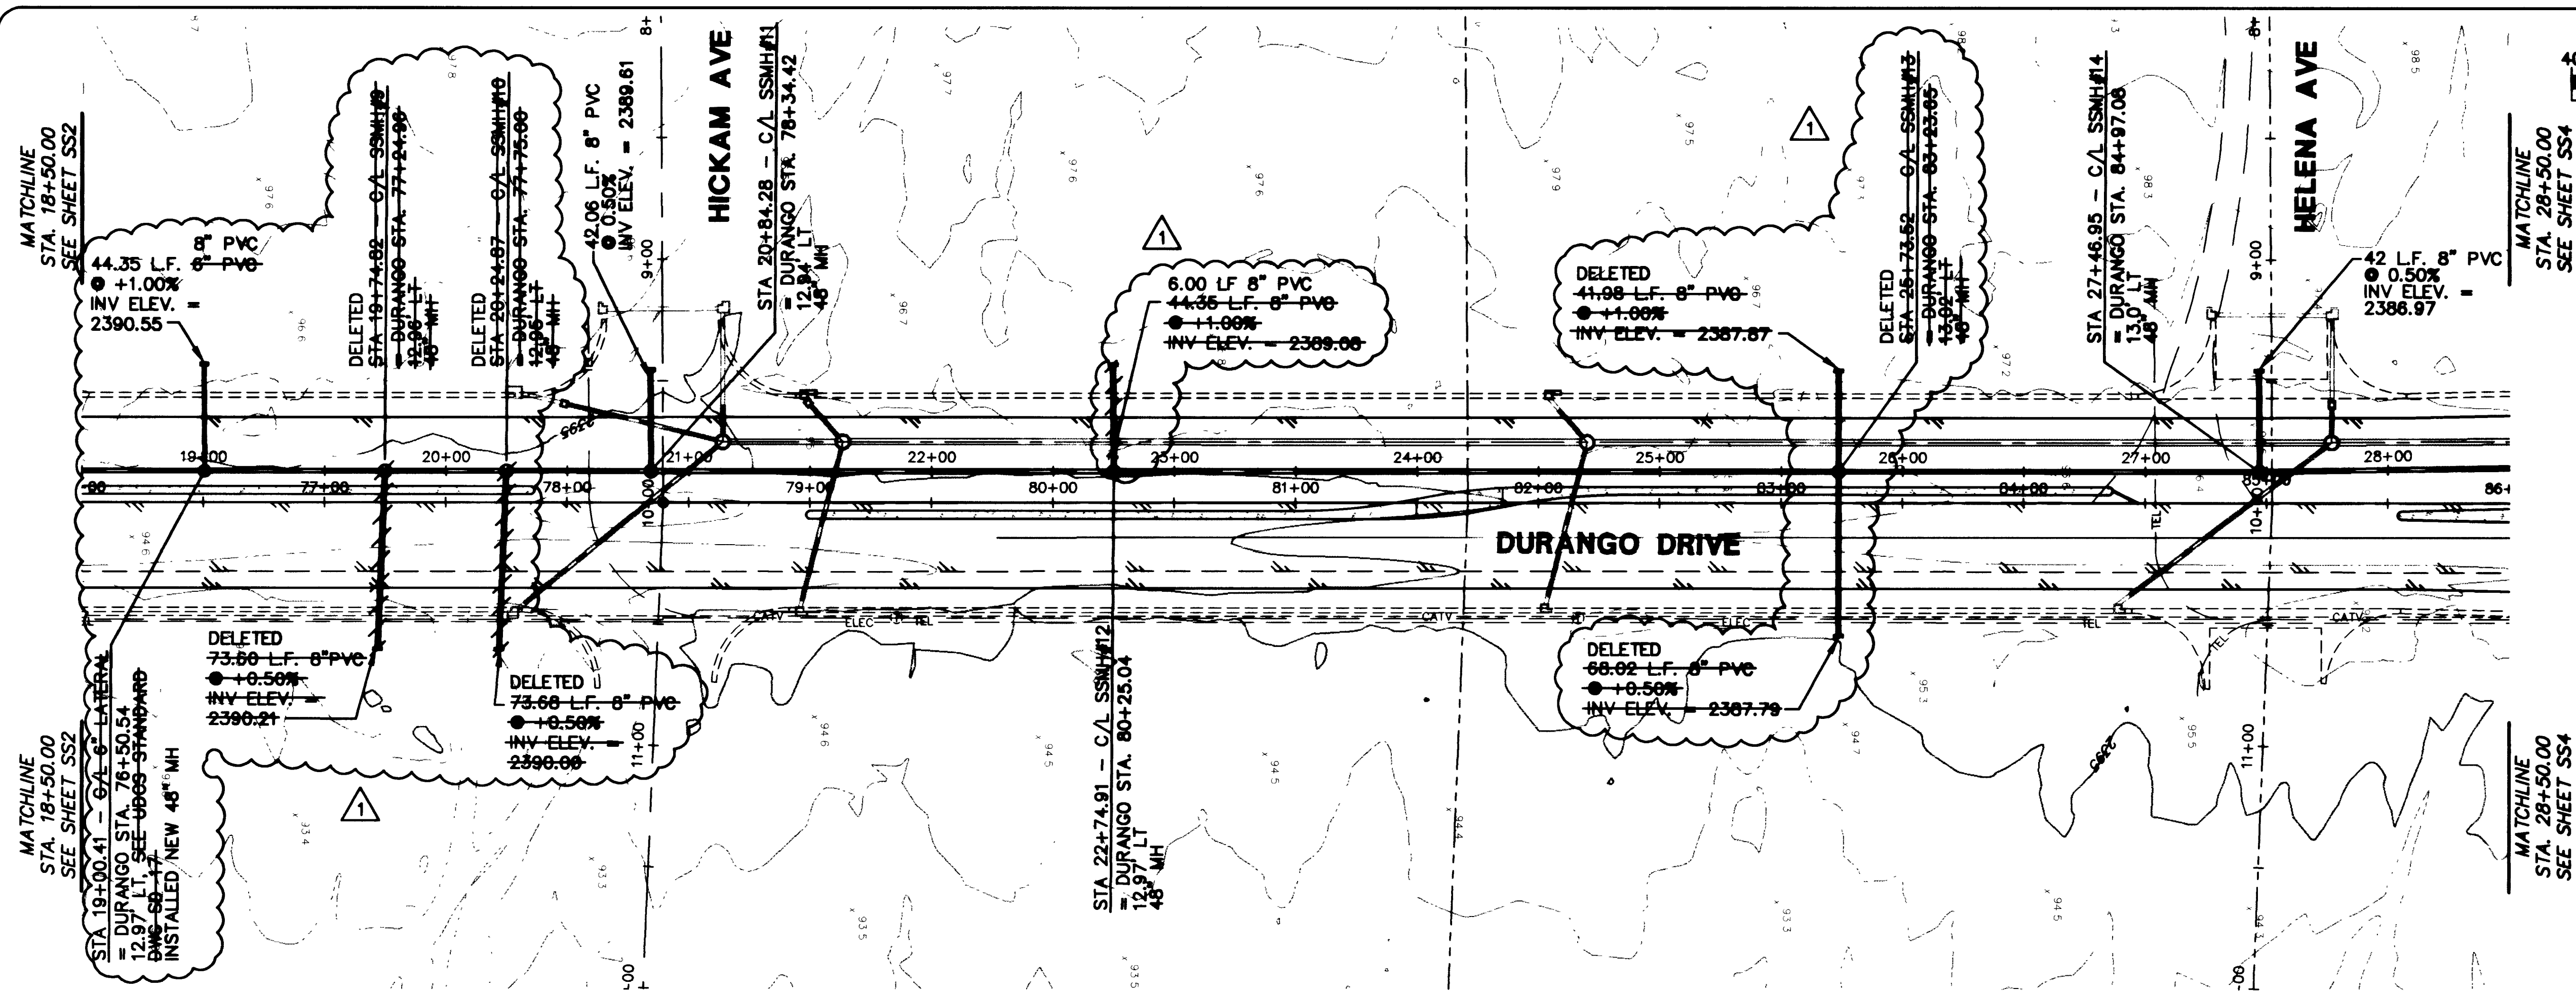

NOTE:
1. CAP ALL LATERALS AT TERMINATION.

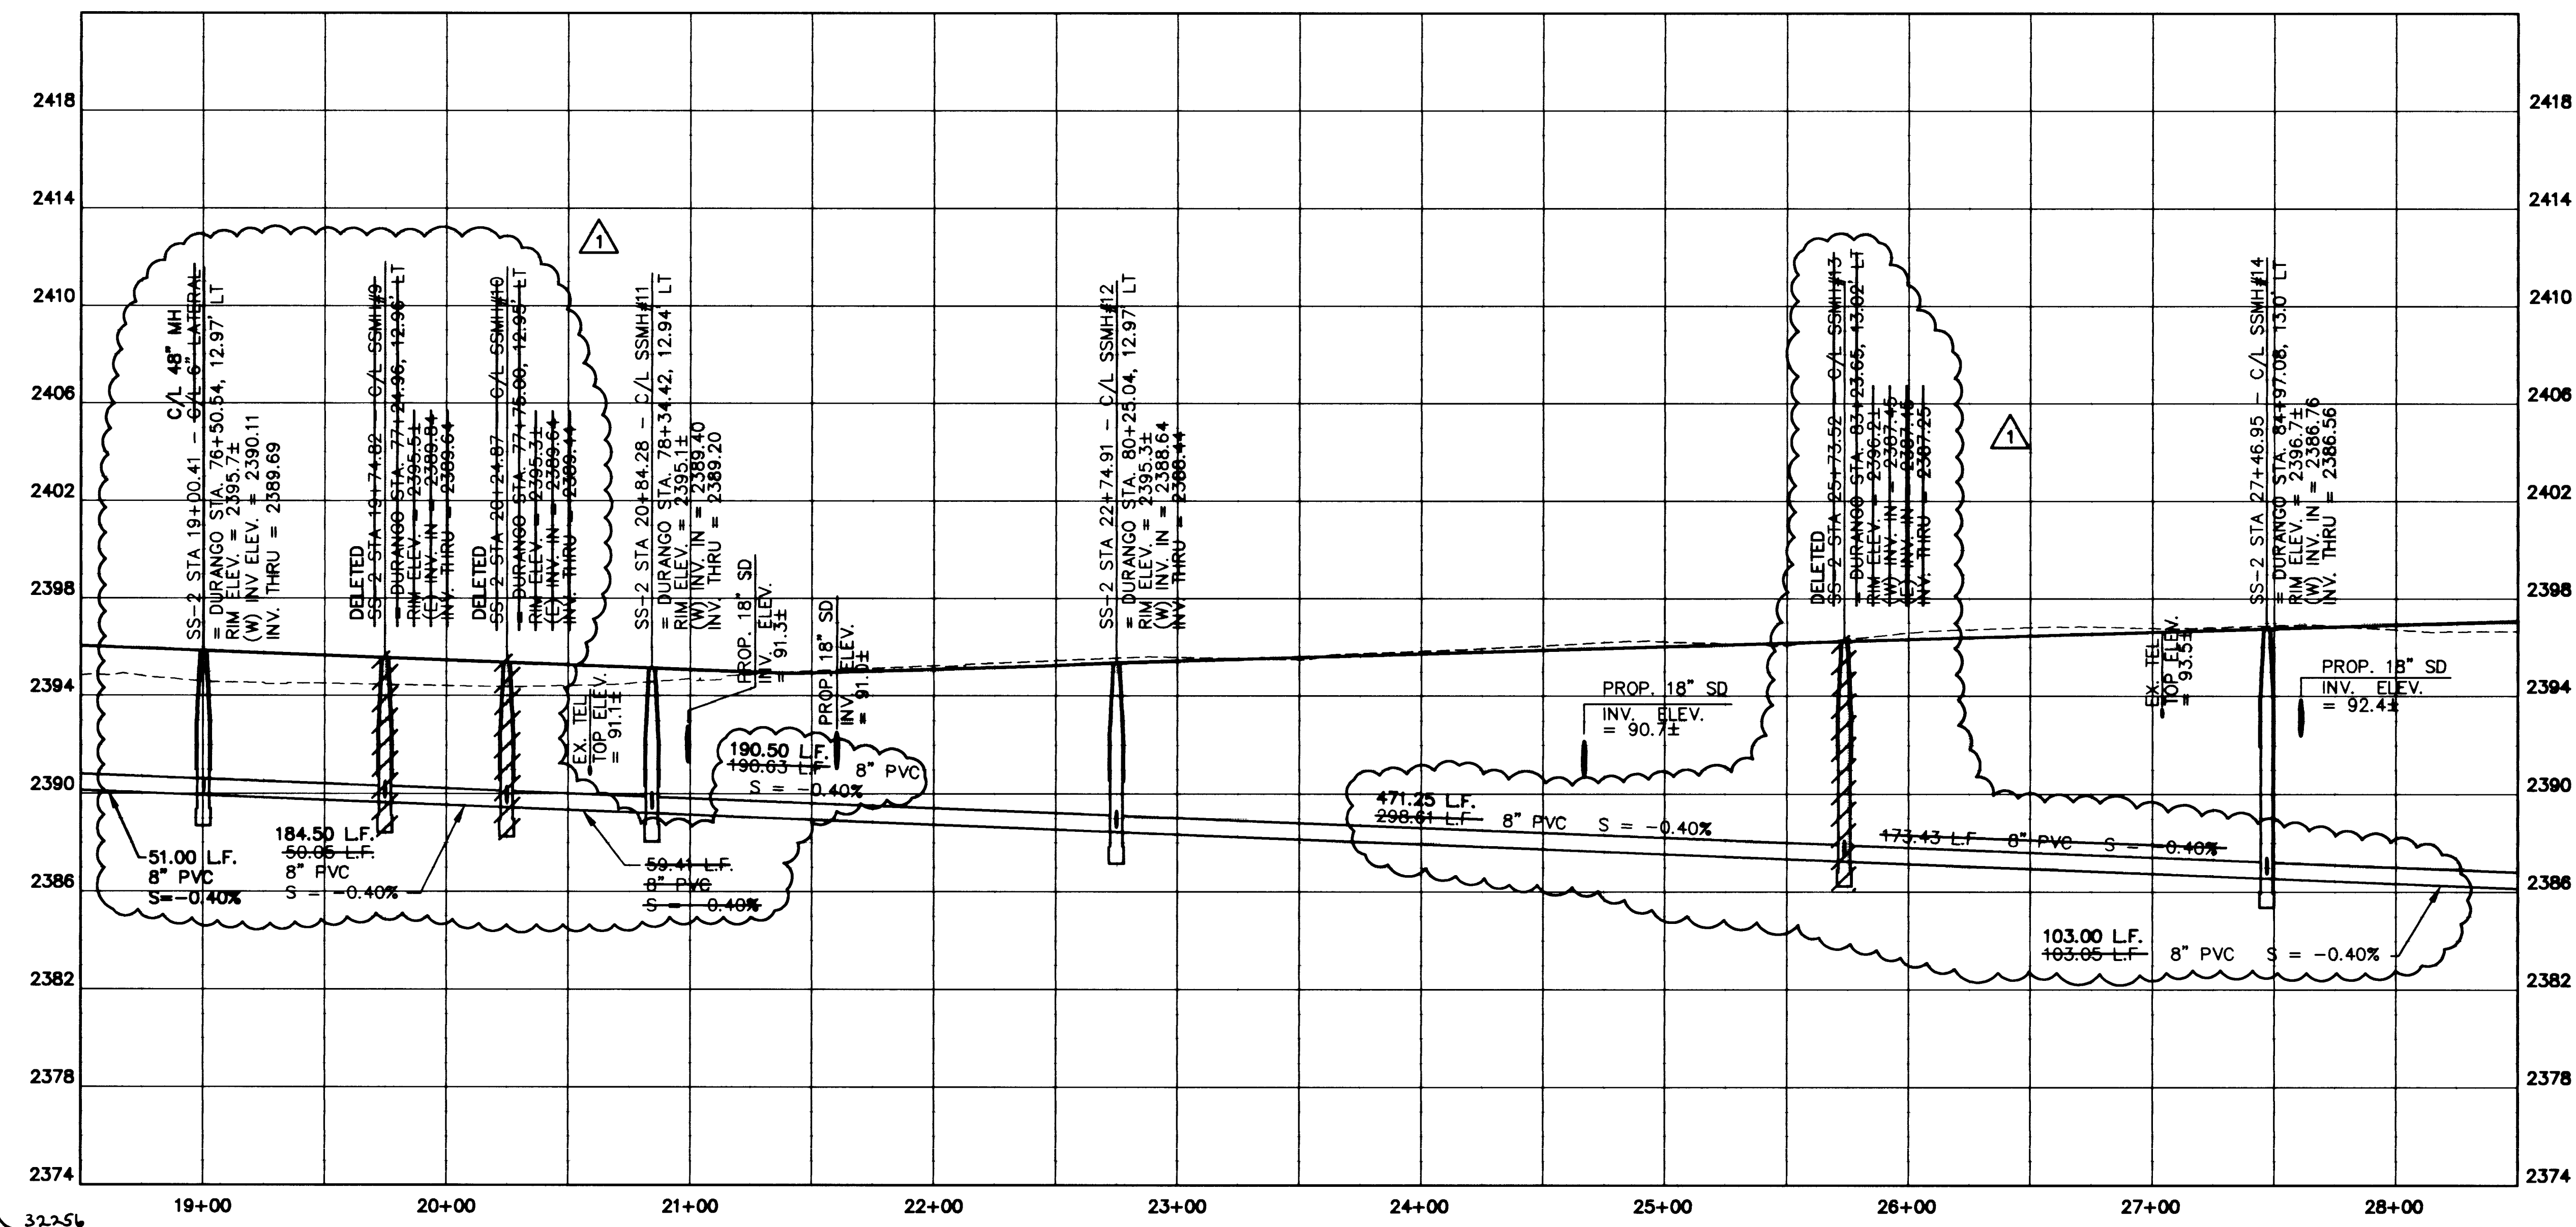

DEPARTMENT OF PUBLIC WORKS		A	03/16/01	LMW	CHANGED PER AS-BUILTS
		>			
		>			
		REV	DATE	BY	REVISION

0

SANITARY SEWER PLAN & PROFILE SS2 STA. 18+50 TO STA. 28+50 DURANGO DRIVE	DURANGO DRIVE IMPROVEMENTS CHEYENNE AVENUE TO LONE MOUNTAIN ROAD
--	--

SEAL	
WG. NO.	
5249	
BY	
JL/LMW	
DATE	
07/17/98	
SCALE	
HORIZ.	1"=40'
VERT.	1"=4'
DRAWING	SHEET
SS3	72 OF
	106 SHEETS