


NOTE:  
1. CAP ALL LATERALS AT TERMINATION.

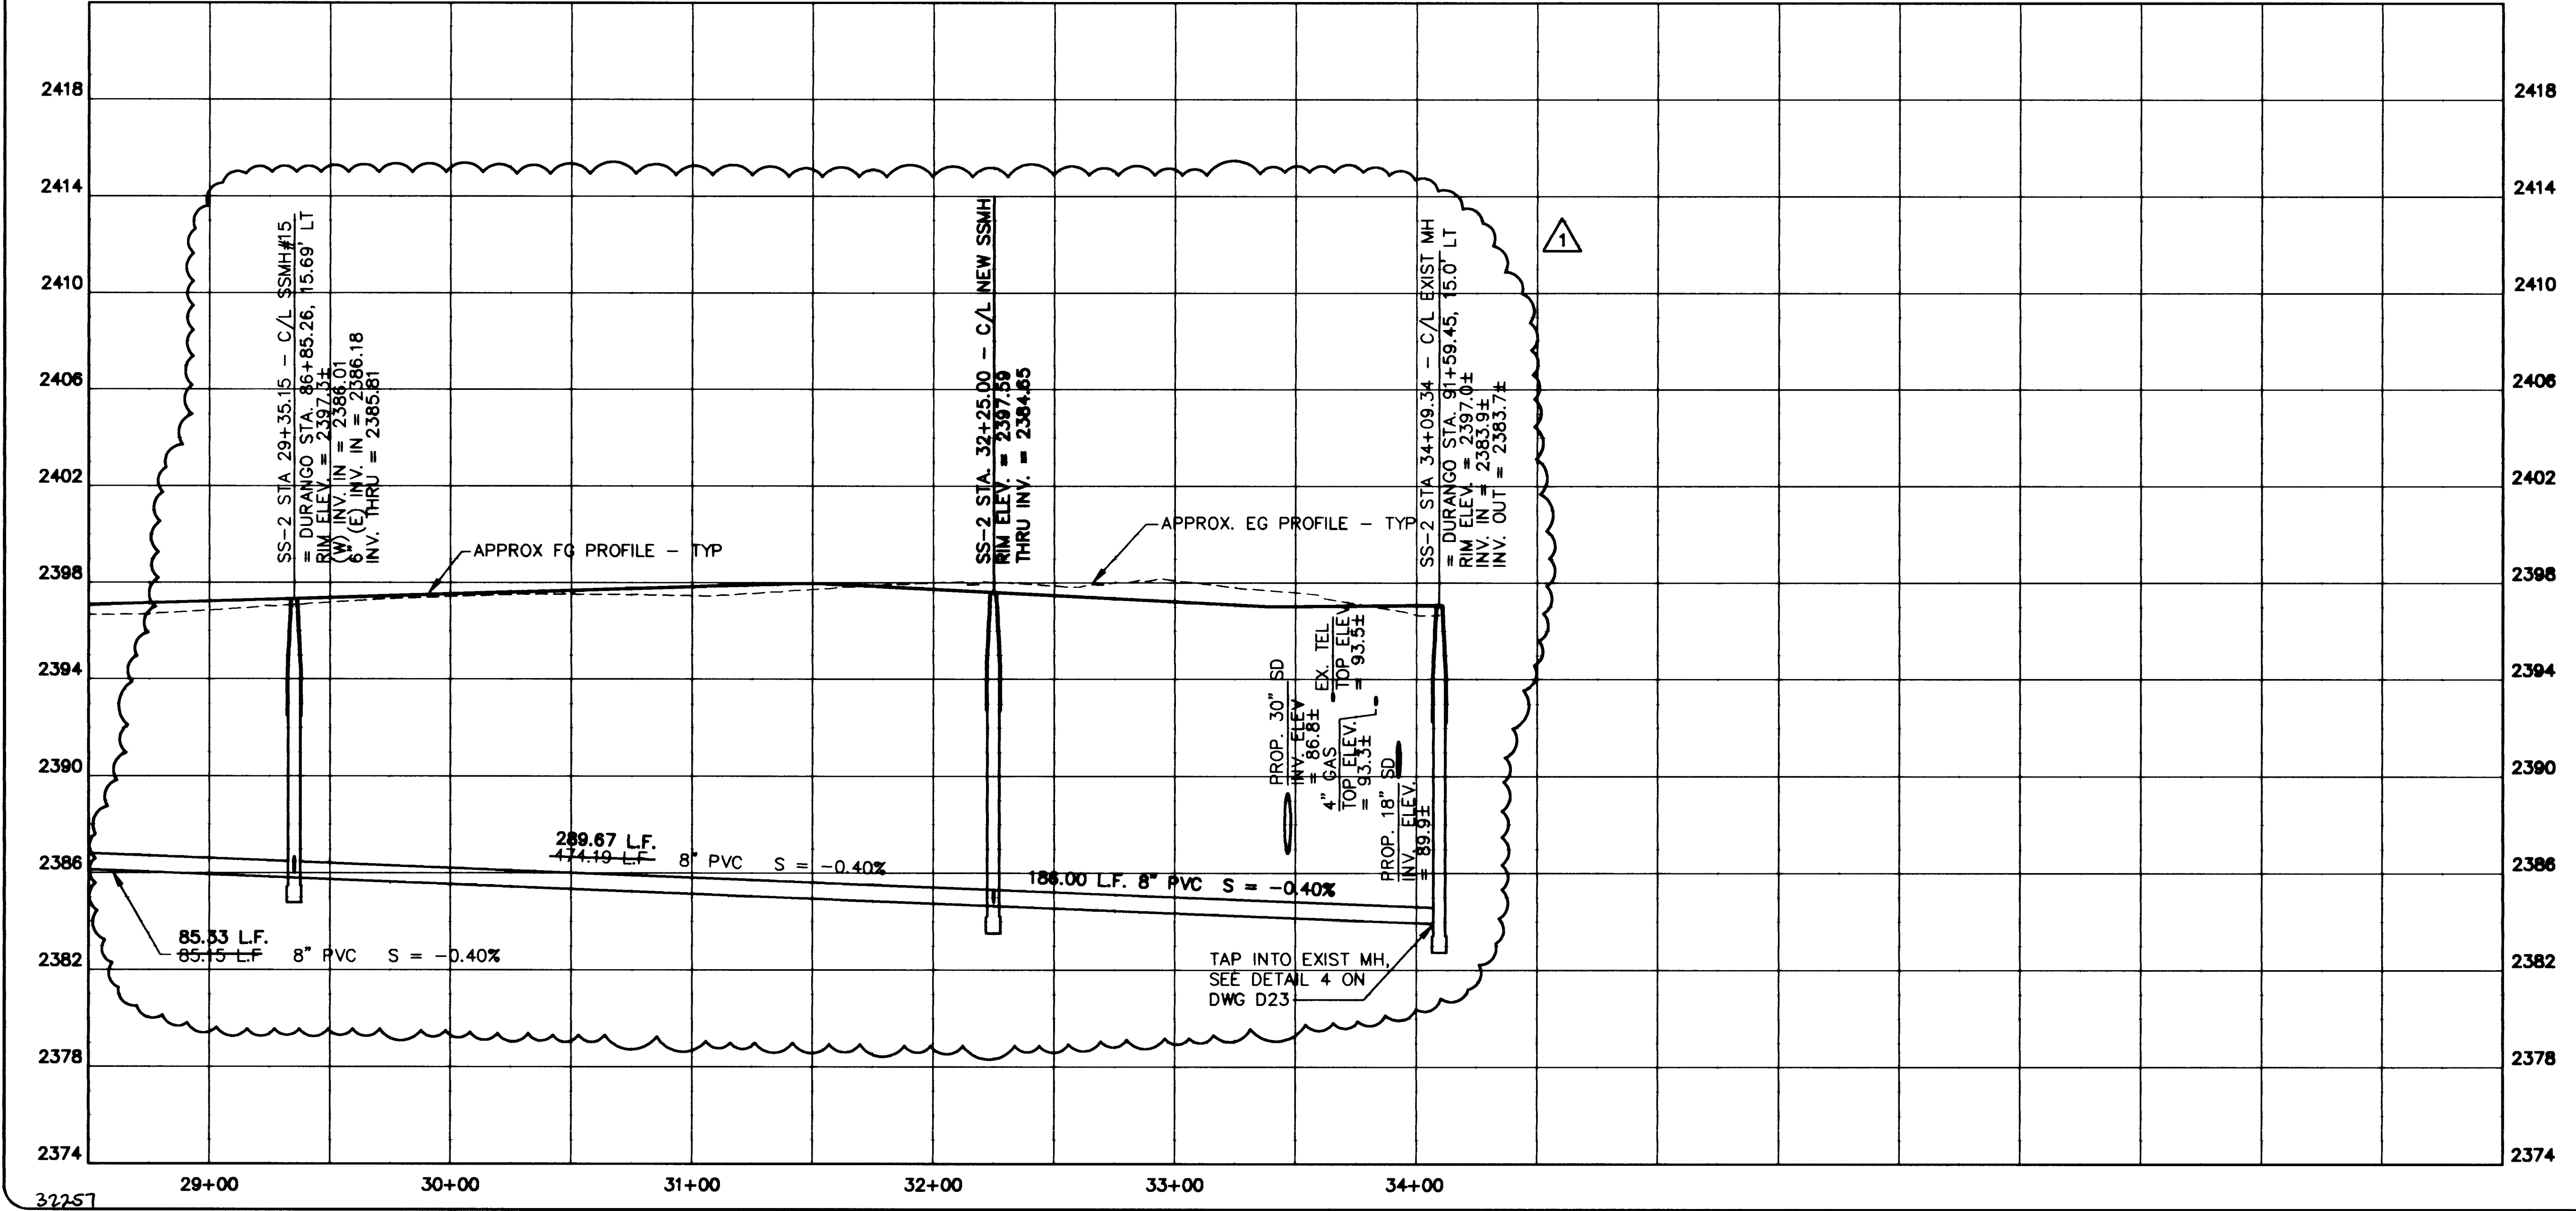

PLT  
SS4

DEPARTMENT OF PUBLIC WORKS  
CITY OF LAS VEGAS, NEVADA

03/16/01 LMW CHANGED PER AS-BUILTS

CONSULTING ENGINEERS • PLANNERS • LAND SURVEYORS  
2727 SOUTH RAINBOW BOULEVARD  
LAS VEGAS, NEVADA 89102-5148 PHONE (702) 873-7550 FAX (702) 362-2597

**vtn** nevada

SANITARY SEWER PLAN & PROFILE  
SS2 STA. 28+50 TO STA. 34+09.34  
DURANGO DRIVE

PROJECT  
DURANGO DRIVE IMPROVEMENTS  
CHEYENNE AVENUE TO LONE MOUNTAIN ROAD

WO. NO. 5249

BY JL/LMW  
DATE 07/17/98

SCALE HORIZ. 1"=40'  
VERT. 1"=4'

DRAWING SHEET 73 OF 93  
SS4 106 SHEETS