


**NOTE:**  
1. CAP ALL LATERALS AT TERMINATION.

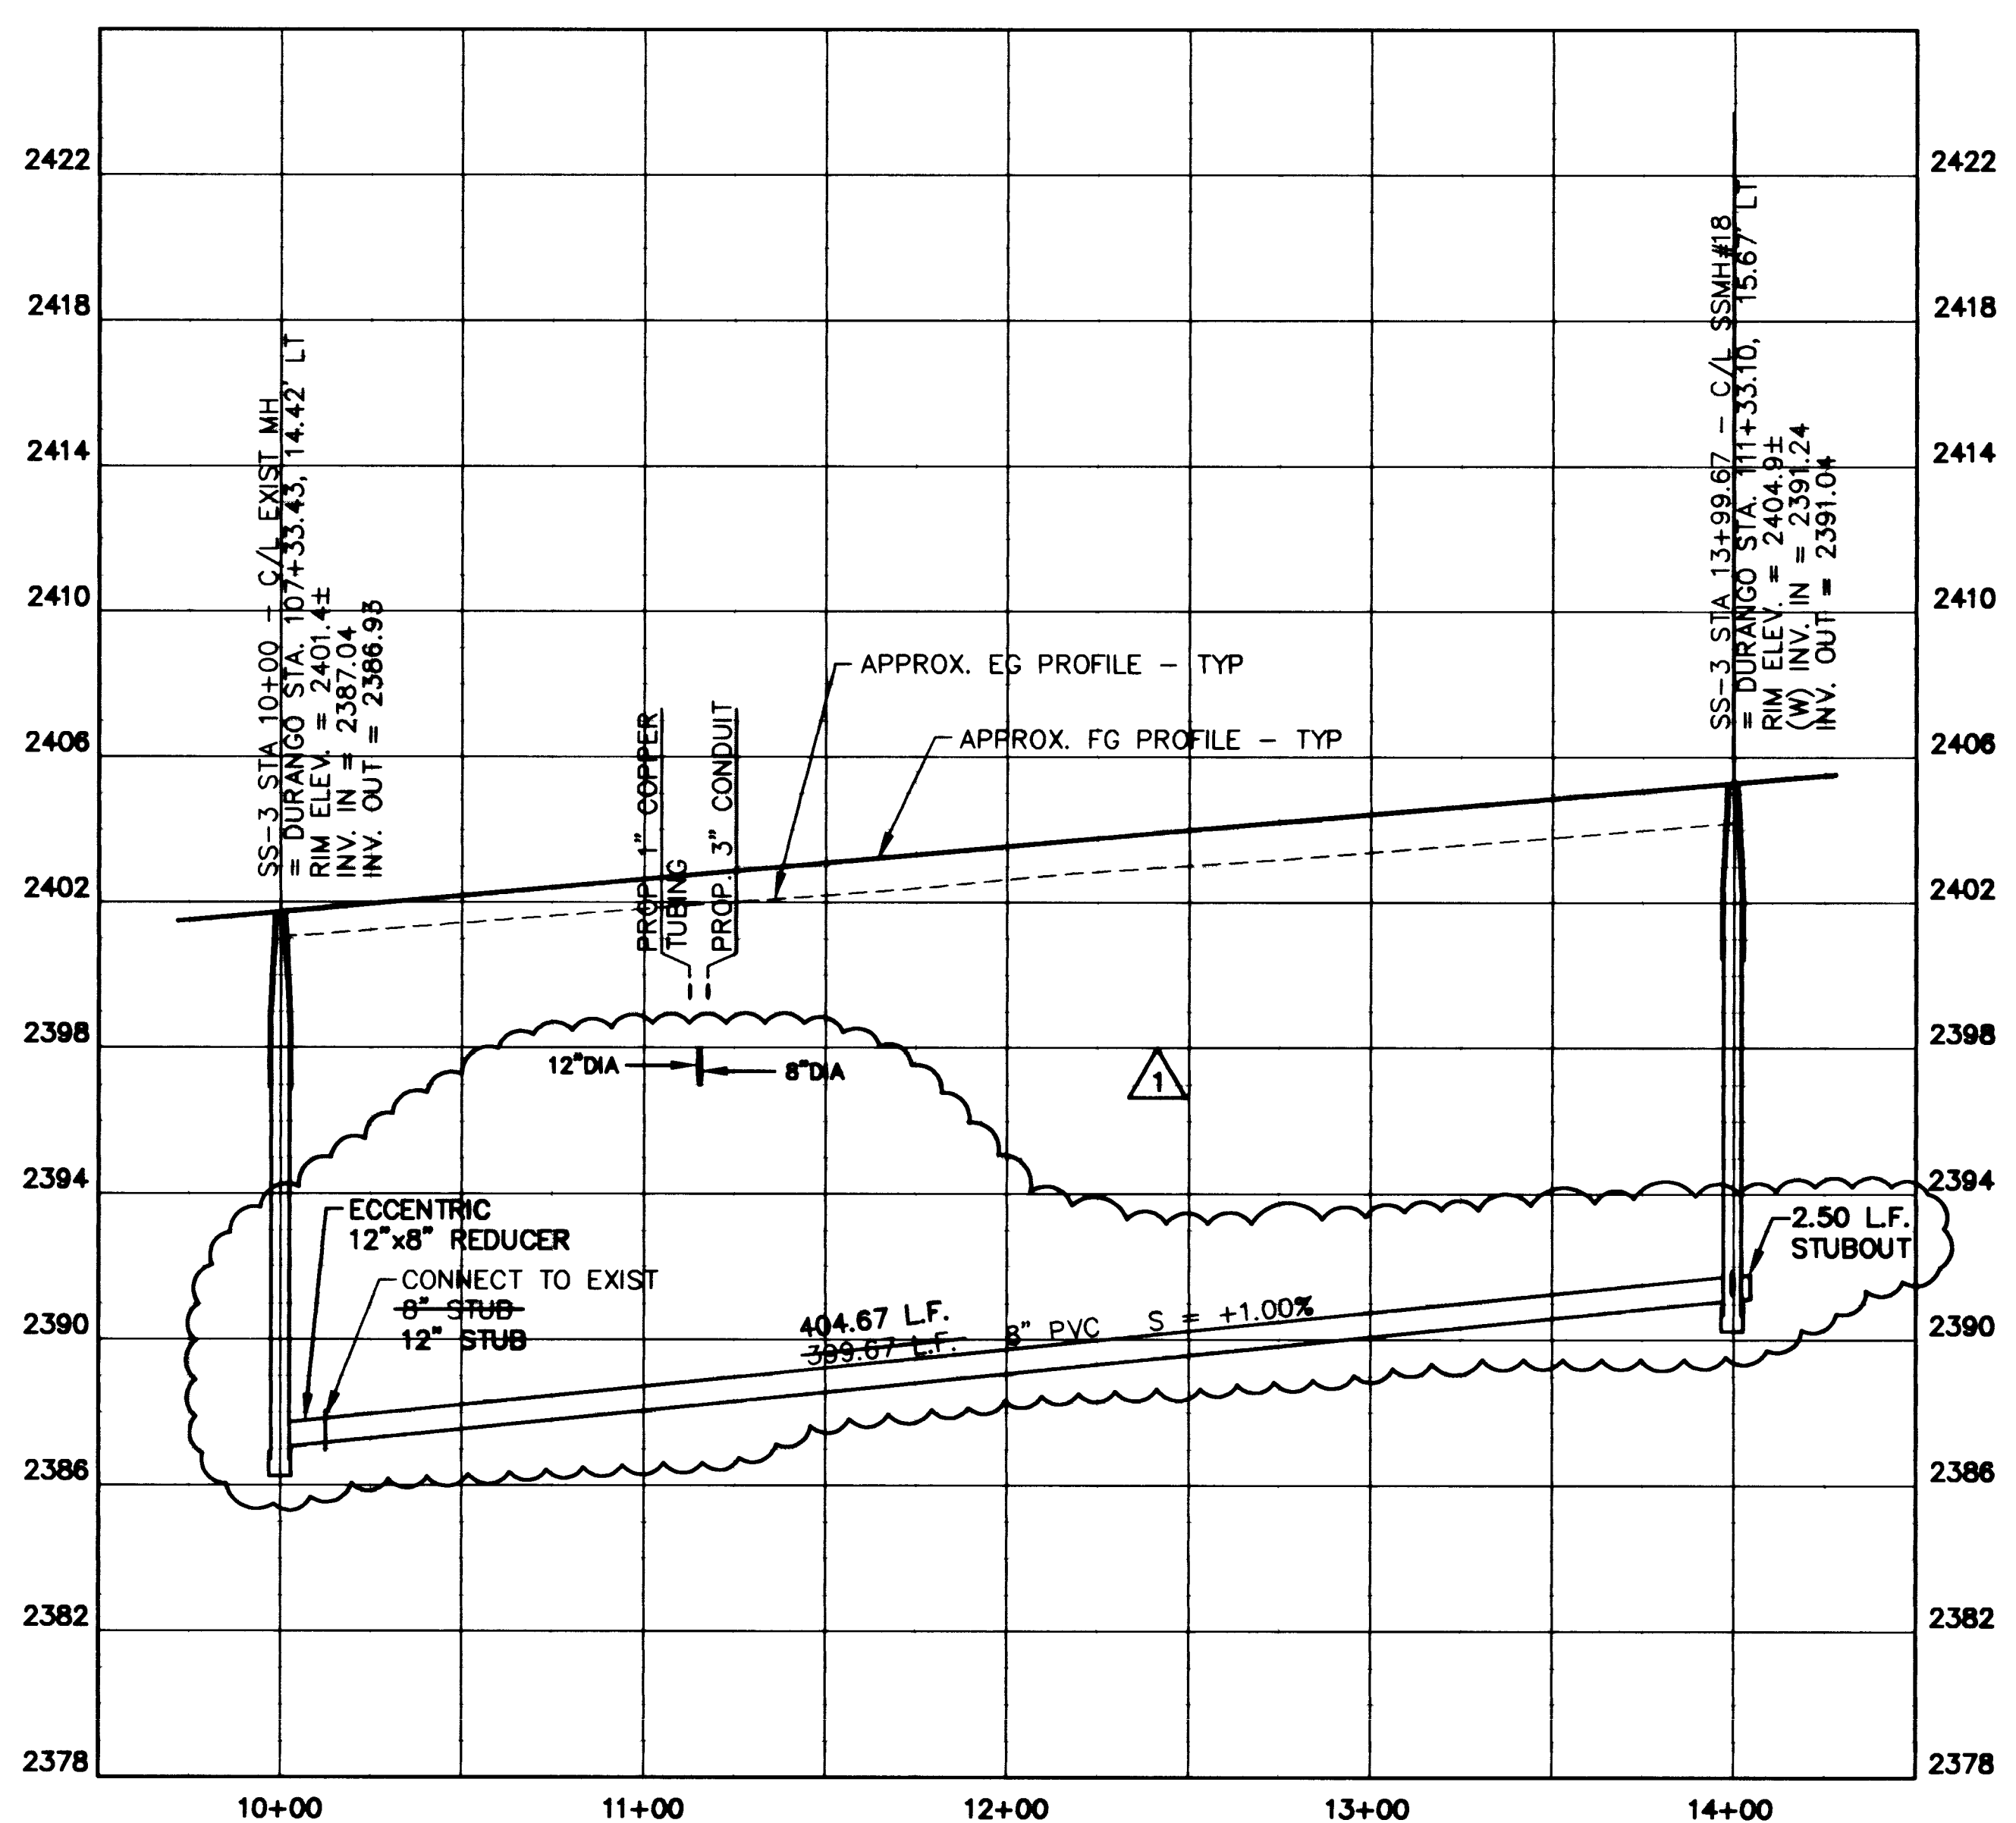

VIEWS: MS = "K", PS = "PLT"  
 I:\CAD\PUBLIC\WORK\5249\5249-SS.DWG

32259

DEPARTMENT OF PUBLIC WORKS CITY OF LAS VEGAS, NEVADA		CHANGED PER AS-BUILTS	
REV	DATE	BY	REASON
1	03/16/01	LMW	

CONSULTING ENGINEERS • PLANNERS • LAND SURVEYORS  
 2727 SOUTH RAINBOW BOULEVARD  
 LAS VEGAS, NEVADA 89102-5148 PHONE (702) 873-7550 FAX (702) 362-2597

**SANITARY SEWER PLAN & PROFILE**  
 SS3 STA. 10+00 TO STA. 13+99.67  
 DURANGO DRIVE

PROJECT: DURANGO DRIVE IMPROVEMENTS  
 CHEYENNE AVENUE TO LONE MOUNTAIN ROAD

SEAL

WO. NO.	5249
BY	JL/LMW
DATE	07/17/98
SCALE	HORIZ. 1"=40' VERT. 1"=4'
DRAWING	SS6
SHEET	75
OF	106
SHEETS	