


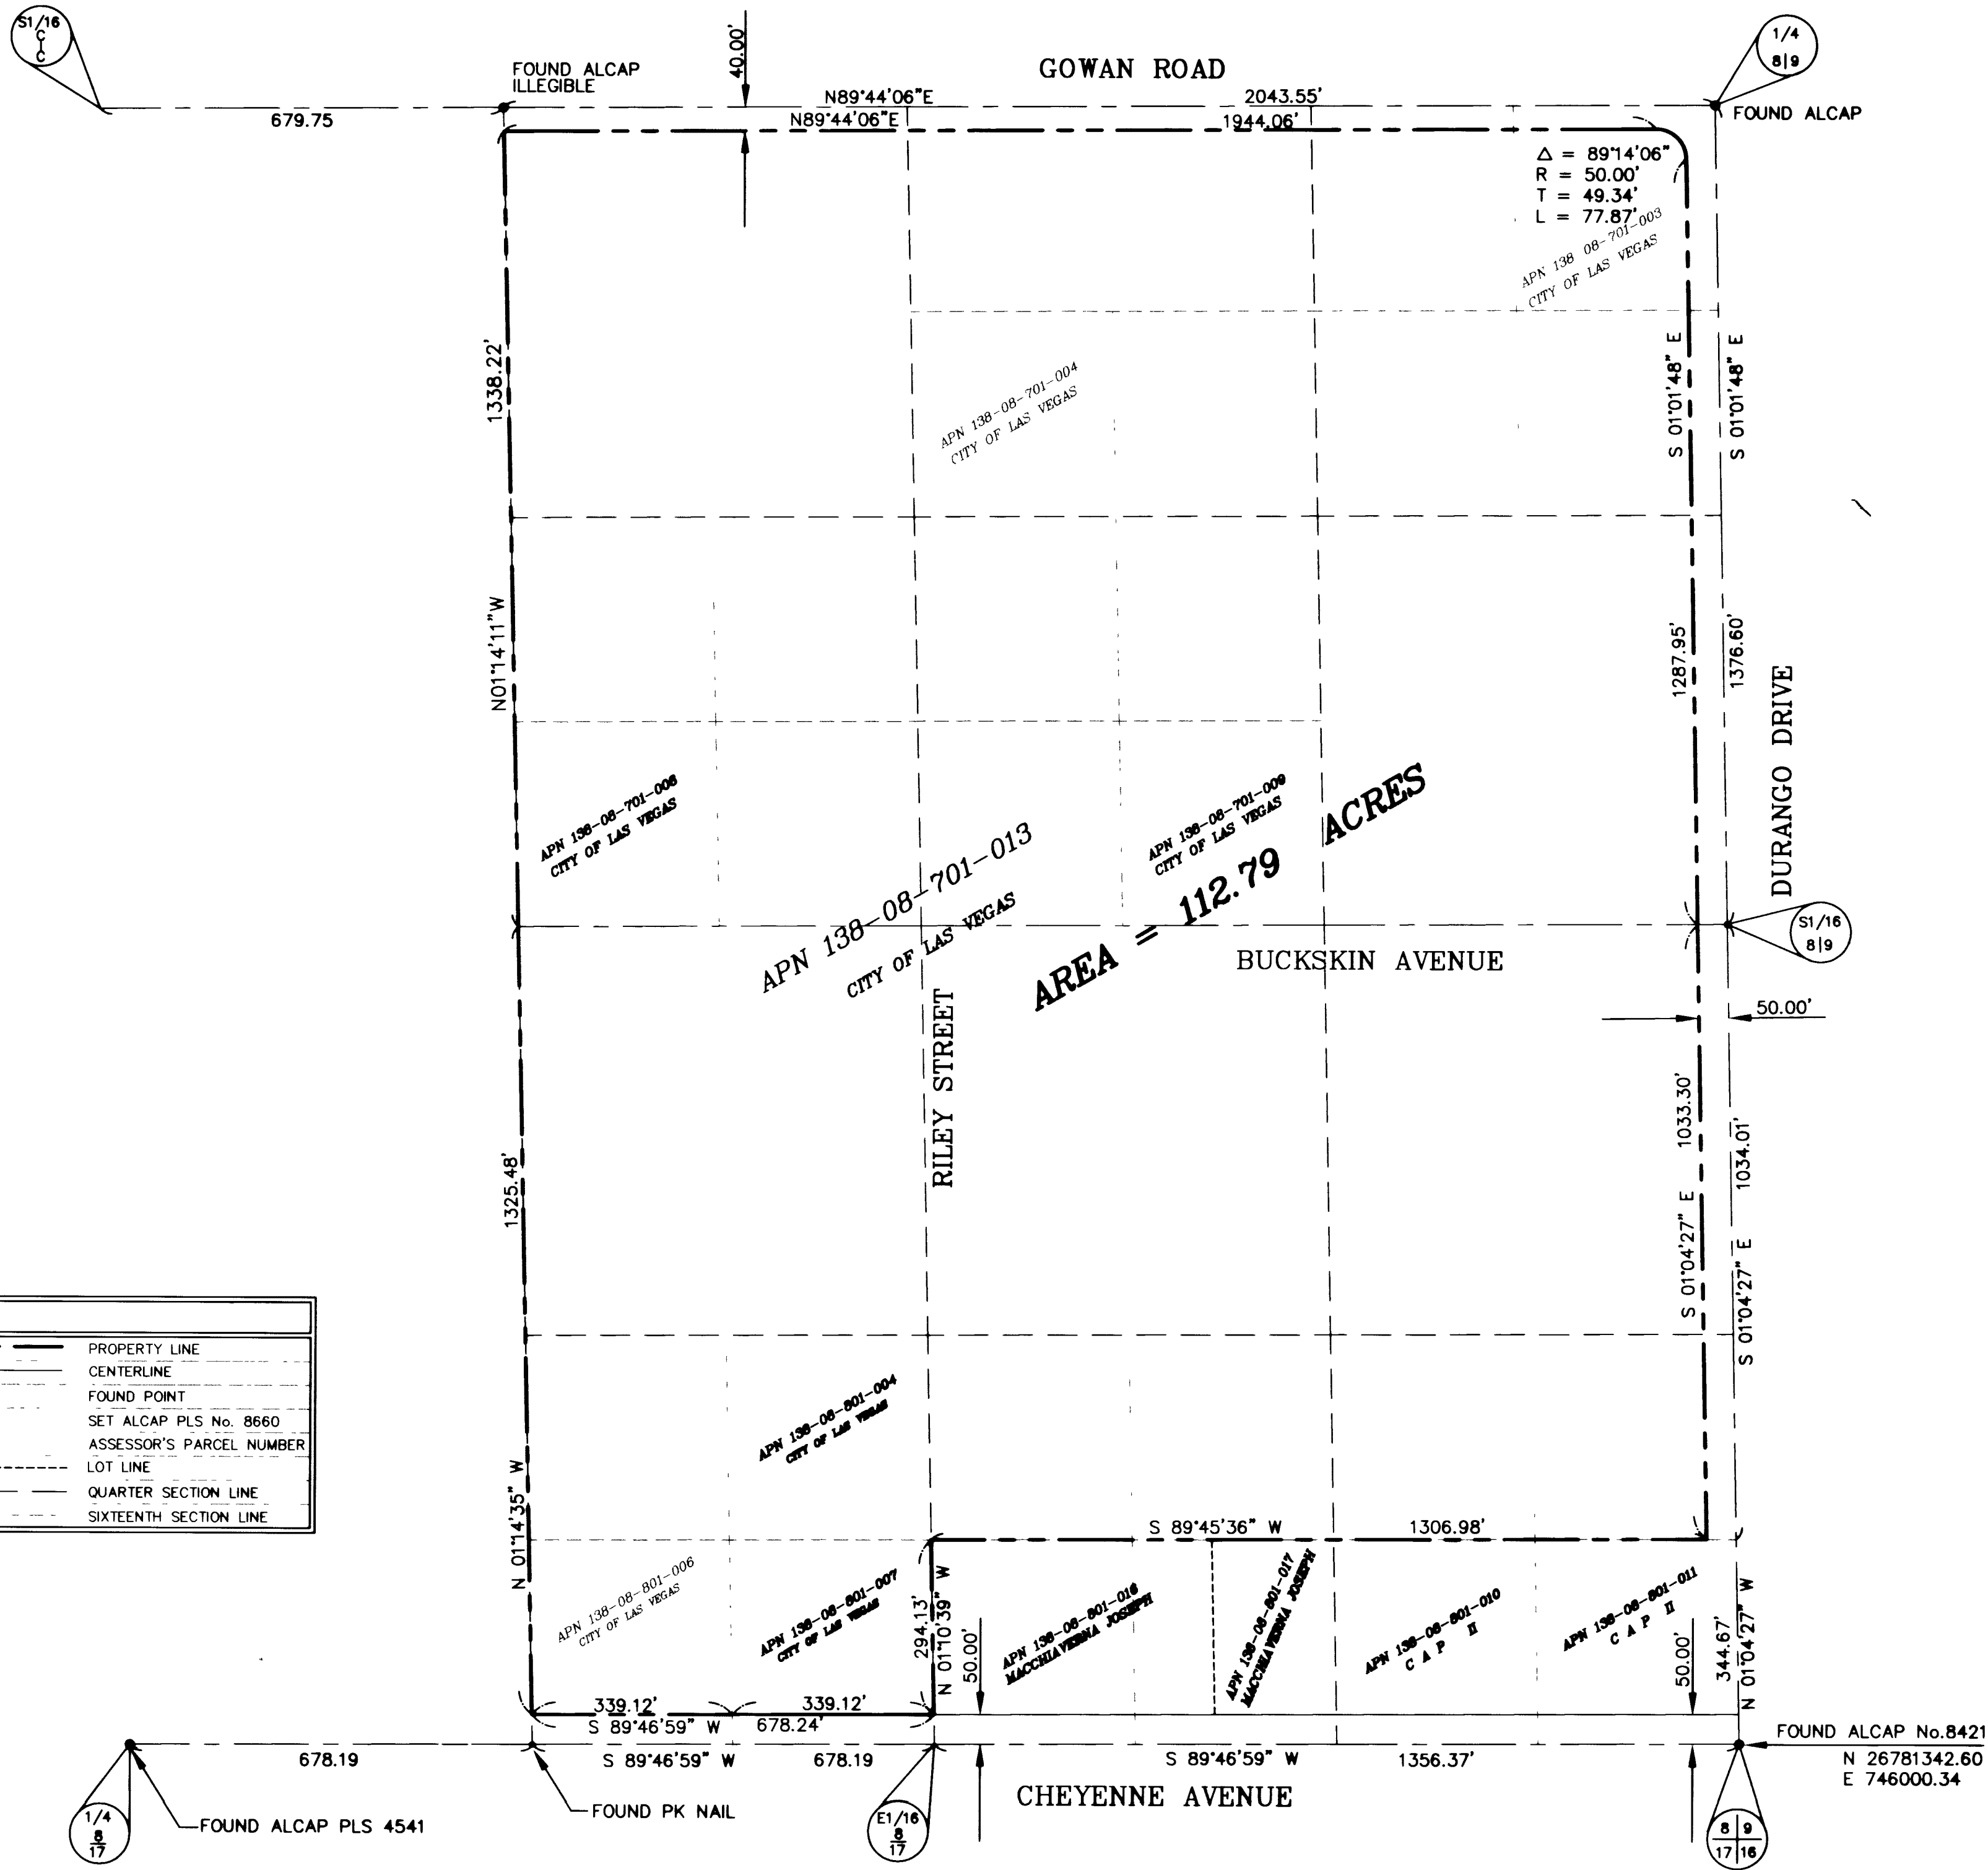


LEGEND:	
---	PROPERTY LINE
---	CENTERLINE
●	FOUND POINT
○	SET ALCAP PLS No. 8660
APN	ASSESSOR'S PARCEL NUMBER
---	LOT LINE
---	QUARTER SECTION LINE
---	SIXTEENTH SECTION LINE

SURVEY ANALYSIS

ALEXANDER ROAD

8

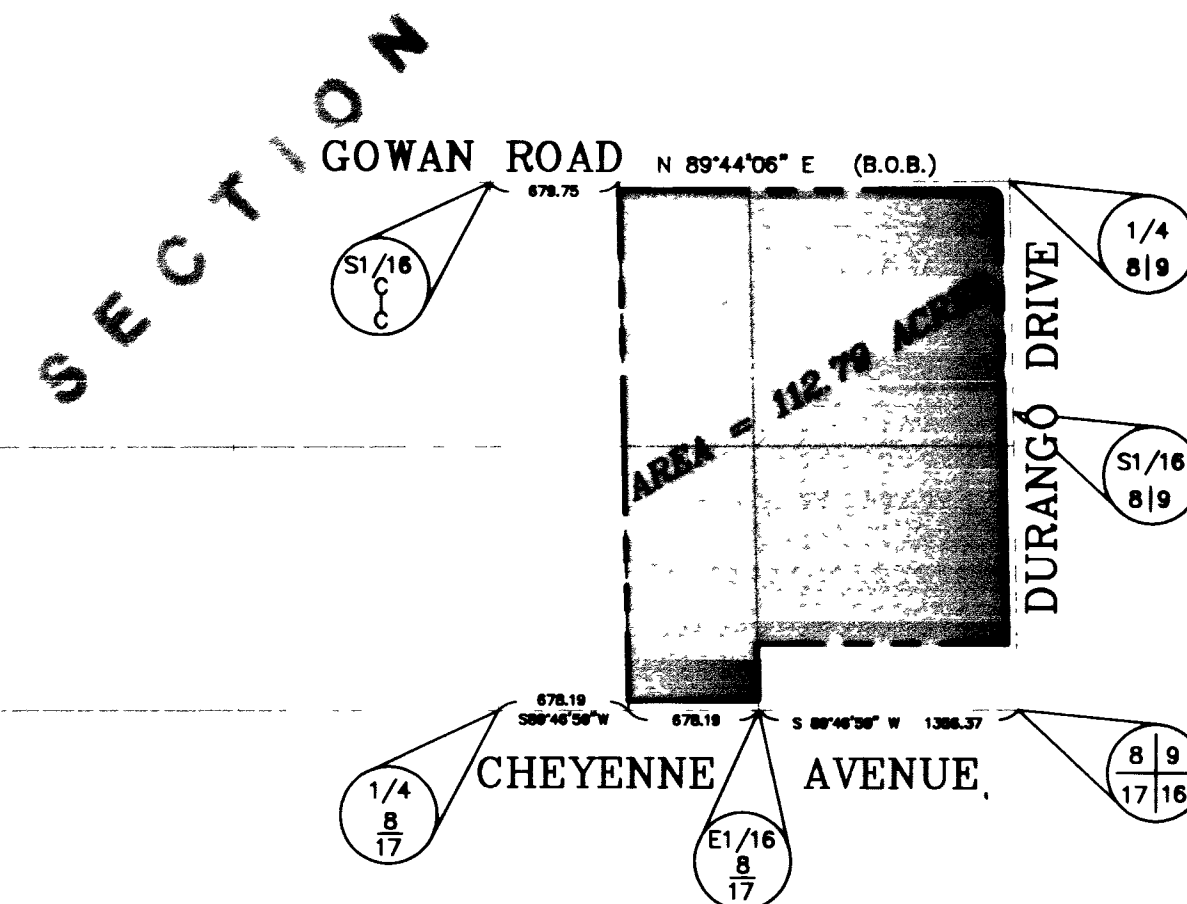

BASIS OF BEARINGS.

BEING THE NORTH LINE OF THE SOUTHEAST QUARTER (SE 1/4) OF SECTION 8, TOWNSHIP 20 SOUTH, RANGE 60 EAST, M.D.M. CLARK COUNTY, NEVADA. TAKEN AS NORTH 89°44'06" EAST, SADDLEBACK EAST - UNIT 4 MAP, BOOK 62, PAGE 92, RECORDED JULY 14, 1994, CLARK COUNTY, OFFICIAL RECORDS.

SURVEYOR'S CERTIFICATE.

I, PAUL B. CHANDLER, A PROFESSIONAL LAND SURVEYOR REGISTERED IN THE STATE OF NEVADA AND ACTING AS AGENT FOR POGGEMEYER DESIGN GROUP CERTIFY TO GREELEY AND HANSEN, THAT:

- 1) THIS IS A TRUE AND ACCURATE REPRESENTATION OF THE LANDS SURVEYED UNDER MY SUPERVISION AT THE INSTANCE OF GREELEY AND HANSEN.
- 2) THE LANDS SURVEYED LIE WITHIN SECTIONS 8, TOWNSHIP 20 SOUTH, RANGE 60 EAST, AND THE SURVEY WAS COMPLETED ON SEPTEMBER 15, 1995.
- 3) THERE ARE NO ENCROACHMENTS EXCEPT AS SHOWN ON THIS MAP.
- 4) THE MONUMENTS ARE OF THE CHARACTER SHOWN AND OCCUPY THE POSITIONS INDICATED.


RECORD DRAWINGS NOT FOR CONSTRUCTION

1. TO ALTER THESE DOCUMENTS FOR ANOTHER PROJECT BY ANYONE OTHER THAN THE ORIGINAL ARCHITECT IS A VIOLATION OF NRS 823.
2. THIS RECORD DRAWING HAS BEEN PREPARED IN PART, BASED UPON INFORMATION FURNISHED BY THE GENERAL CONTRACTOR, WHILE THIS INFORMATION IS BELIEVED TO BE RELIABLE, THE DESIGN PROFESSIONAL CANNOT ASSURE ITS ACCURACY, AND THUS IS NOT RESPONSIBLE FOR THE ACCURACY OF THIS RECORD DRAWING OR FOR ANY ERRORS OR OMISSIONS WHICH MAY HAVE BEEN INCORPORATED INTO IT AS A RESULT. THE DESIGN PROFESSIONAL CANNOT AND DOES NOT WARRANT THEIR ACCURACY.
3. INFORMATION THAT MAY BE INCLUDED WOULD BE SIGNIFICANT CHANGES TO ROOM ARRANGEMENTS ON THE FLOOR PLANS AND ASSOCIATED DRAWINGS, MINOR DIMENSION OR CONSTRUCTION DETAIL CHANGES MAY NOT BE INCLUDED.

CONTRACTOR _____ DATE _____

POGEMEYER DESIGN GROUP
ENGINEERS PLANNERS SURVEYORS
LANDSCAPE ARCHITECTS
2601 NORTH TENAYA WAY
LAS VEGAS, NEVADA 89128 (702) 255-8100

PAUL B. CHANDLER
PROFESSIONAL LAND SURVEYOR
STATE OF NEVADA
REGISTRATION NO. 8660

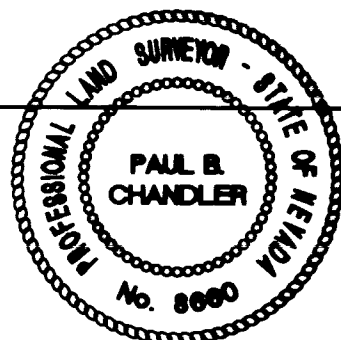


GREELEY AND HANSEN
ENGINEERS
4625 SOUTH POLARIS AVENUE, SUITE 210
LAS VEGAS, NEVADA 89103 (702) 736-7062
3.2.2.75

DESIGNED PBC
DRAWN PBC
CHECKED PBC

APPROVED

NO.	DATE	APPD	REVISION

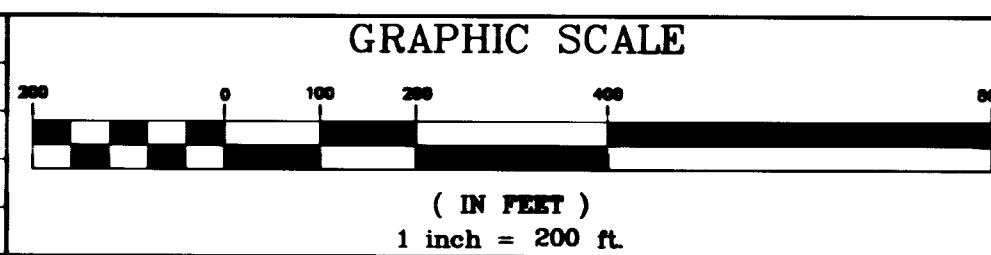

CITY OF LAS VEGAS, NEVADA
DEPARTMENT OF PUBLIC WORKS
NORTHWEST WATER RESOURCE CENTER
100% DESIGN

SURVEY
MONUMENTATION PLAN

PROJ. NO. 7190
DWG PDG 1
SHEET 91 OF 106
DATE 07.22.98 REV -