



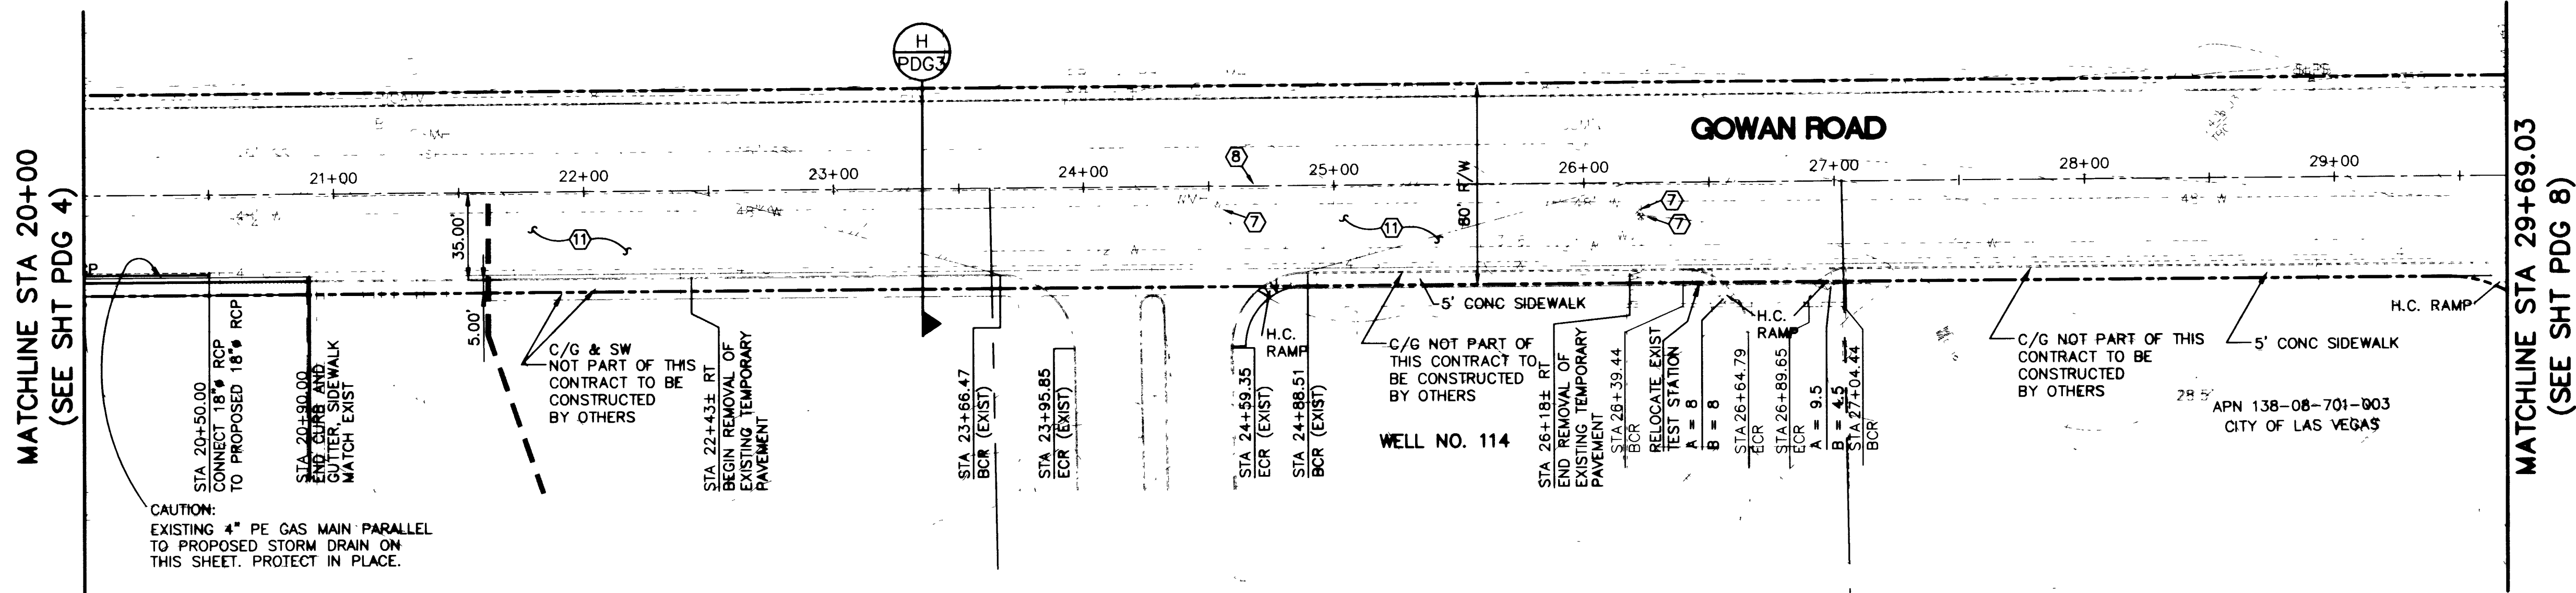


PLAN - GOWAN ROAD

SCALE: HORZ 1" = 40'

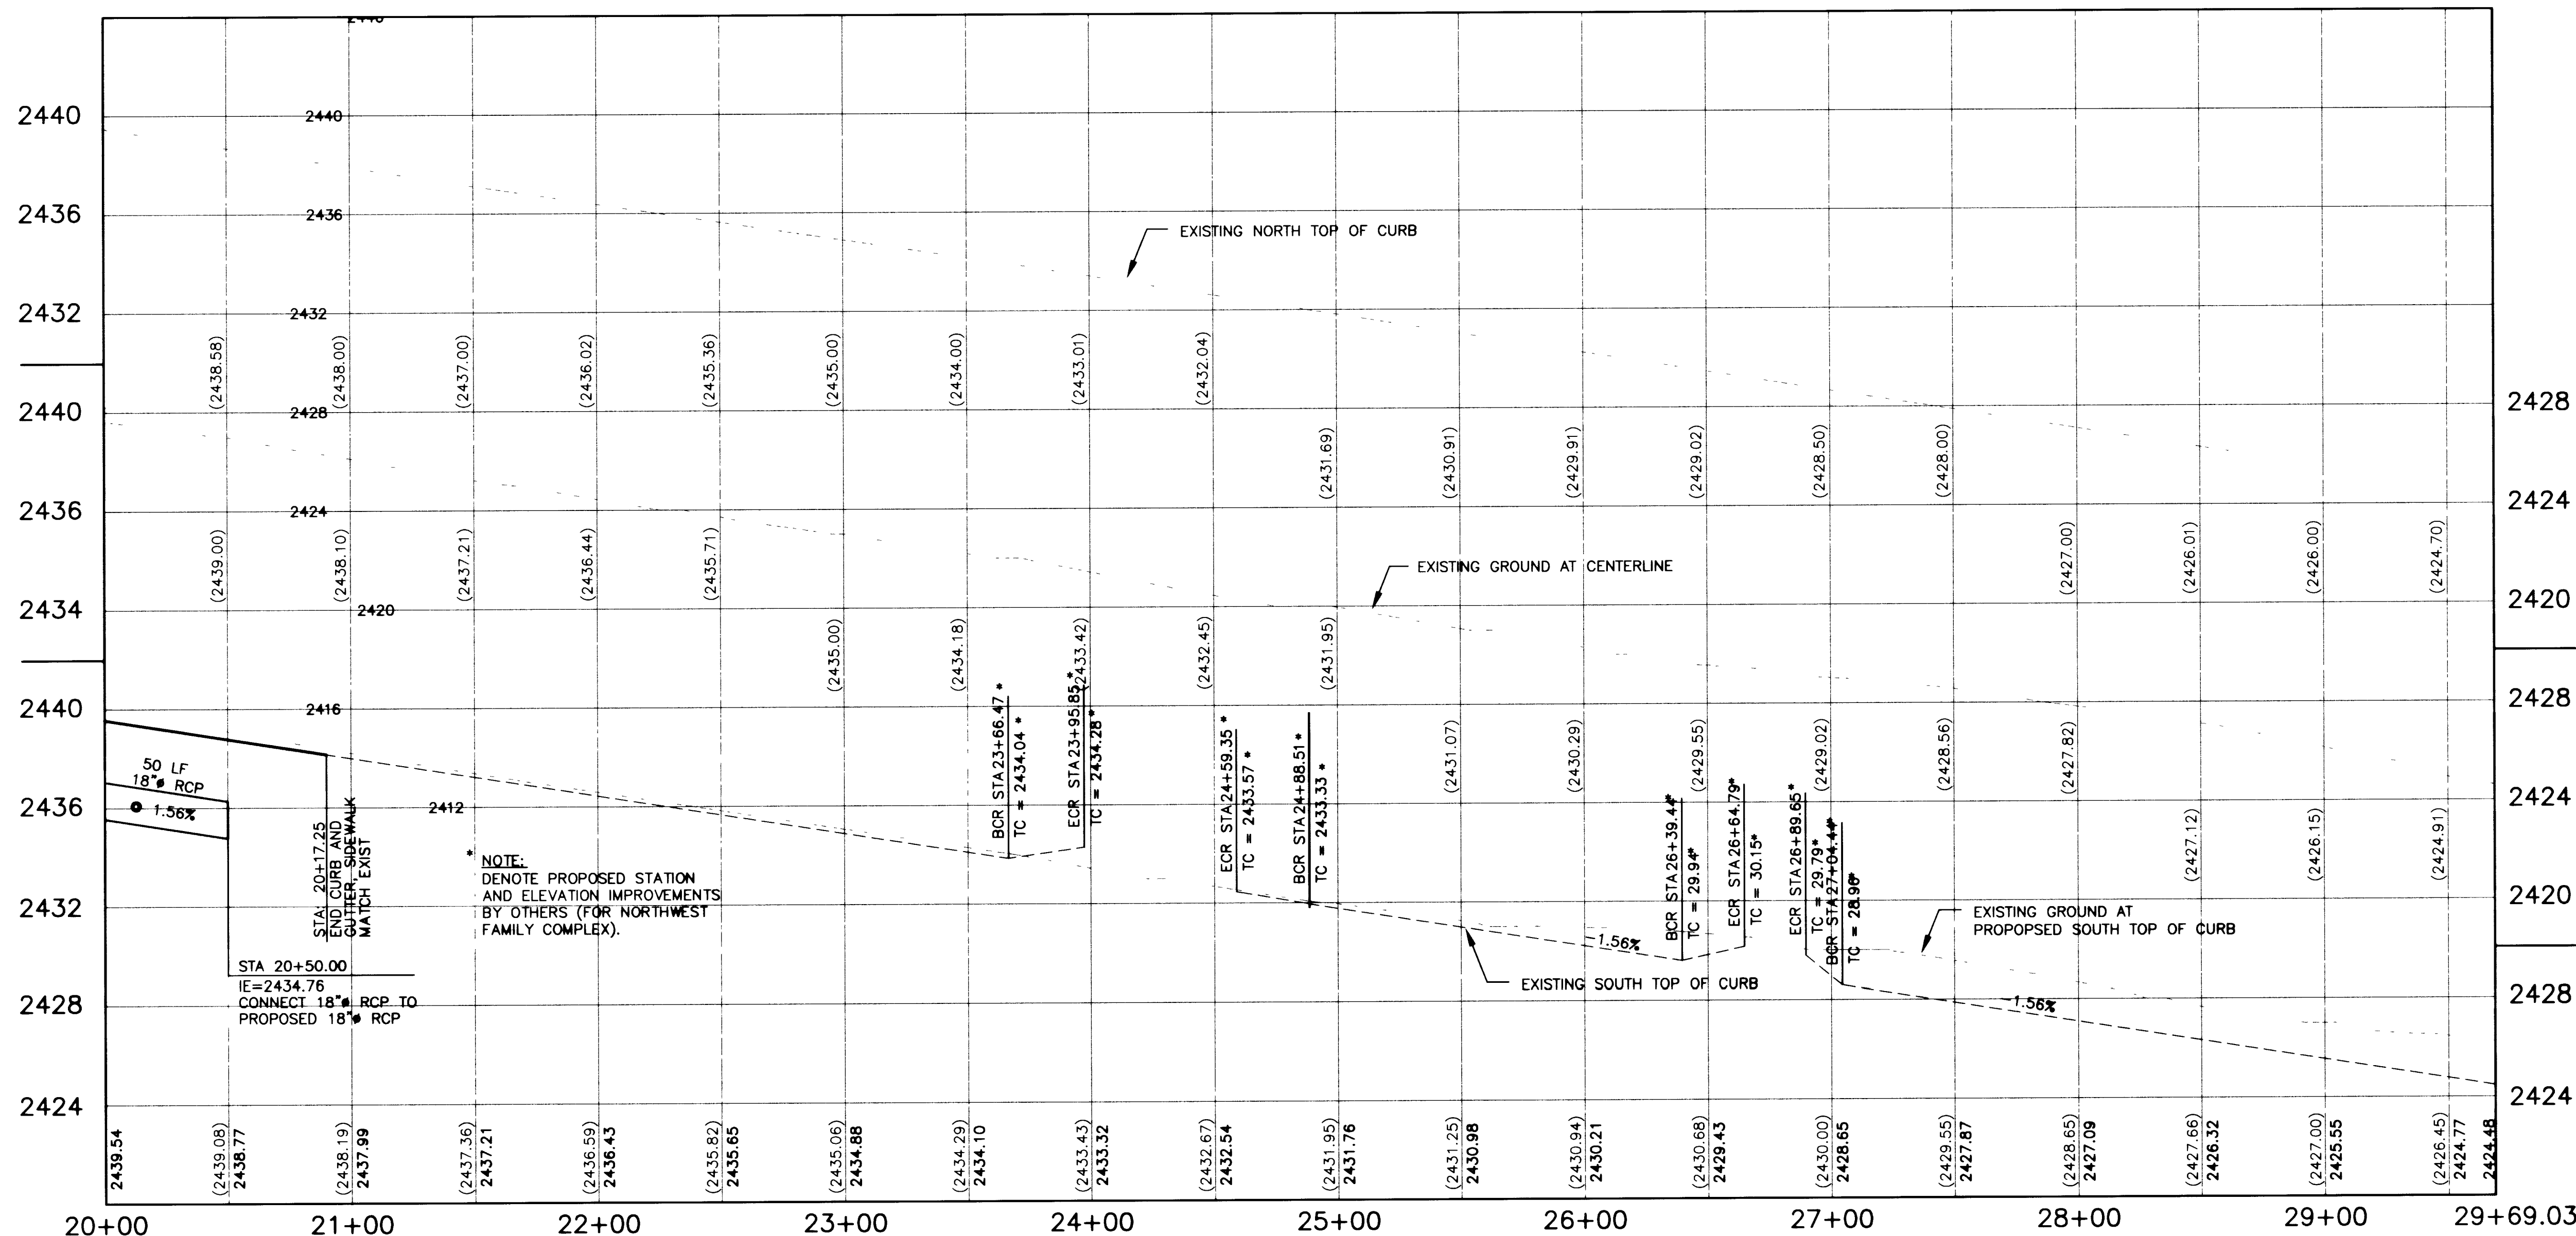

PROFILE - GOWAN ROAD

SCALE: HORZ 1" = 40'
VERT 1" = 4'

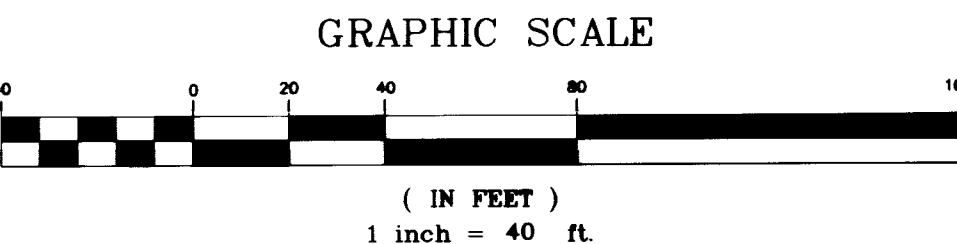

CONSTRUCTION KEYNOTES

- ① CONSTRUCT 5" ASPHALTIC CONCRETE OVER 8" OF TYPE II AGGREGATE BASE IN ACCORDANCE WITH DETAIL NO. (A) PDG 3
- ② RELOCATE EXISTING F.H. AS SHOWN HEREON.
- ③ CONSTRUCT COMMERCIAL DRIVEWAY ENTRANCE PER CLARK COUNTY AREA STD DWG NO. 225
- ④ CONSTRUCT HANDICAP RAMP PER CLARK COUNTY AREA STD DWG NO. 235 CASE I.
- ⑤ CONSTRUCT SIDEWALK IN ACCORDANCE WITH USD NO. 234.
- ⑥ CONSTRUCT "L" TYPE CURB AND GUTTER IN ACCORDANCE WITH USD NO. 216.
- ⑦ ADJUST TO GRADE IN ACCORDANCE WITH USD NO. 408 (MANHOLES) NO. 517 (VALVE BOX) NO. 506 (METER BOX).
- ⑧ SAWCUT EXISTING PAVEMENT AND MATCH EXISTING, AS SHOWN HEREON.
- ⑨ CONSTRUCT "A" TYPE CURB IN ACCORDANCE WITH USD NO. 219.
- ⑩ CONSTRUCT 8" CROSS GUTTER PER CLARK COUNTY AREA STD AREA DWG NO. 228.
- ⑪ CONSTRUCT 4" ASPHALTIC CONCRETE OVER 8" OF TYPE II AGGREGATE BASE IN ACCORDANCE WITH DETAIL NO. (B) PDG 3

RECORD DRAWINGS
NOT FOR CONSTRUCTION

1. TO ALTER THESE DOCUMENTS FOR ANOTHER PROJECT BY ANYONE OTHER THAN THE ORIGINAL ARCHITECT IS A VIOLATION OF NRS 623.
2. THIS RECORD DRAWING HAS BEEN PREPARED IN PART, BASED UPON INFORMATION FURNISHED BY THE GENERAL CONTRACTOR, WHILE THIS INFORMATION IS BELIEVED TO BE RELIABLE, THE DESIGN PROFESSIONAL CANNOT ASSURE ITS ACCURACY, AND THIS IS NOT RESPONSIBLE FOR THE ACCURACY OF THIS RECORD DRAWING OR FOR ANY ERRORS OR OMISSIONS WHICH MAY HAVE BEEN INCORPORATED INTO IT AS A RESULT. THE DESIGN PROFESSIONAL CANNOT AND DOES NOT WARRANT THEIR ACCURACY.
3. INFORMATION THAT MAY BE INCLUDED WOULD BE SIGNIFICANT CHANGES TO ROOM ARRANGEMENTS ON THE FLOOR PLANS AND ASSOCIATED DRAWINGS, MINOR DIMENSION OR CONSTRUCTION DETAIL CHANGES MAY NOT BE INCLUDED.

CONTRACTOR _____ DATE _____

Avoid cutting underground utility lines. It's costly.

Call
before you
Dig

1-800-227-2600

POGGEMEYER DESIGN GROUP
ENGINEERS PLANNERS SURVEYORS
LANDSCAPE ARCHITECTS
2601 NORTH TENAYA WAY
LAS VEGAS, NEVADA 89128 (702) 255-8100

GREELEY AND HANSEN
ENGINEERS
4625 SOUTH POLARIS AVENUE, SUITE 210
LAS VEGAS, NEVADA 89103 (702) 736-7062
32279

DESIGNED SW
DRAWN FT
CHECKED MBH

APPROVED

NO.	DATE	APPD	REVISION

CITY OF LAS VEGAS, NEVADA
DEPARTMENT OF PUBLIC WORKS
NORTHWEST WATER RESOURCE CENTER
100% DESIGN

ROADWAY IMPROVEMENTS
GOWAN ROAD - STA 20+00 TO END
PLAN AND PROFILE

PROJ. NO.	7190
DWG	PDG 5
SHEET	5 OF 13
DATE	07.21.98
REV	0