


# CITY OF LAS VEGAS

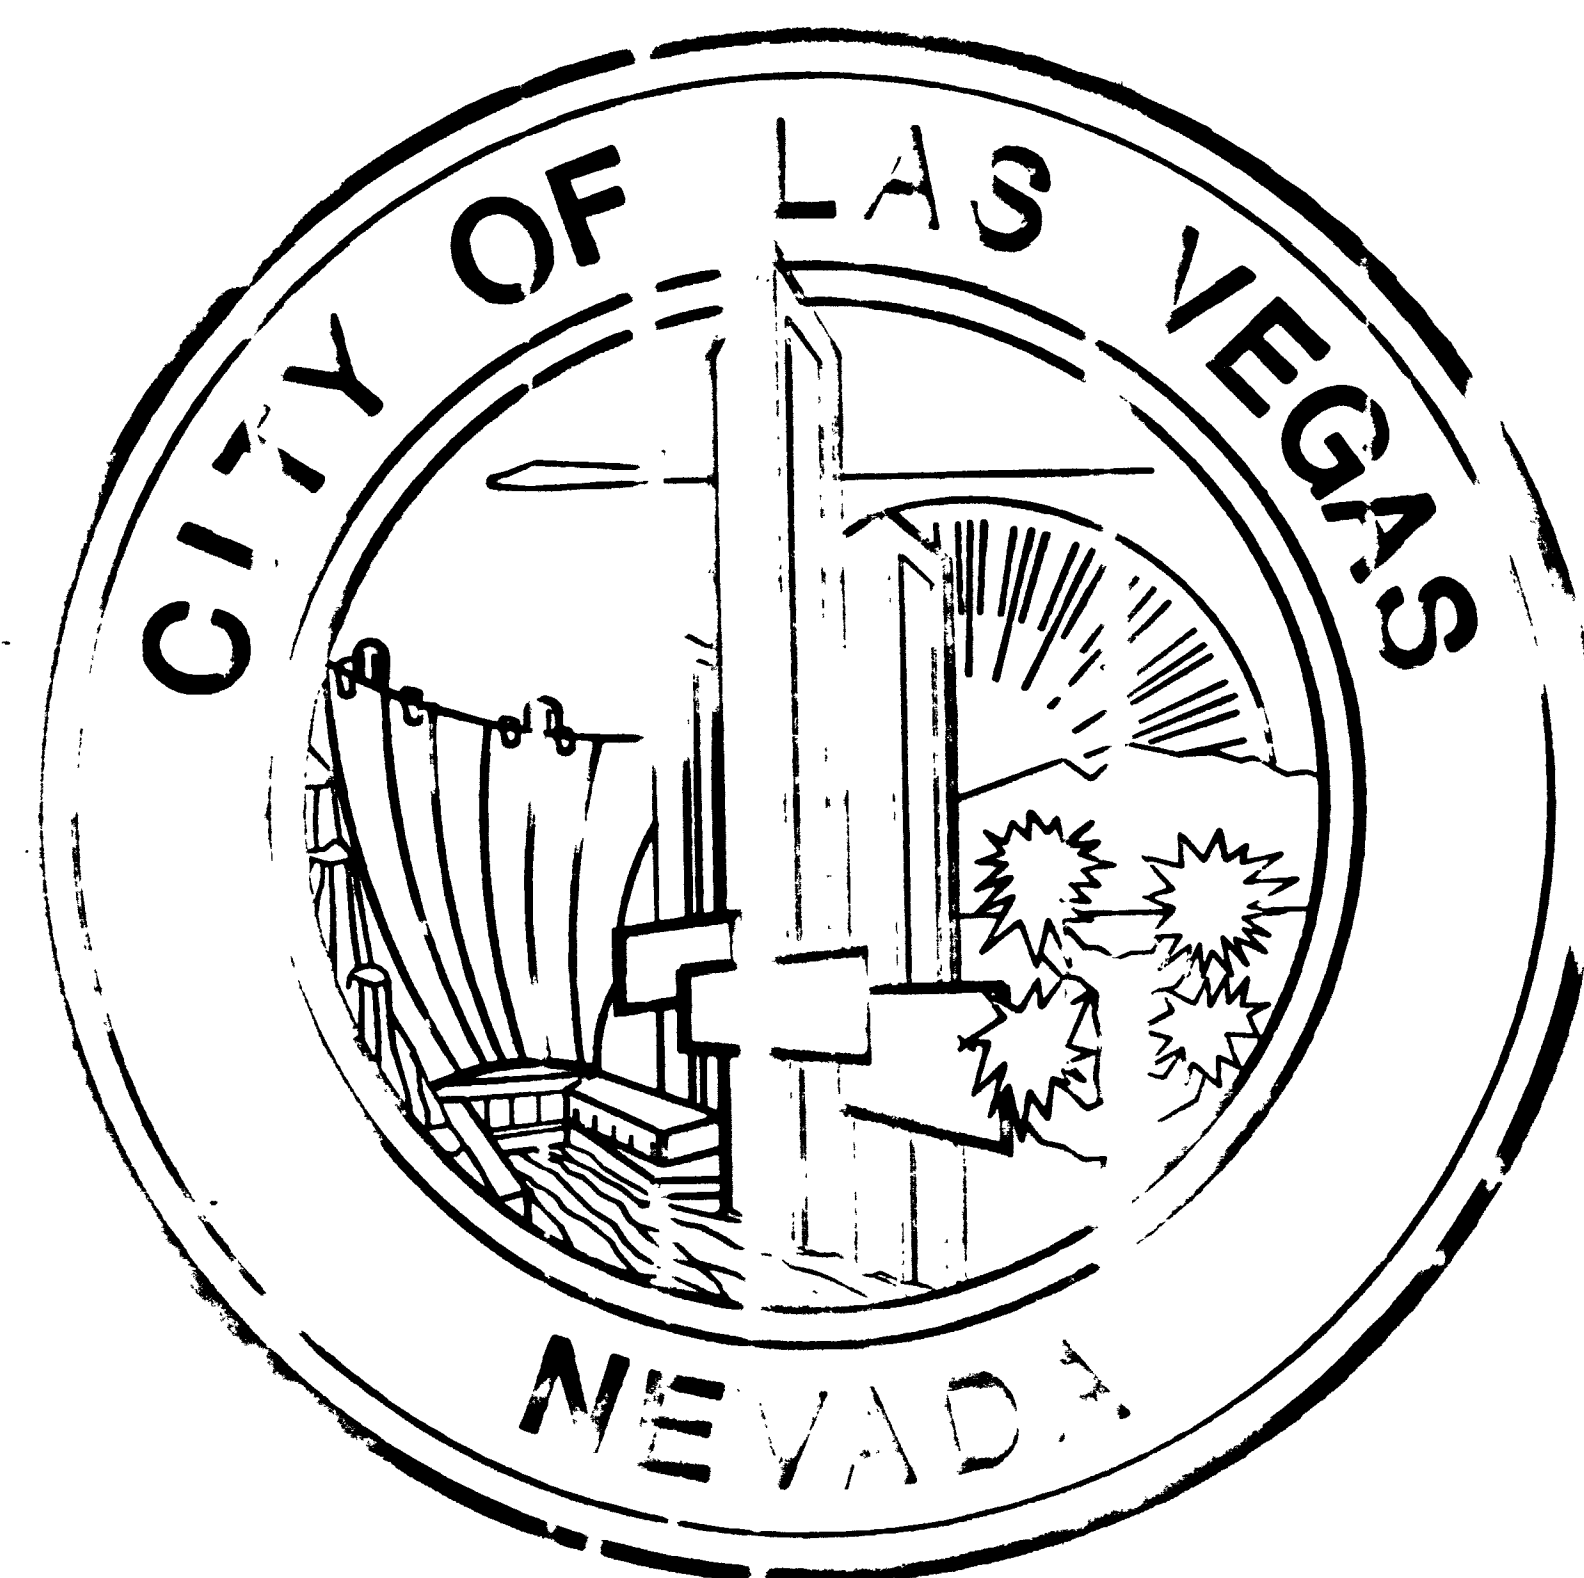

Mayor  
**JAN LAVERTY JONES**

**Committee:**  
**ARNE JENSEN**  
**MICHAEL J. DONALD**  
**GARY REESE**  
**LARRY BROWN**

City Manager:  
VIRGINIA VALENTINE, PE

**Director of Public Works:**  
**RICHARD D. BOECKE**

City Engineer:  
**DENNIS ANDERSON, P.E.**

# DEPARTMENT OF PUBLIC WORKS

# DURANGO DRIVE IMPROVEMENTS

# CHEYENNE AVE. TO LONE MTN. ROAD

31D NUMBER: 39.1730.06-RC

FUNDED BY:  
REGIONAL TRANSPORTATION COMMISSION  
REGIONAL FLOOD CONTROL DISTRICT  
CITY OF LAS VEGAS SANITATION FUNDS

PROJECT NAME: 2017 DUKAKIS DRIVE IMPROVEMENT

This project water plan complies with the Las Vegas Valley Water District's technical requirements. However, this water plan is NOT APPROVED FOR CONSTRUCTION at this time and this signature does not provide or imply a water commitment.

Bonnie Croft 7-25-90  
LNAME DATE

# REVIEWED

12-99  
City Engineer Date

D.C. White 3-31-99  
Traffic Engineer Date

Ray B. Johnson 7/29/98  
Regional Transportation Commission Date

Gale W. Fraser, Jr. 7/29/88  
Clark County Regional  
Flood Control District Date

Las Vegas Valley Water District Date 12/22/98

Kimberly Granath-Mansel 7-13-98  
Community Cable TV Date

7-13-98 Date  
Sprint Central Telephone

San Francisco 7/13/92  
Nevada Power Company Date

Joe Plant 7.13.9  
Southwest Gas Corporation Date

RECORD DRAWING 03/16/01

|                                                                                       |        |                            |          |               |                                                                                     |                                                                              |             |      |
|---------------------------------------------------------------------------------------|--------|----------------------------|----------|---------------|-------------------------------------------------------------------------------------|------------------------------------------------------------------------------|-------------|------|
|  | SHEET: | DEPARTMENT OF PUBLIC WORKS | PROJECT: | DURANGO DRIVE |  | SCALE (1)<br>DRAWN BY: L.M.W.<br>DATE JULY 1988<br>W.A. F.<br>DESIGN BY J.L. | REVISIONS   | DATE |
|                                                                                       |        |                            |          |               |                                                                                     |                                                                              | COVER SHEET |      |