
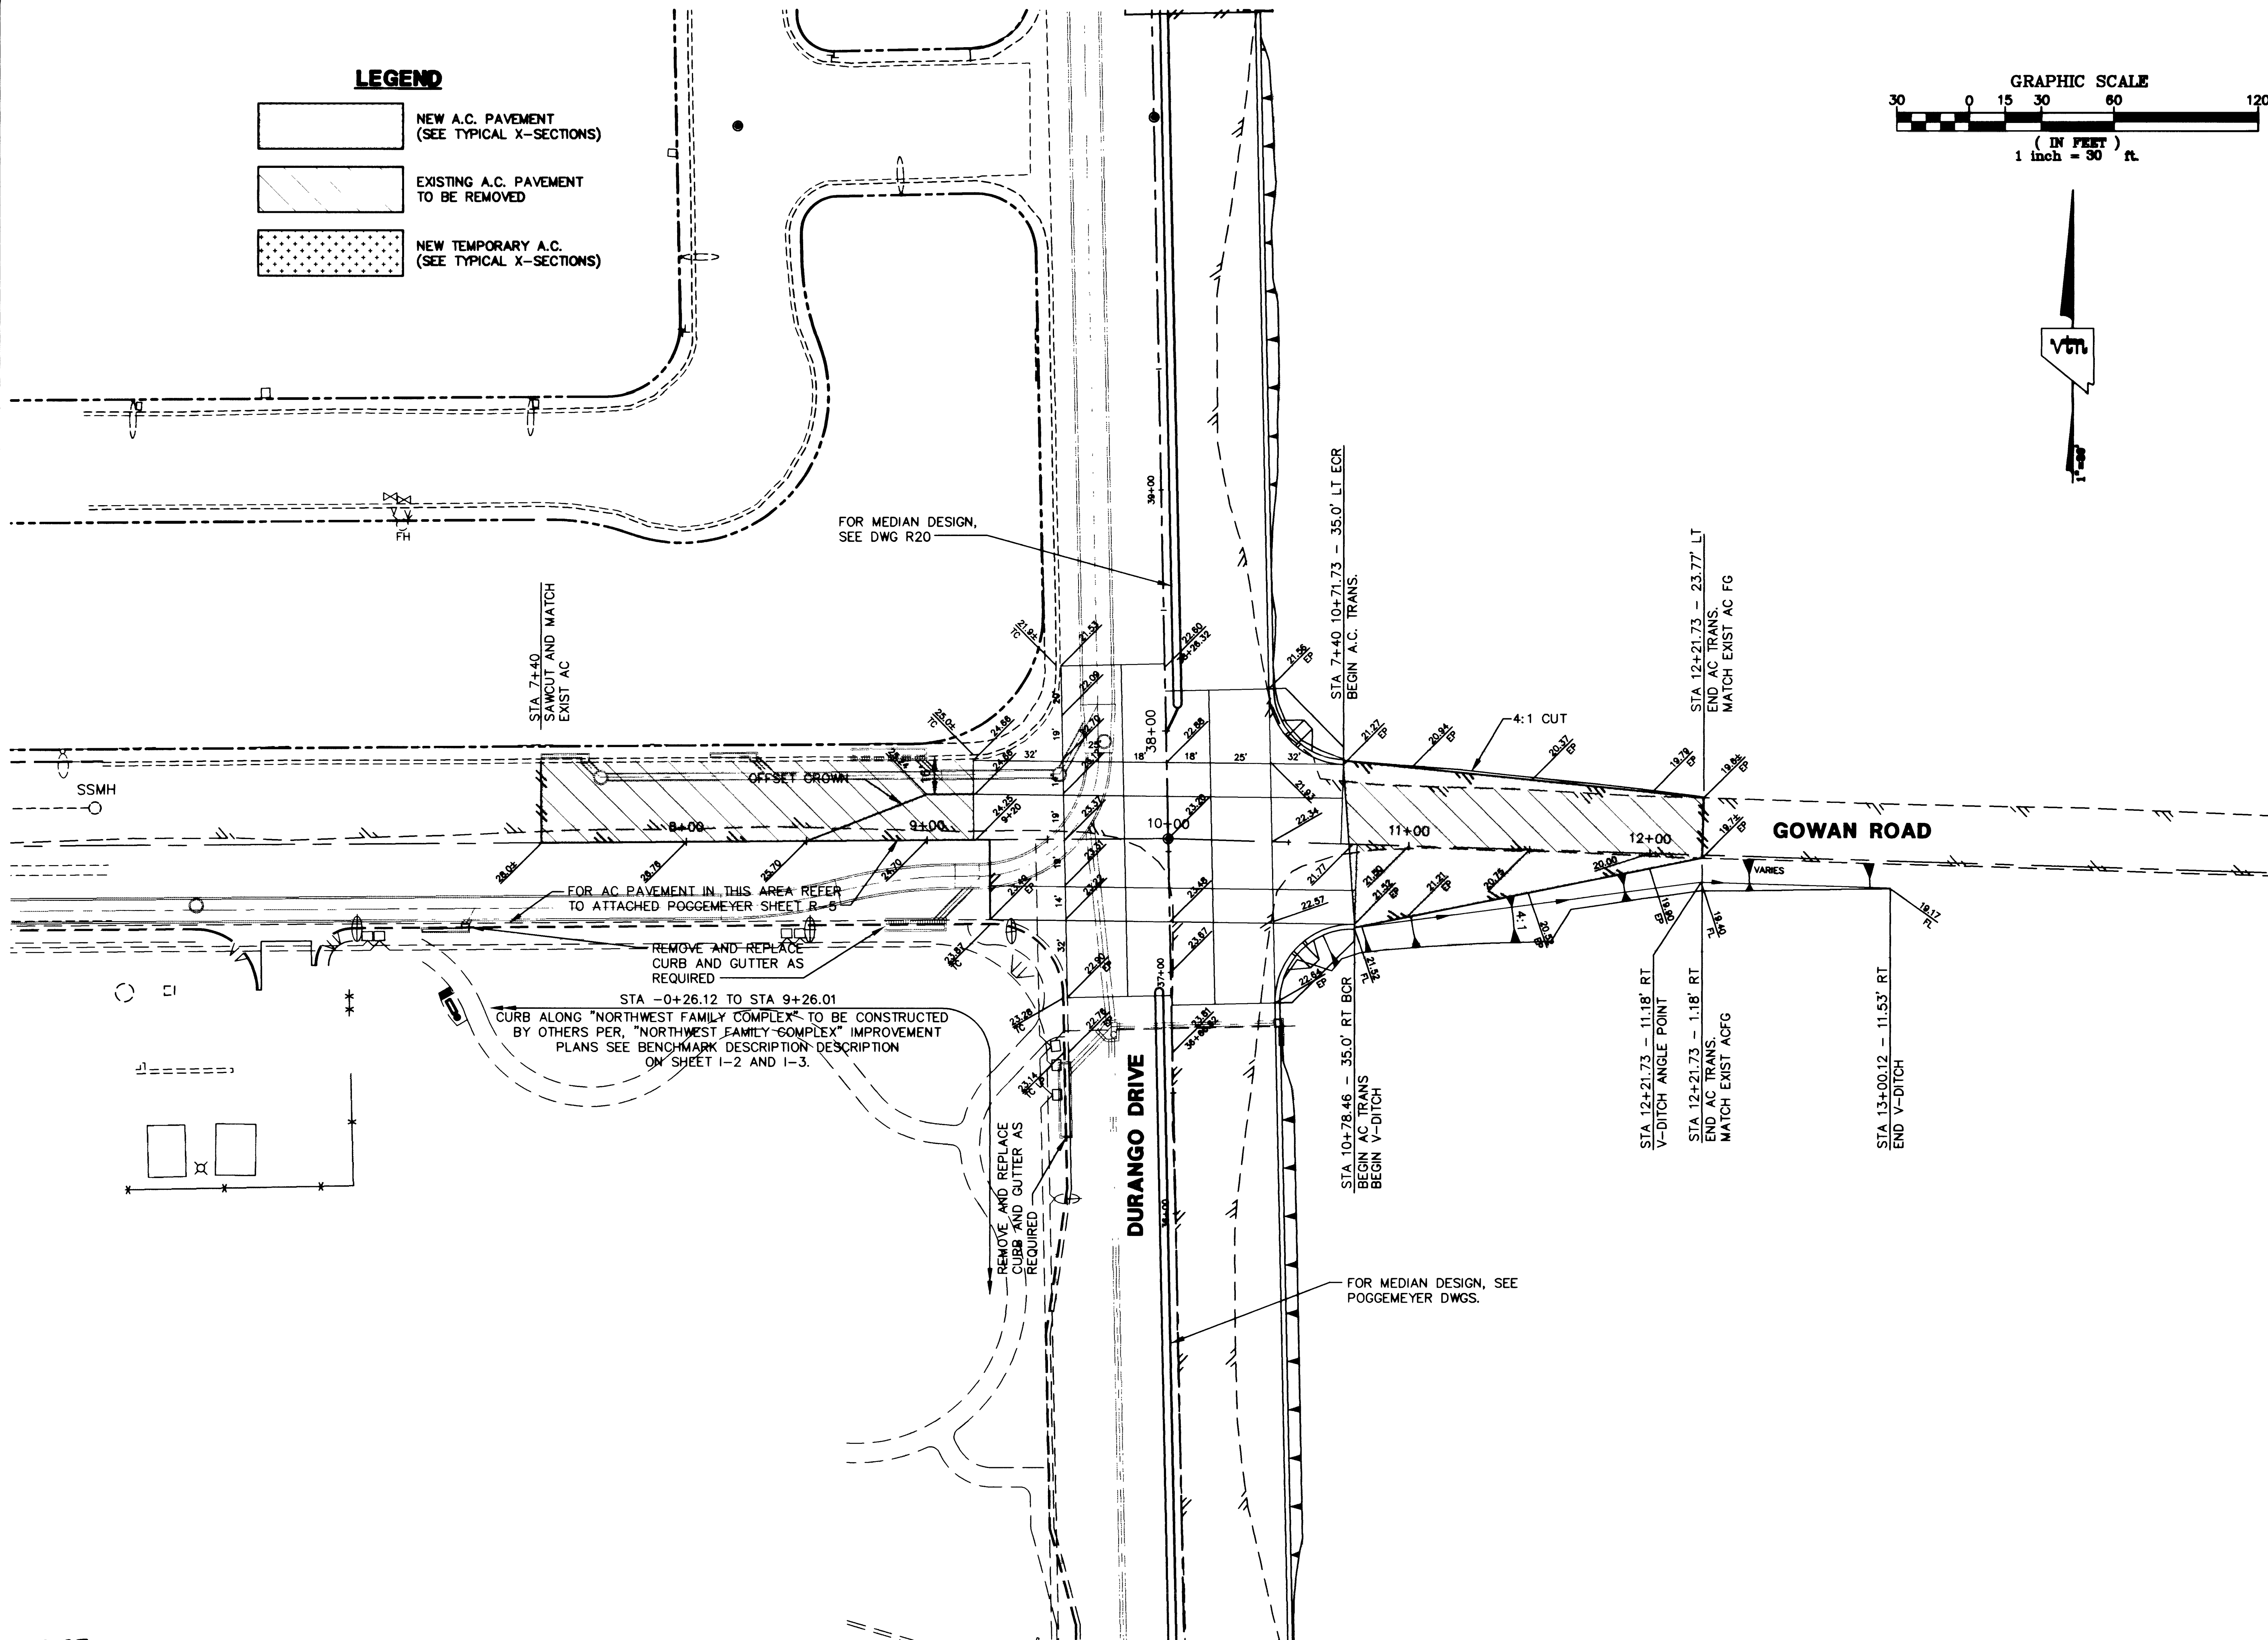


VIEWS: MS = "B", PS = "PLT"
I:\CAD\PROJECTS\5249\5249-INT.DWG

32227

LEGEND

- NEW A.C. PAVEMENT
(SEE TYPICAL X-SECTIONS)
- EXISTING A.C. PAVEMENT
TO BE REMOVED
- NEW TEMPORARY A.C.
(SEE TYPICAL X-SECTIONS)

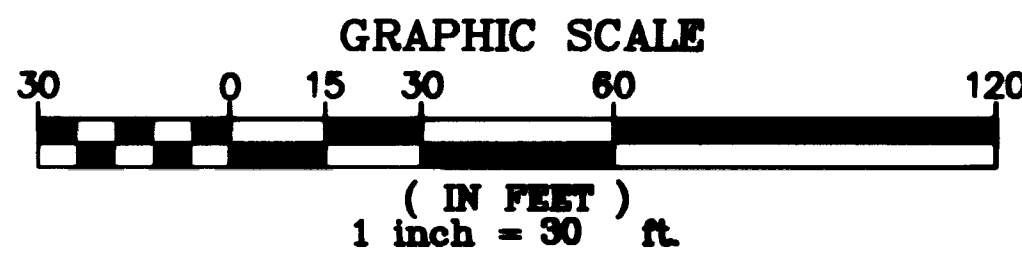

DEPARTMENT OF PUBLIC WORKS
CITY OF LAS VEGAS, NEVADA

vtn nevada

CONSULTING ENGINEERS • PLANNERS • LAND SURVEYORS
2727 SOUTH RAINBOW BOULEVARD
LAS VEGAS, NEVADA 89102-5148 PHONE (702) 873-7550 FAX (702) 362-2597

TITLE INTERSECTION GRADING PLAN
GOWAN ROAD / DURANGO DRIVE

PROJECT DURANGO DRIVE IMPROVEMENTS
CHEYENNE AVENUE TO LONE MOUNTAIN ROAD

WO. NO. 5249

BY JL/LMW

DATE 07/17/98

SCALE HORIZ. 1"=30'

VERT. NONE

DRAWING R13

SHEET 43 OF 106 SHEETS

RECORD DRAWING 03/23/01