



	NEW A.C. PAVEMENT (SEE TYPICAL X-SECTIONS)
	EXISTING A.C. PAVEMENT TO BE REMOVED
	NEW TEMPORARY A.C. (SEE TYPICAL X-SECTIONS)

GRAPHIC SCALE

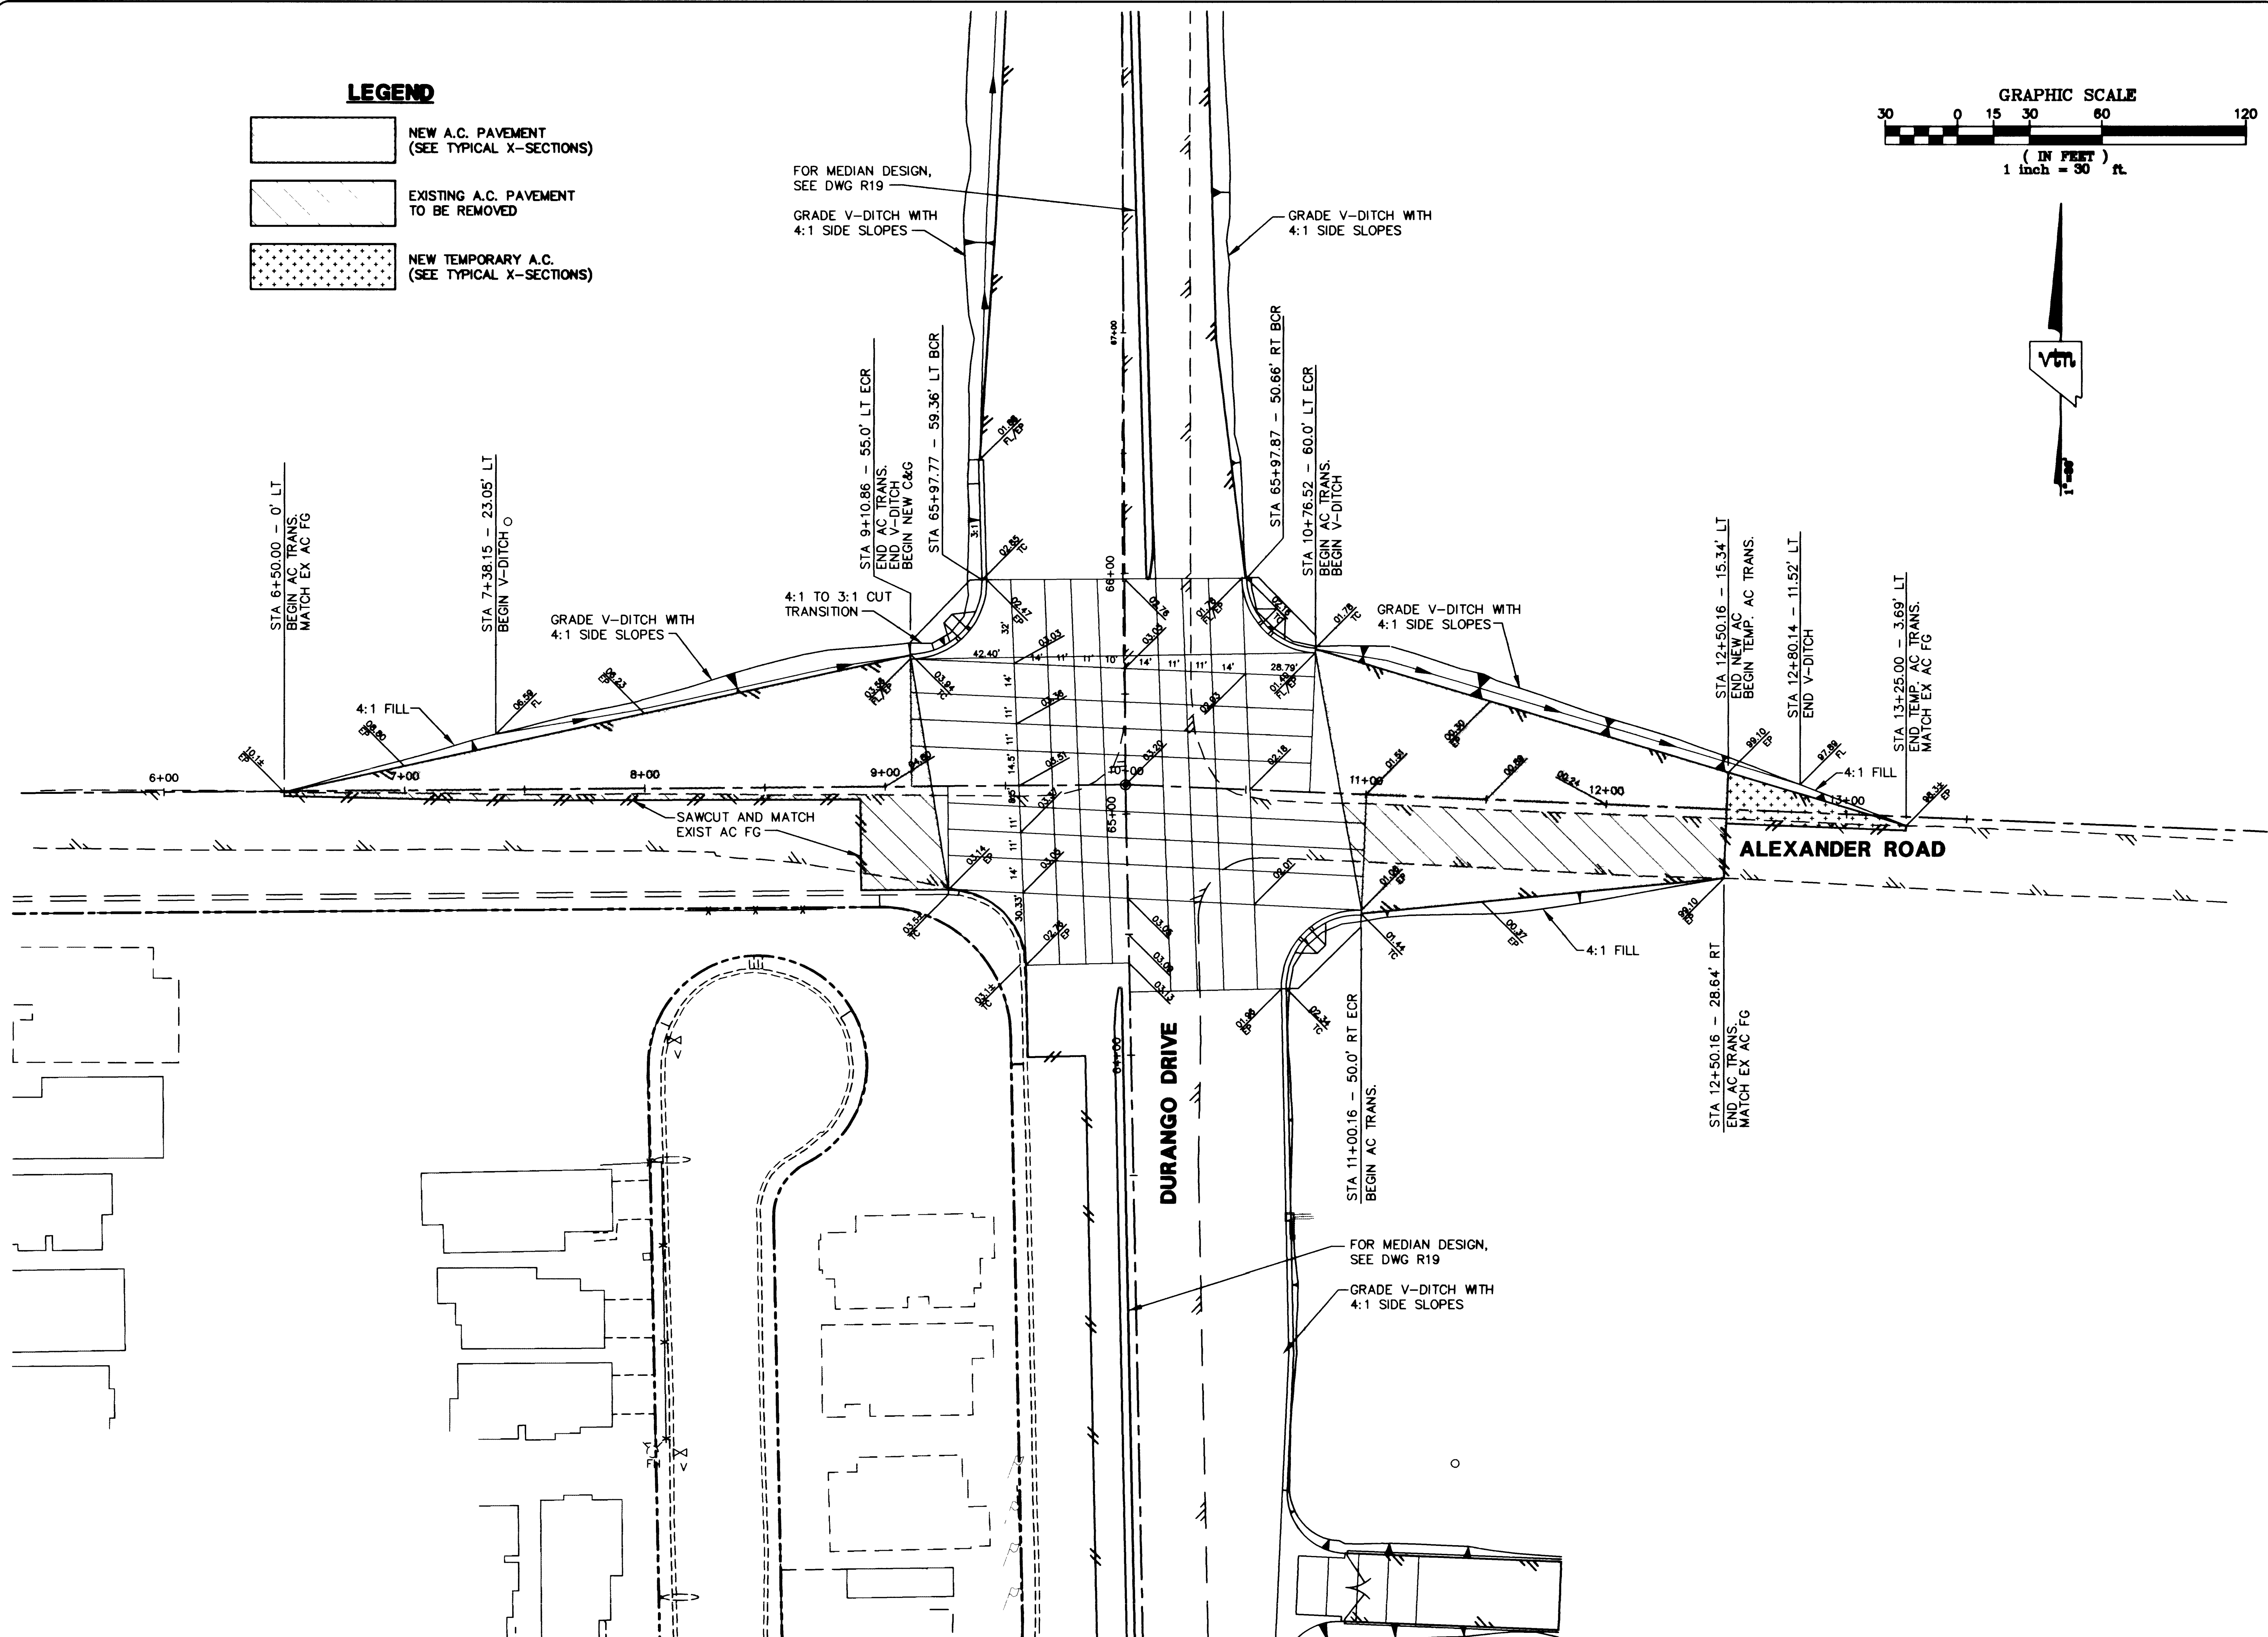

(IN FEET)
1 inch = 30 ft.

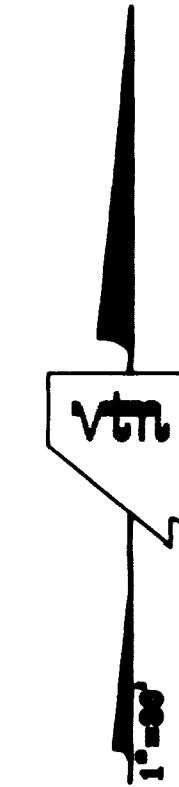

DEPARTMENT OF PUBLIC WORKS
CITY OF LAS VEGAS, NEVADA

VEN

2727 SOUTH RAINBOW BOULEVARD
LAS VEGAS, NEVADA 89102-5148 PHONE (702) 873-7550 FAX (702) 362-2587

INTERSECTION GRADING PLAN
ALEXANDER ROAD / DURANGO DR

**DURANGO DRIVE IMPROVEMENTS
CHEYENNE AVENUE TO LONE MOUNTAIN ROAD**

D. NO. 5249	
Y JL/LMW	
DATE 07/17/98	
SCALE	HORIZ. 1"=30' VERT. NONE
DRAWING R14	SHEET 44 OF 106 SHEETS

RECORD DRAWING 03/23/01

VIEWS: MS = "C", PS = "PLT"
 I: \CAD\PubWrk\5249\5249-INT.DWG

32228