
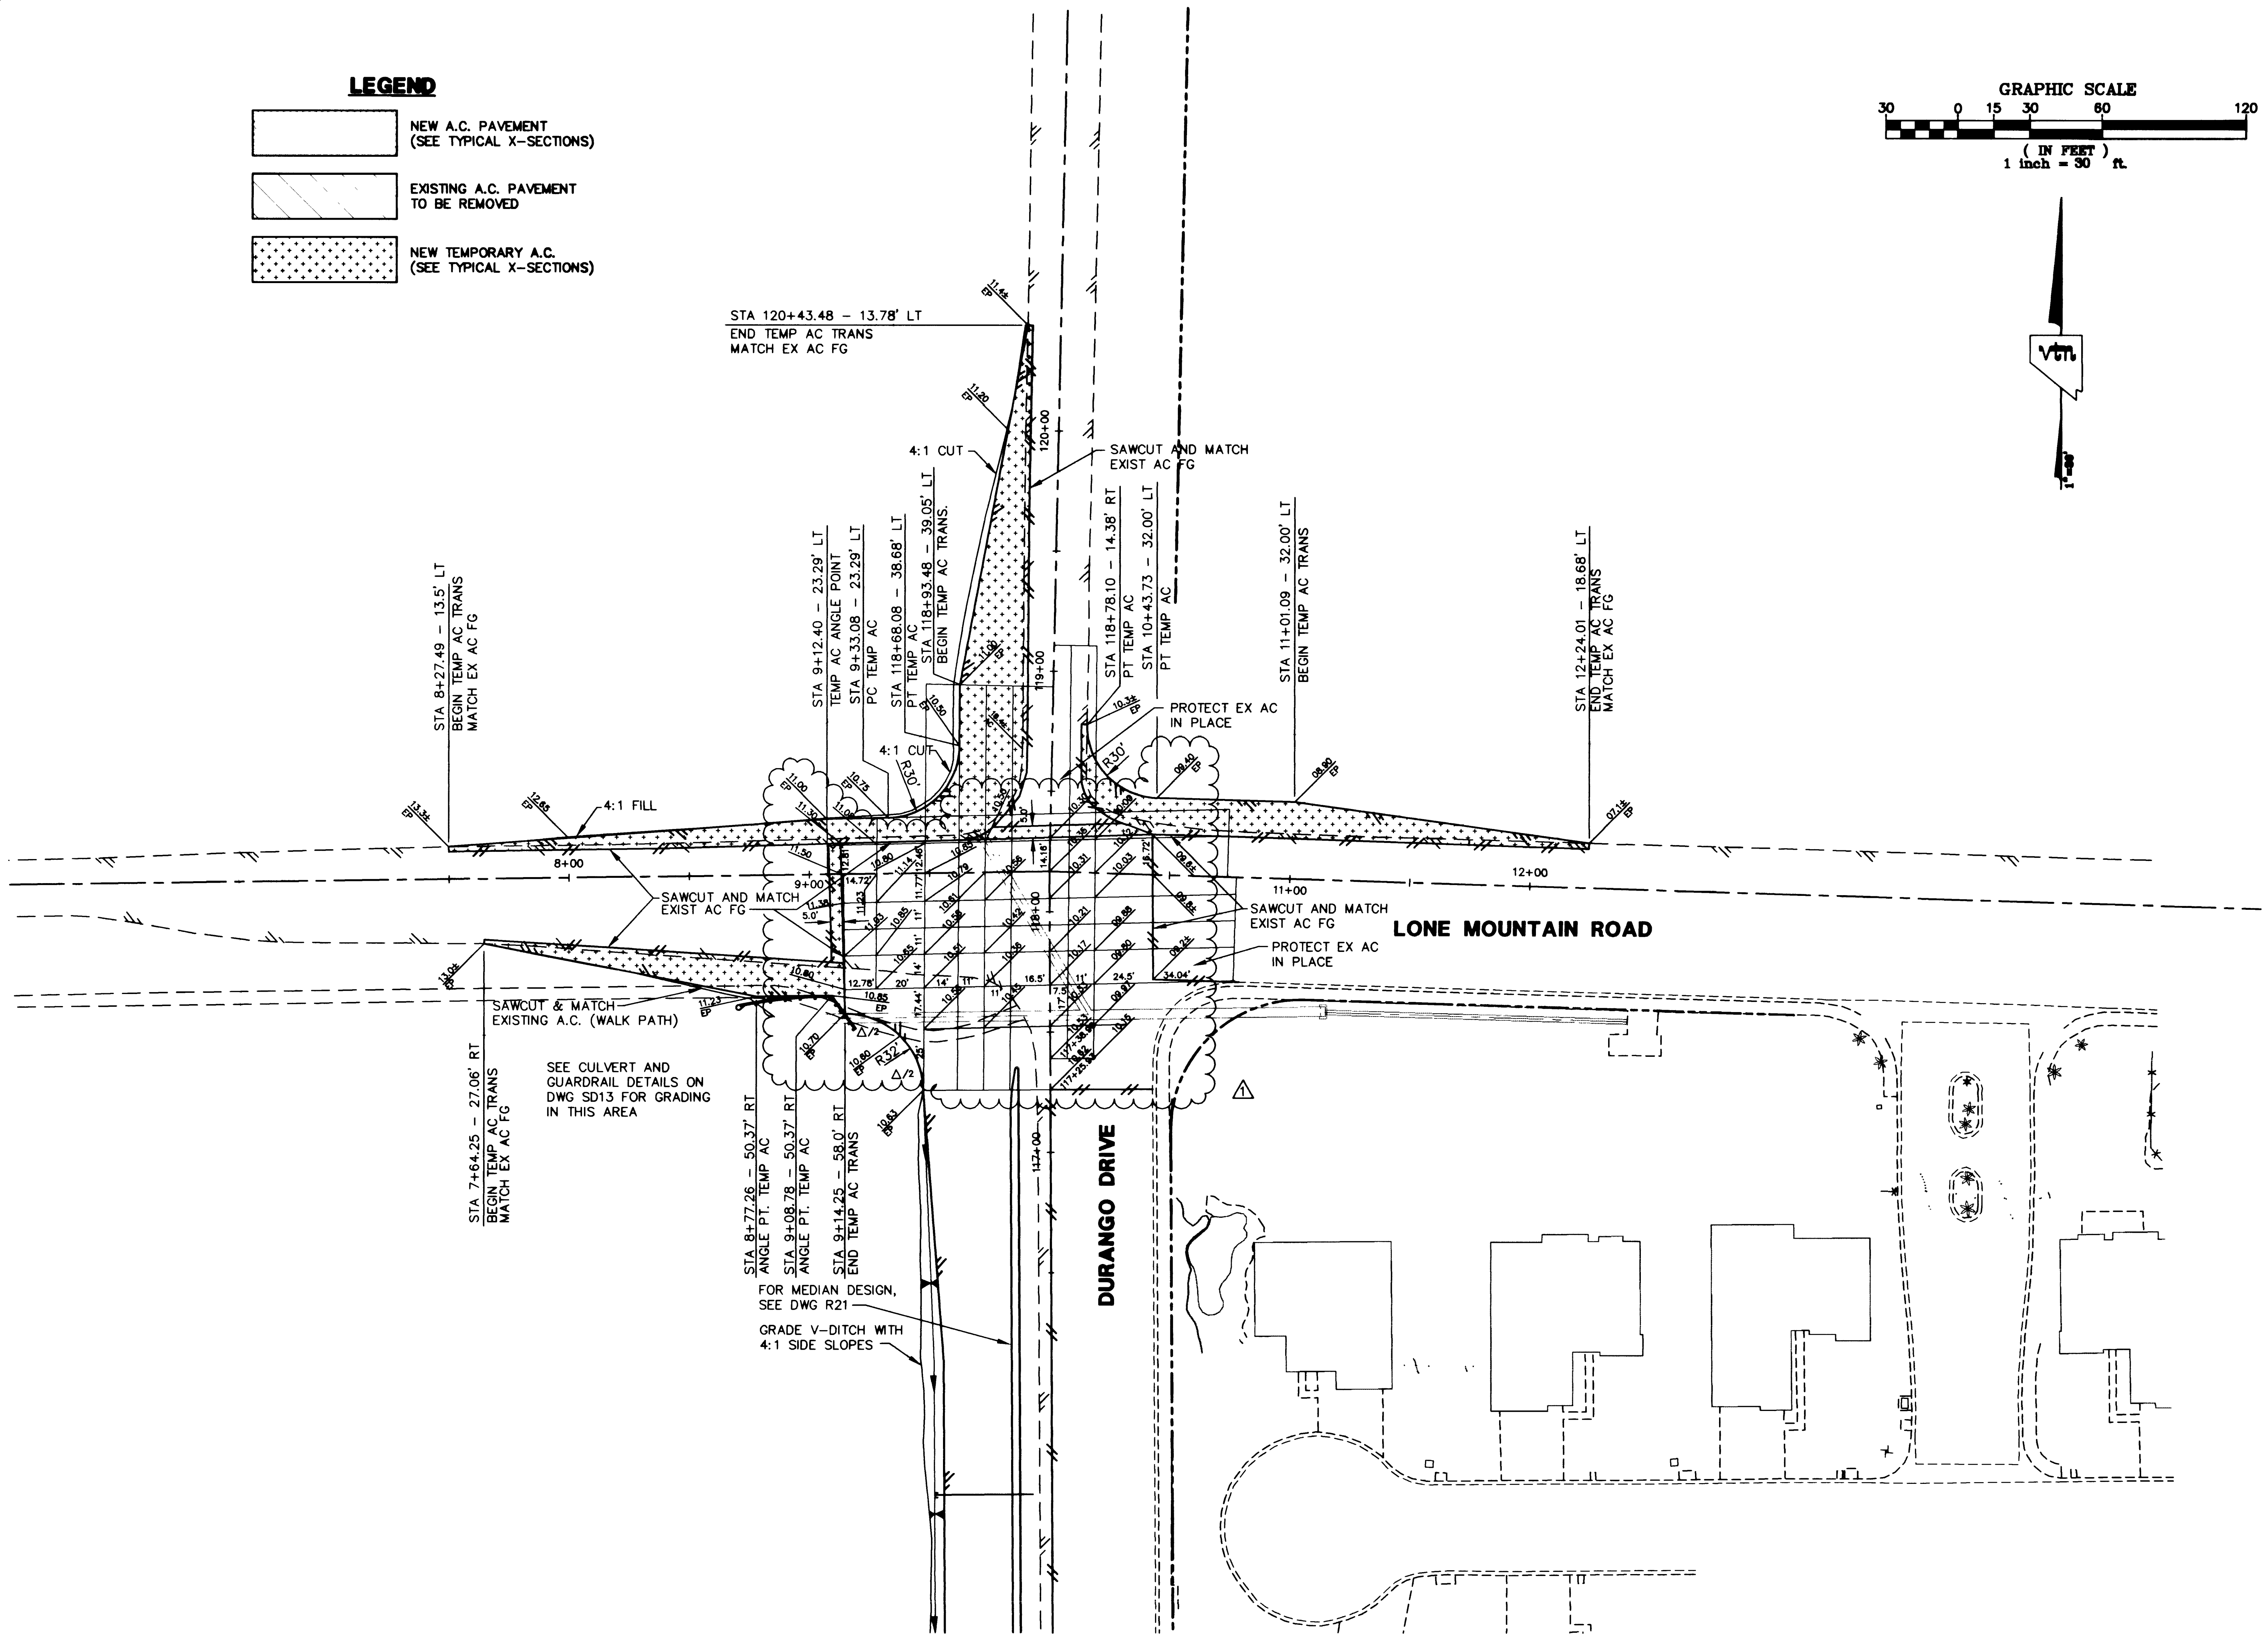
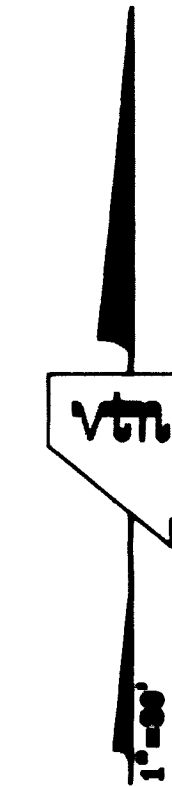


	NEW A.C. PAVEMENT (SEE TYPICAL X-SECTIONS)
	EXISTING A.C. PAVEMENT TO BE REMOVED
	NEW TEMPORARY A.C. (SEE TYPICAL X-SECTIONS)

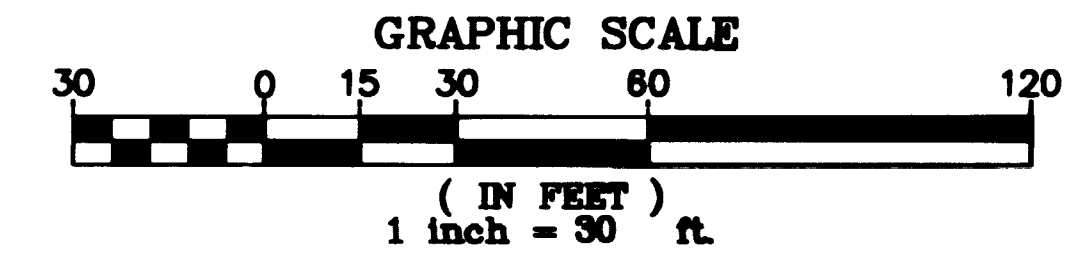

DEPARTMENT OF PUBLIC WORKS
CITY OF LAS VEGAS, NEVADA

VEN **nevada**

CONSULTING ENGINEERS • PLANNERS • LAND SURVEYORS
2727 SOUTH RAINBOW BOULEVARD
LAS VEGAS, NEVADA 89102-5148 PHONE (702) 873-7550 FAX (702) 362-2599

INTERSECTION GRADING PLAN
LONE MTN ROAD / DURANGO DR

DURANGO DRIVE IMPROVEMENTS
CHEYENNE AVENUE TO LONE MOUNTAIN ROAD

O. NO.		5249	
Y		JL/LMW	
DATE		07/17/98	
SCALE	HORIZ.	1"=30'	
	VERT.	NONE	
DRAWING		SHEET	
R16		46	
		OF	
		106	
		SHEETS	

RECORD DRAWING 03/23/01