


NEW PLT (PS)
I:\CADD\PROJECTS\5249\5249-MED.DWG

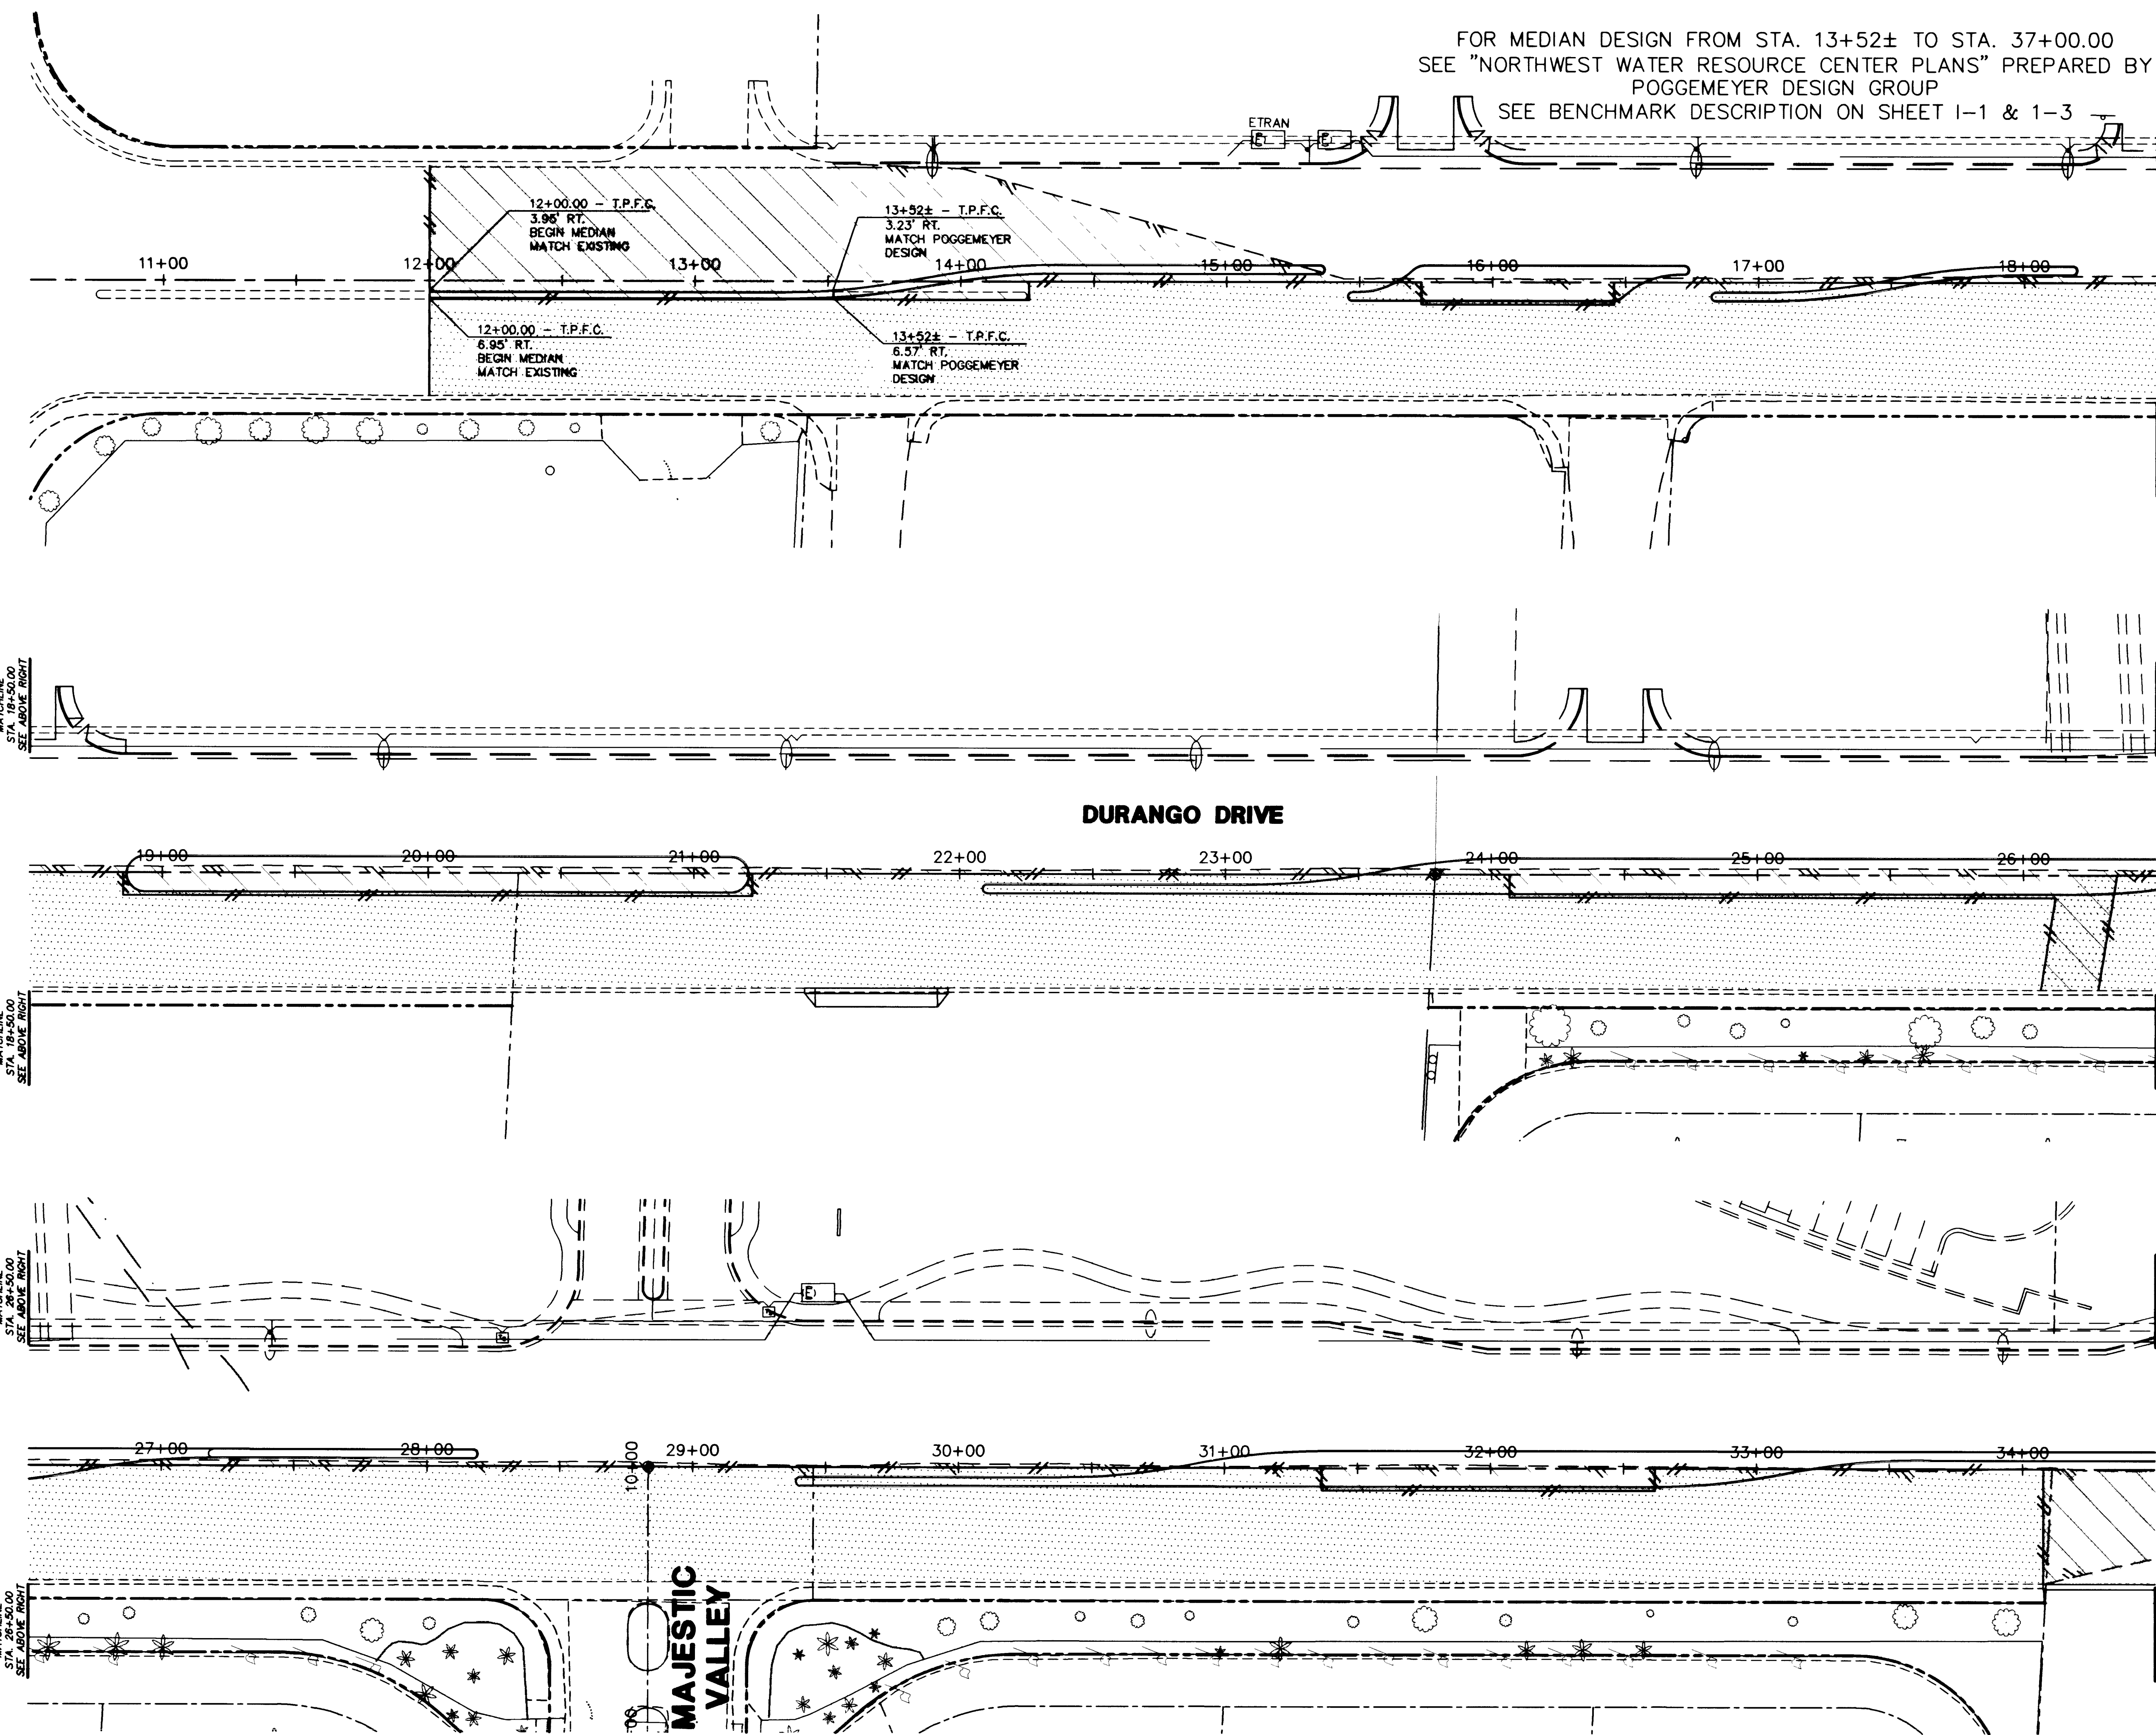

FOR MEDIAN DESIGN FROM STA. 13+52± TO STA. 37+00.00
SEE "NORTHWEST WATER RESOURCE CENTER PLANS" PREPARED BY
POGGEMEYER DESIGN GROUP
SEE BENCHMARK DESCRIPTION ON SHEET 1-1 & 1-3

NOTE:
ALL "T.B.C." OFFSET REFERENCES
ARE TO TOP BACK OF CURB
ALL "T.P.F.C." OFFSET REFERENCES
ARE TO THE TOP OF PAVEMENT AT FACE
OF CURB.

LEGEND

- NEW A.C. PAVEMENT
(SEE TYPICAL
CROSS-SECTIONS)
- EXISTING A.C. PAVEMENT
TO BE REMOVED
- EXISTING A.C. PAVEMENT
TO REMAIN WITH NEW
A.C. OVERLAY (SEE
TYPICAL X-SECTIONS)
- NEW TEMPORARY A.C.
(SEE TYPICAL
CROSS-SECTIONS)
- NEW CONCRETE MEDIAN
- NEW 6" TYPE II
AGGREGATE BASE

DEPARTMENT OF PUBLIC WORKS
CITY OF LAS VEGAS

vtm nevada

CONSULTING ENGINEERS • PLANNERS • LAND SURVEYORS
2727 SOUTH RAINBOW BOULEVARD
LAS VEGAS, NEVADA 89102-5148 PHONE (702) 873-7550 FAX (702) 362-2597

TITLE MEDIAN ISLAND GEOMETRICS
AND
IRRIGATION PLAN

PROJECT DURATION DRIVE IMPROVEMENTS
CHEYENNE AVENUE TO LONE MOUNTAIN ROAD

NO. NO. 5249
BY JSL
DATE 07/17/98
SCALE HORIZ. 1"=30'
VERT. NONE
DRAWING SHEET 47
R17 OF 106
SHEETS

RECORD DRAWING 03/23/01