


VEN "PLT" (PS)
I:\CADD\PROJECTS\5249\5249-MED.DWG

32232

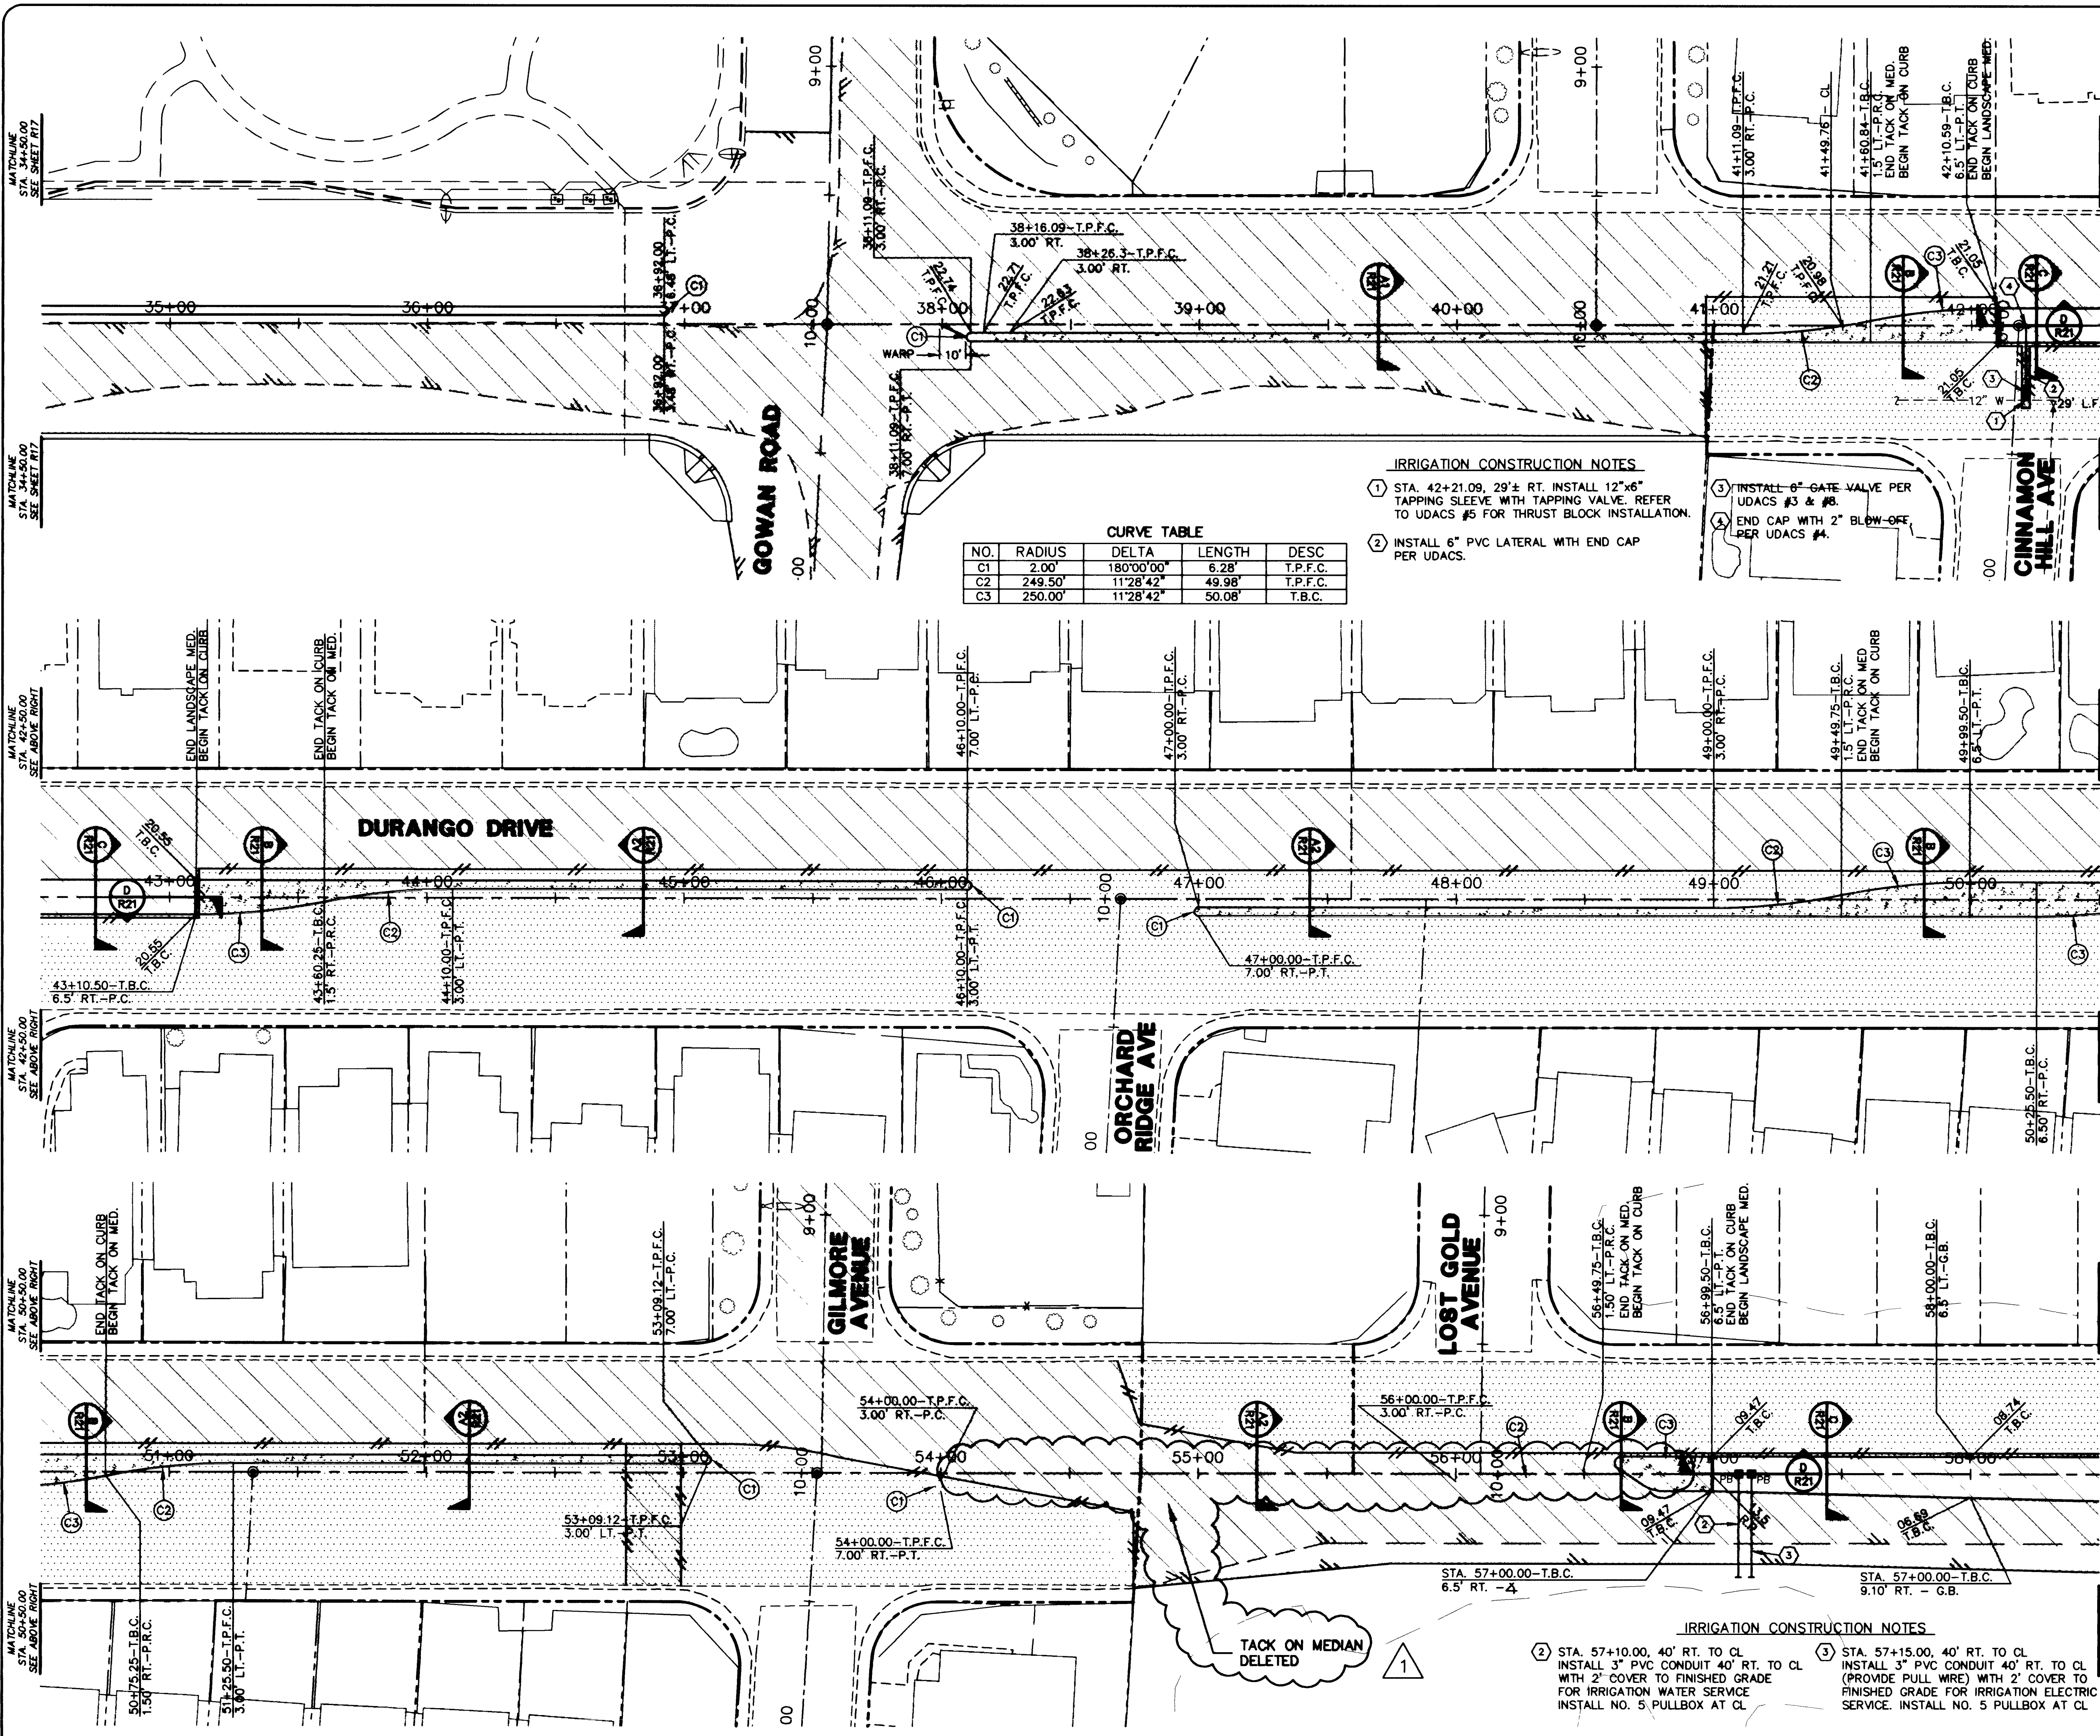

CURVE TABLE				
NO.	RADIUS	DELTA	LENGTH	DESC
C1	2.00'	180°00'00"	6.28'	T.P.F.C.
C2	249.50'	11°28'42"	49.98'	T.P.F.C.
C3	250.00'	11°28'42"	50.08'	T.B.C.

- IRRIGATION CONSTRUCTION NOTES**
- STA. 42+21.09, 29'± RT. INSTALL 12"x6" TAPPING SLEEVE WITH TAPPING VALVE. REFER TO UDACS #5 FOR THRUST BLOCK INSTALLATION.
 - INSTALL 6" PVC LATERAL WITH END CAP PER UDACS.
 - INSTALL 6" GATE VALVE PER UDACS #3 & #8.
 - END CAP WITH 2" BLOW-OFF PER UDACS #4.

NOTE:
ALL "T.B.C." OFFSET REFERENCES ARE TO TOP BACK OF CURB
ALL "T.P.F.C." OFFSET REFERENCES ARE TO THE TOP OF PAVEMENT AT FACE OF CURB.

- LEGEND**
- NEW A.C. PAVEMENT (SEE TYPICAL CROSS-SECTIONS)
 - EXISTING A.C. PAVEMENT TO BE REMOVED
 - EXISTING A.C. PAVEMENT TO REMAIN WITH NEW A.C. OVERLAY (SEE TYPICAL X-SECTIONS)
 - NEW TEMPORARY A.C. (SEE TYPICAL CROSS-SECTIONS)
 - NEW CONCRETE MEDIAN
 - NEW 6" TYPE II AGGREGATE BASE

CONDITIONAL APPROVAL OF VALVED OUTLET (6" OR LARGER)
THE WATER PLANS SHOW ONE OR MORE VALVED OUTLETS EXTENDING OUT OF PAVED AREAS. INSTALLATION OF THESE OUTLETS IS ACCEPTABLE, HOWEVER, IF THE OUTLETS ARE INCORRECTLY LOCATED OR NOT USED FOR ANY REASON WHEN THE PROPERTY IS ACTUALLY DEVELOPED, THE DEVELOPER SHALL ABANDON THE OUTLETS AT THE CONNECTION TO THE ACTIVE MAIN IN ACCORDANCE WITH THE AGENCY'S STANDARDS AND AT THE DEVELOPER'S EXPENSE. APPROVAL OF THE VALVED OUTLET DOES NOT PROVIDE OR IMPLY A WATER COMMITMENT.

APPROVED
LAS VEGAS VALLEY WATER DISTRICT DATE

- IRRIGATION CONSTRUCTION NOTES**
- STA. 57+10.00, 40' RT. TO CL. INSTALL 3" PVC CONDUIT 40' RT. TO CL WITH 2" COVER TO FINISHED GRADE FOR IRRIGATION WATER SERVICE. INSTALL NO. 5 PULLBOX AT CL.
 - STA. 57+15.00, 40' RT. TO CL. INSTALL 3" PVC CONDUIT 40' RT. TO CL (PROVIDE PULL WIRE) WITH 2" COVER TO FINISHED GRADE FOR IRRIGATION ELECTRIC SERVICE. INSTALL NO. 5 PULLBOX AT CL.

DEPARTMENT OF PUBLIC WORKS
CITY OF LAS VEGAS

CONSULTING ENGINEERS • PLANNERS • LAND SURVEYORS
2727 SOUTH RAINBOW BOULEVARD
LAS VEGAS, NEVADA 89102-5148
PHONE (702) 873-7550 FAX (702) 362-2597

vtm nevada

TITLE
MEDIAN ISLAND GEOMETRICS AND IRRIGATION PLAN

PROJECT
DURANGO DRIVE IMPROVEMENTS
CHEYENNE AVENUE TO LONE MOUNTAIN ROAD

NO. NO. 5249
JSL
BY TMM,WBM,DJB
DATE 07/17/98
SCALE HORIZ. 1"=30'
VERT. NONE
DRAWING R18
SHEET 48 OF 106 SHEETS

REVISIONS
NO. DATE BY
1 2/19/01 KJO REVISED PER AS-BUILTS