


\\PUB\WORK\5249\5249-LA1.DWG
SD14P.LT, SD15P.LT, SD16P.LT
3/22/99


32249

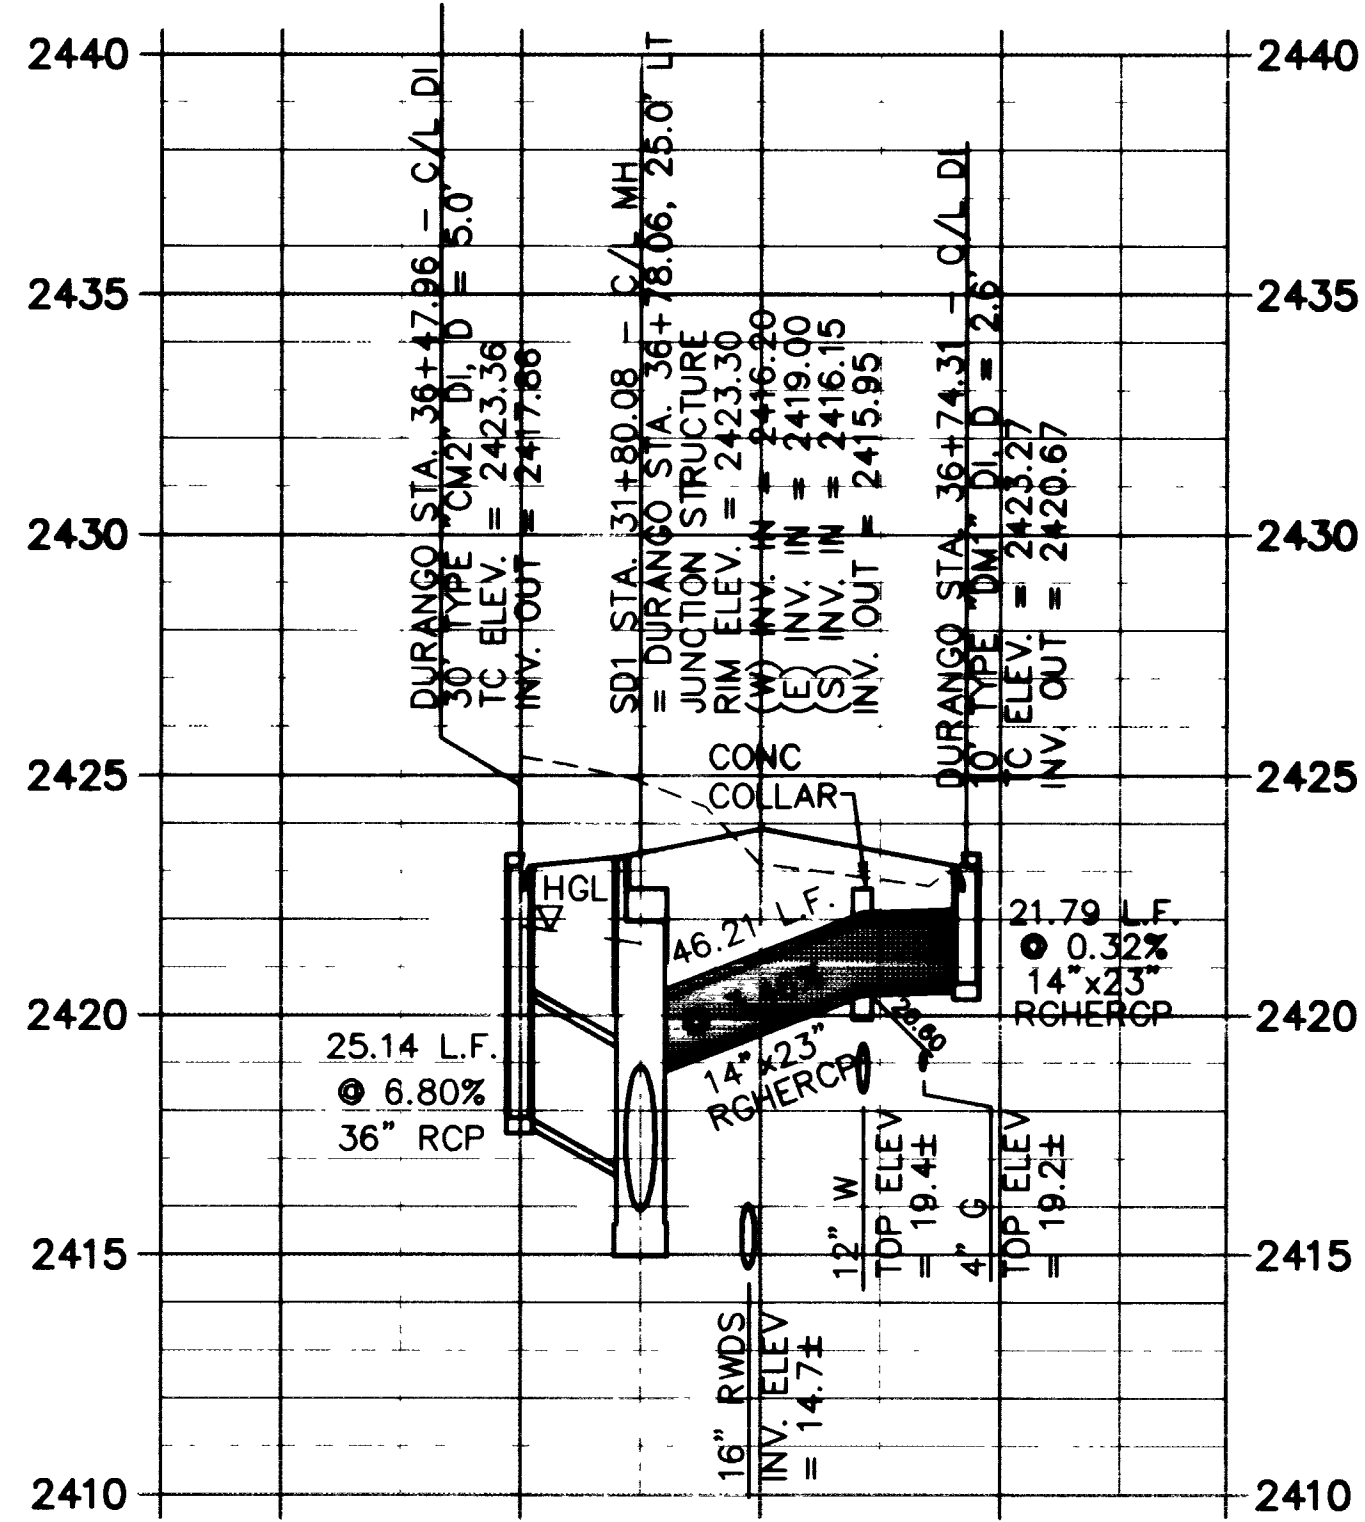

PROP. 18" SS
INV. ELEV
= 96.8±

1
—


STA. 36+78.06

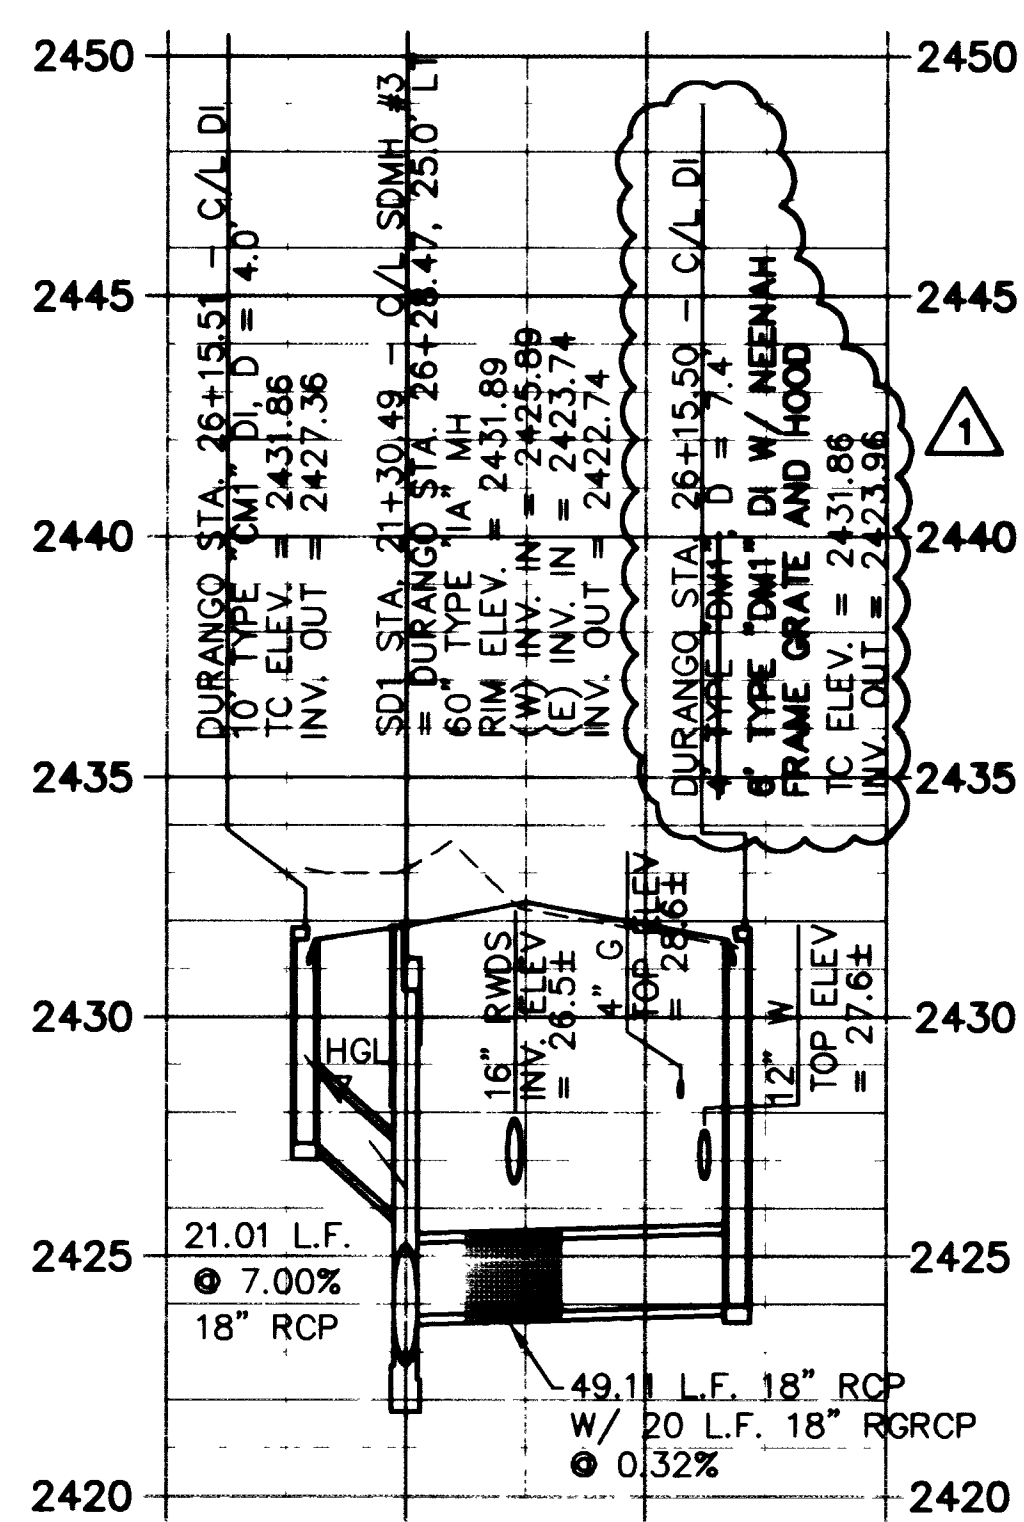

PROP. 18" SS
INV. ELEV
= 10.0±


2
—

STA. 26+28.47

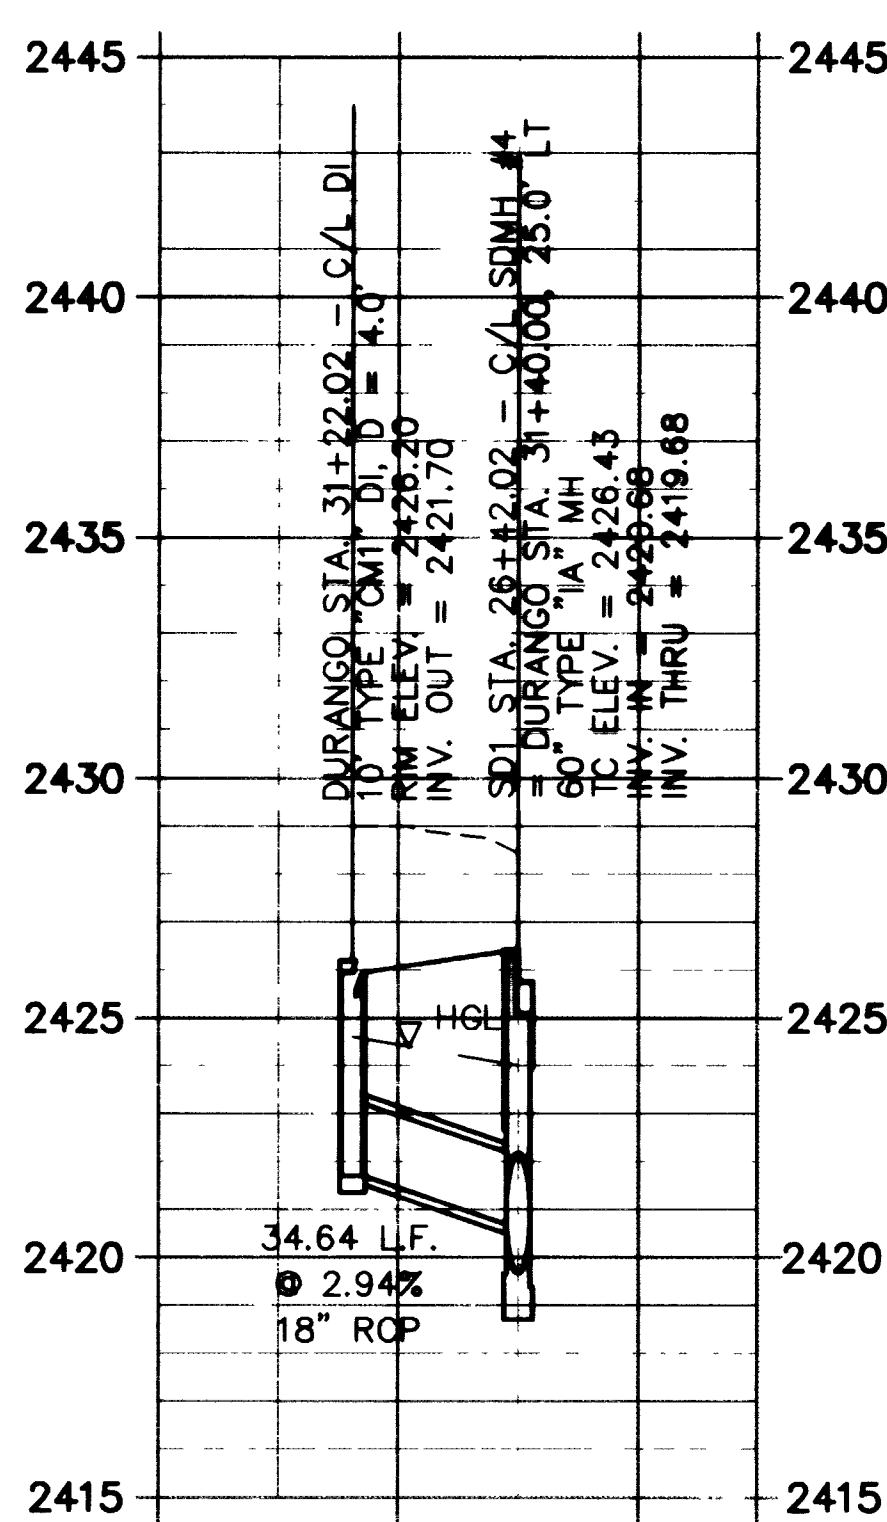

3
—


STA. 31+40.00

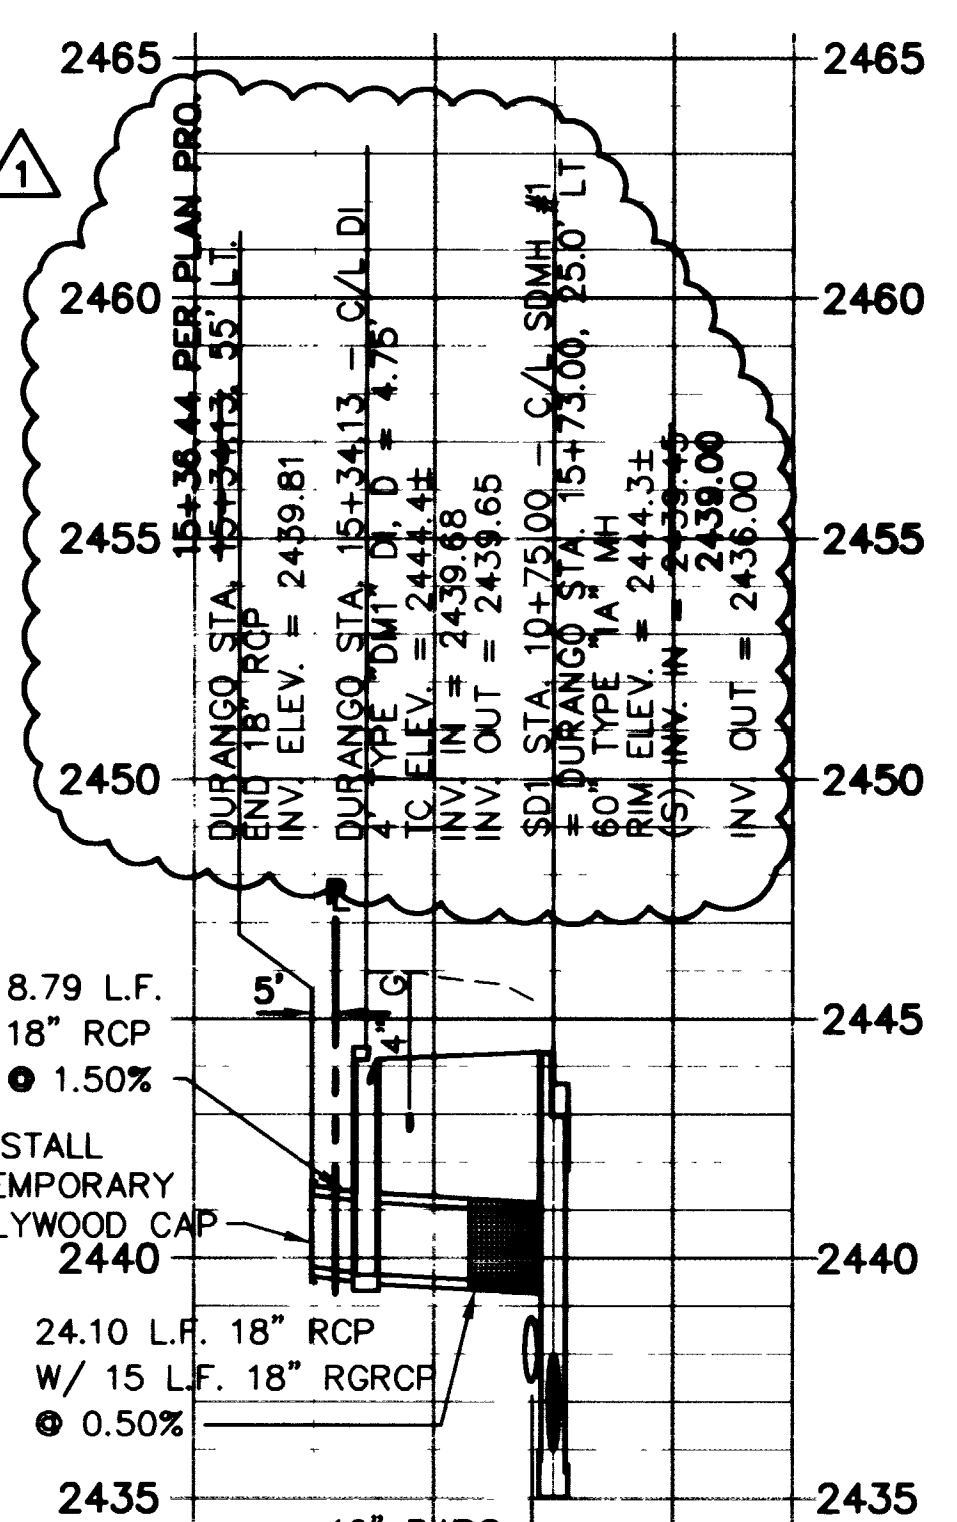

PROP. 30" SS
INV. ELEV
= 29.3±

4
—

STA. 15+73.00

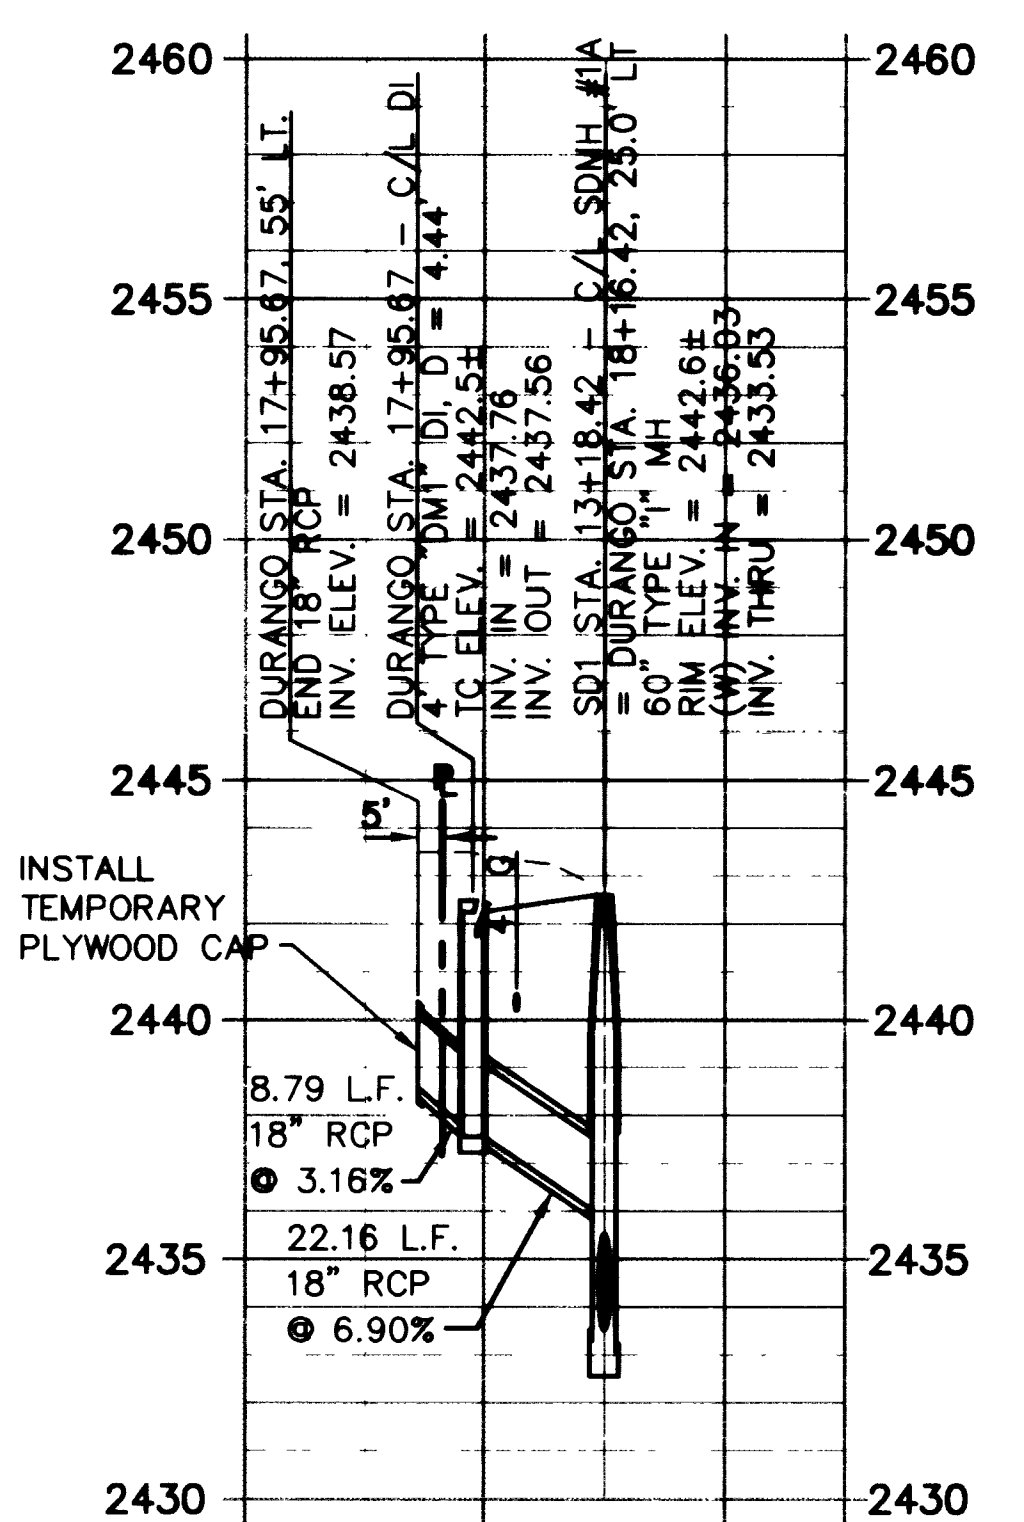

PROP. 18" SS
INV. ELEV
= 20.7±

5
—

STA. 18+16.42

- NOTES:
1. FOR STORM DRAIN SEE SHT.
SD1 AND SD2.
2. ALL RCP IS TO BE CLASS III.

APPROVED	
LAS VEGAS VALLEY WATER DISTRICT	DATE

STORM DRAIN LATERAL DETAILS
SD1 STA. 10+00 TO STA. 32+63.21
DURANGO DRIVE
CHEYENNE AVENUE TO LONE MOUNTAIN ROAD

NO. NO.	5249
BY	JL/LMW
DATE	07/17/98
SCALE	HORIZ. 1"=40' VERT. 1"=4'
DRAWING	SHEET 65 OF 106
SD14	

DEPARTMENT OF PUBLIC WORKS CITY OF LAS VEGAS, NEVADA	2/12/01 KJO REVISED PER AS-BUILTS
CONSULTING ENGINEERS • PLANNERS • LAND SURVEYORS 2727 SOUTH RAINBOW BOULEVARD LAS VEGAS, NEVADA 89102-5148 PHONE (702) 873-7550 FAX (702) 362-2597	REVISION

RECORD DRAWING 03/23/01