



VIEWS: SD14.PLT, SD15.PLT, SD16.PLT
I:\CADD\PUBLIC\3249\3249-LA1.DWG


32250

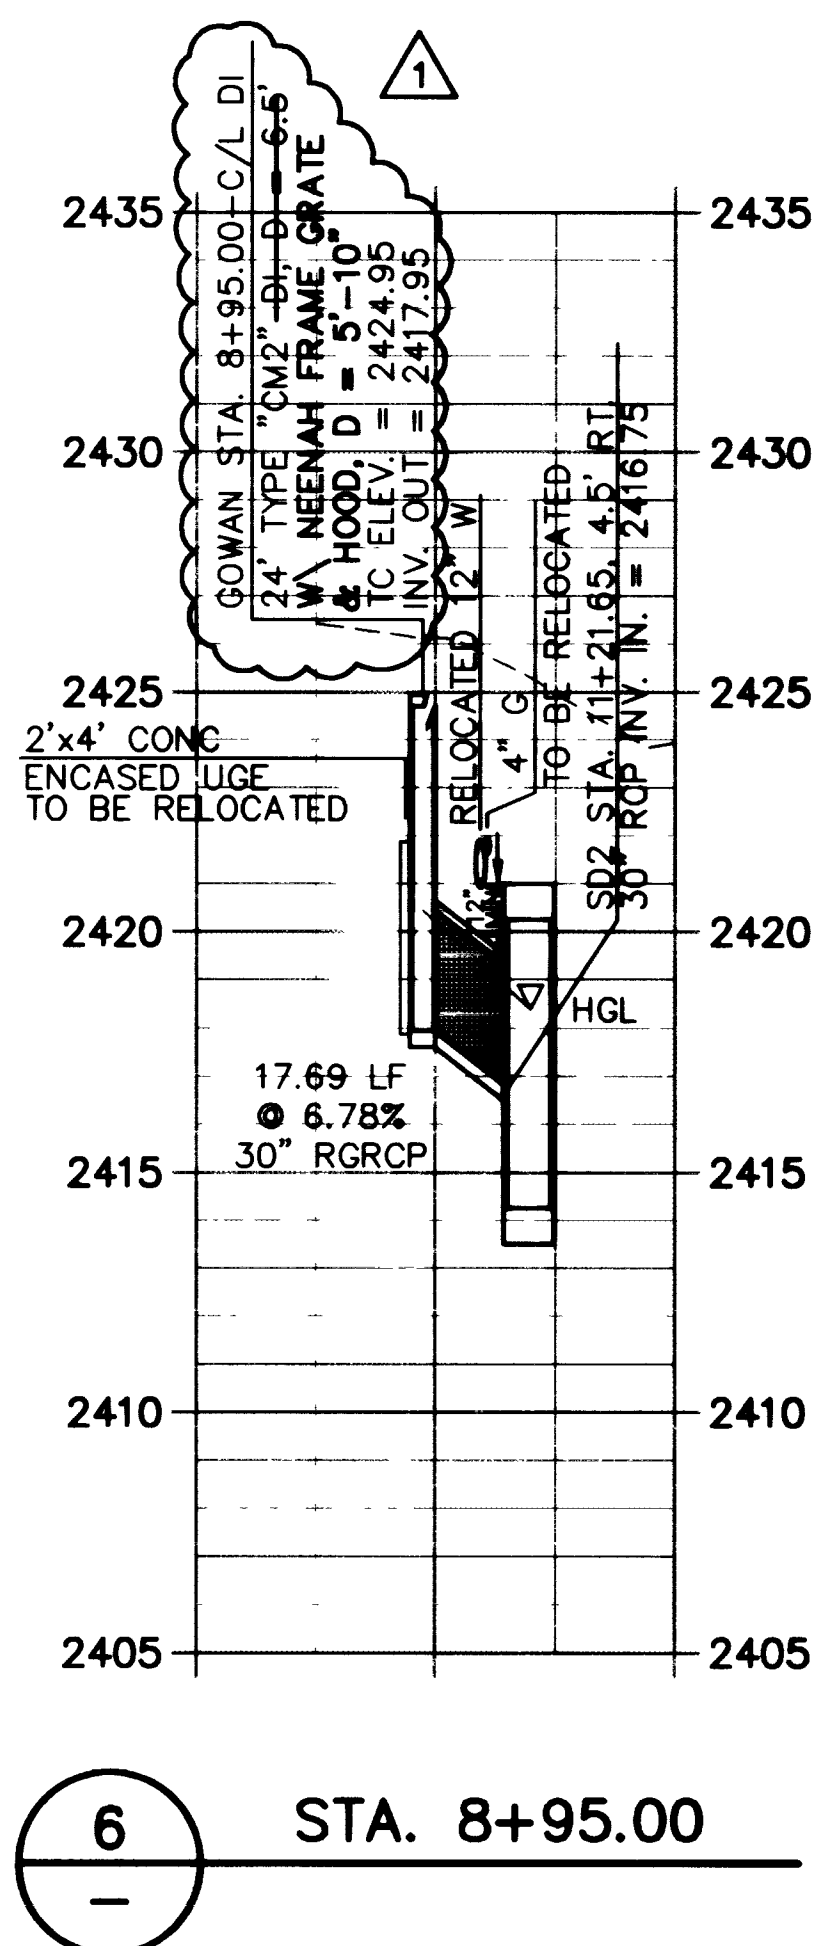


6 STA. 8+95.00

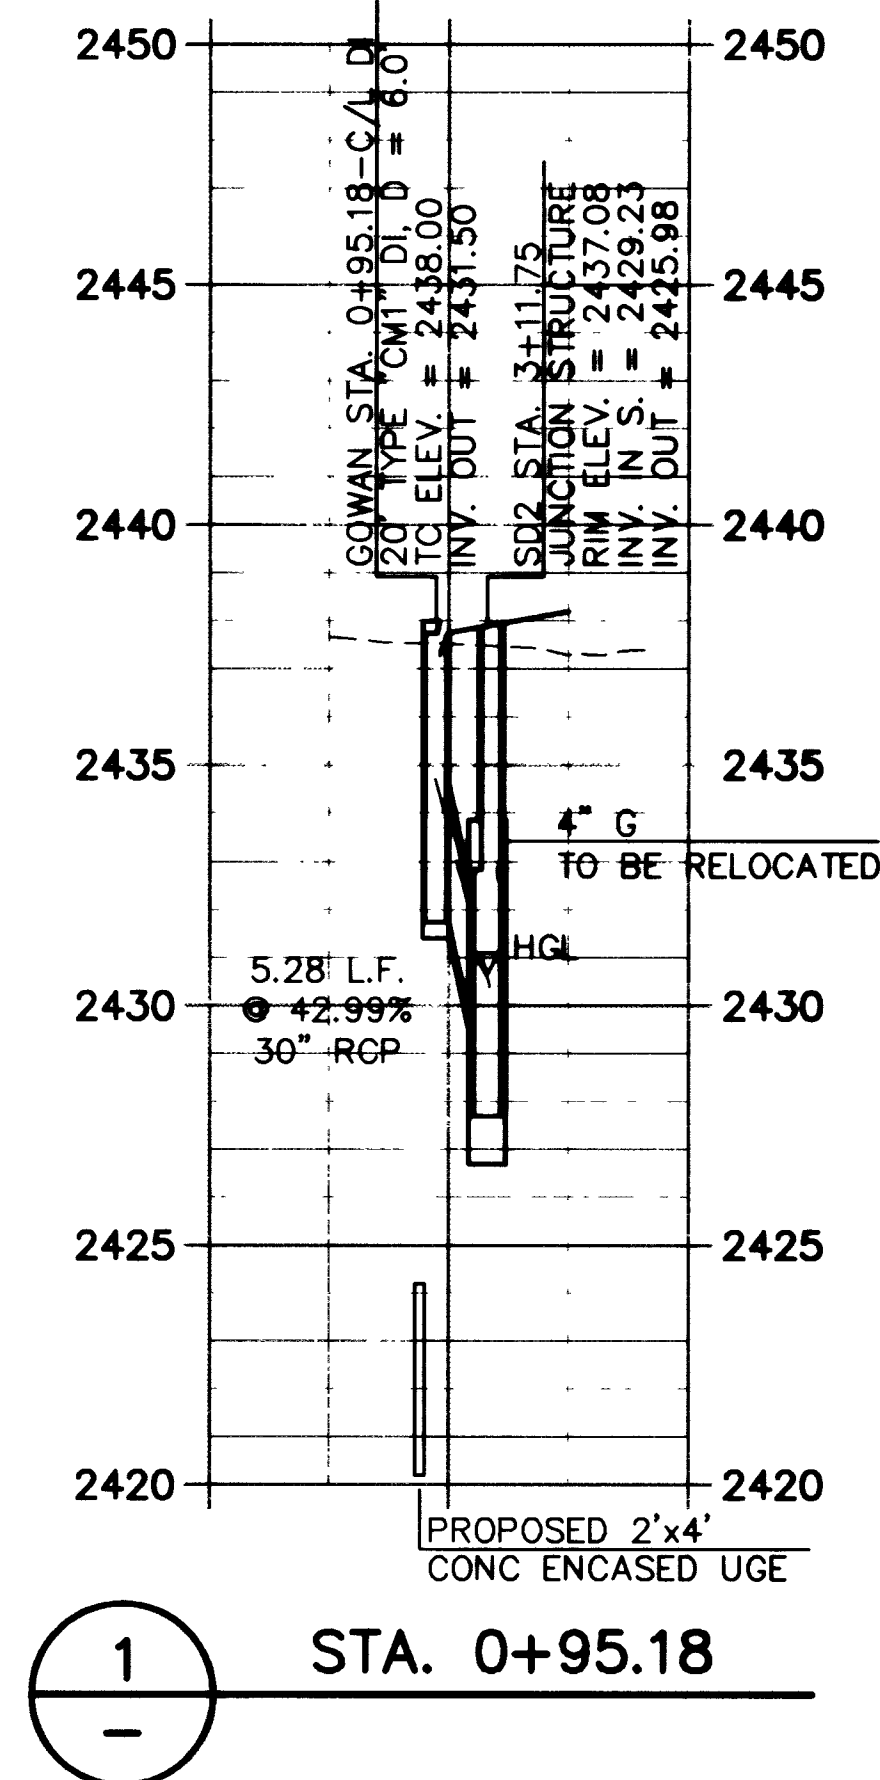


1 STA. 0+95.18

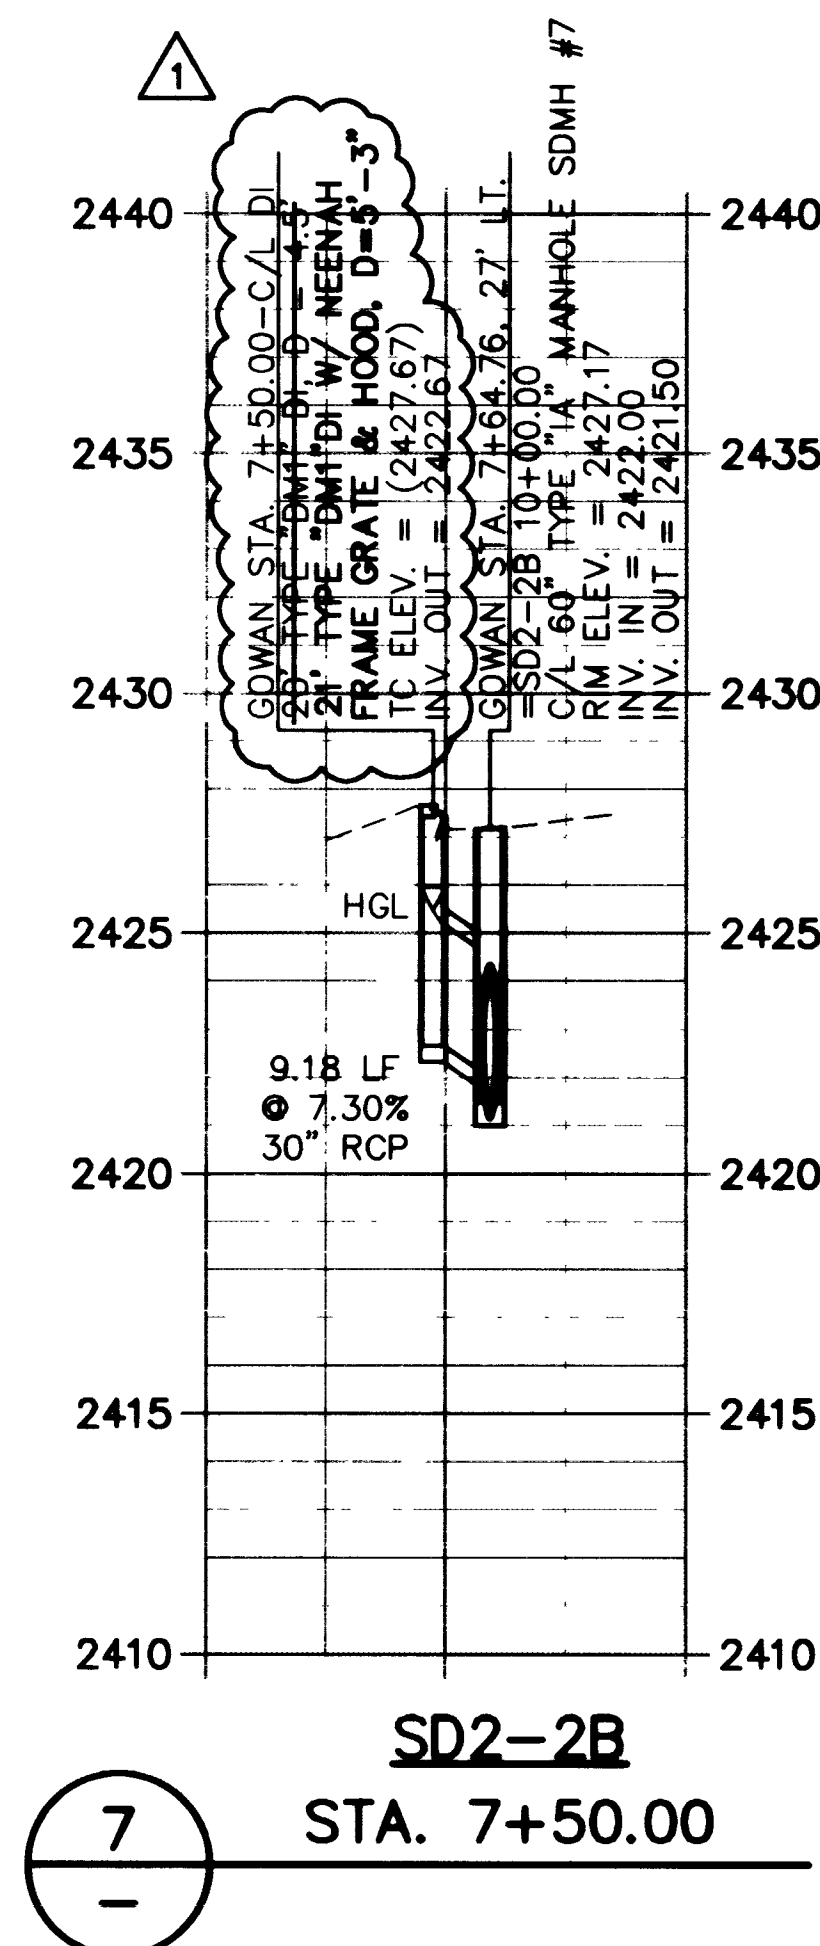


7 STA. 7+50.00

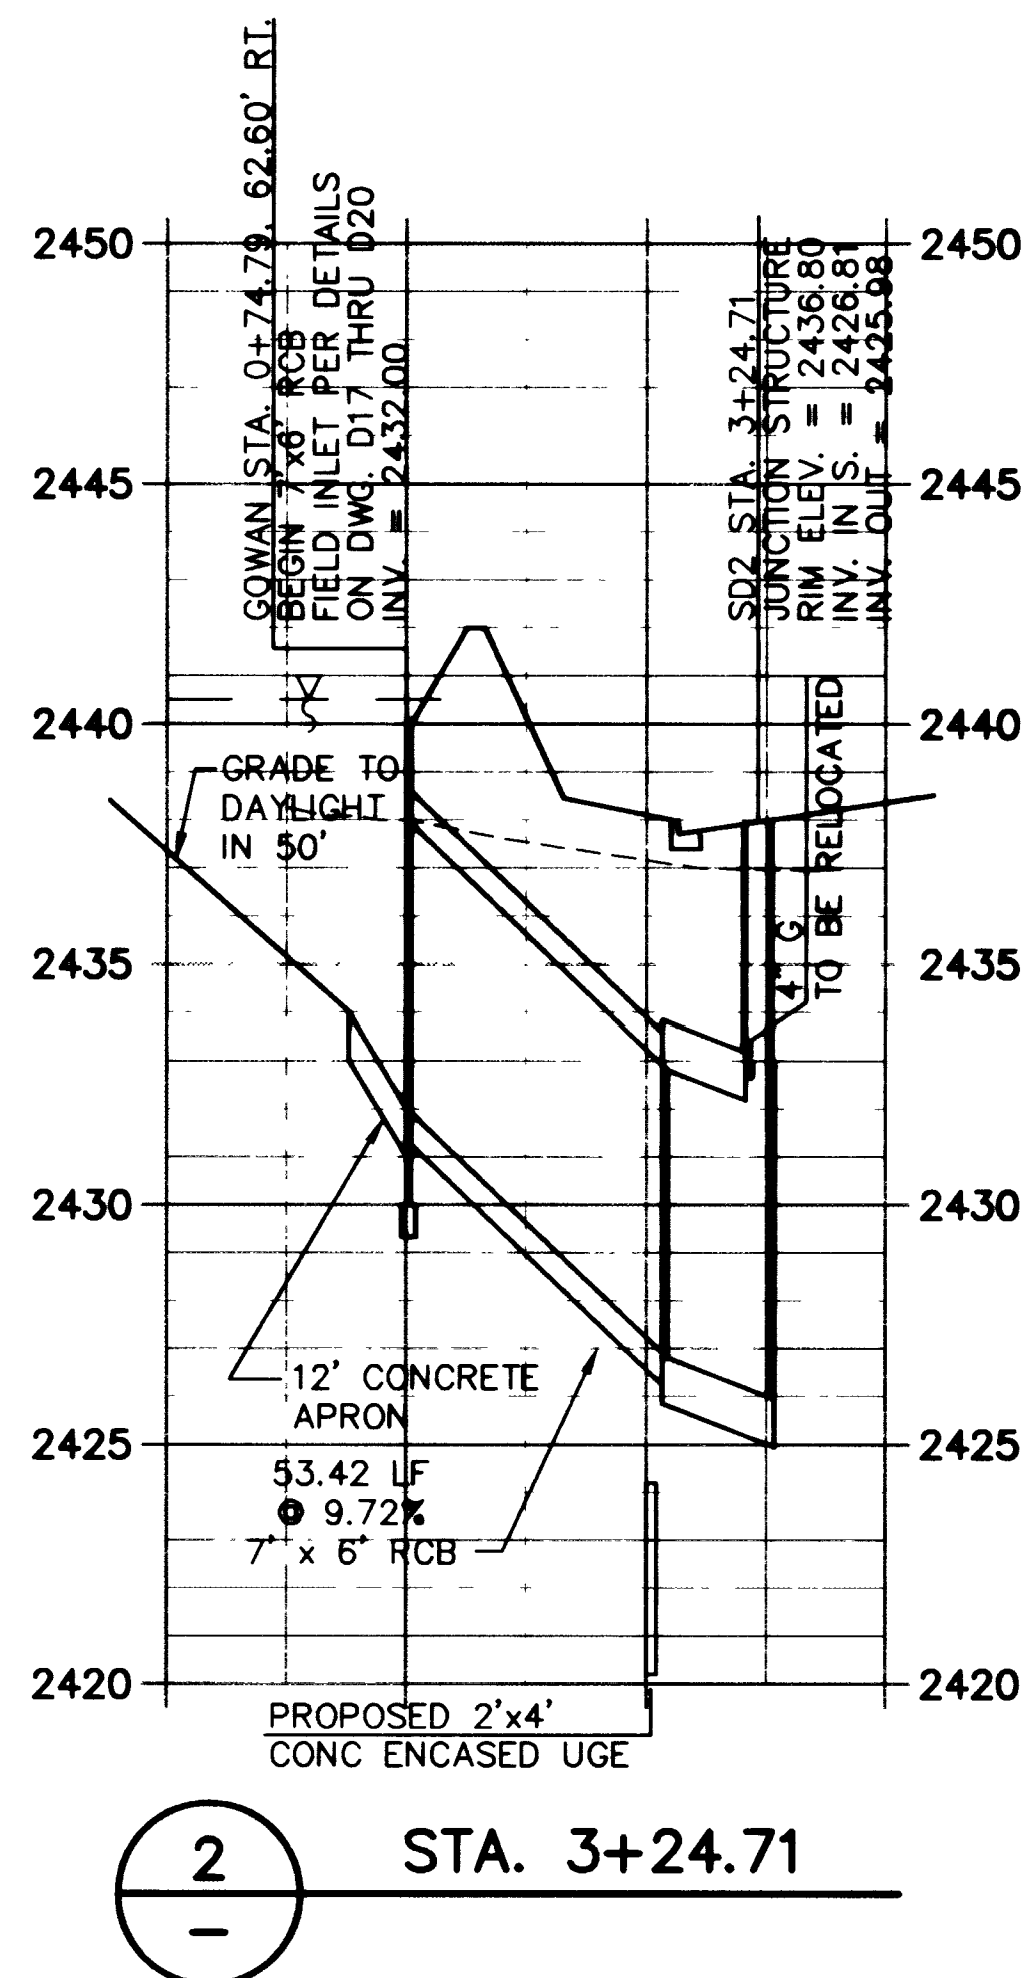


2 STA. 3+24.71

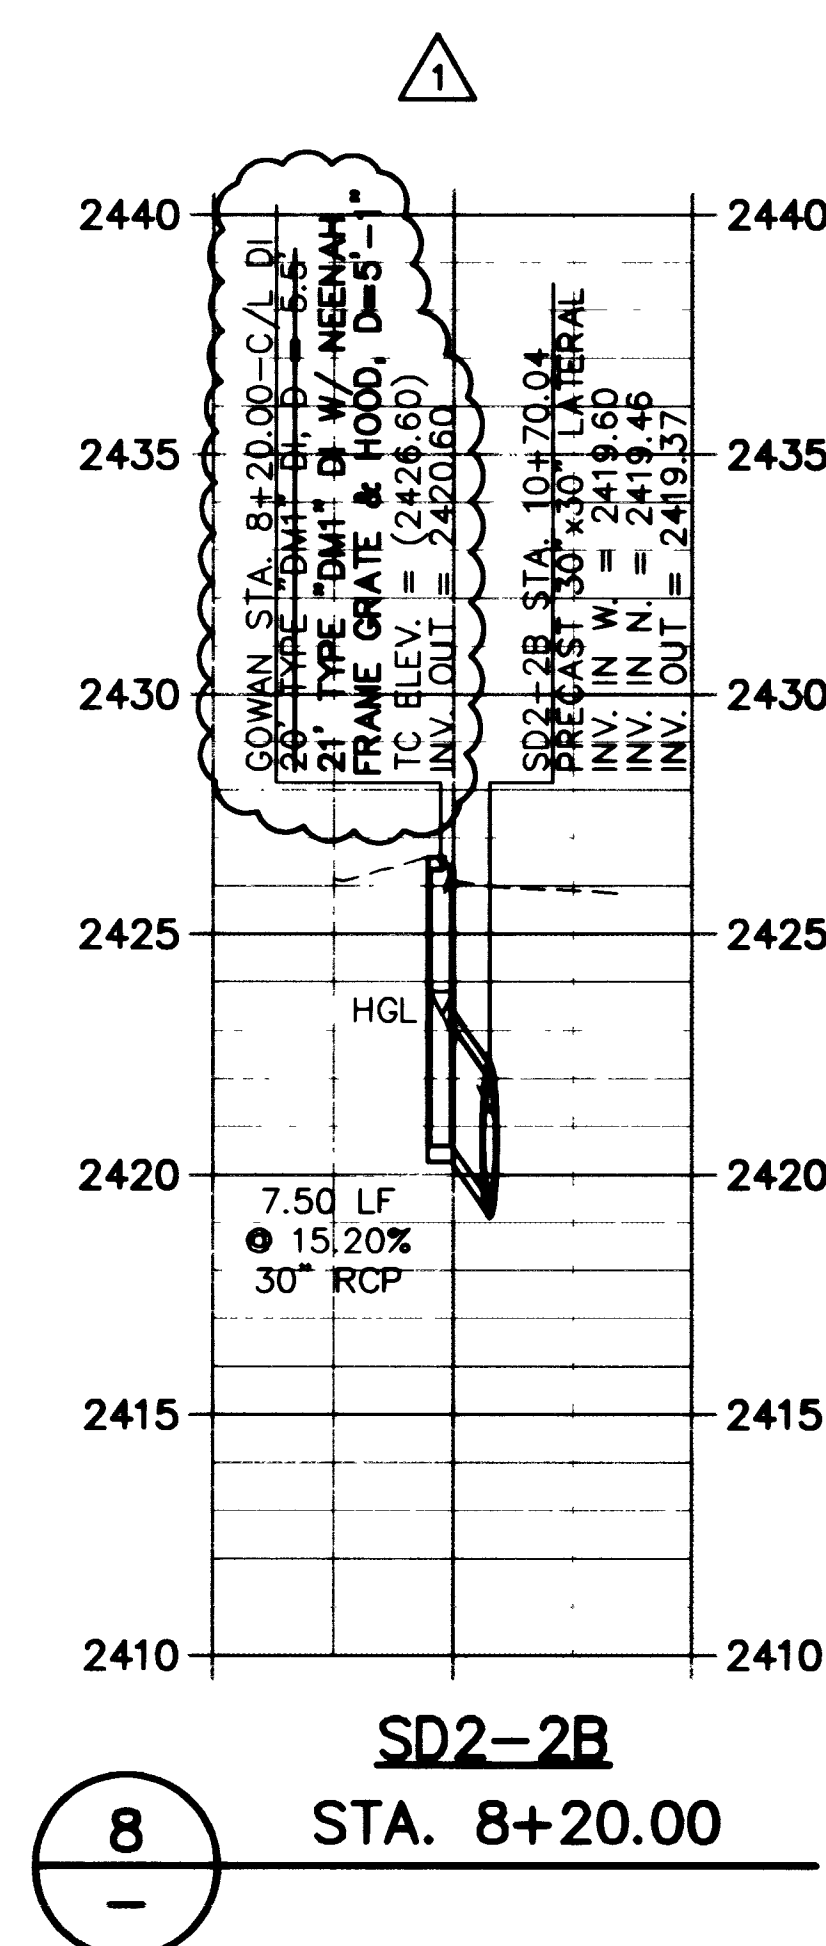


8 STA. 8+20.00

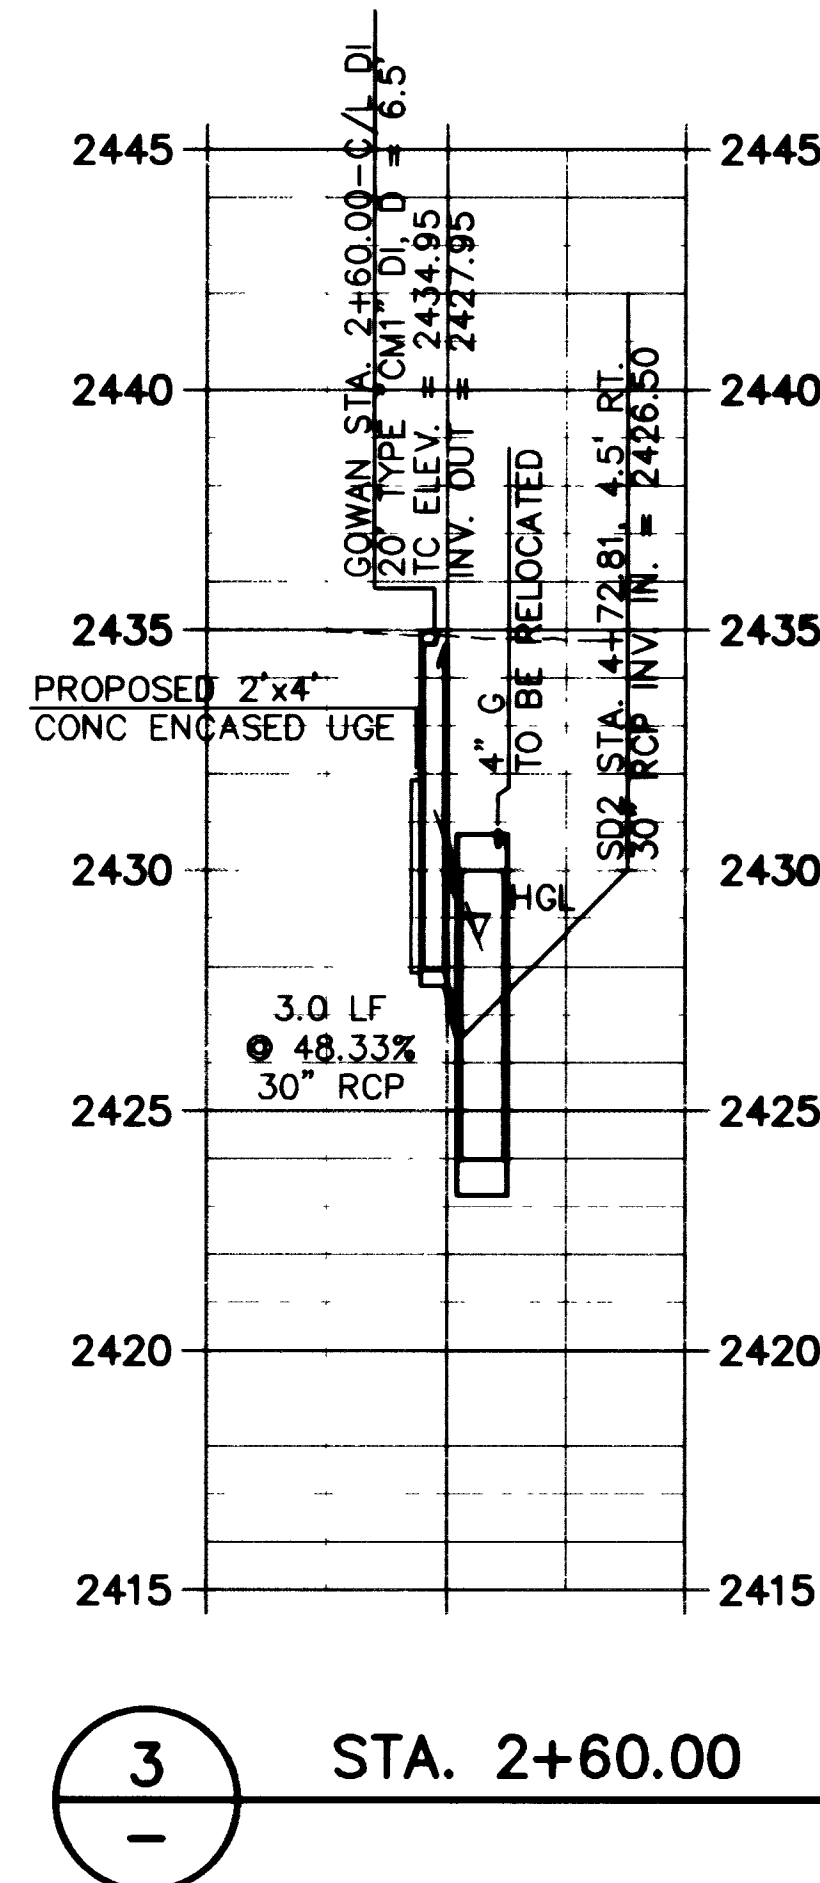


3 STA. 2+60.00

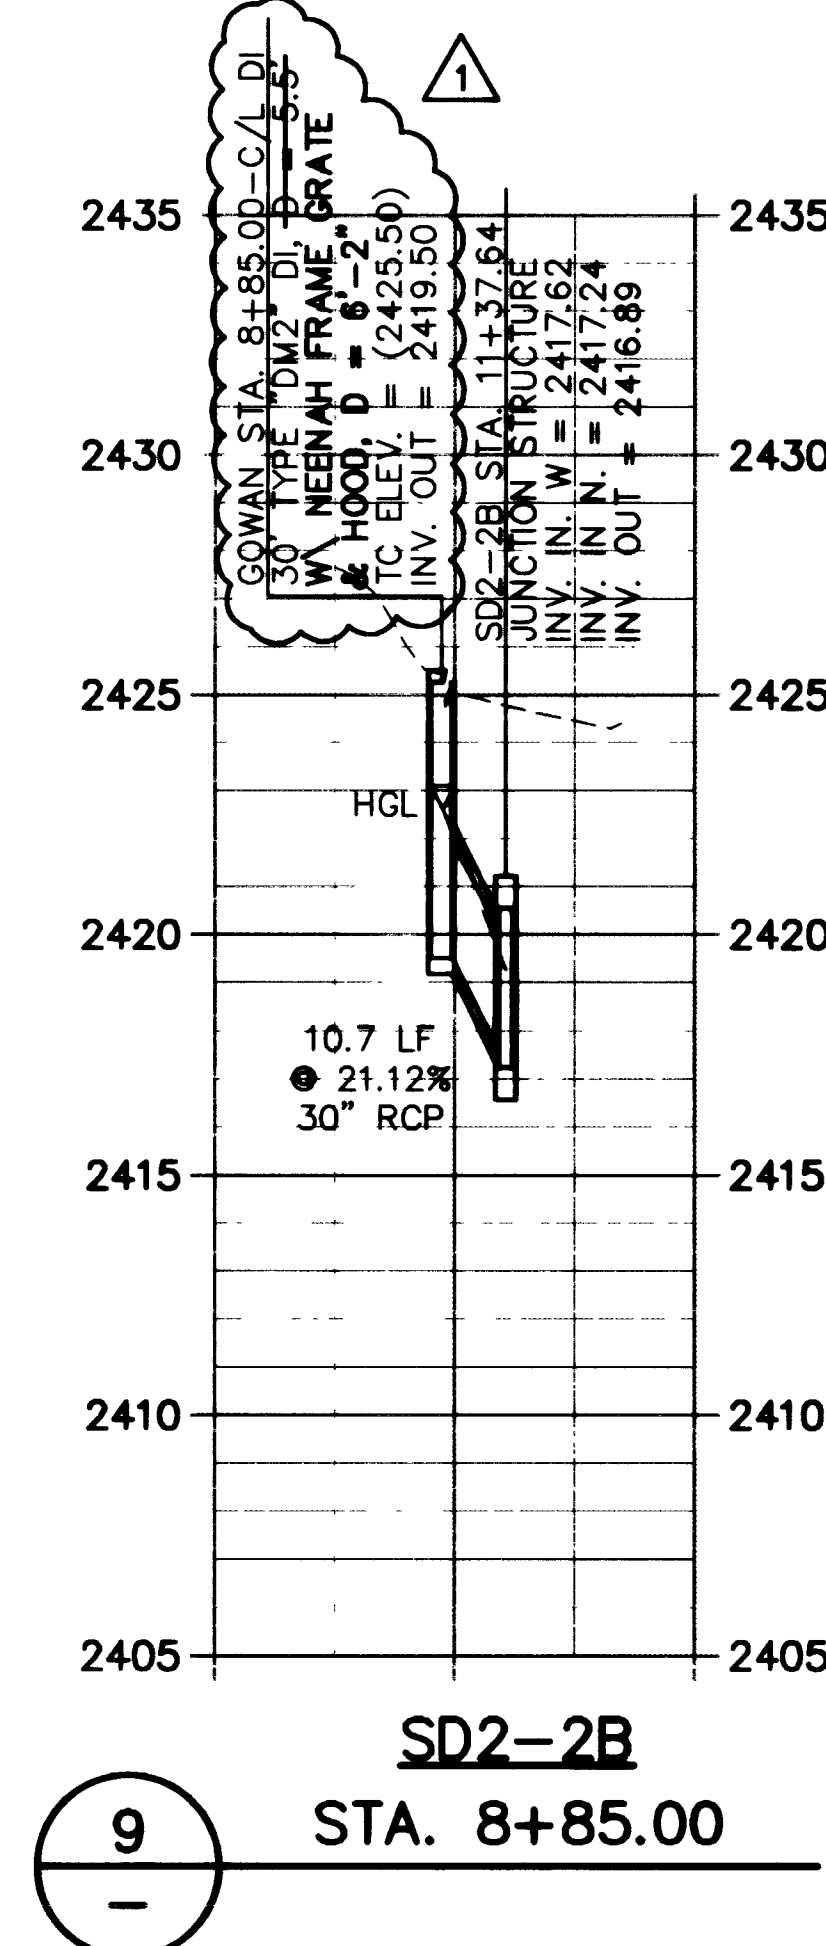


9 STA. 8+85.00

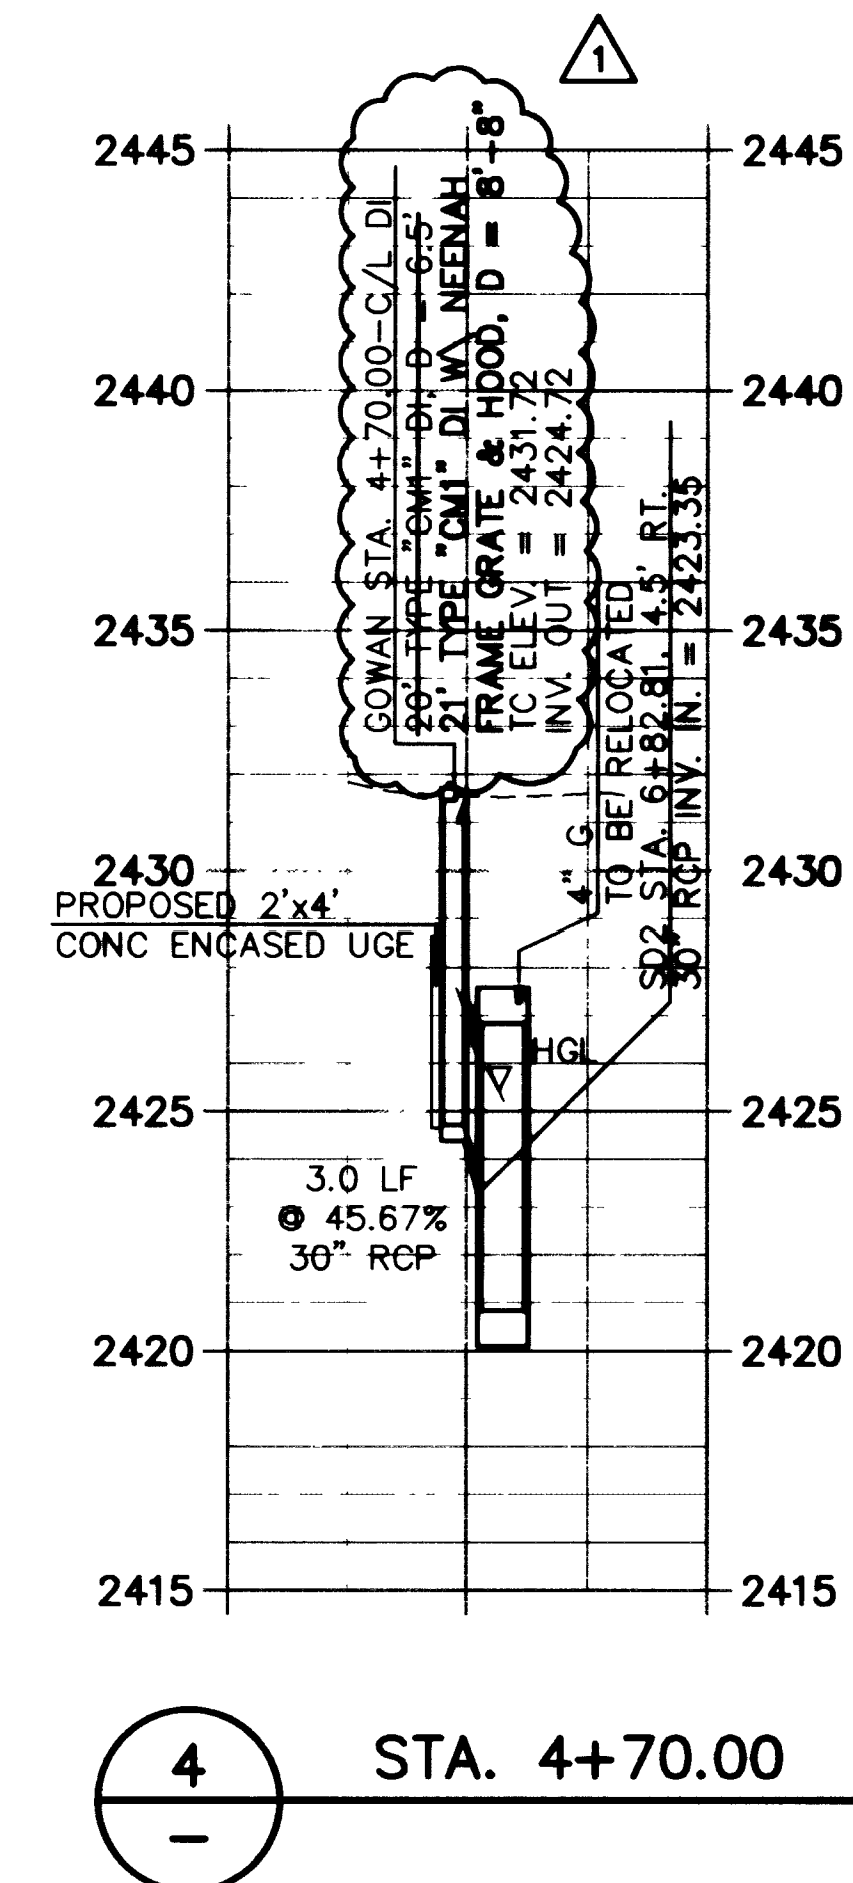

4 STA. 4+70.00

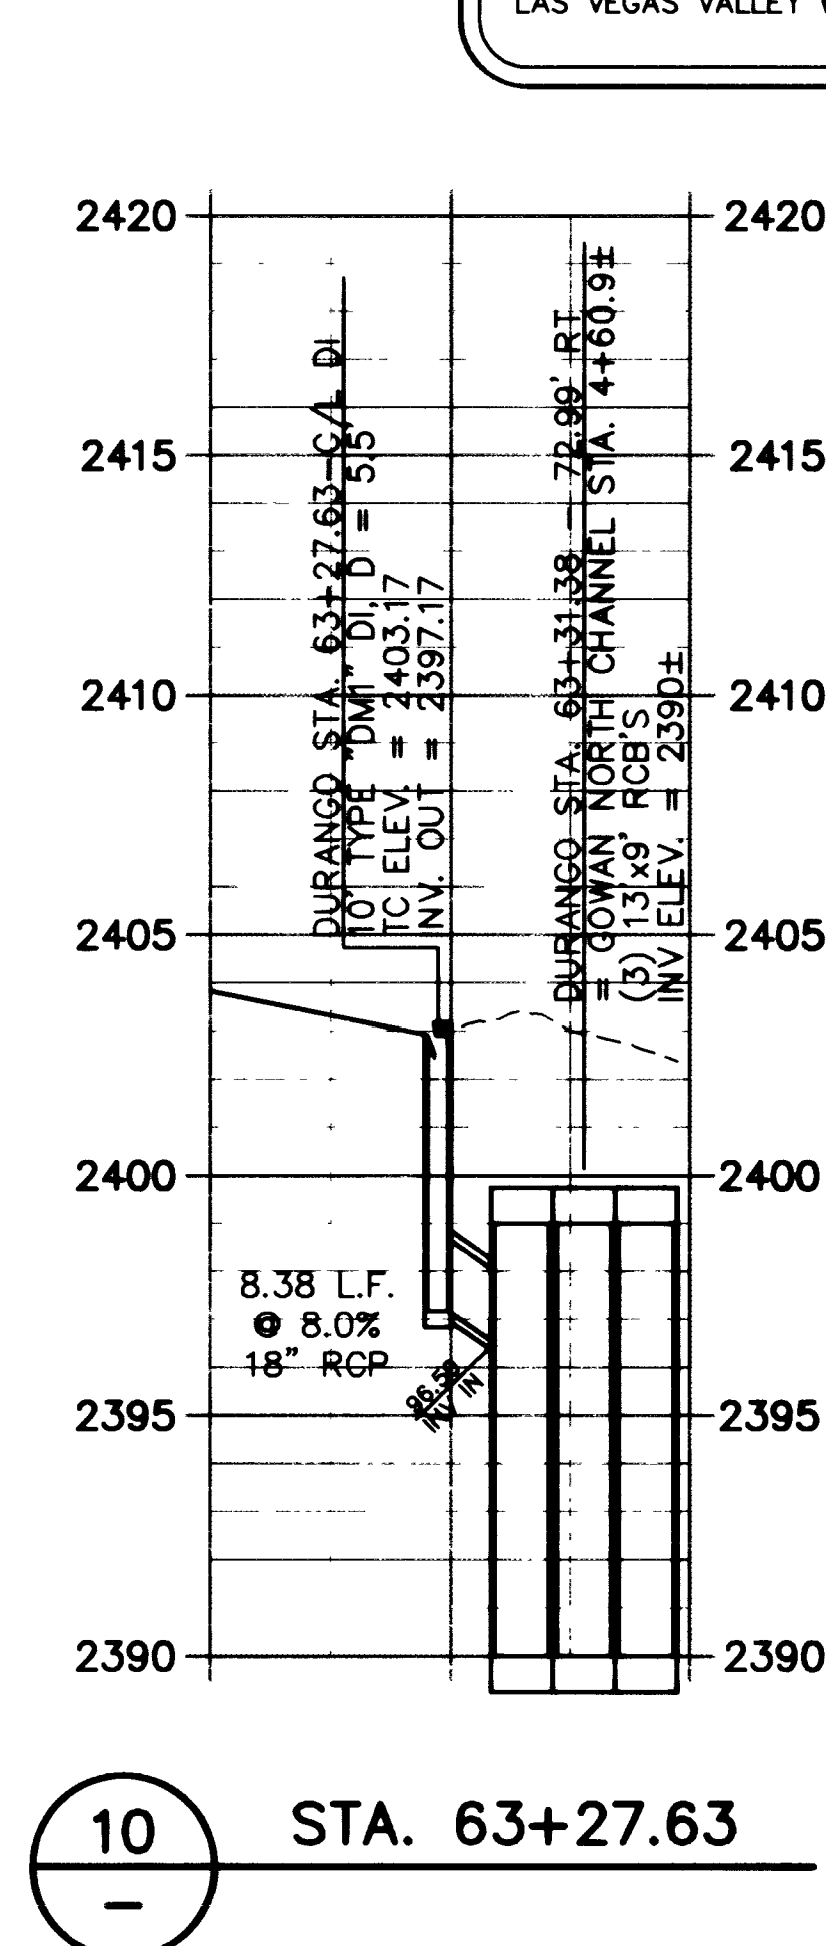

10 STA. 63+27.63

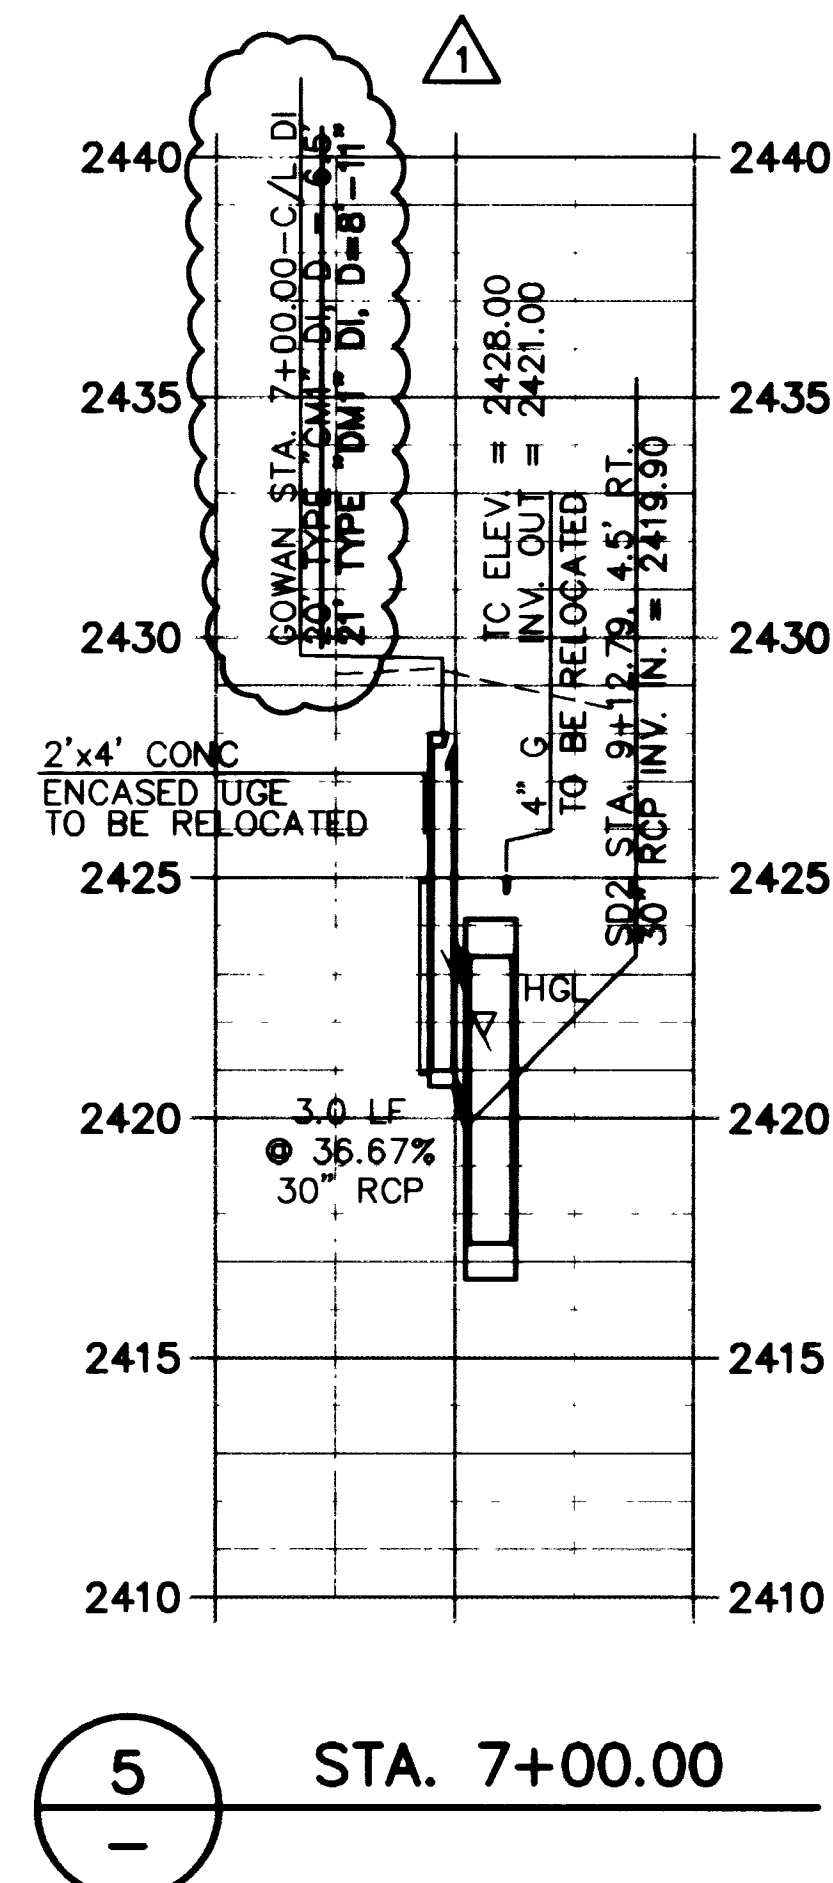

5 STA. 7+00.00

- NOTES:
1. FOR STORM DRAIN SEE SHT. SD4, SD5 AND SD8.
2. ALL RCP IS TO BE CLASS III.

APPROVED

LAS VEGAS VALLEY WATER DISTRICT

DATE

STORM DRAIN LATERAL DETAILS
SD2 STA. 2+00 TO STA. 12+50.00
GOWAN ROAD

DURANGO DRIVE IMPROVEMENTS
CHEYENNE AVENUE TO LONE MOUNTAIN ROAD

WD. NO. 5249
BY JL/WBM
DATE 07/17/98
SCALE HORIZ. 1"=40'
VERT. 1"=4'
DRAWING SD15
SHEET 66 OF 106 SHEETS

DEPARTMENT OF PUBLIC WORKS
CITY OF LAS VEGAS, NEVADA

vtm nevada

CONSULTING ENGINEERS • PLANNERS • LAND SURVEYORS
2727 SOUTH RAINBOW BOULEVARD
LAS VEGAS, NEVADA 89102-5148 PHONE (702) 873-7550 FAX (702) 362-2597

2/12/01 KJO REVISED PER AS-BUILTS

REVISION
DATE BY

RECORD DRAWING 03/23/01