



NEWS, SD3P.LT, SD3P.LT, SD3P.LT
I:\CADD\WORK\5249\5249-LAT.DWG


3-2-51

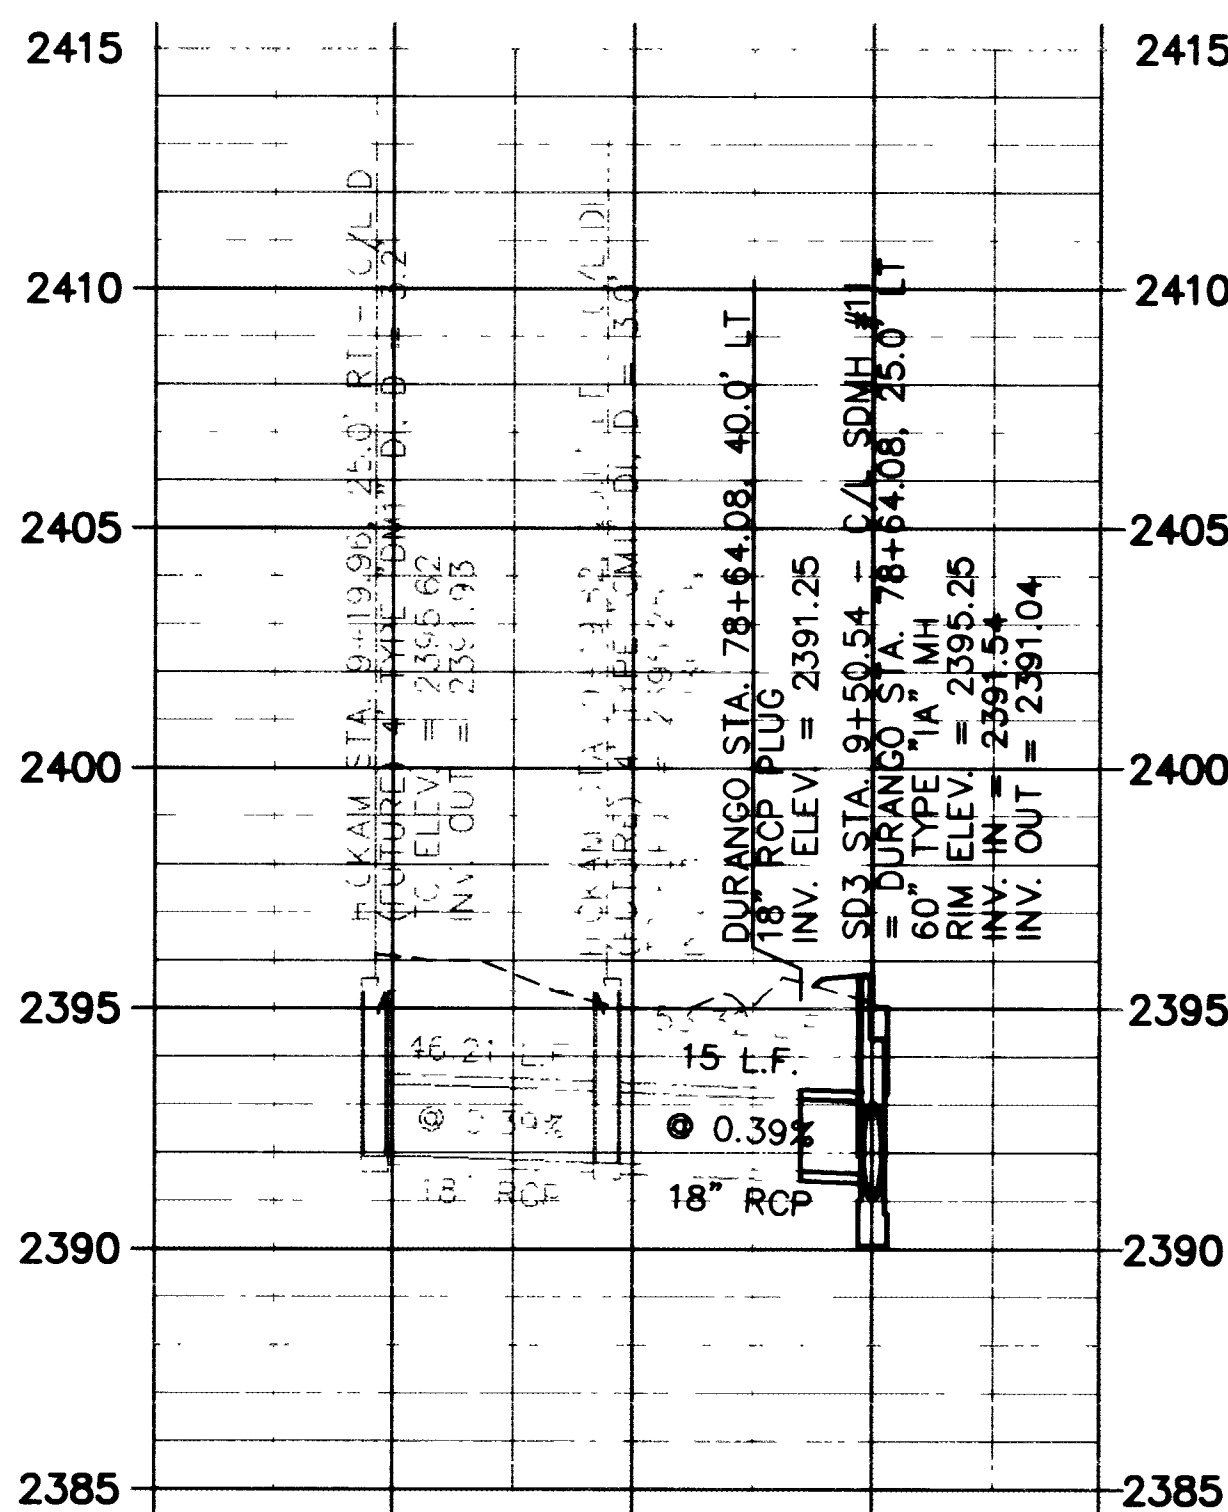


5 STA. 78+64.08

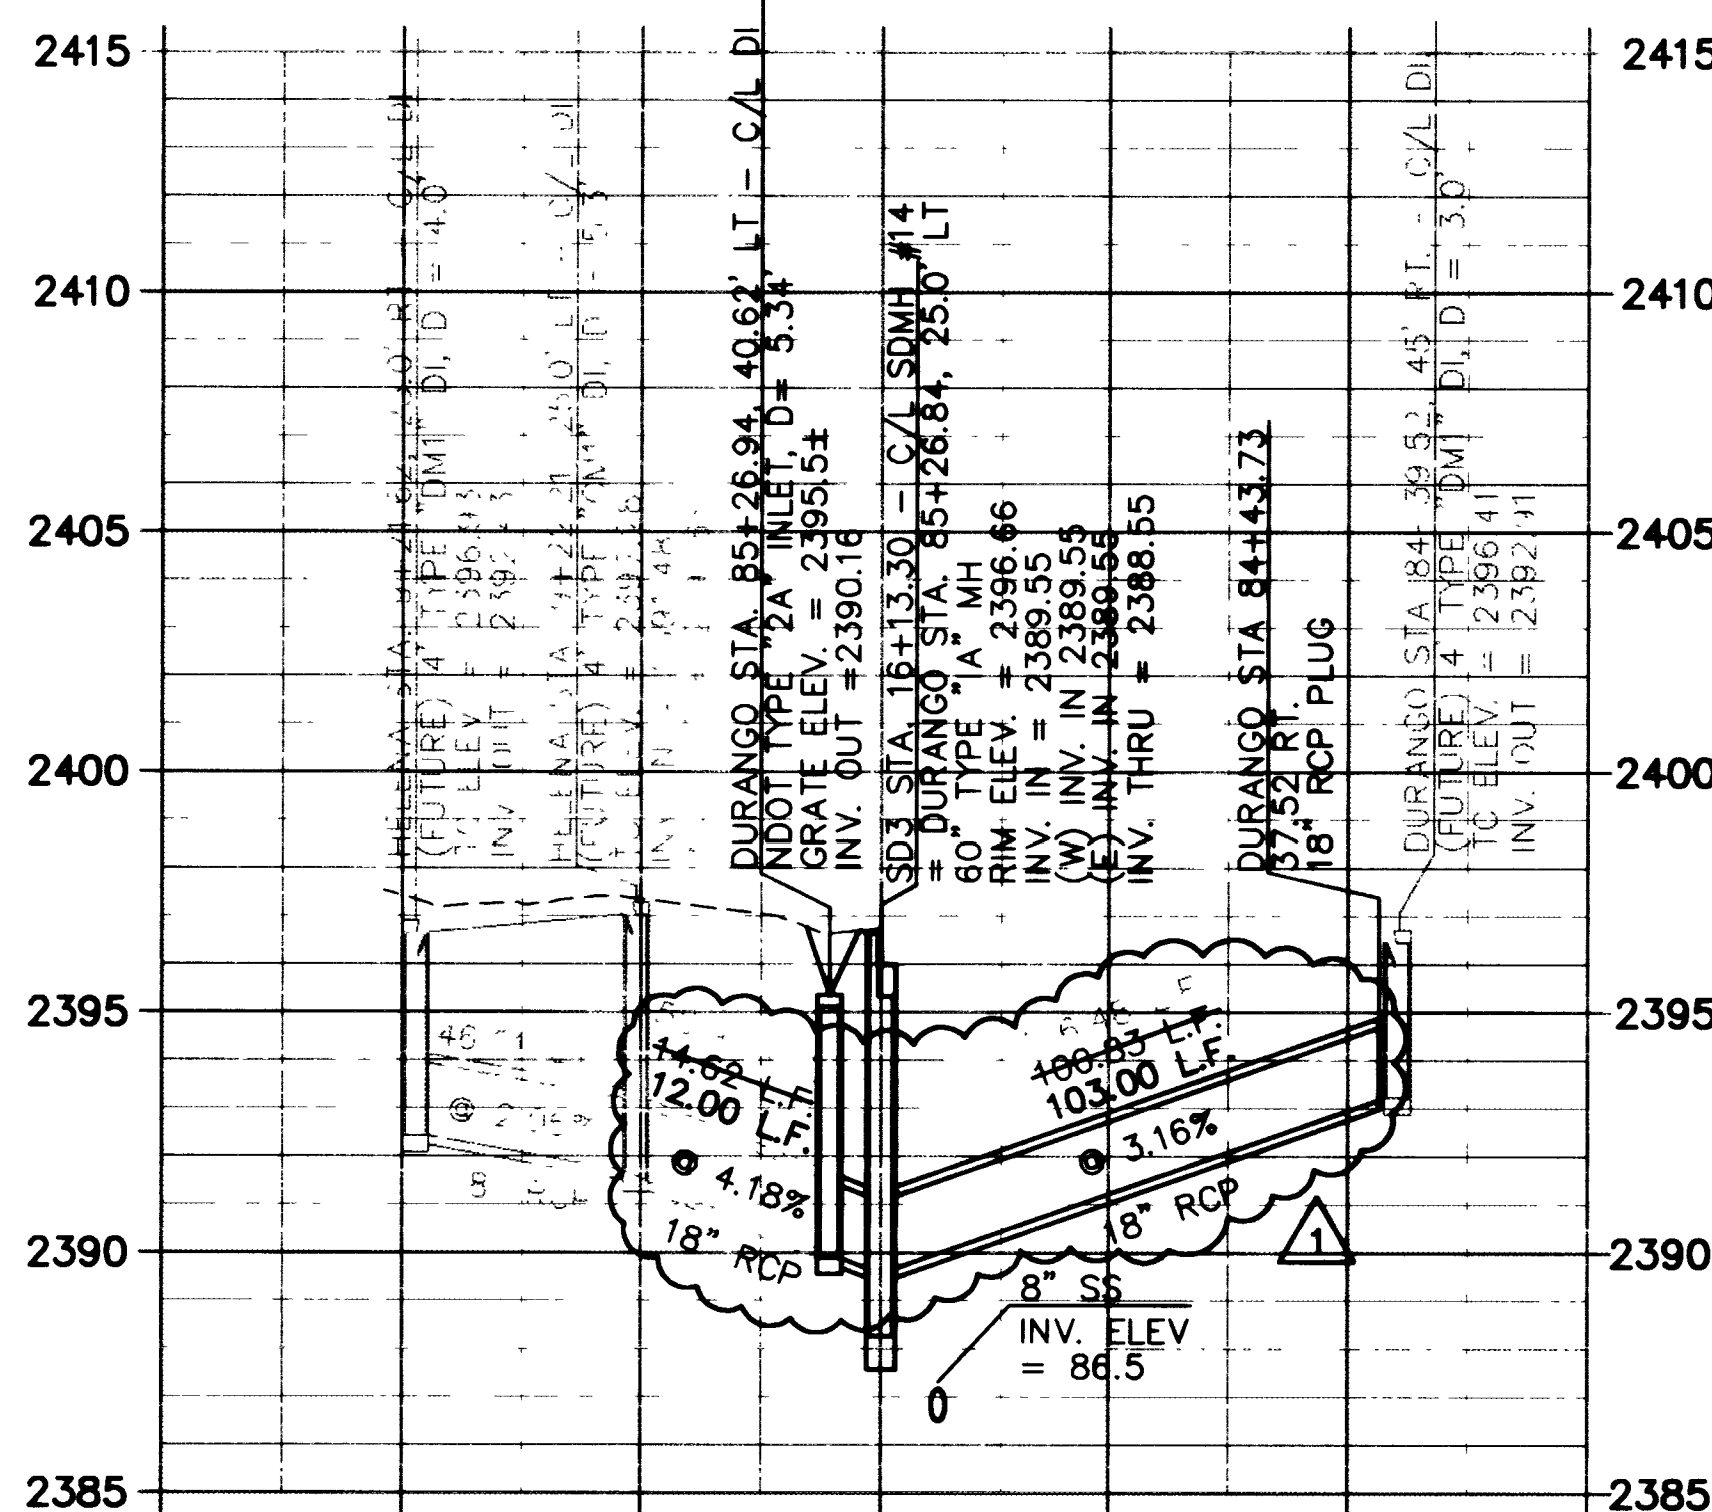


6 STA. 85+26.84

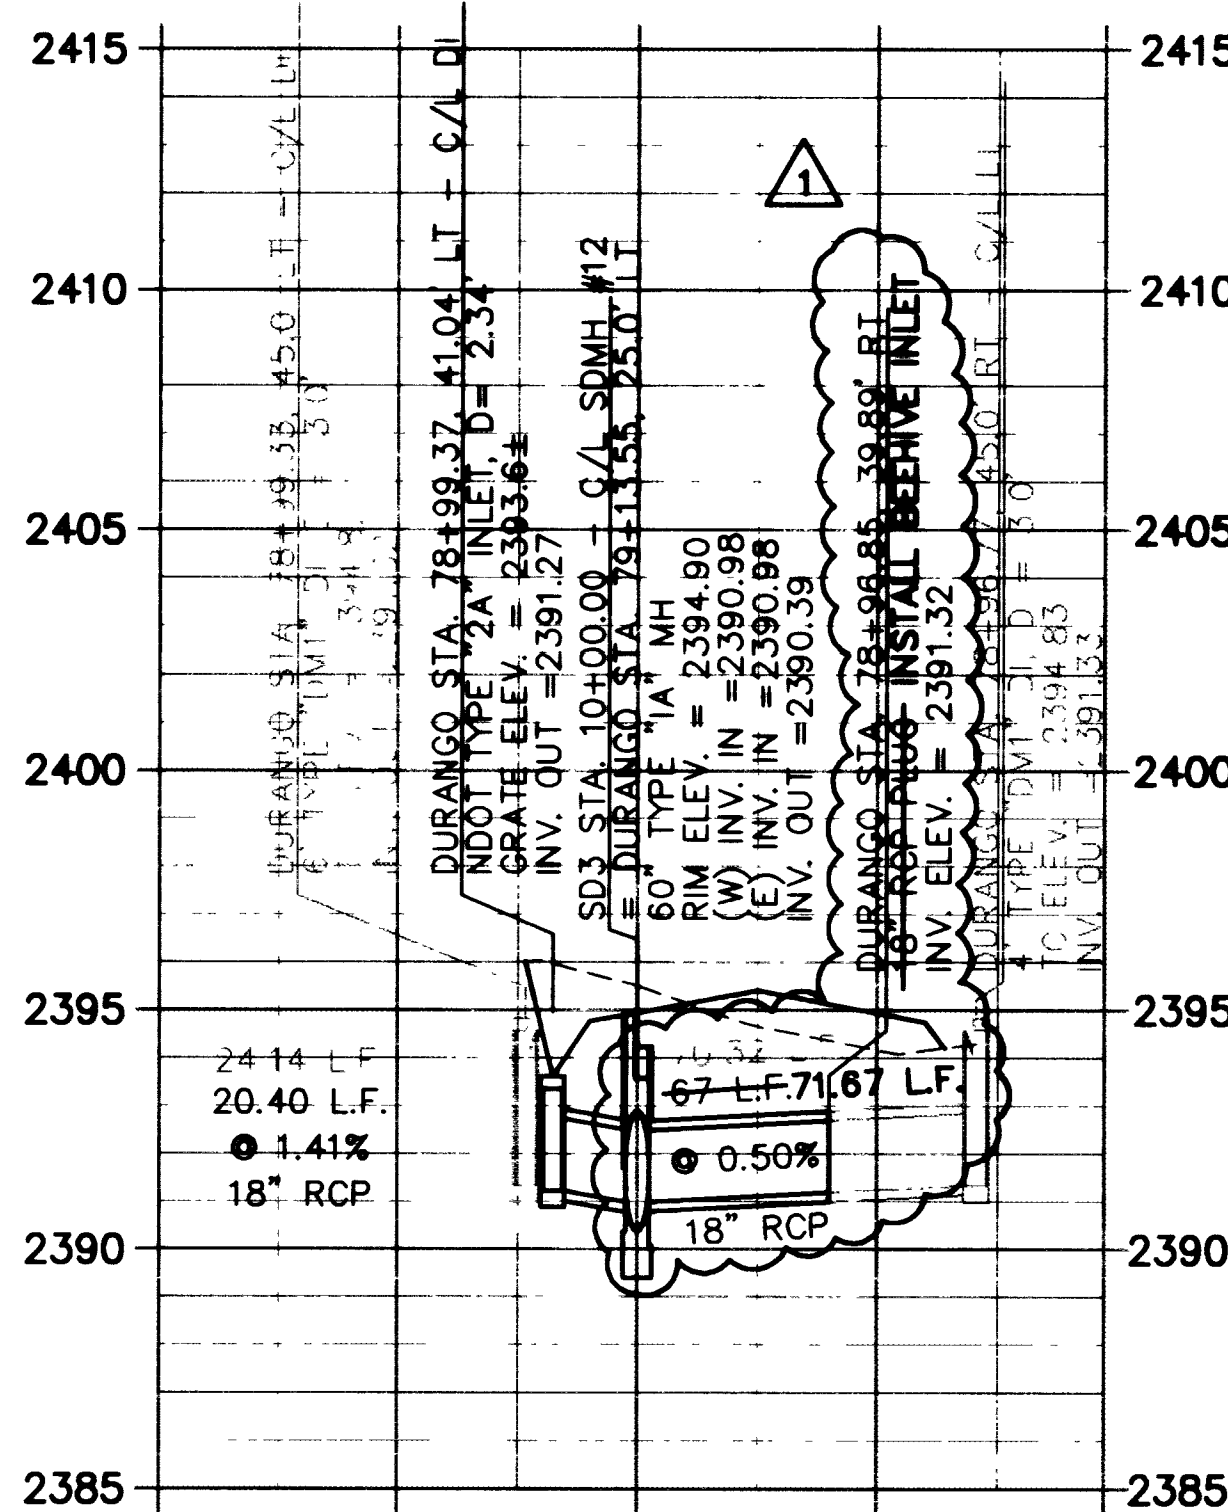


1 STA. 79+13.55

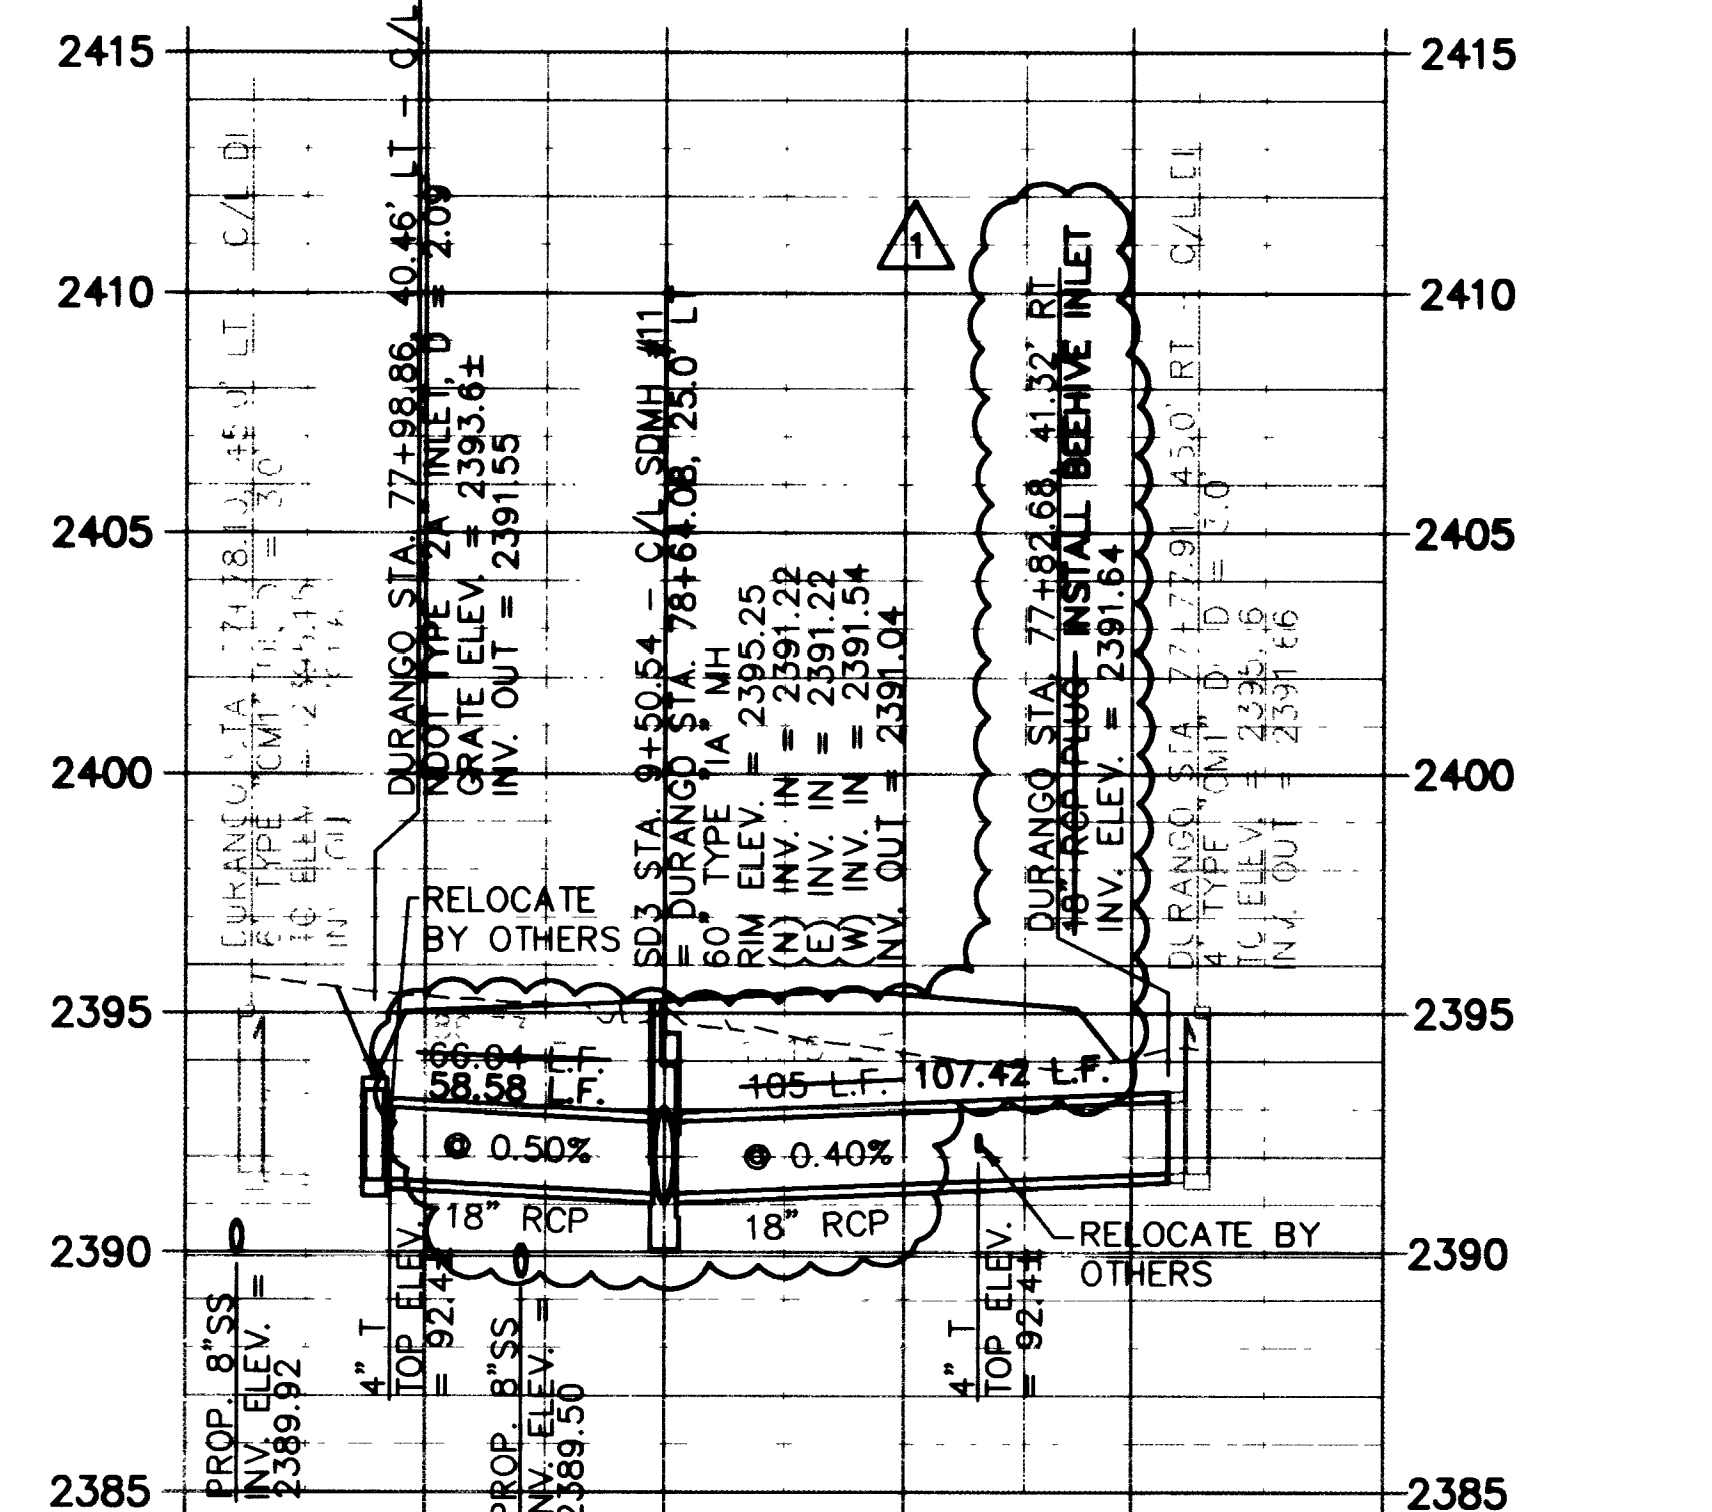


2 STA. 78+64.08

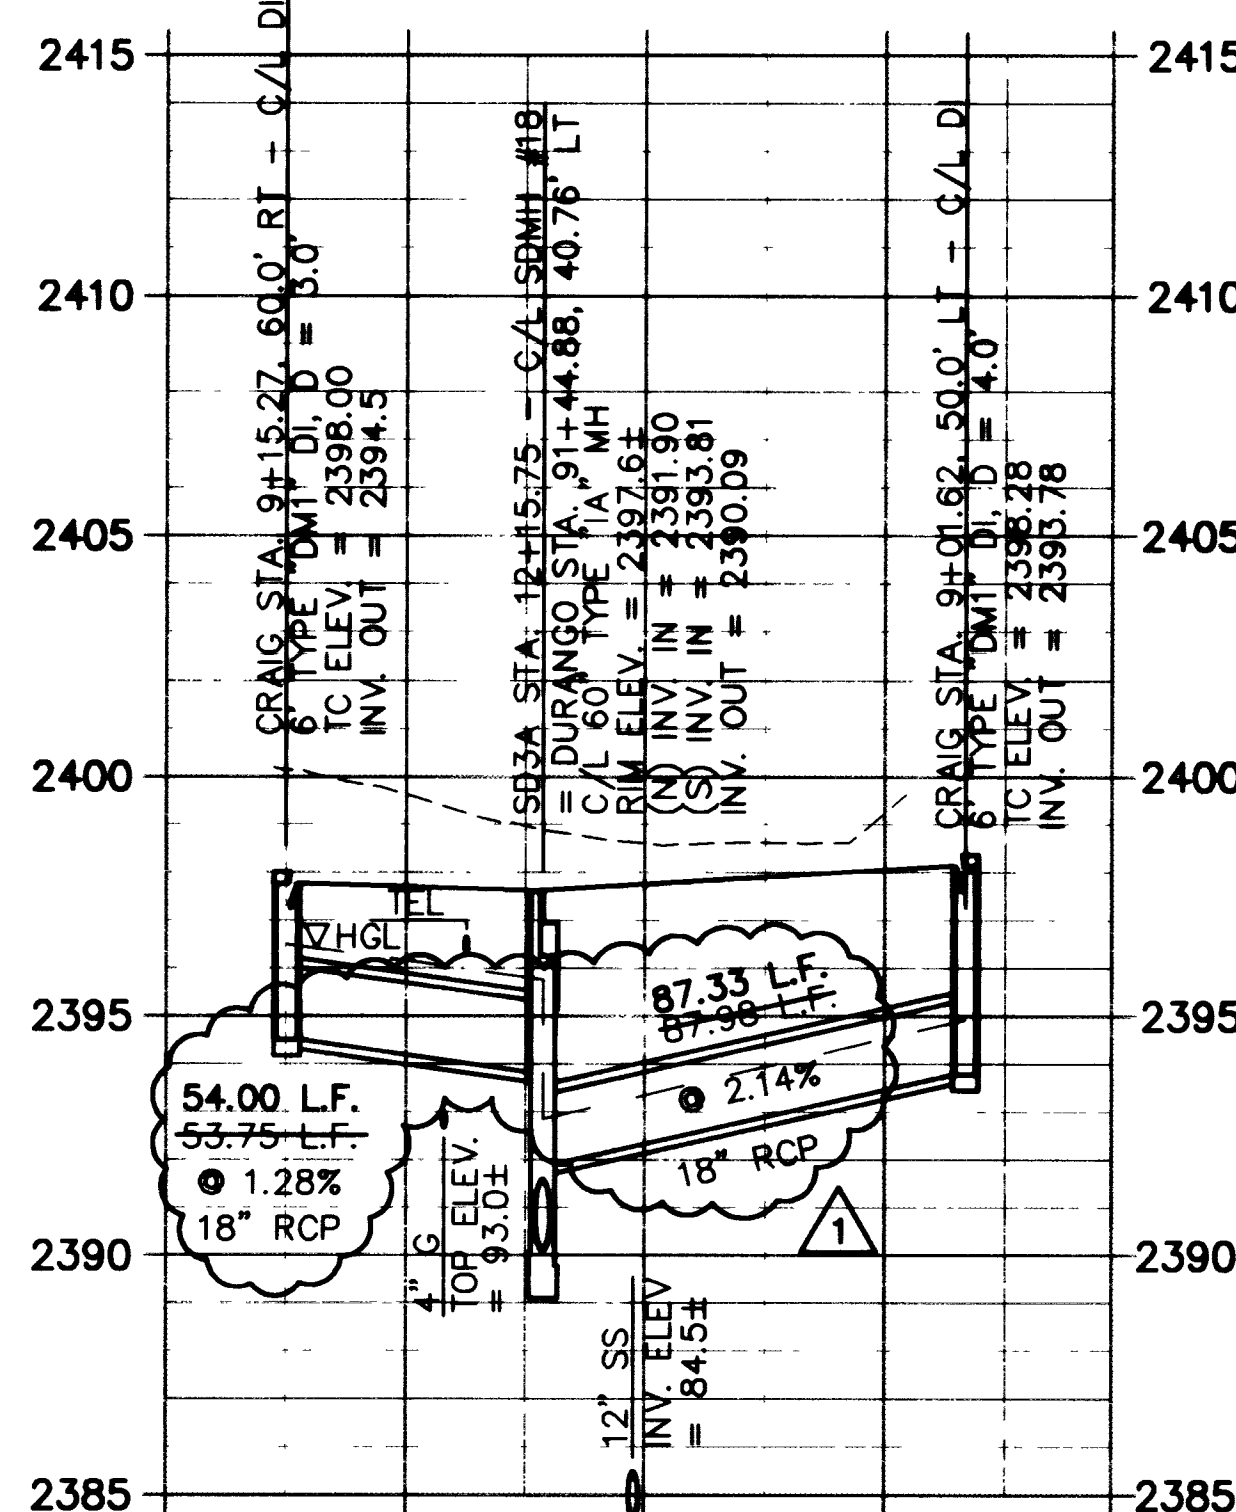


3 STA. 91+44.88

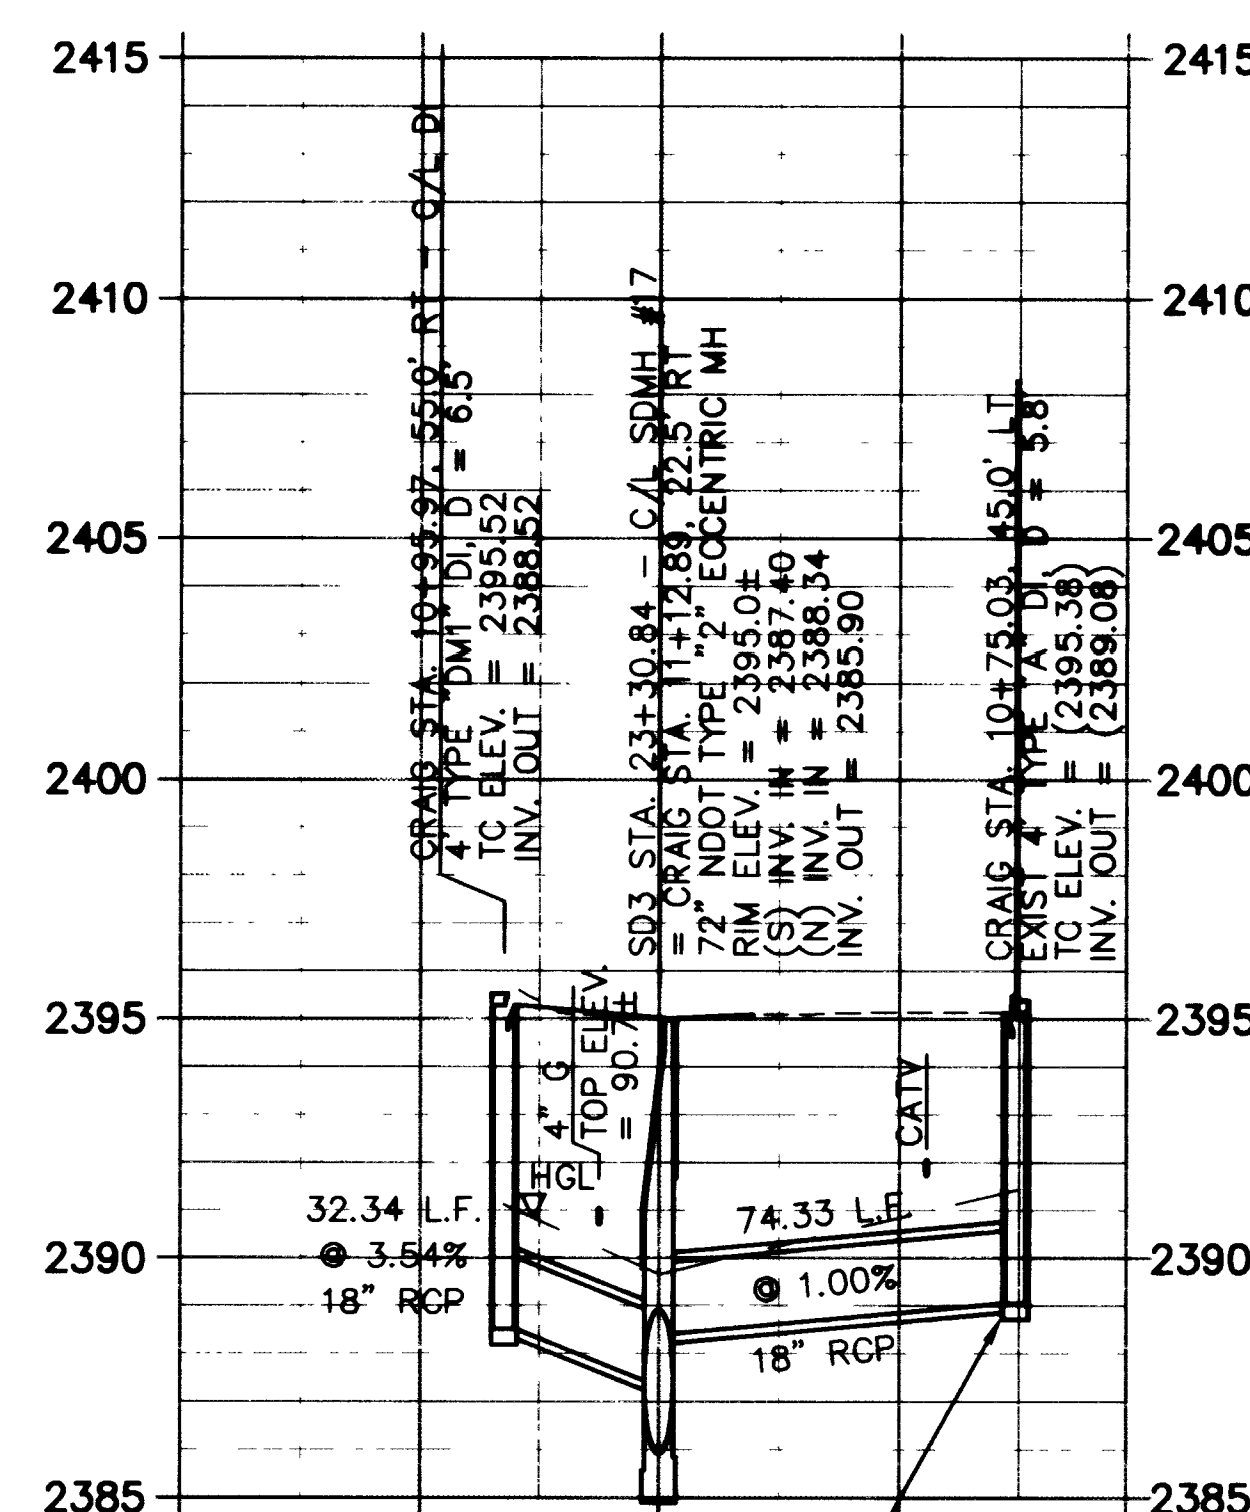


4 CRAIG STA. 11+12.89

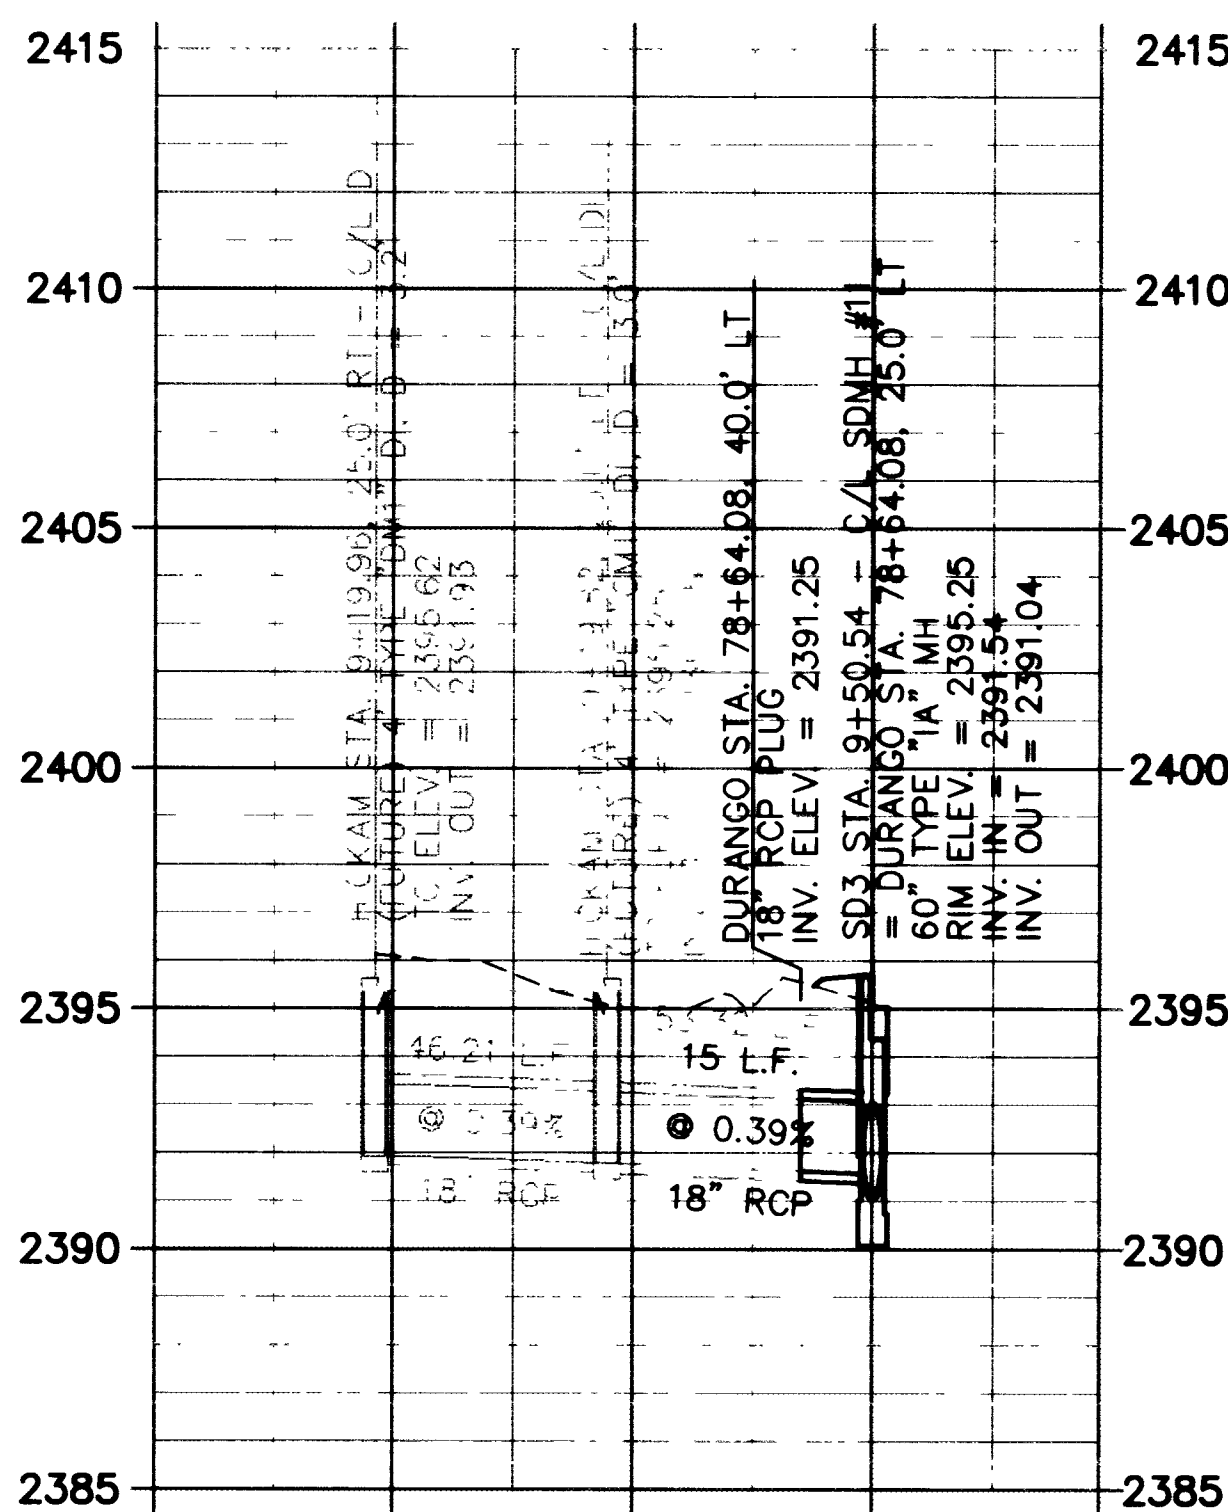

5 STA. 78+64.08

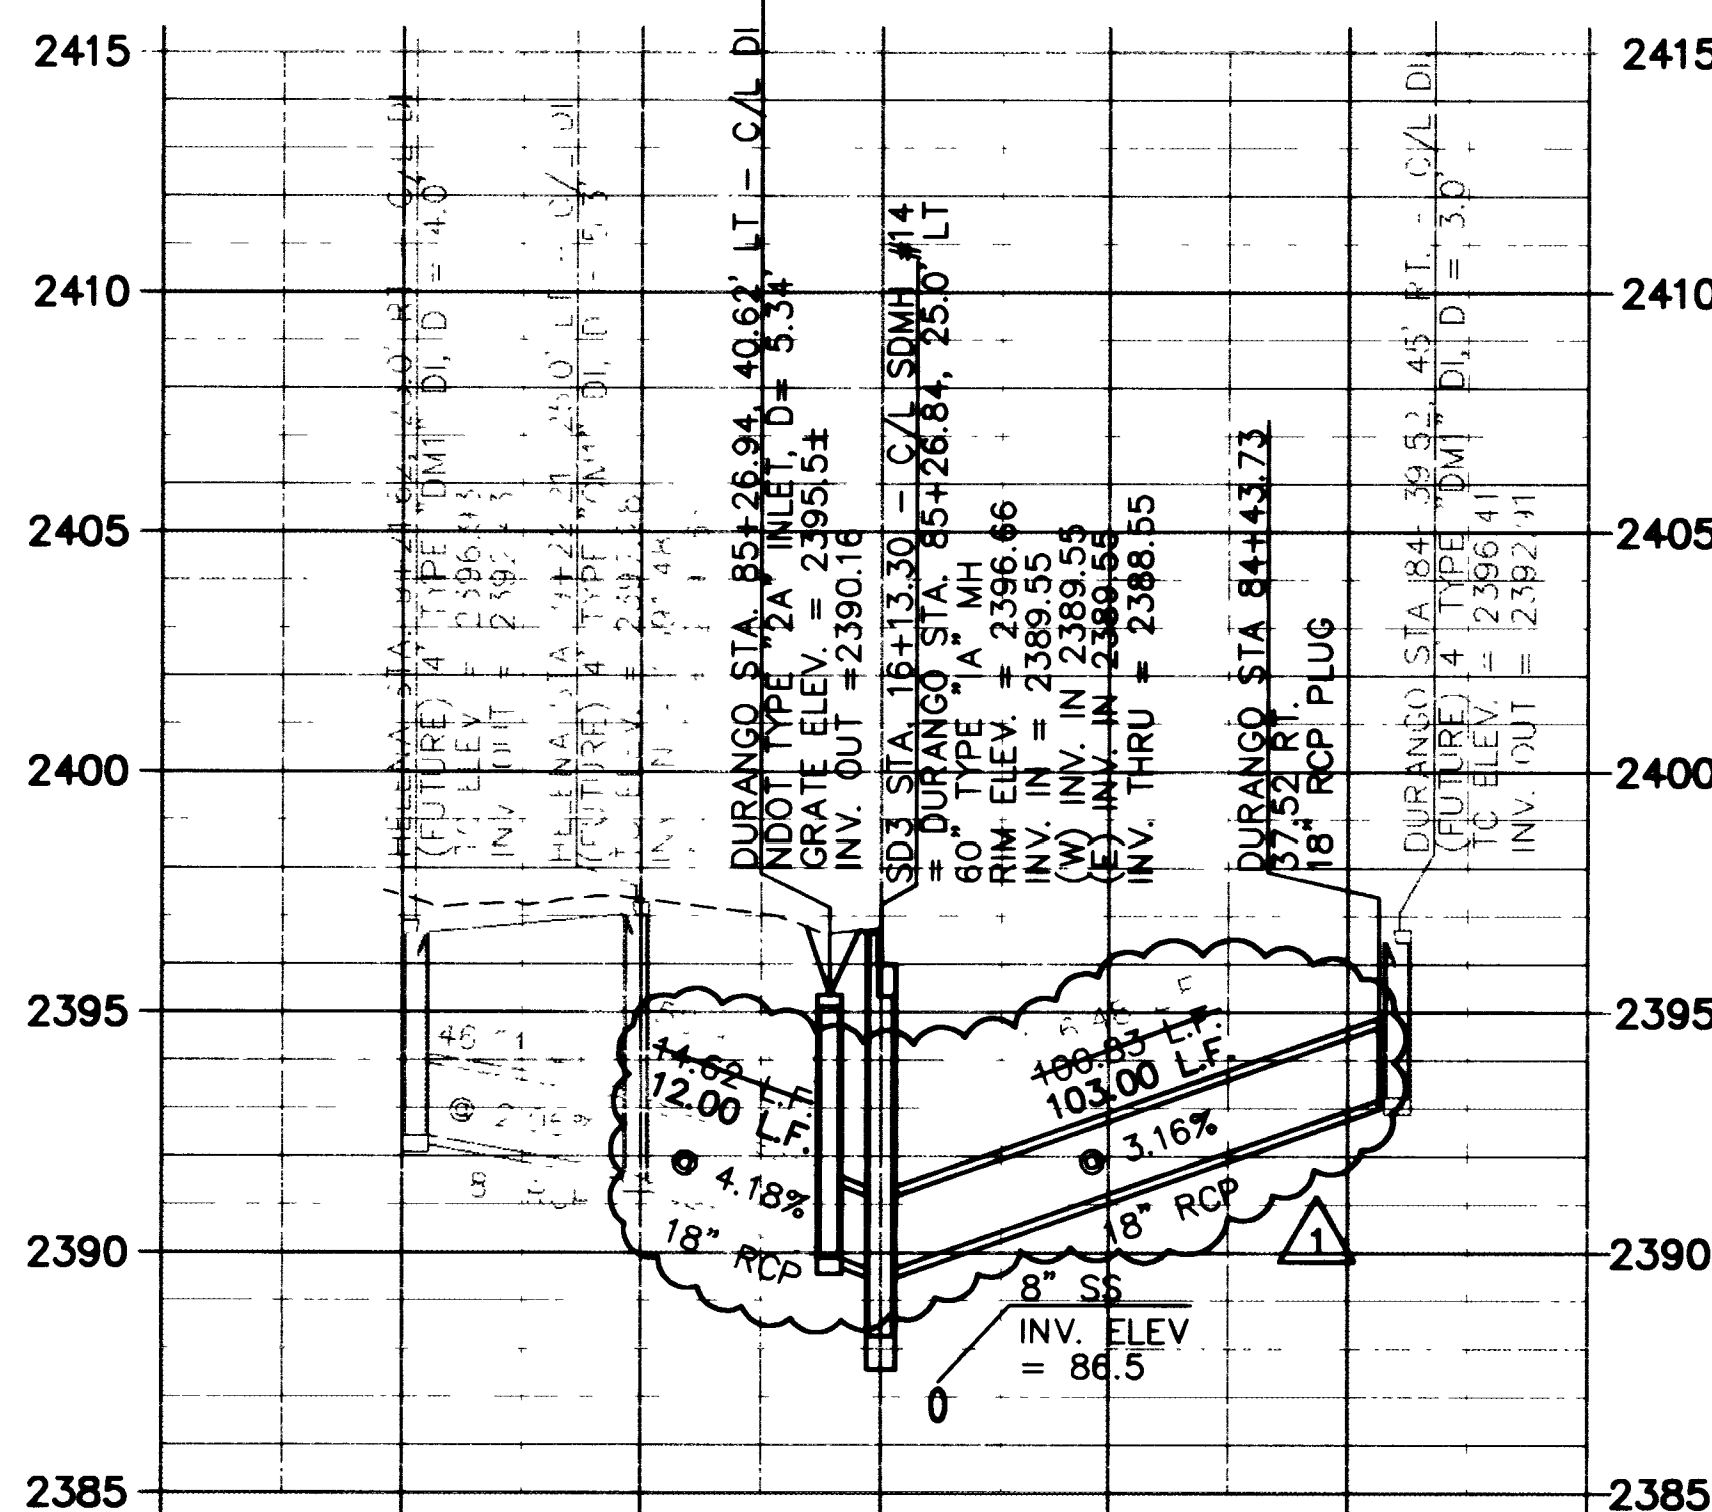

6 STA. 85+26.84

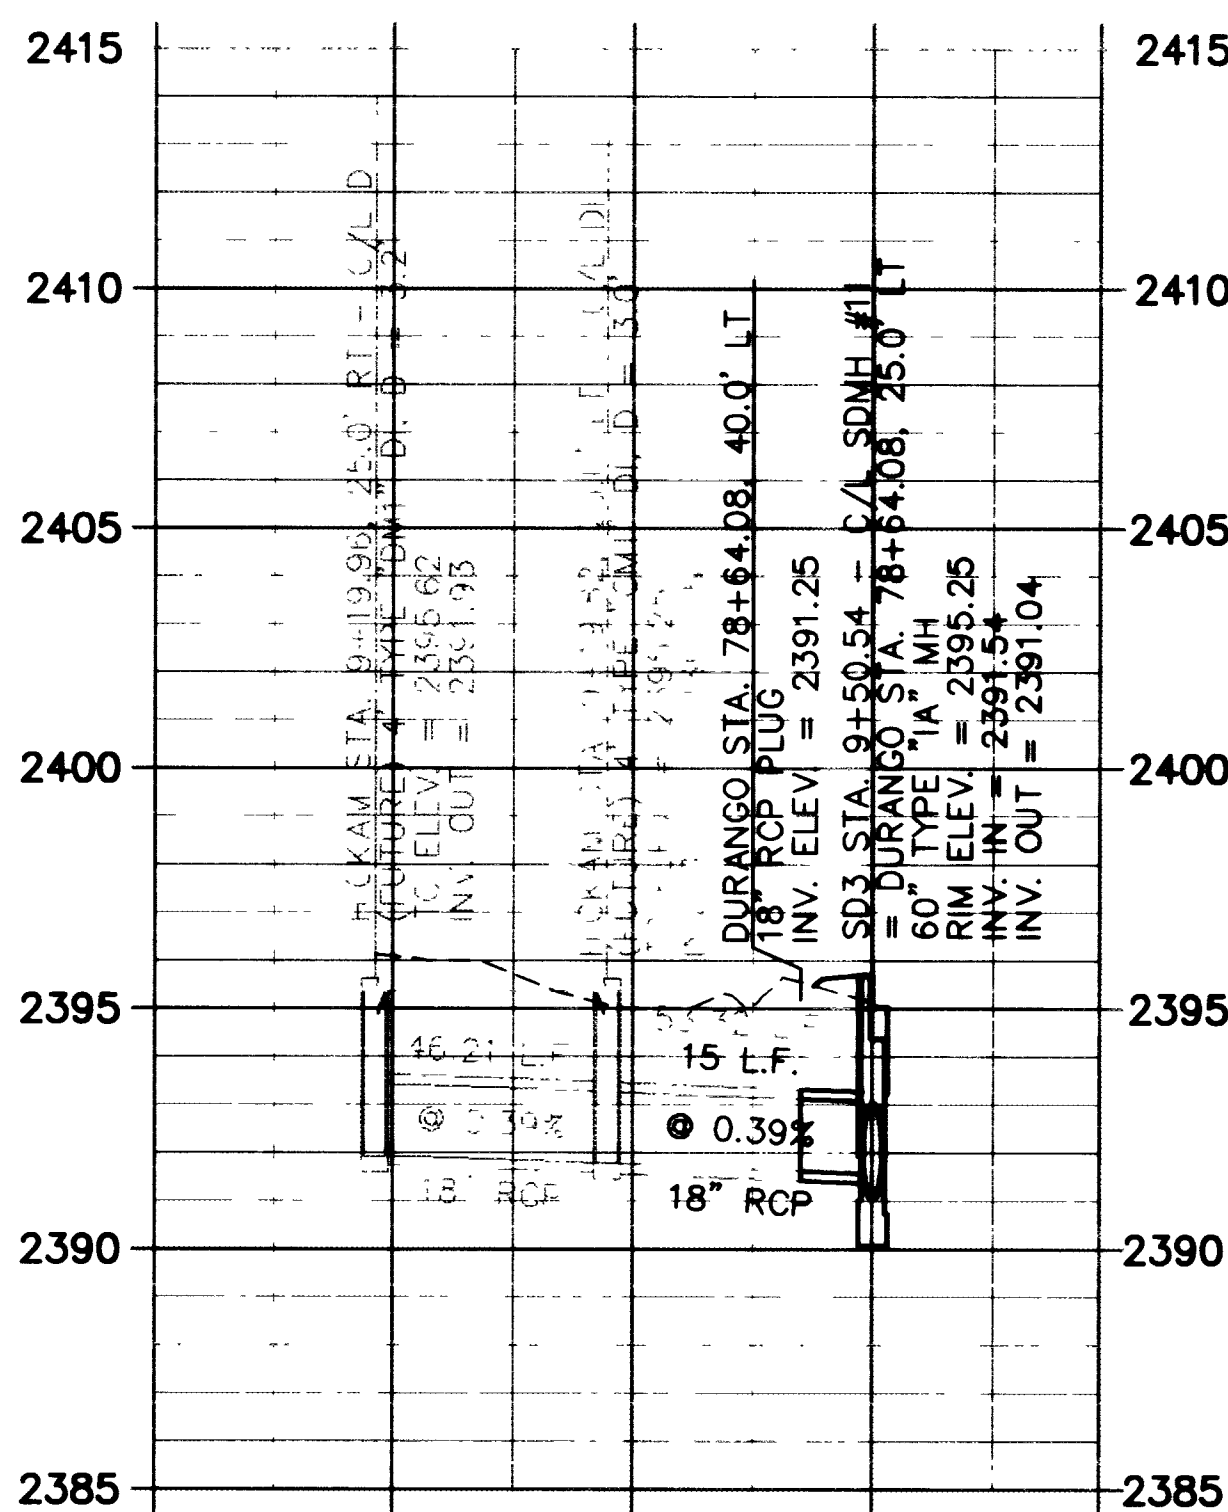

7 STA. 82+06.09

- NOTES:
1. FOR STORM DRAIN SEE SHT. SD9 AND SD10.
 2. ALL RCP IS TO BE CLASS III.

STORM DRAIN LATERAL DETAILS
SD3 STA 9+50.54 TO TEMP DRAIN
DURANGO DRIVE
DURANGO AVENUE TO LONE MOUNTAIN ROAD

WD. NO.	5249
BY	JL/LMW
DATE	07/17/98
SCALE	HORIZ. 1"=40' VERT. 1"=4'
DRAWING	SHEET 67 OF 106
SD16	

DEPARTMENT OF PUBLIC WORKS CITY OF LAS VEGAS, NEVADA	2/12/01 KJD REUSED PER AS-BUILTS	REVISION BY DATE	CONSULTING ENGINEERS • PLANNERS • LAND SURVEYORS 2727 SOUTH RAINBOW BOULEVARD LAS VEGAS, NEVADA 89102-5148 PHONE (702) 873-7550 FAX (702) 362-2597
---	--	------------------------	--

