
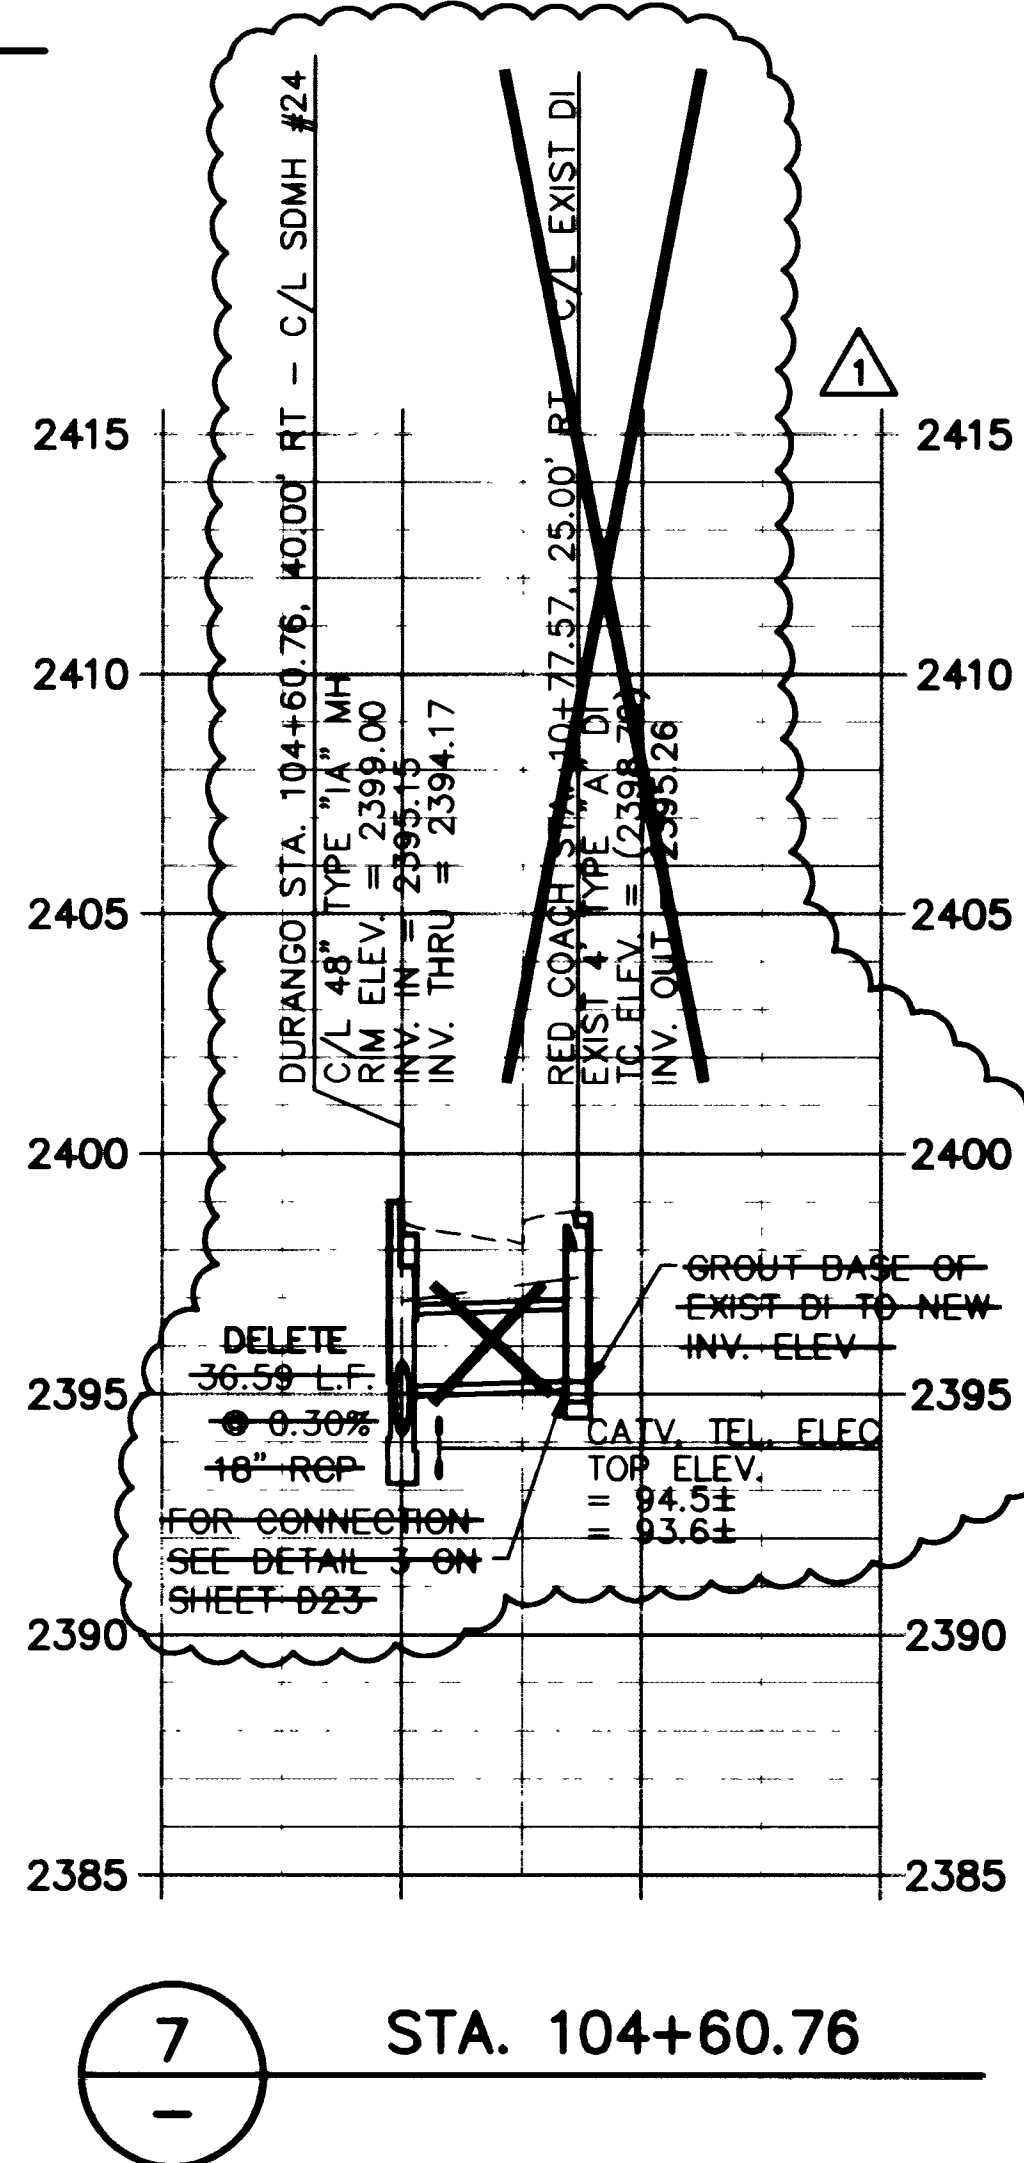
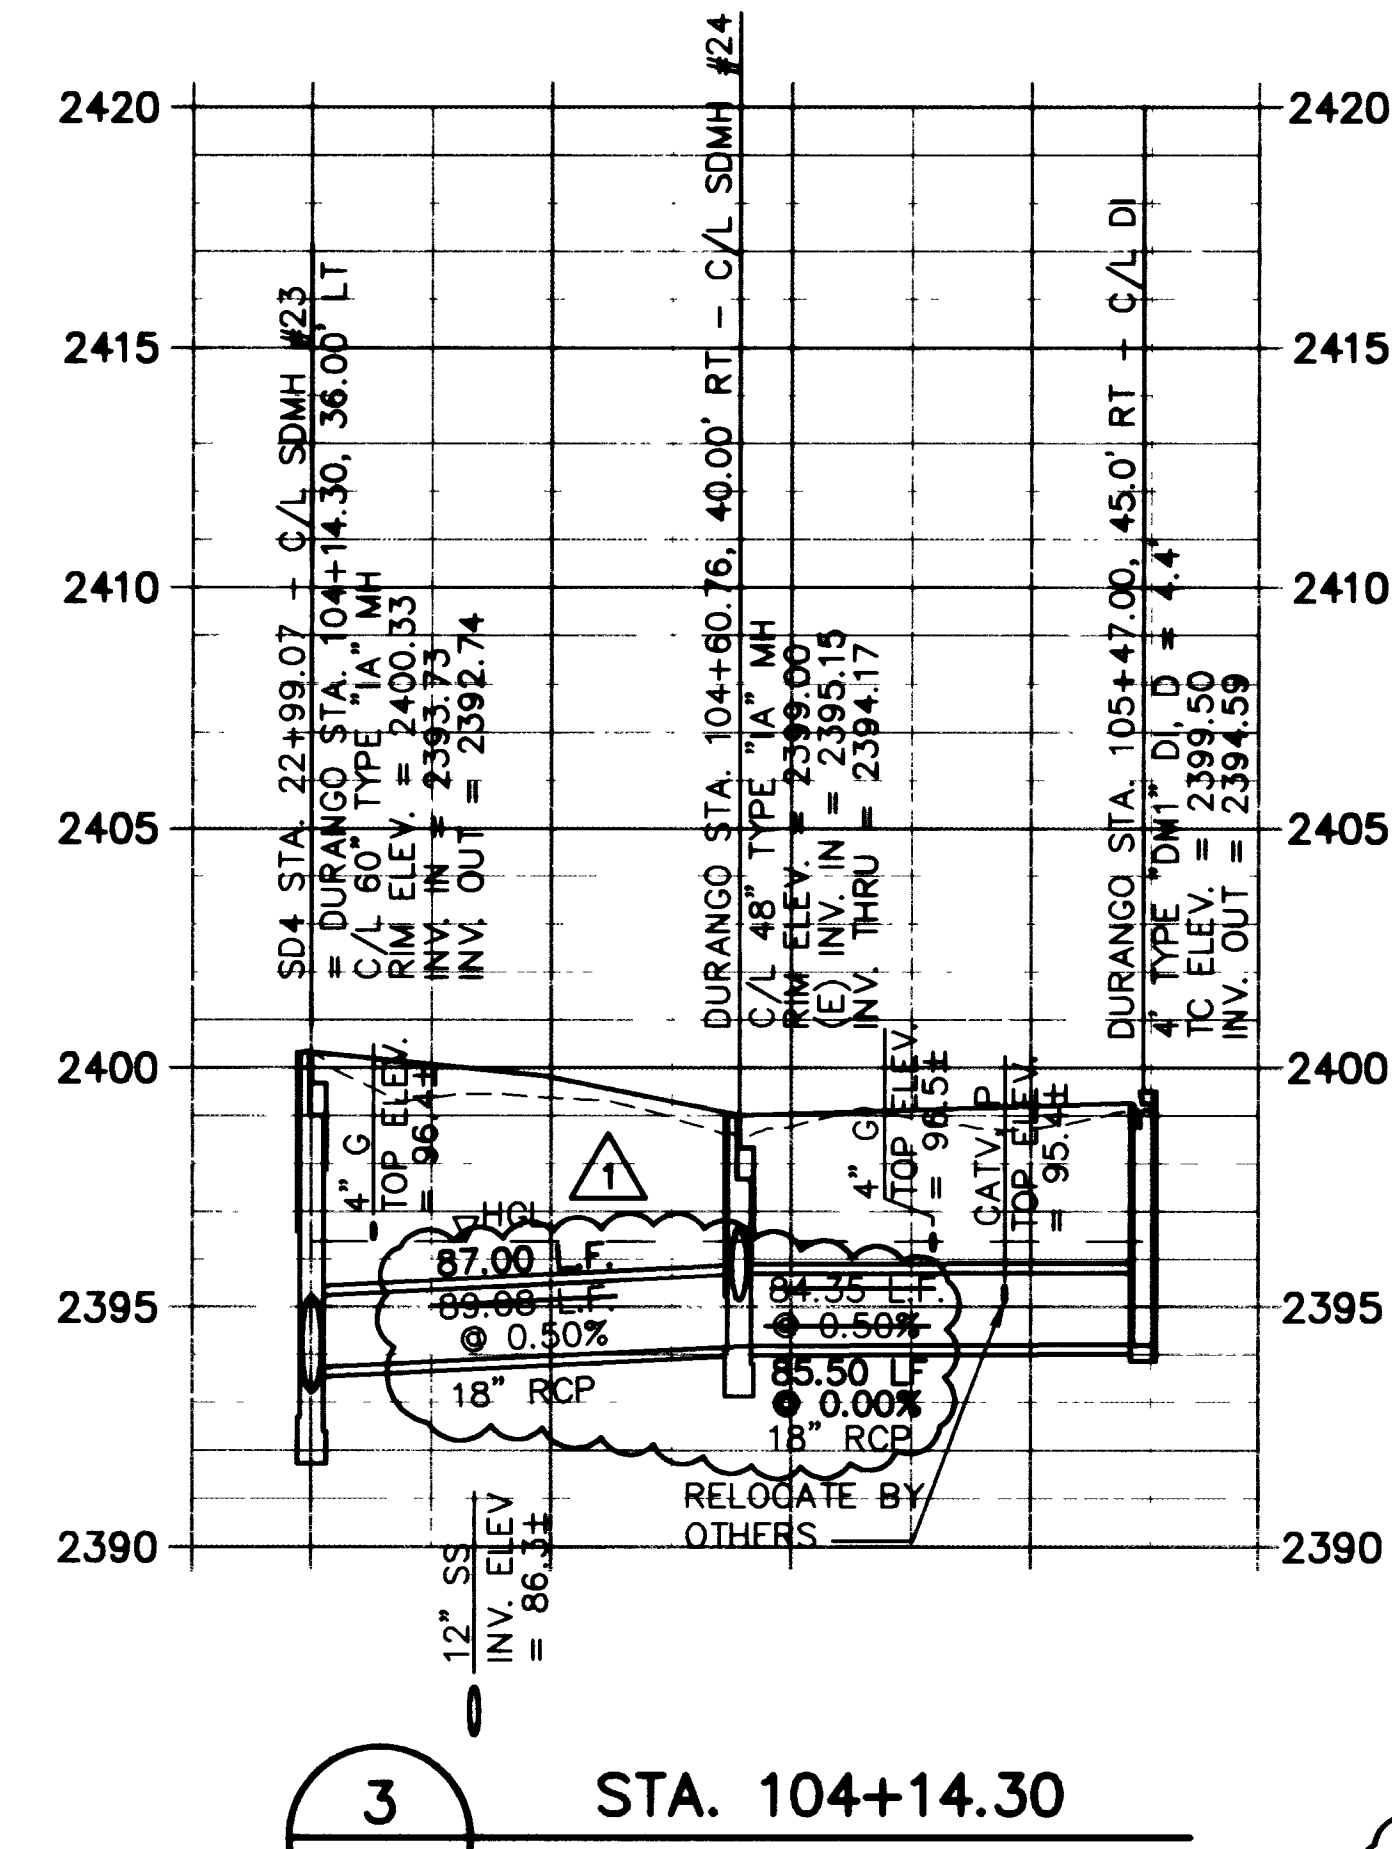
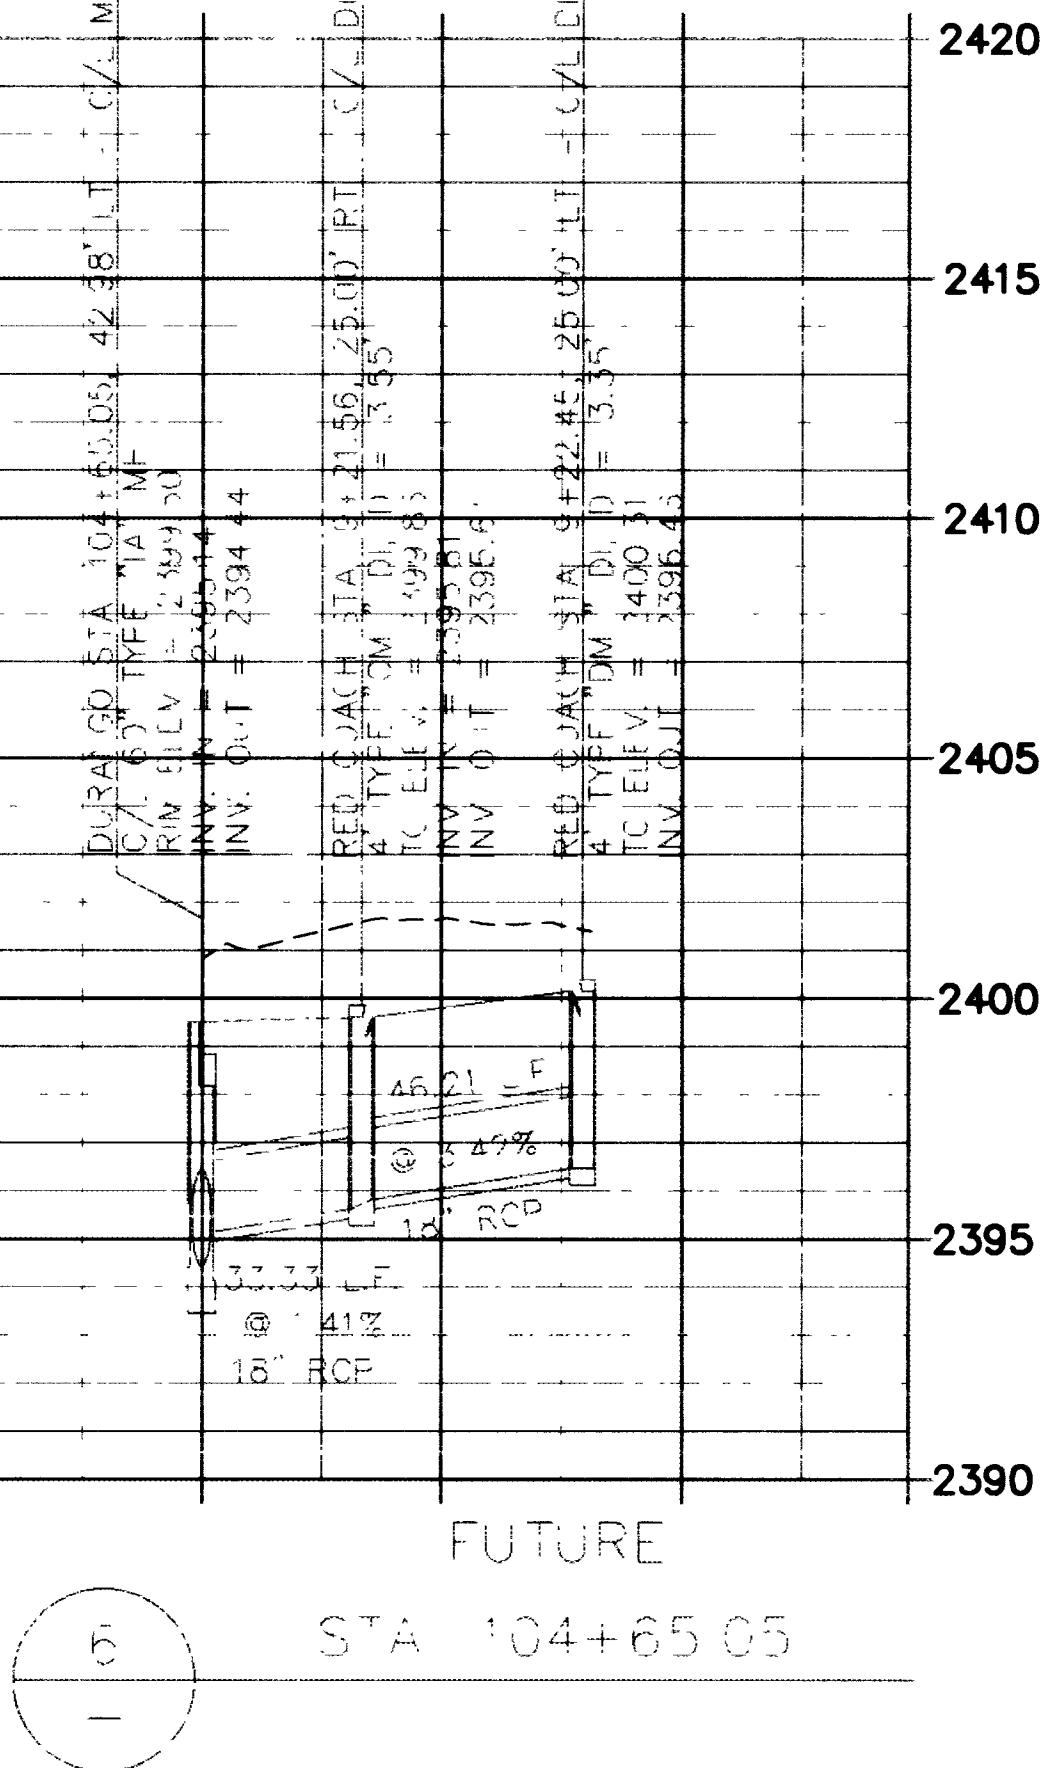
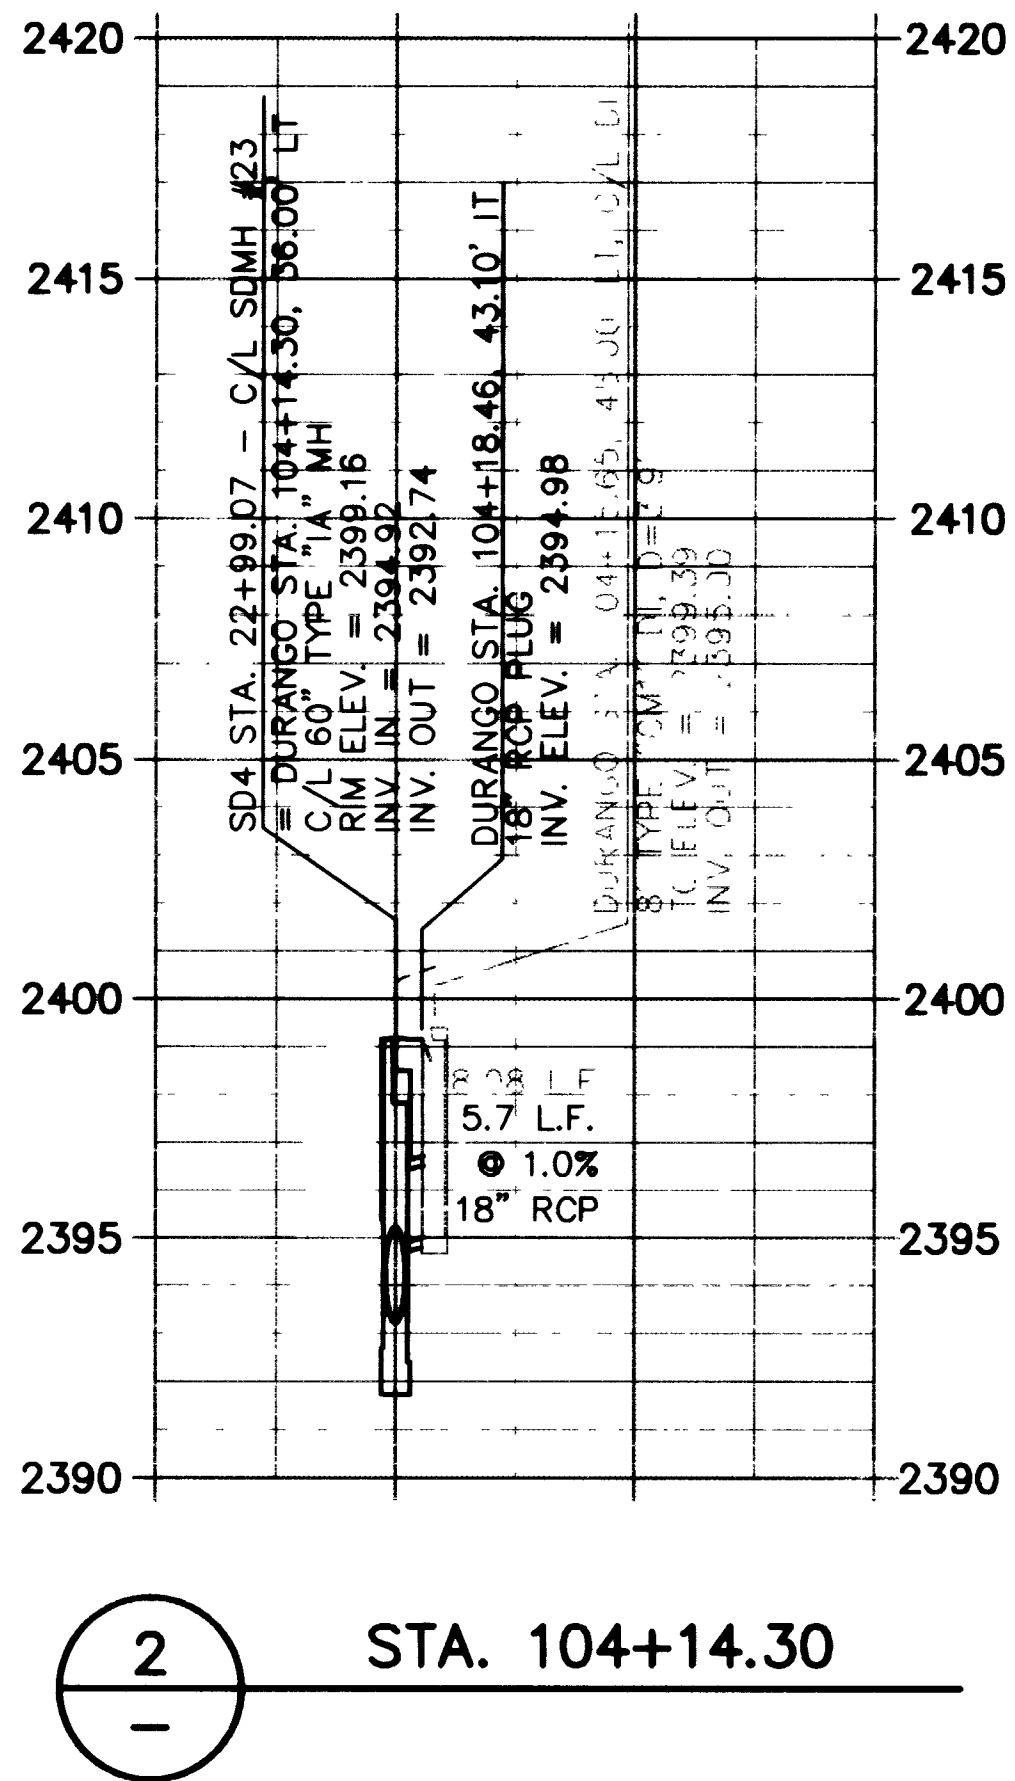
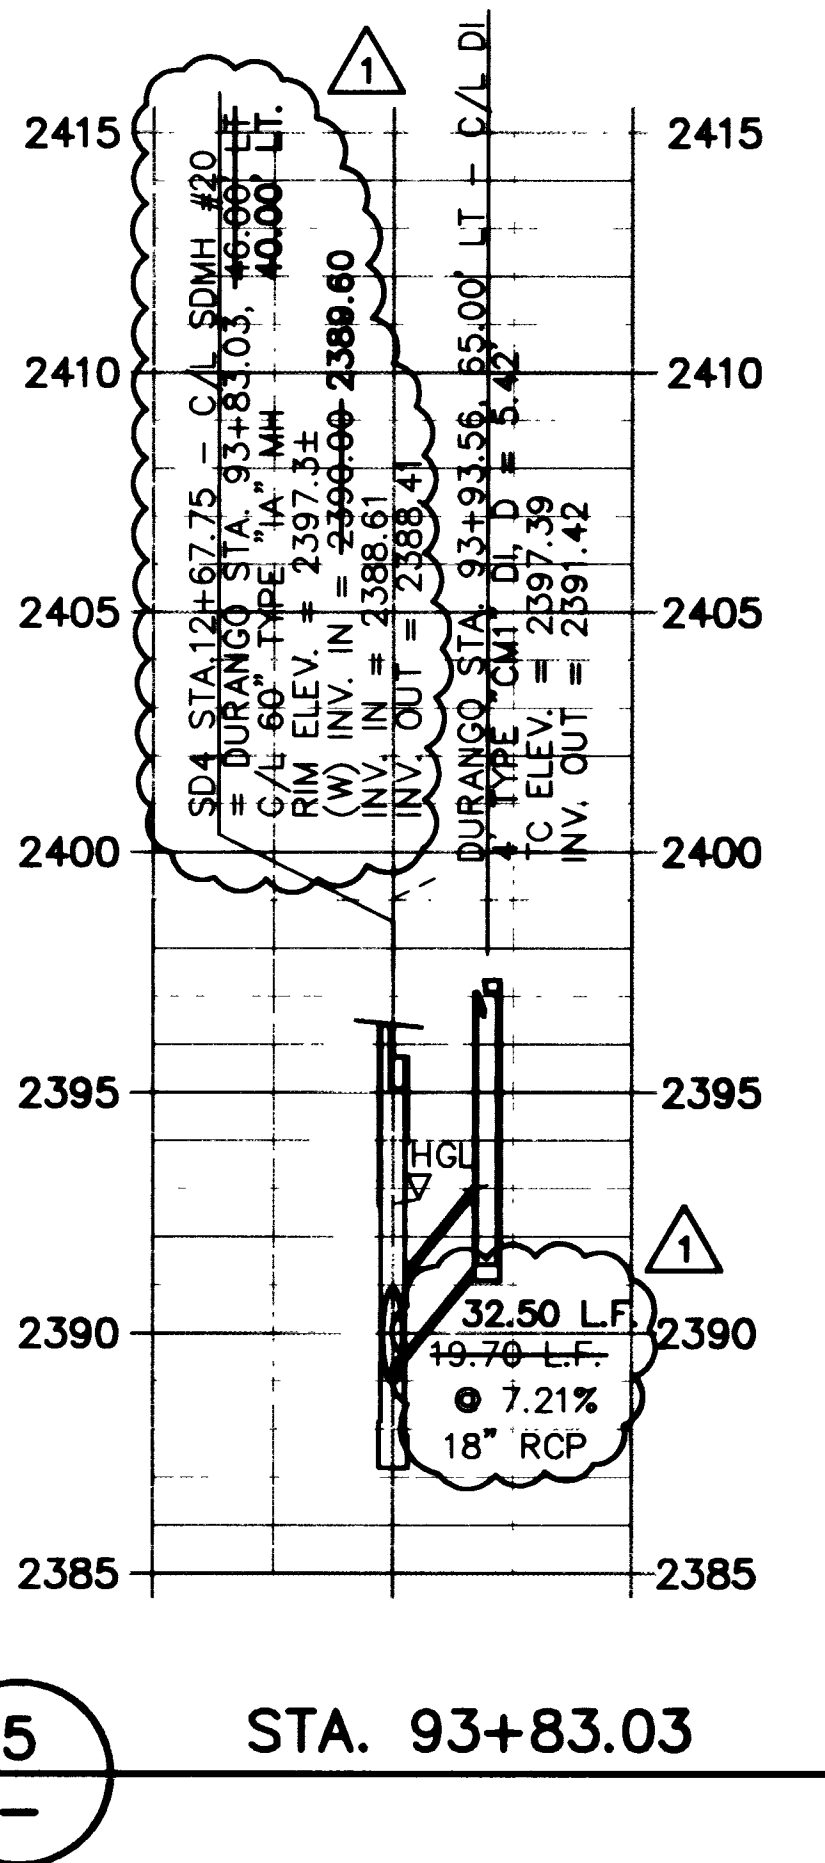
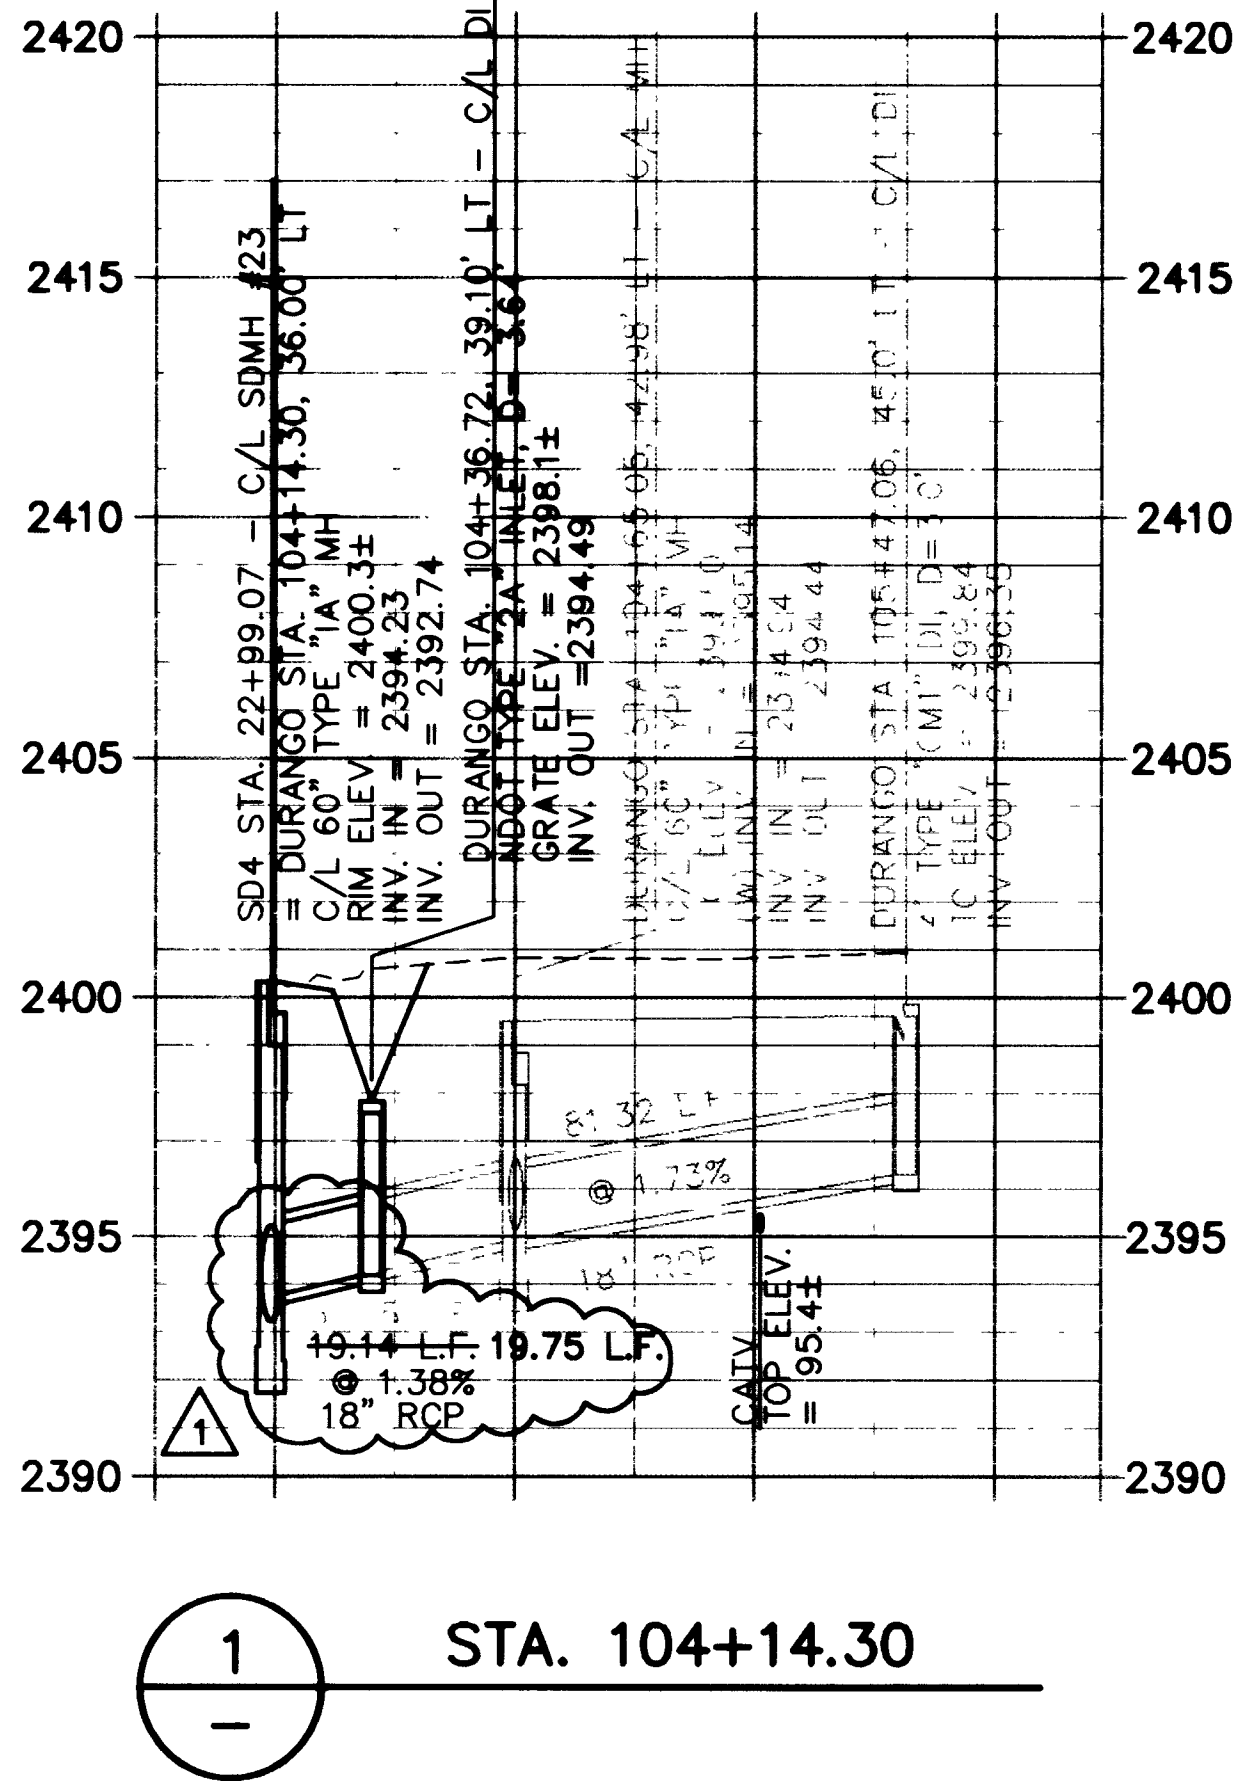


VDWS: SD12PLT, SD13PLT, SD14PLT
E:\CAD\DWG\0323\0323-01.DWG

32252

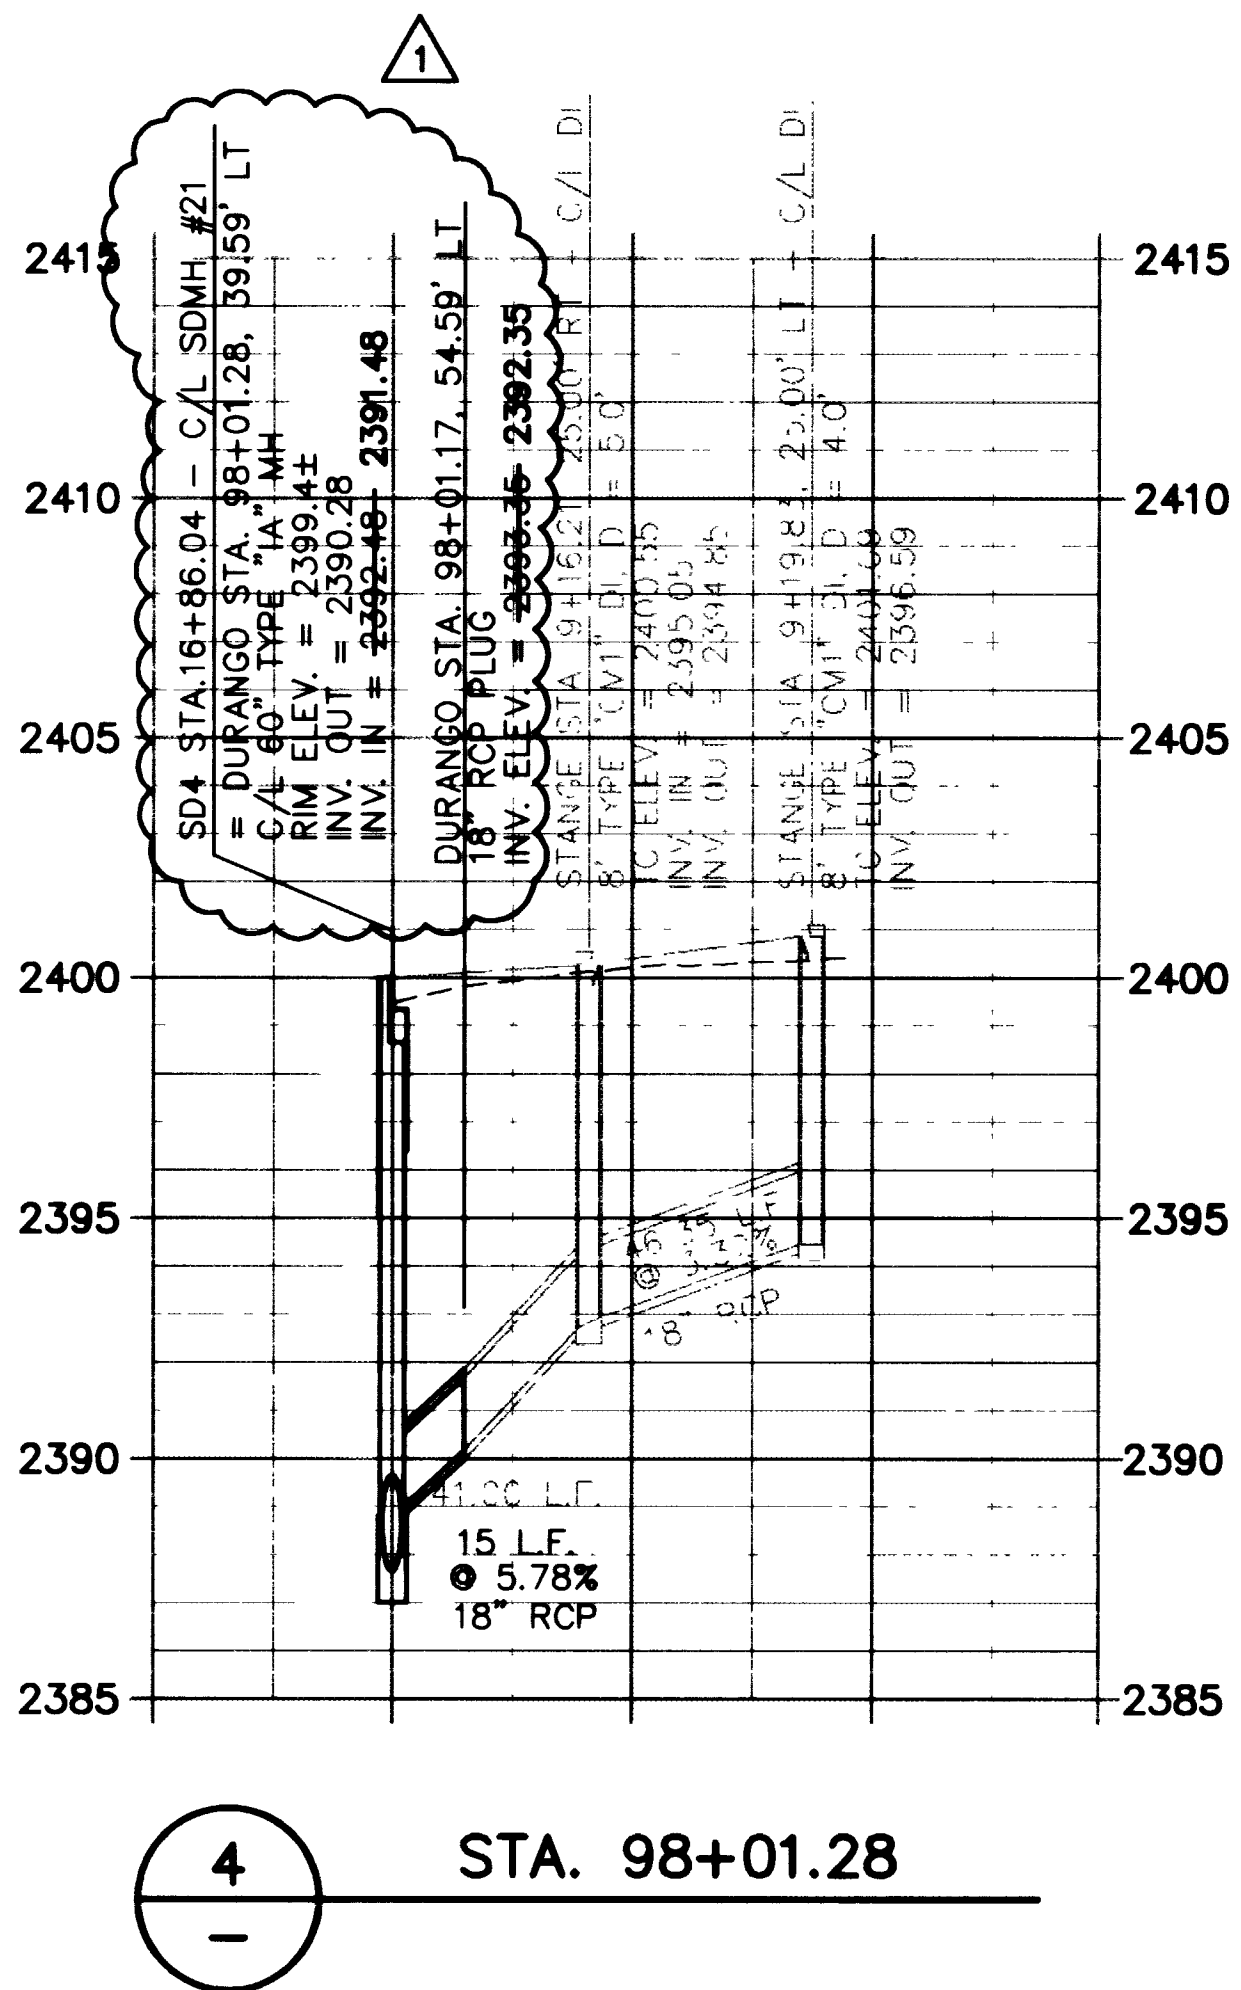

- NOTES:
1. FOR STORM DRAIN SEE SHT. SD11 AND SD12.
 2. ALL RCP IS TO BE CLASS III.

STORM DRAIN LATERAL DETAILS	
SD4 STA. 9+97.57 TO STA. 22+99.07	
DURANGO DRIVE	
DURANGO DRIVE IMPROVEMENTS	
CHEYENNE AVENUE TO LONE MOUNTAIN ROAD	
PROJECT	
SEAL	
WO. NO.	5249
BY	JL/LMW
DATE	07/17/98
SCALE	HORIZ. 1"=40' VERT. 1"=4'
DRAWING	SHEET
SD17	68
106 SHEETS	

DEPARTMENT OF PUBLIC WORKS
CITY OF LAS VEGAS, NEVADA



CONSULTING ENGINEERS • PLANNERS • LAND SURVEYORS
2727 SOUTH RAINBOW BOULEVARD
LAS VEGAS, NEVADA 89102-5148 PHONE (702) 873-7550 FAX (702) 362-2597

REV	DATE	BY	REVISION
1	2/12/01	KJO	REVISED PER AS-BUILTS