


SEE SHEET 1-3 FOR CONTINUATION

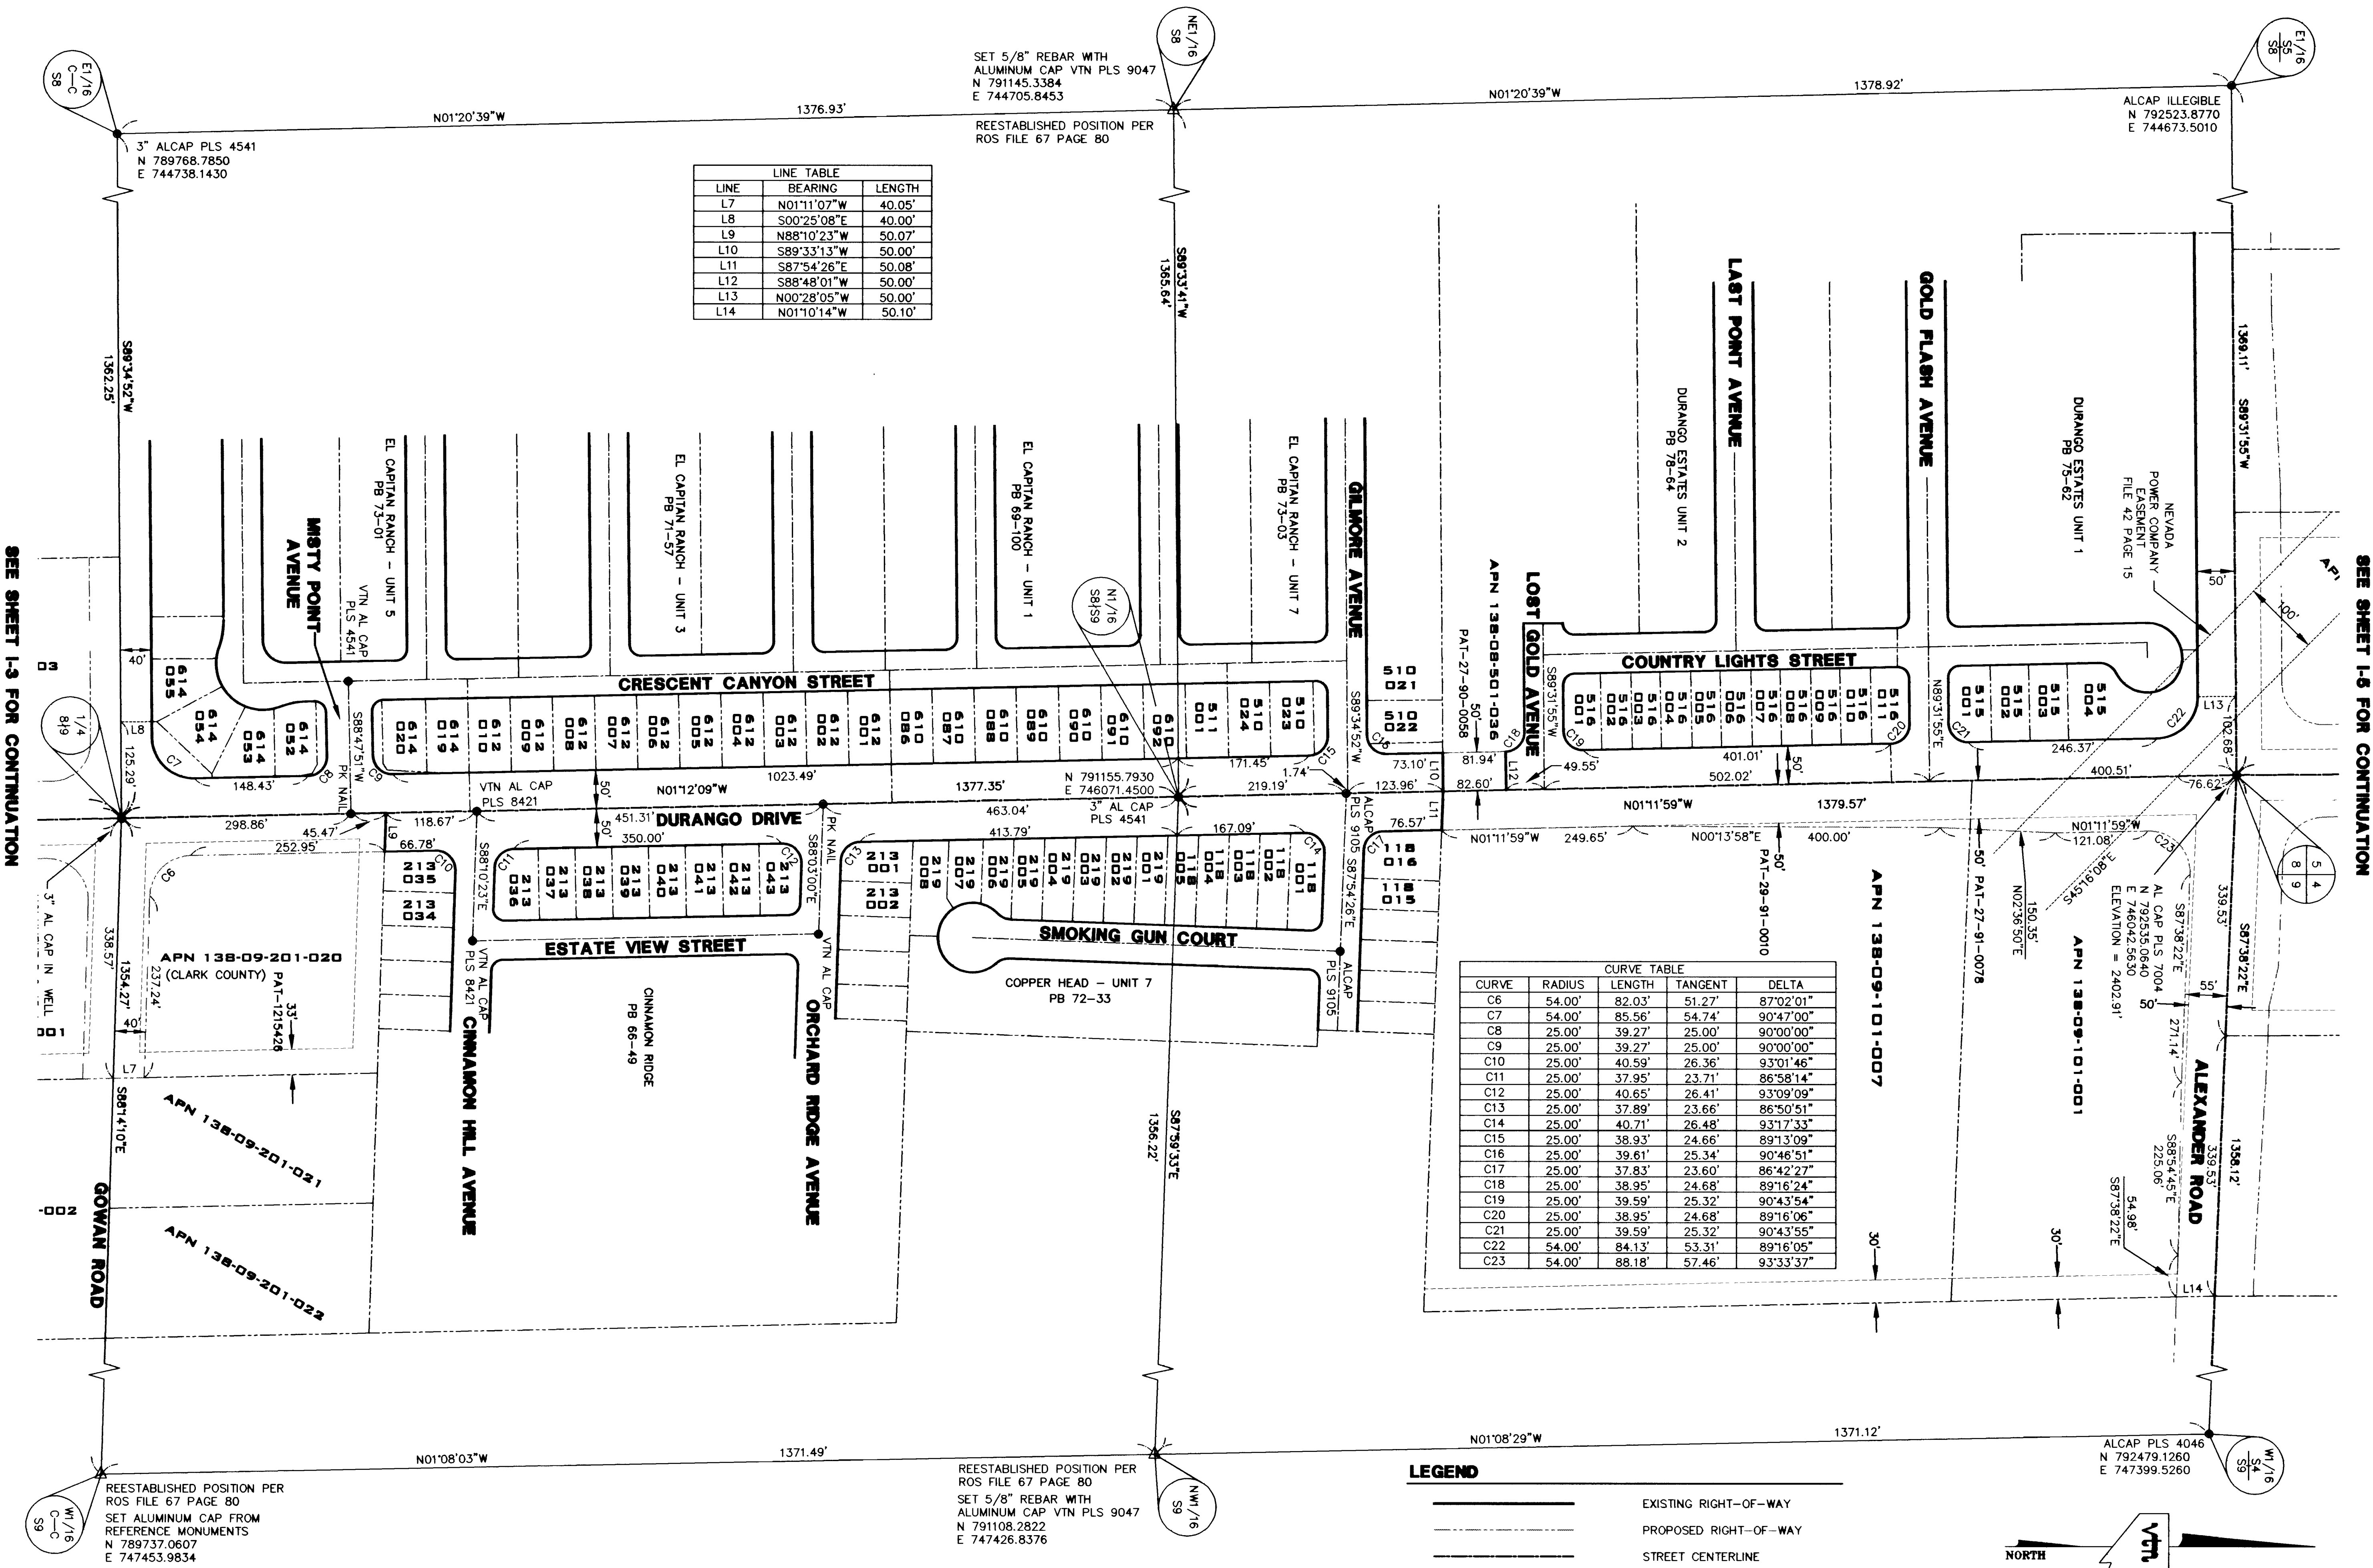

DEPARTMENT OF PUBLIC WORKS
CITY OF LAS VEGAS, NEVADA

SURVEY CONTROL PLAN

TITLE

DURANGO DRIVE IMPROVEMENTS
CHEYENNE AVENUE TO LONE MOUNTAIN ROAD

PROJECT

SEAL

WO. NO. 5249-S
BY MSC
DATE 7-17-98
SCALE HORIZ. 1"=100'
VERT. 1"=100'
DRAWING I-4
SHEET 4 OF 106 SHEETS

CONSULTING ENGINEERS • PLANNERS • LAND SURVEYORS
2727 SOUTH RAINBOW BOULEVARD
LAS VEGAS, NEVADA 89102-5148 PHONE (702) 873-7550 FAX (702) 362-2597

CITY OF LAS VEGAS, NEVADA

REVISION
BY
DATE
REV

RECORD DRAWING 03/23/01