
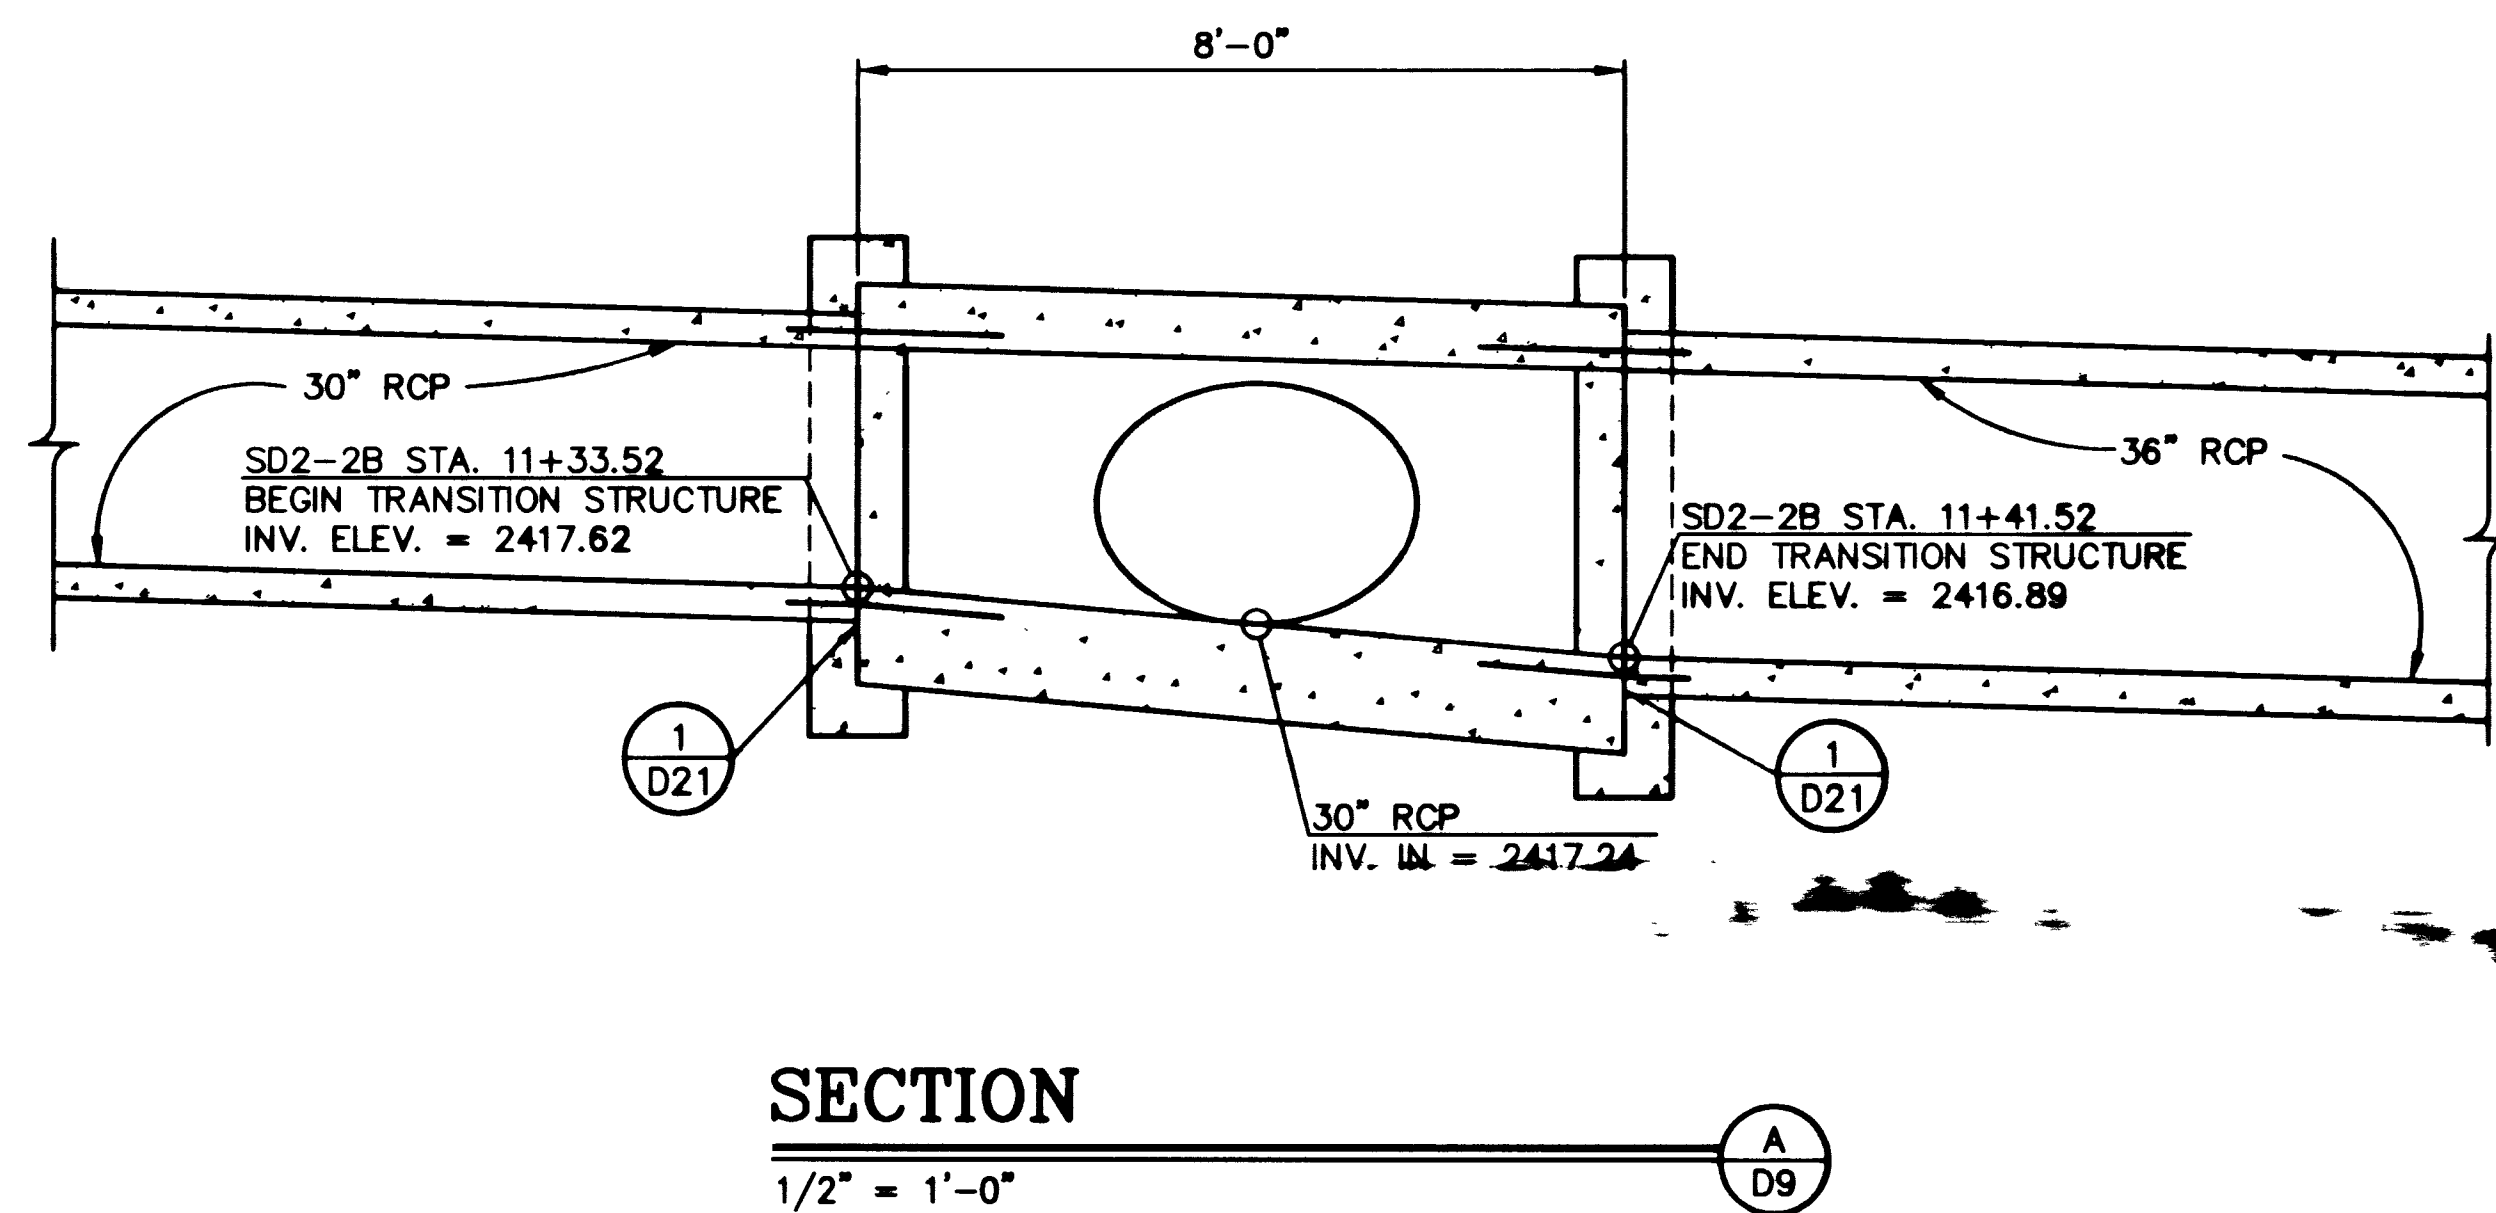
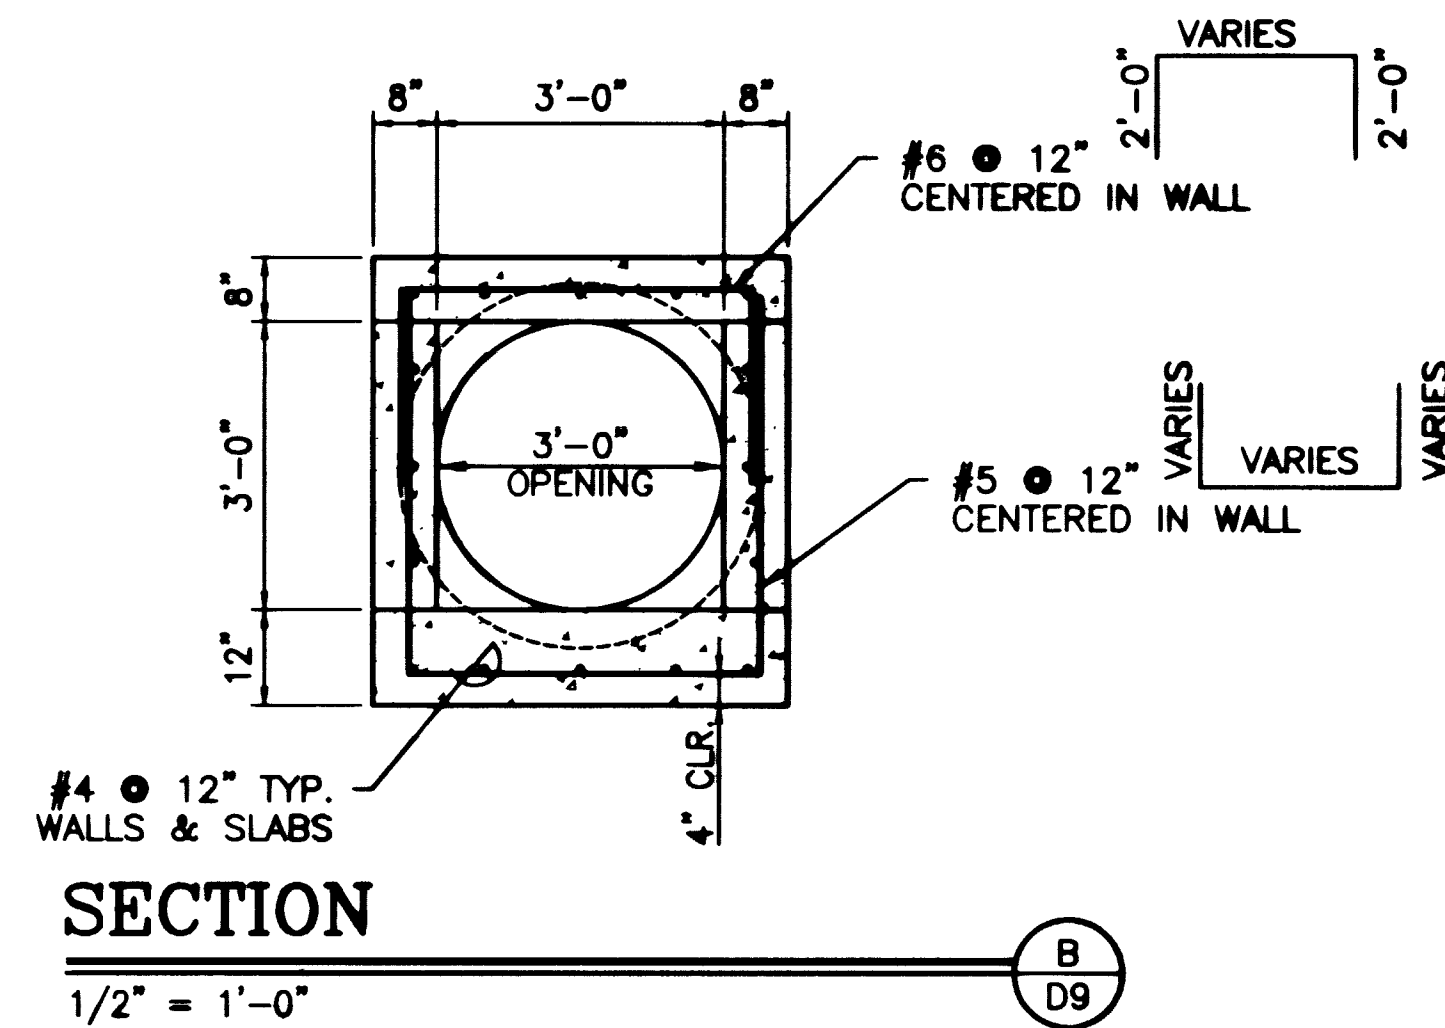


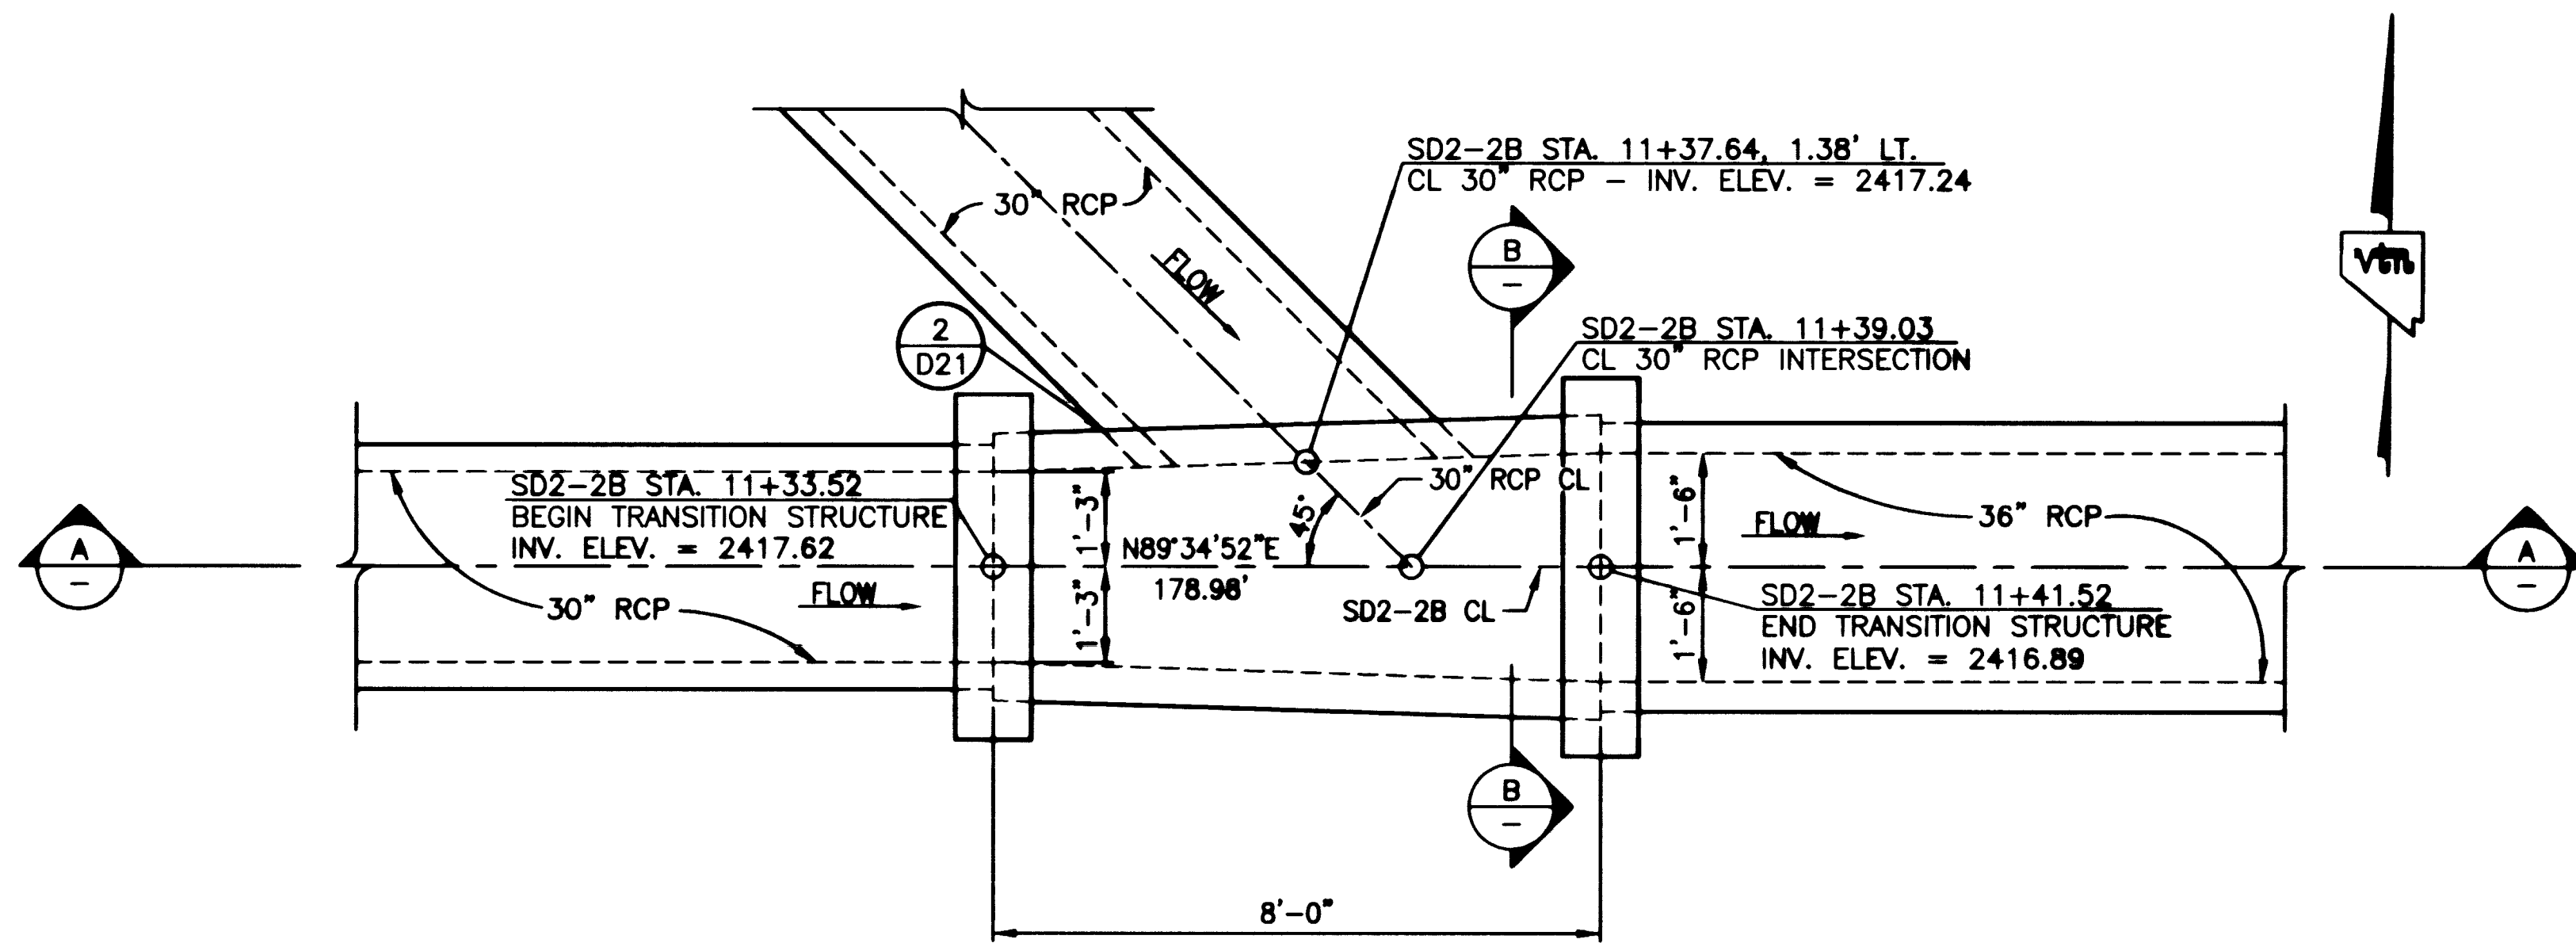

DEPARTMENT OF PUBLIC WORKS  
CITY OF NORTH LAS VEGAS

vtm nevada

CONSULTING ENGINEERS & PLANNERS & LAND SURVEYORS  
1000 WEST WASHINGTON AVENUE, SUITE 200  
LAS VEGAS, NEVADA 89101  
PHONE (702) 735-1100  
FAX (702) 735-1101

R.H. & G.B. ENGINEERING  
1000 WEST WASHINGTON AVENUE, SUITE 200  
LAS VEGAS, NEVADA 89101  
PHONE (702) 735-1100  
FAX (702) 735-1101

TITLE  
STRUCTURAL DETAIL  
JUNCTION STRUCTURE  
SD2-2B STA 11+33.52 TO 11+41.52  
PROJECT  
DURANGO DRIVE IMPROVEMENTS  
CHEYENNE AVENUE TO LONE MOUNTAIN ROAD

WD NO. 5249  
BY WSW  
DATE 7/17/98  
SCALE HORIZ. VERT.  
DRAWING D9  
SHEET 15 OF 108 SHEETS

RECORD DRAWING 03/23/01