



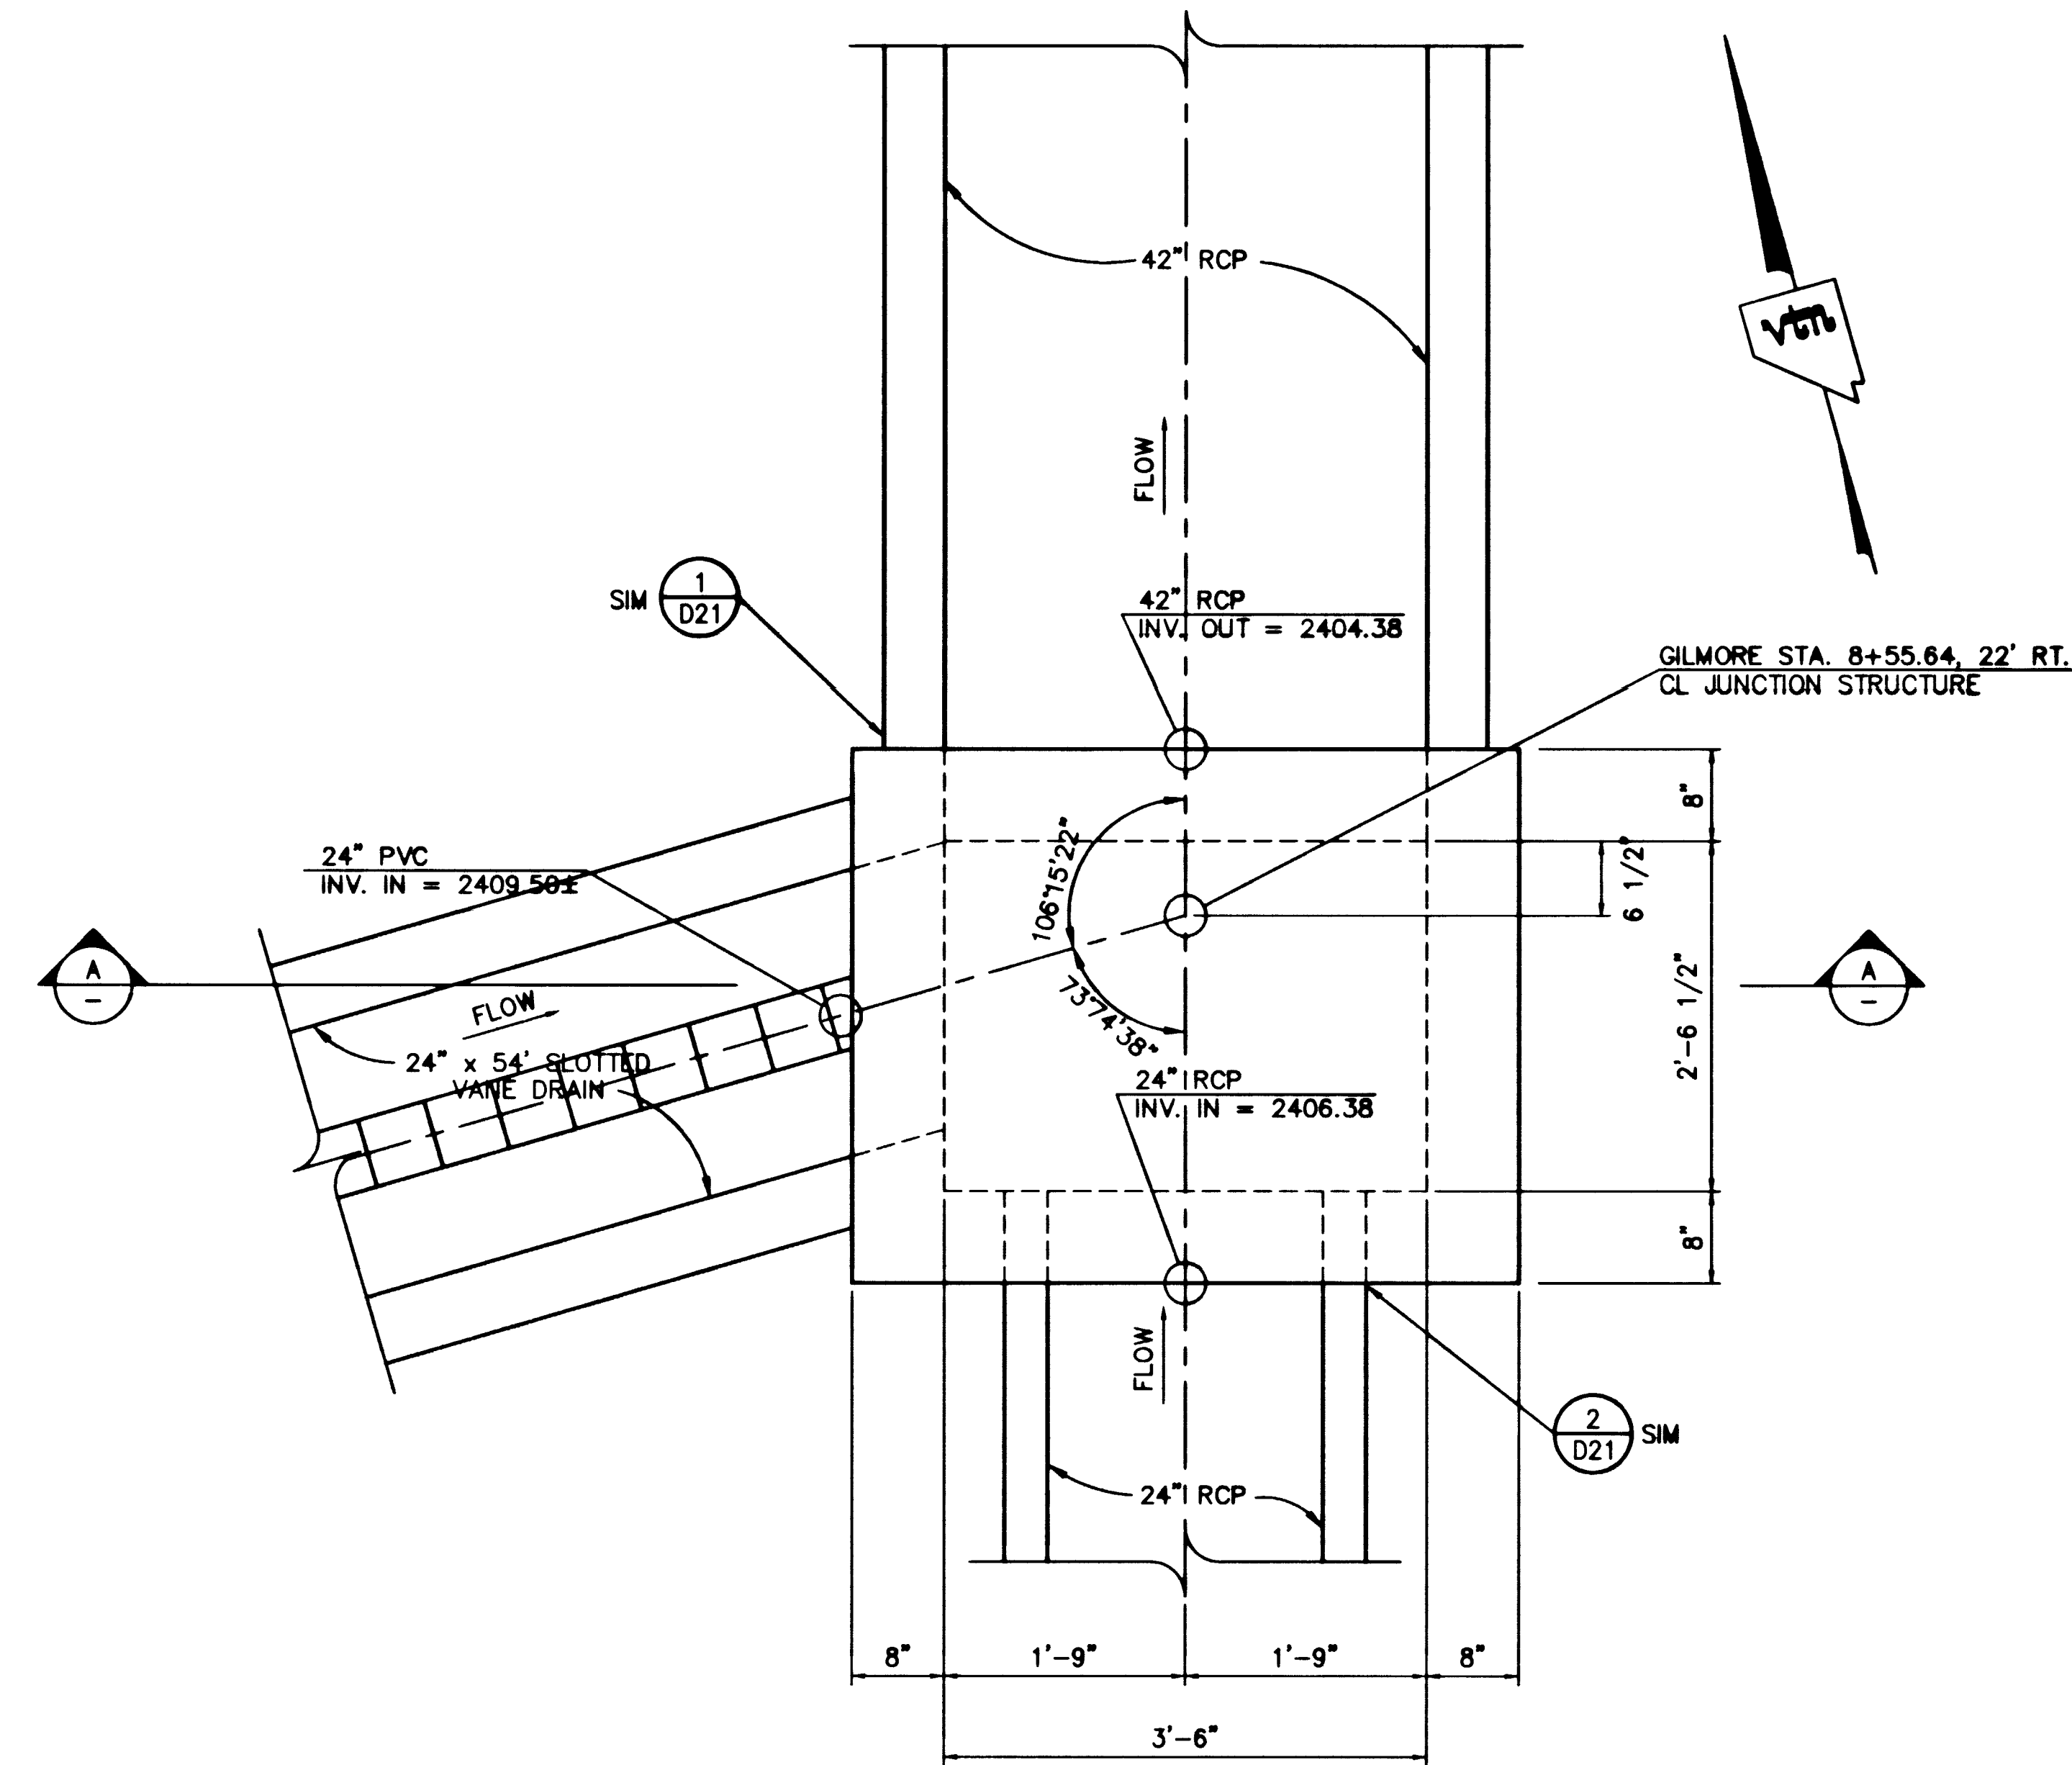


PLAN VIEW

1" = 1'-0"

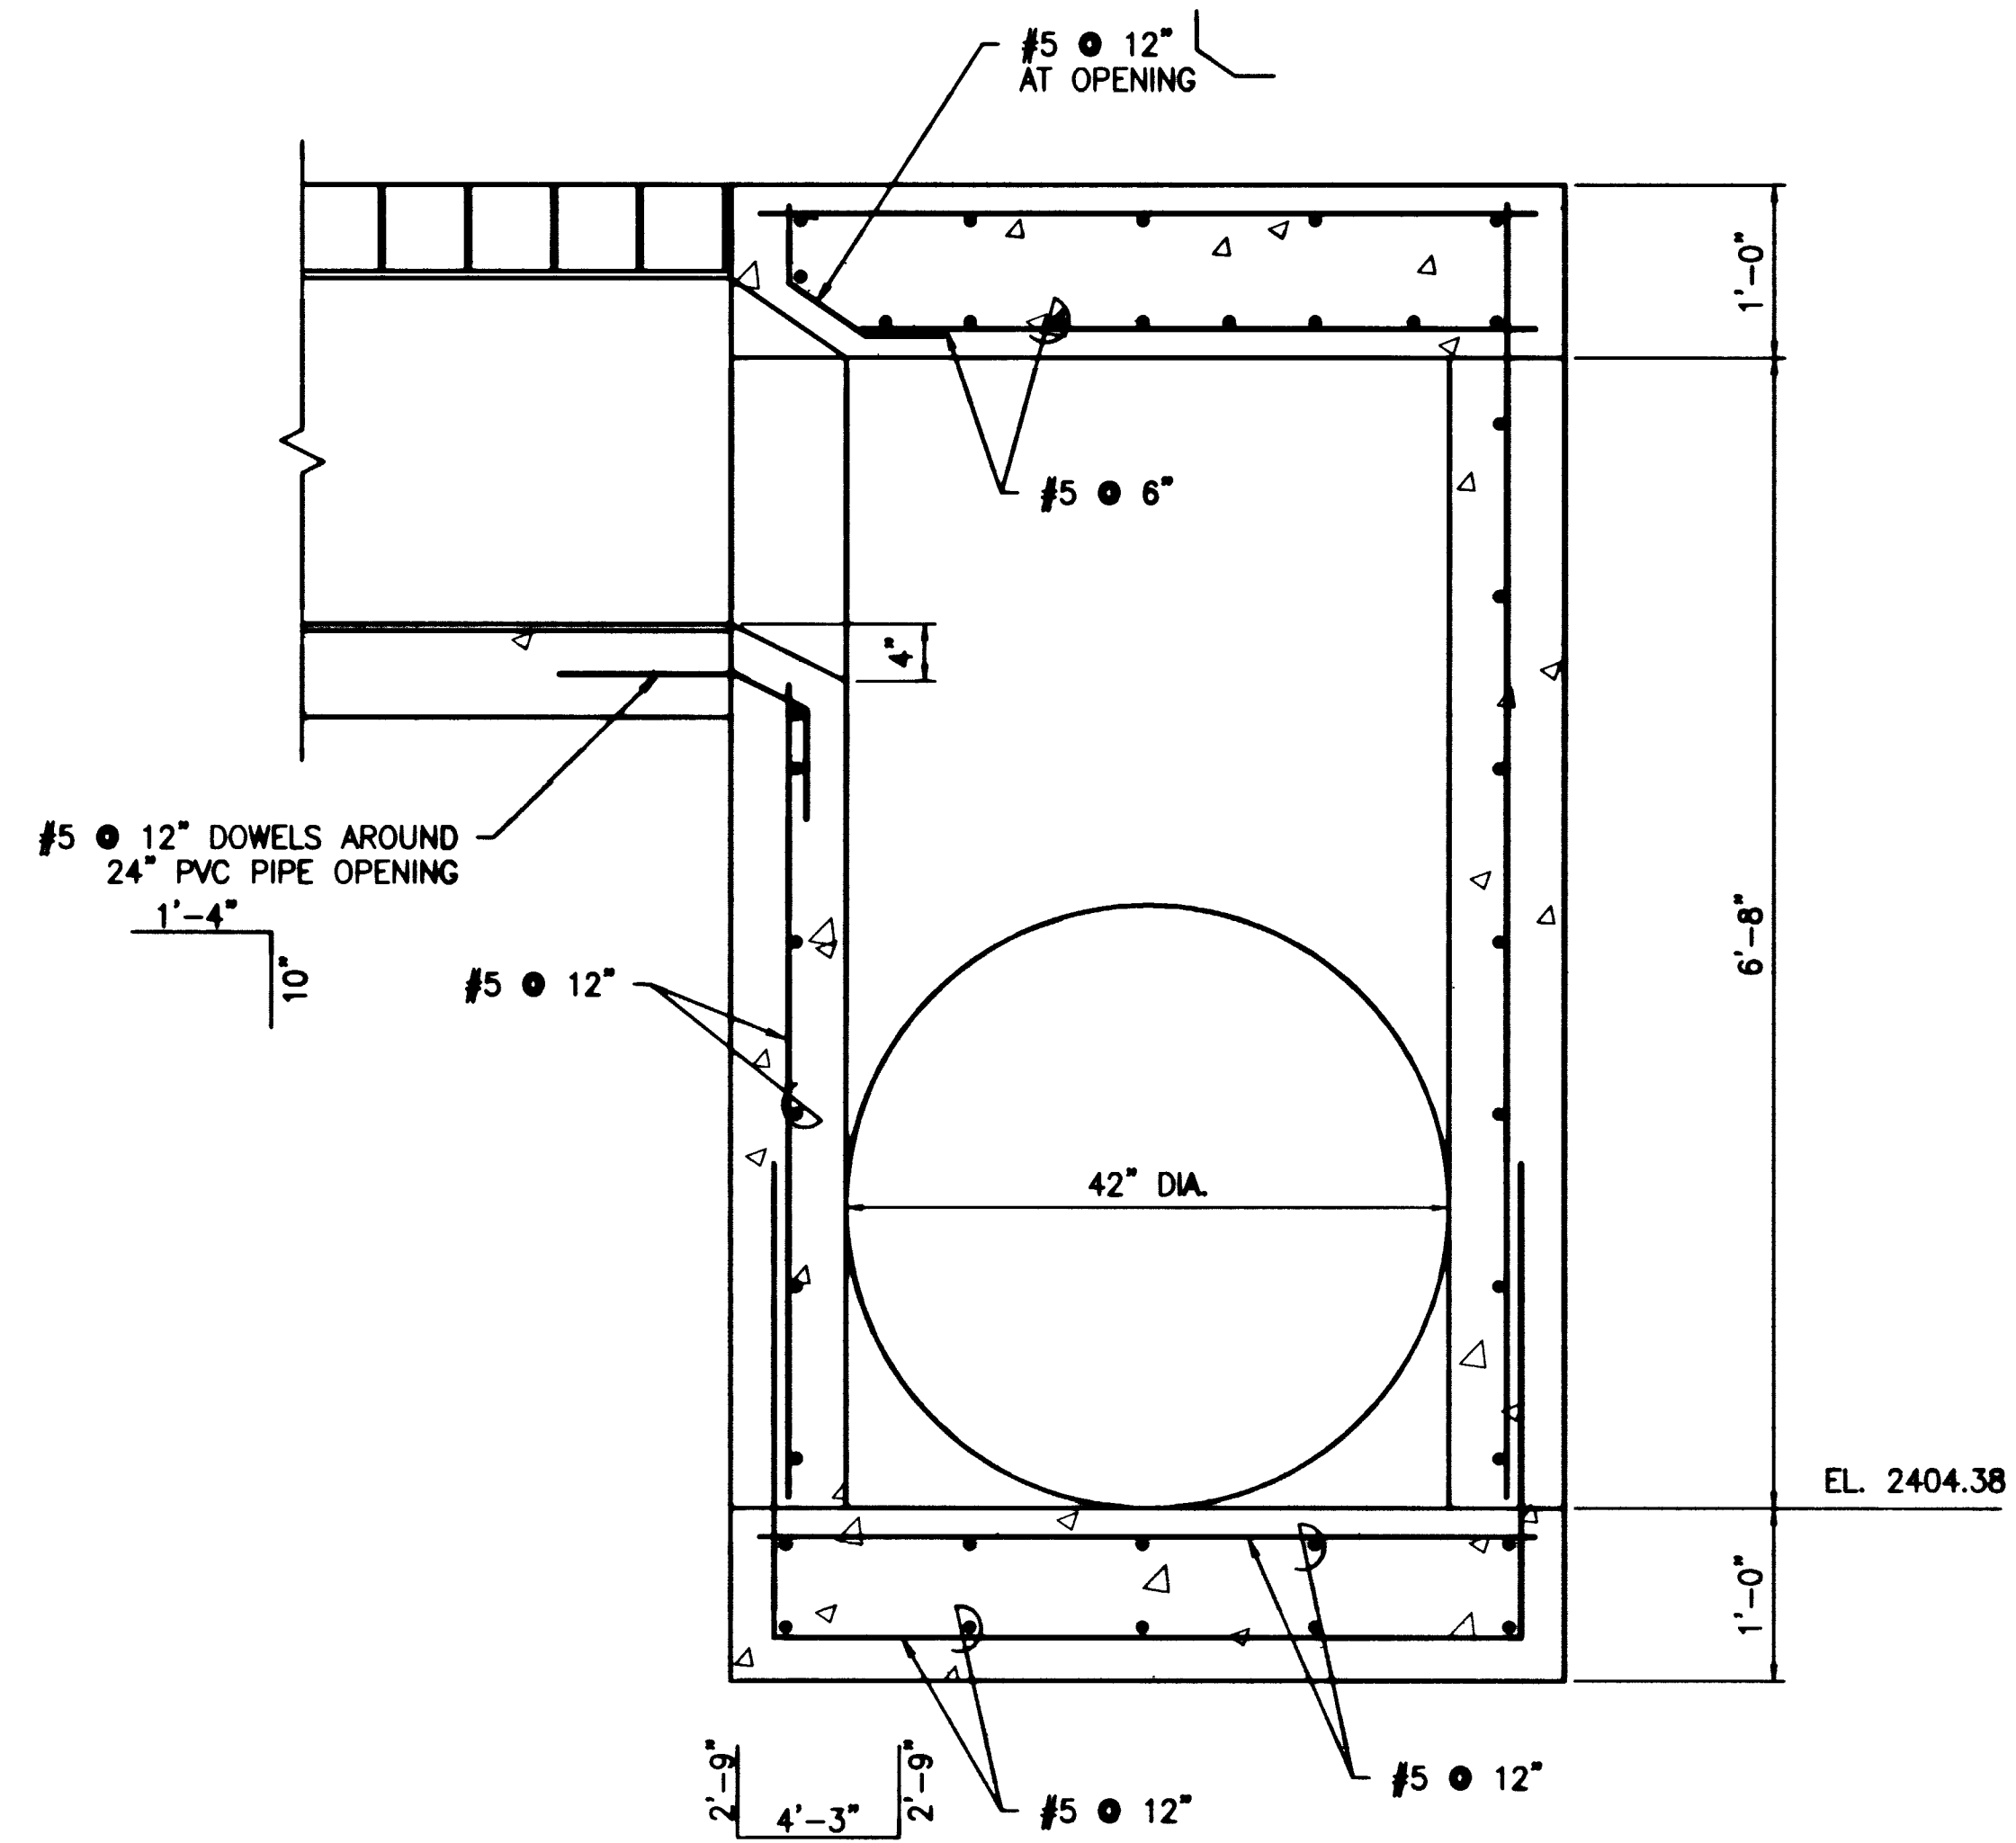

SECTION

1" = 1'-0"

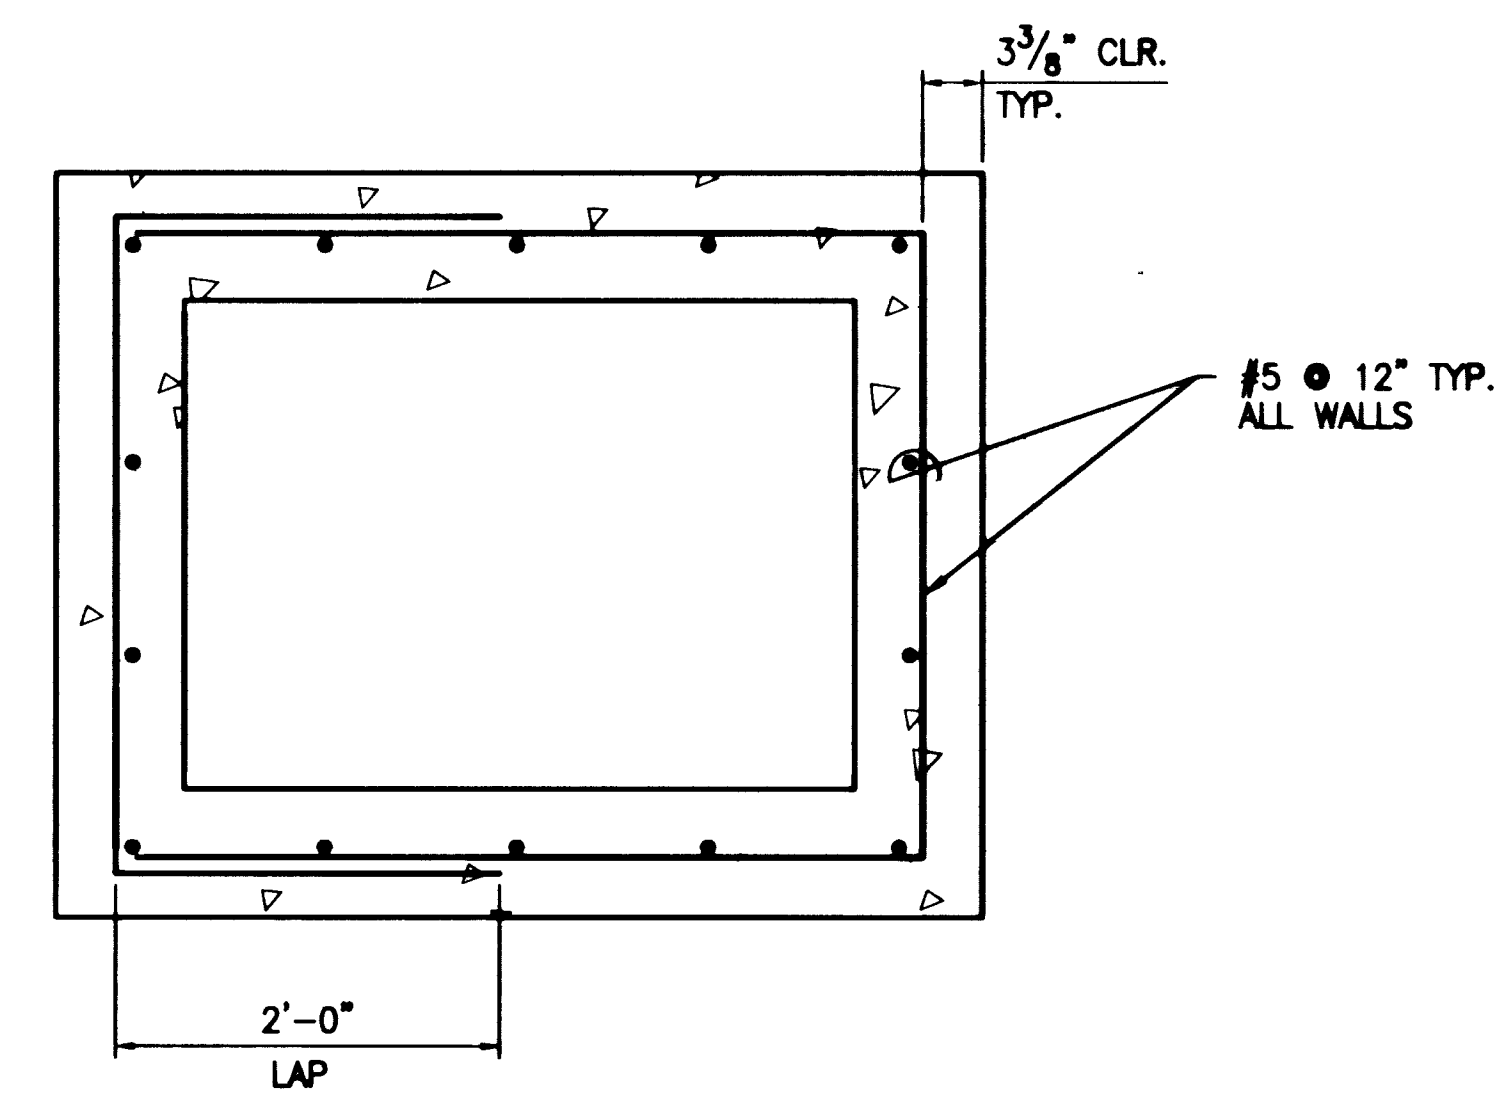

REINFORCEMENT PLAN

1" = 1'-0"

DEPARTMENT OF PUBLIC WORKS
CITY OF LAS VEGAS

vtm nevada

R2H
R2H CONSULTING ENGINEERS & PLANNERS • LAND SURVEYORS
1000 S. DURANGO AVENUE, SUITE 200
LAS VEGAS, NEVADA 89101
(702) 735-1100
Fax: (702) 735-1101

TITLE
STRUCTURAL DETAILS
JUNCTION STRUCTURE
GILMORE STA. 8+55.64, 22' RT.
PROJECT
DURANGO DRIVE IMPROVEMENTS
CHEYENNE AVENUE TO LONE MOUNTAIN ROAD

SEAL

WC NO. 5249
BY WSW
DATE 7/17/98
SCALE HORIZ.
VERT.
DRAWING SHEET 18
OF 108
SHEETS

RECORD DRAWING 03/23/01