



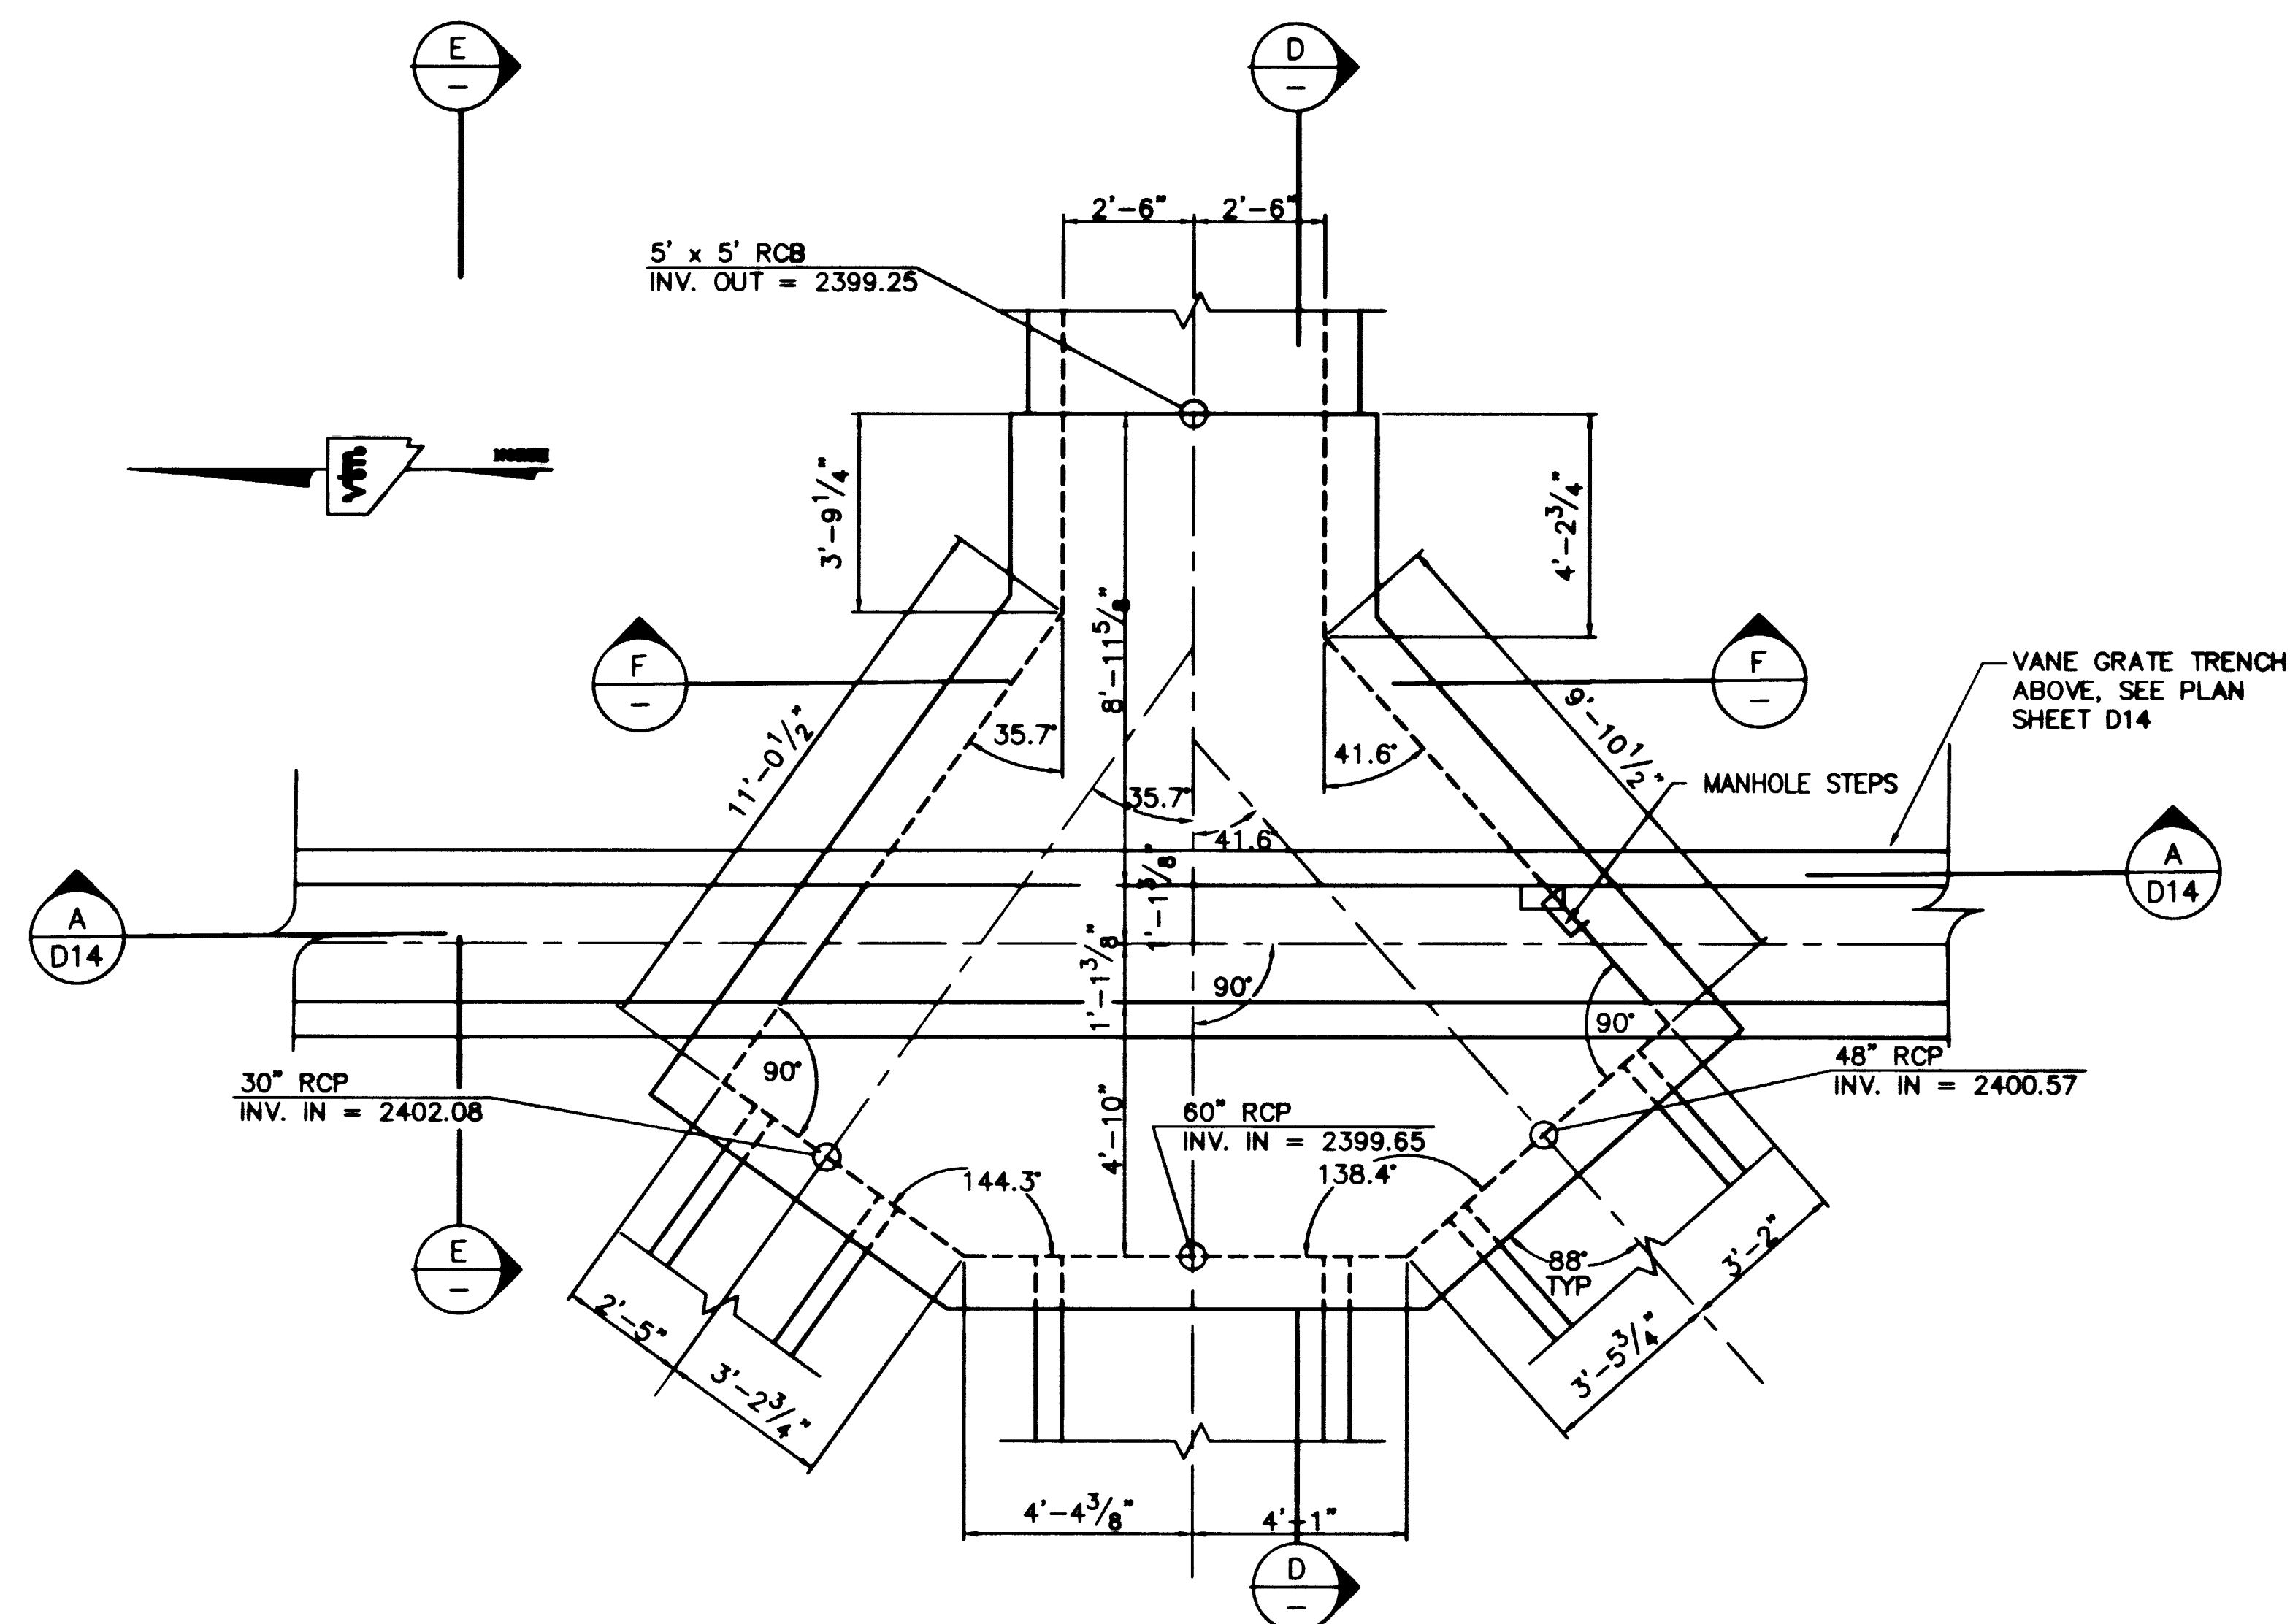


PLAN SECTION

3/8" = 1'-0"

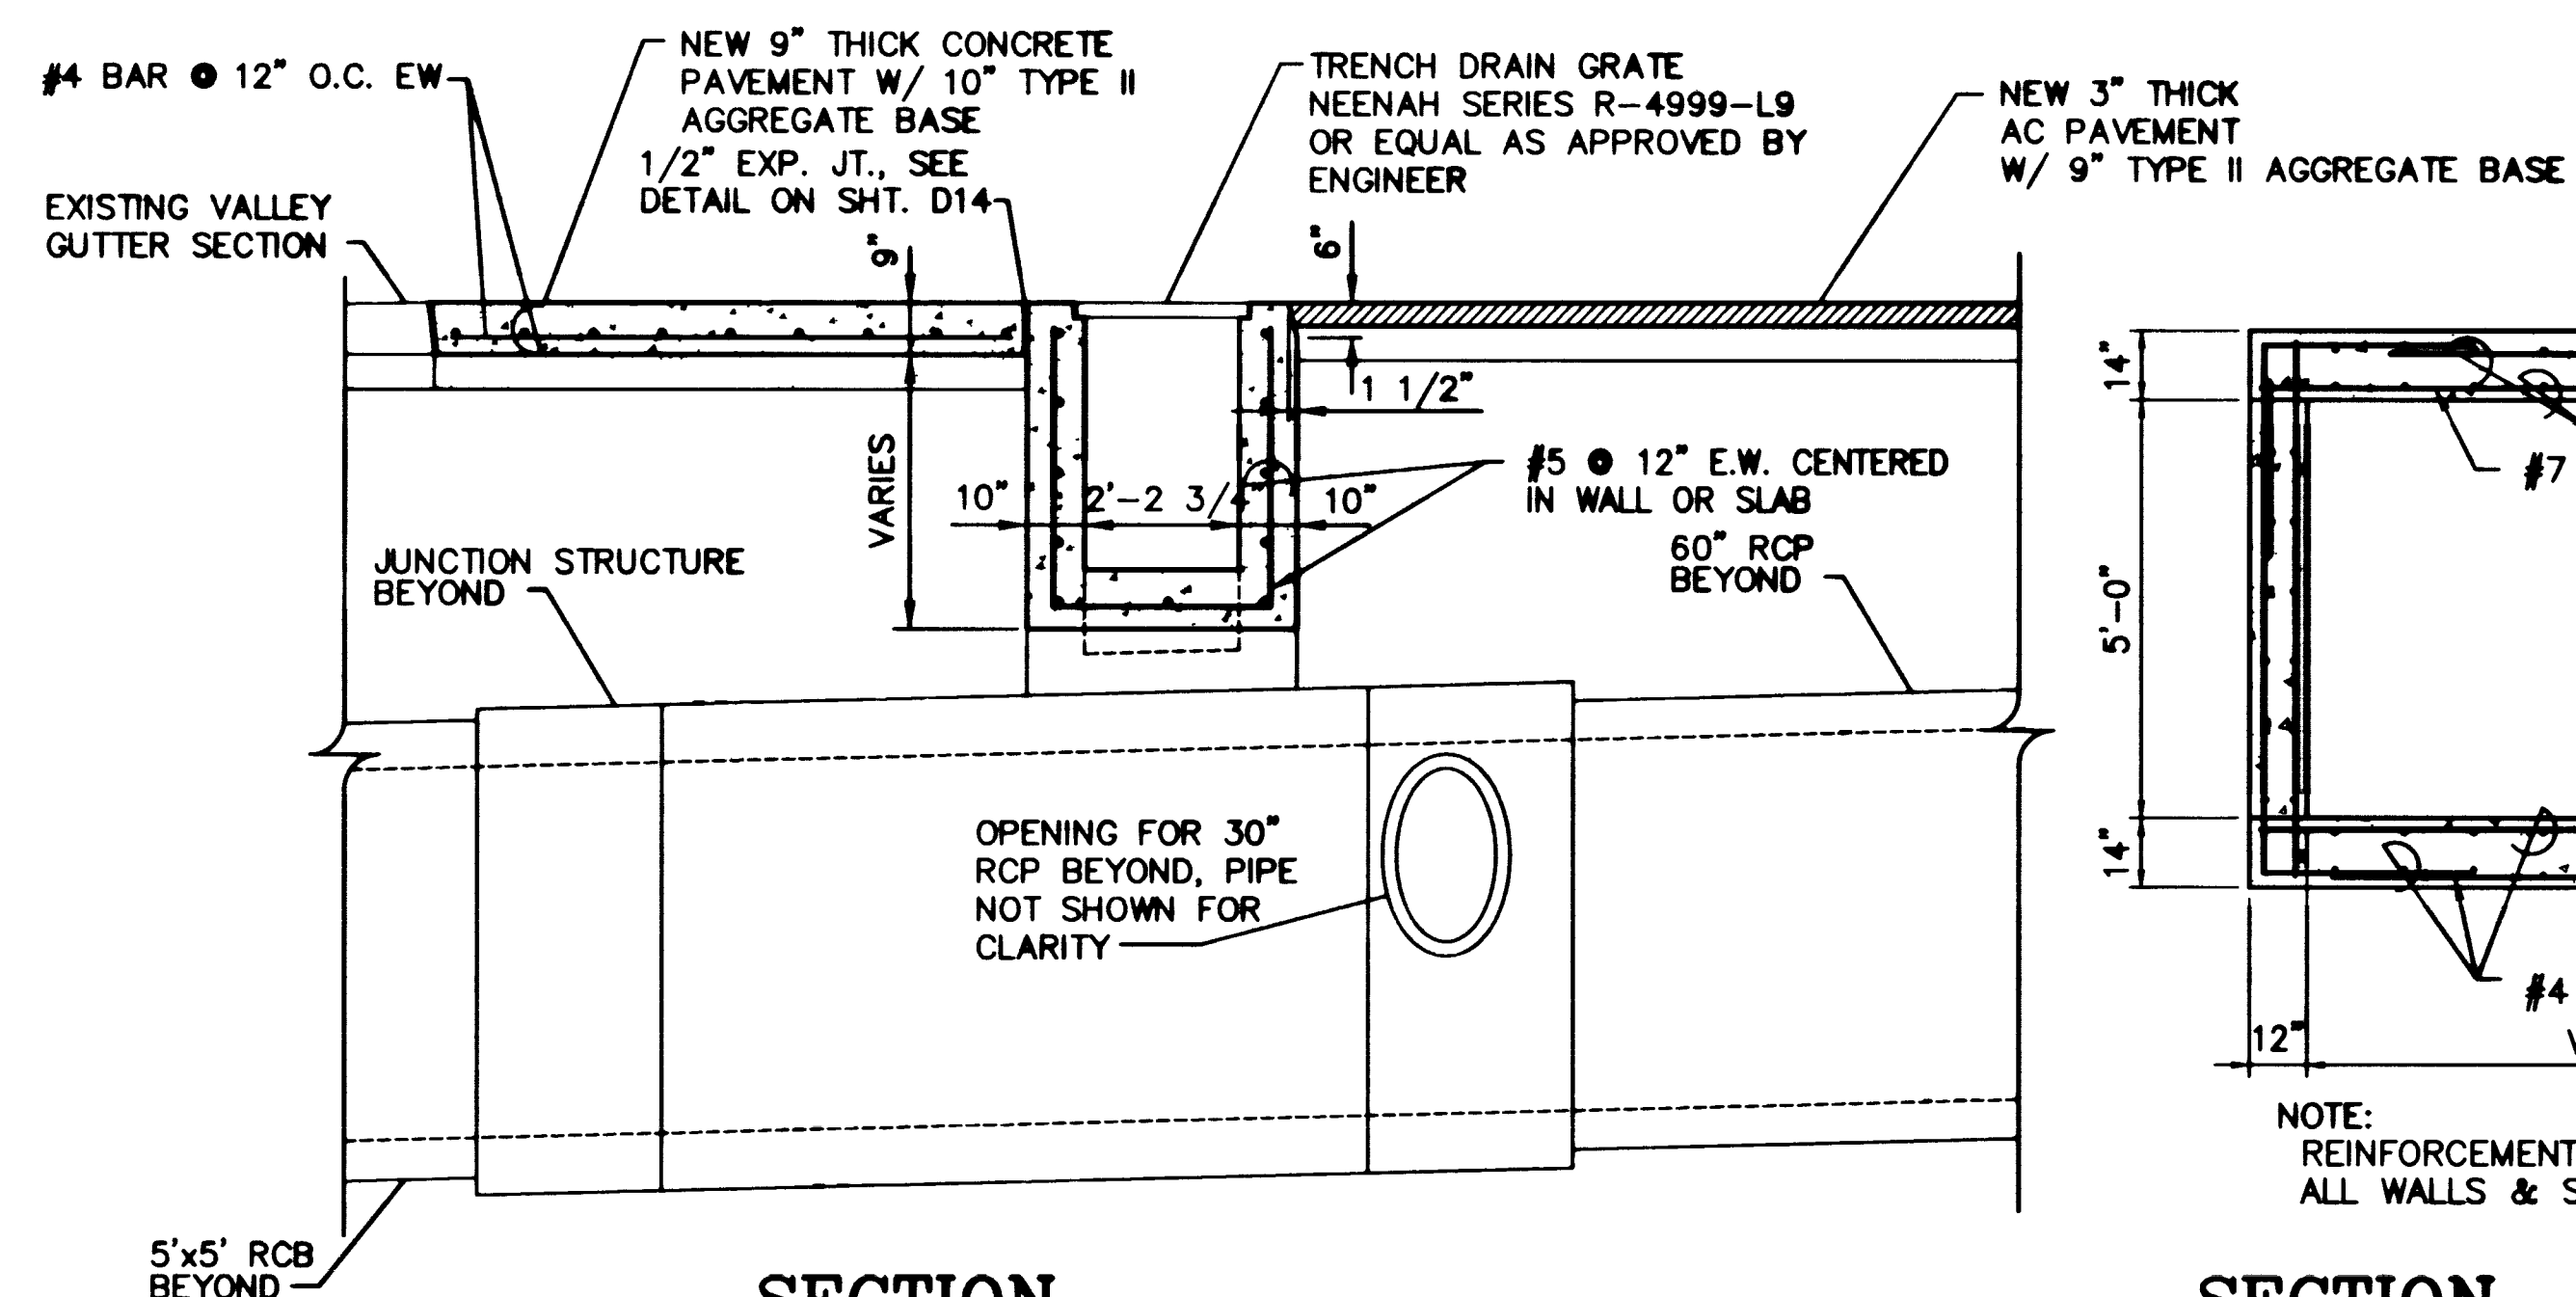


SECTION

3/8" = 1'-0"

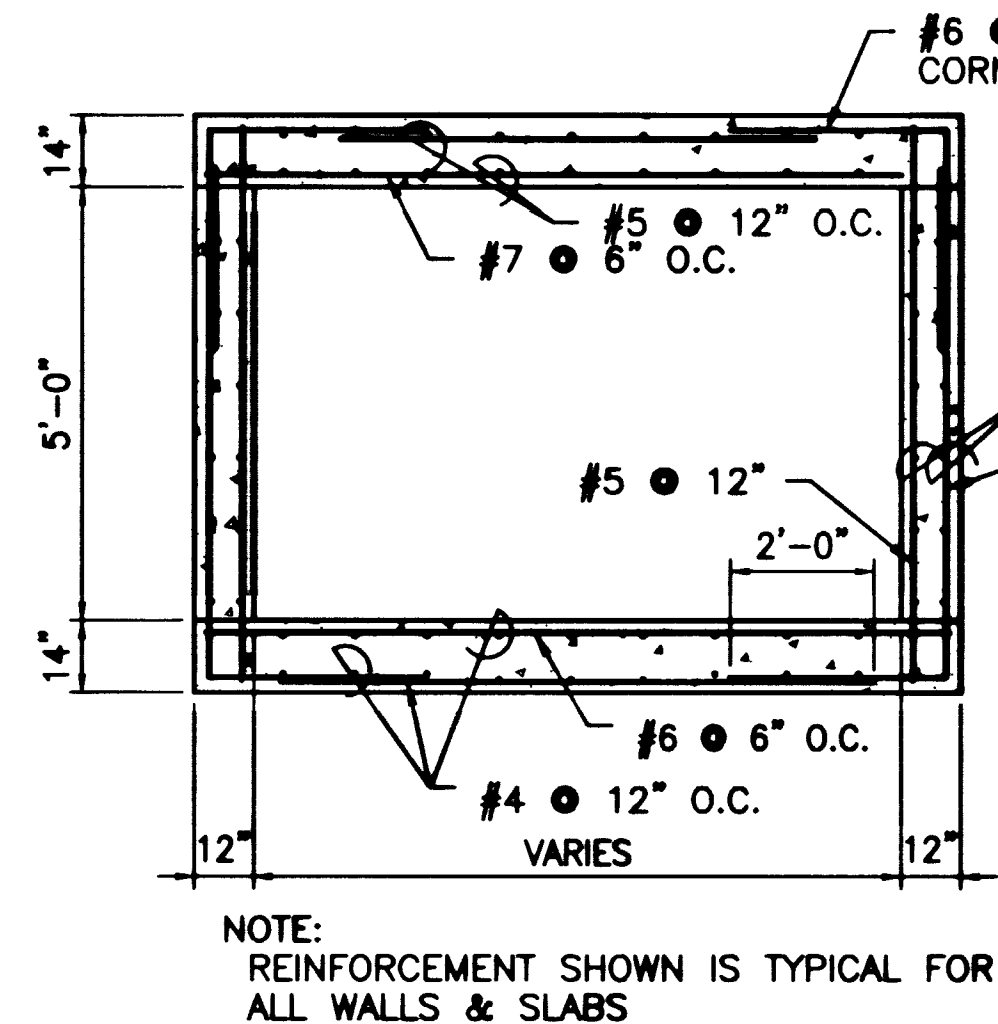


SECTION

N.T.S.

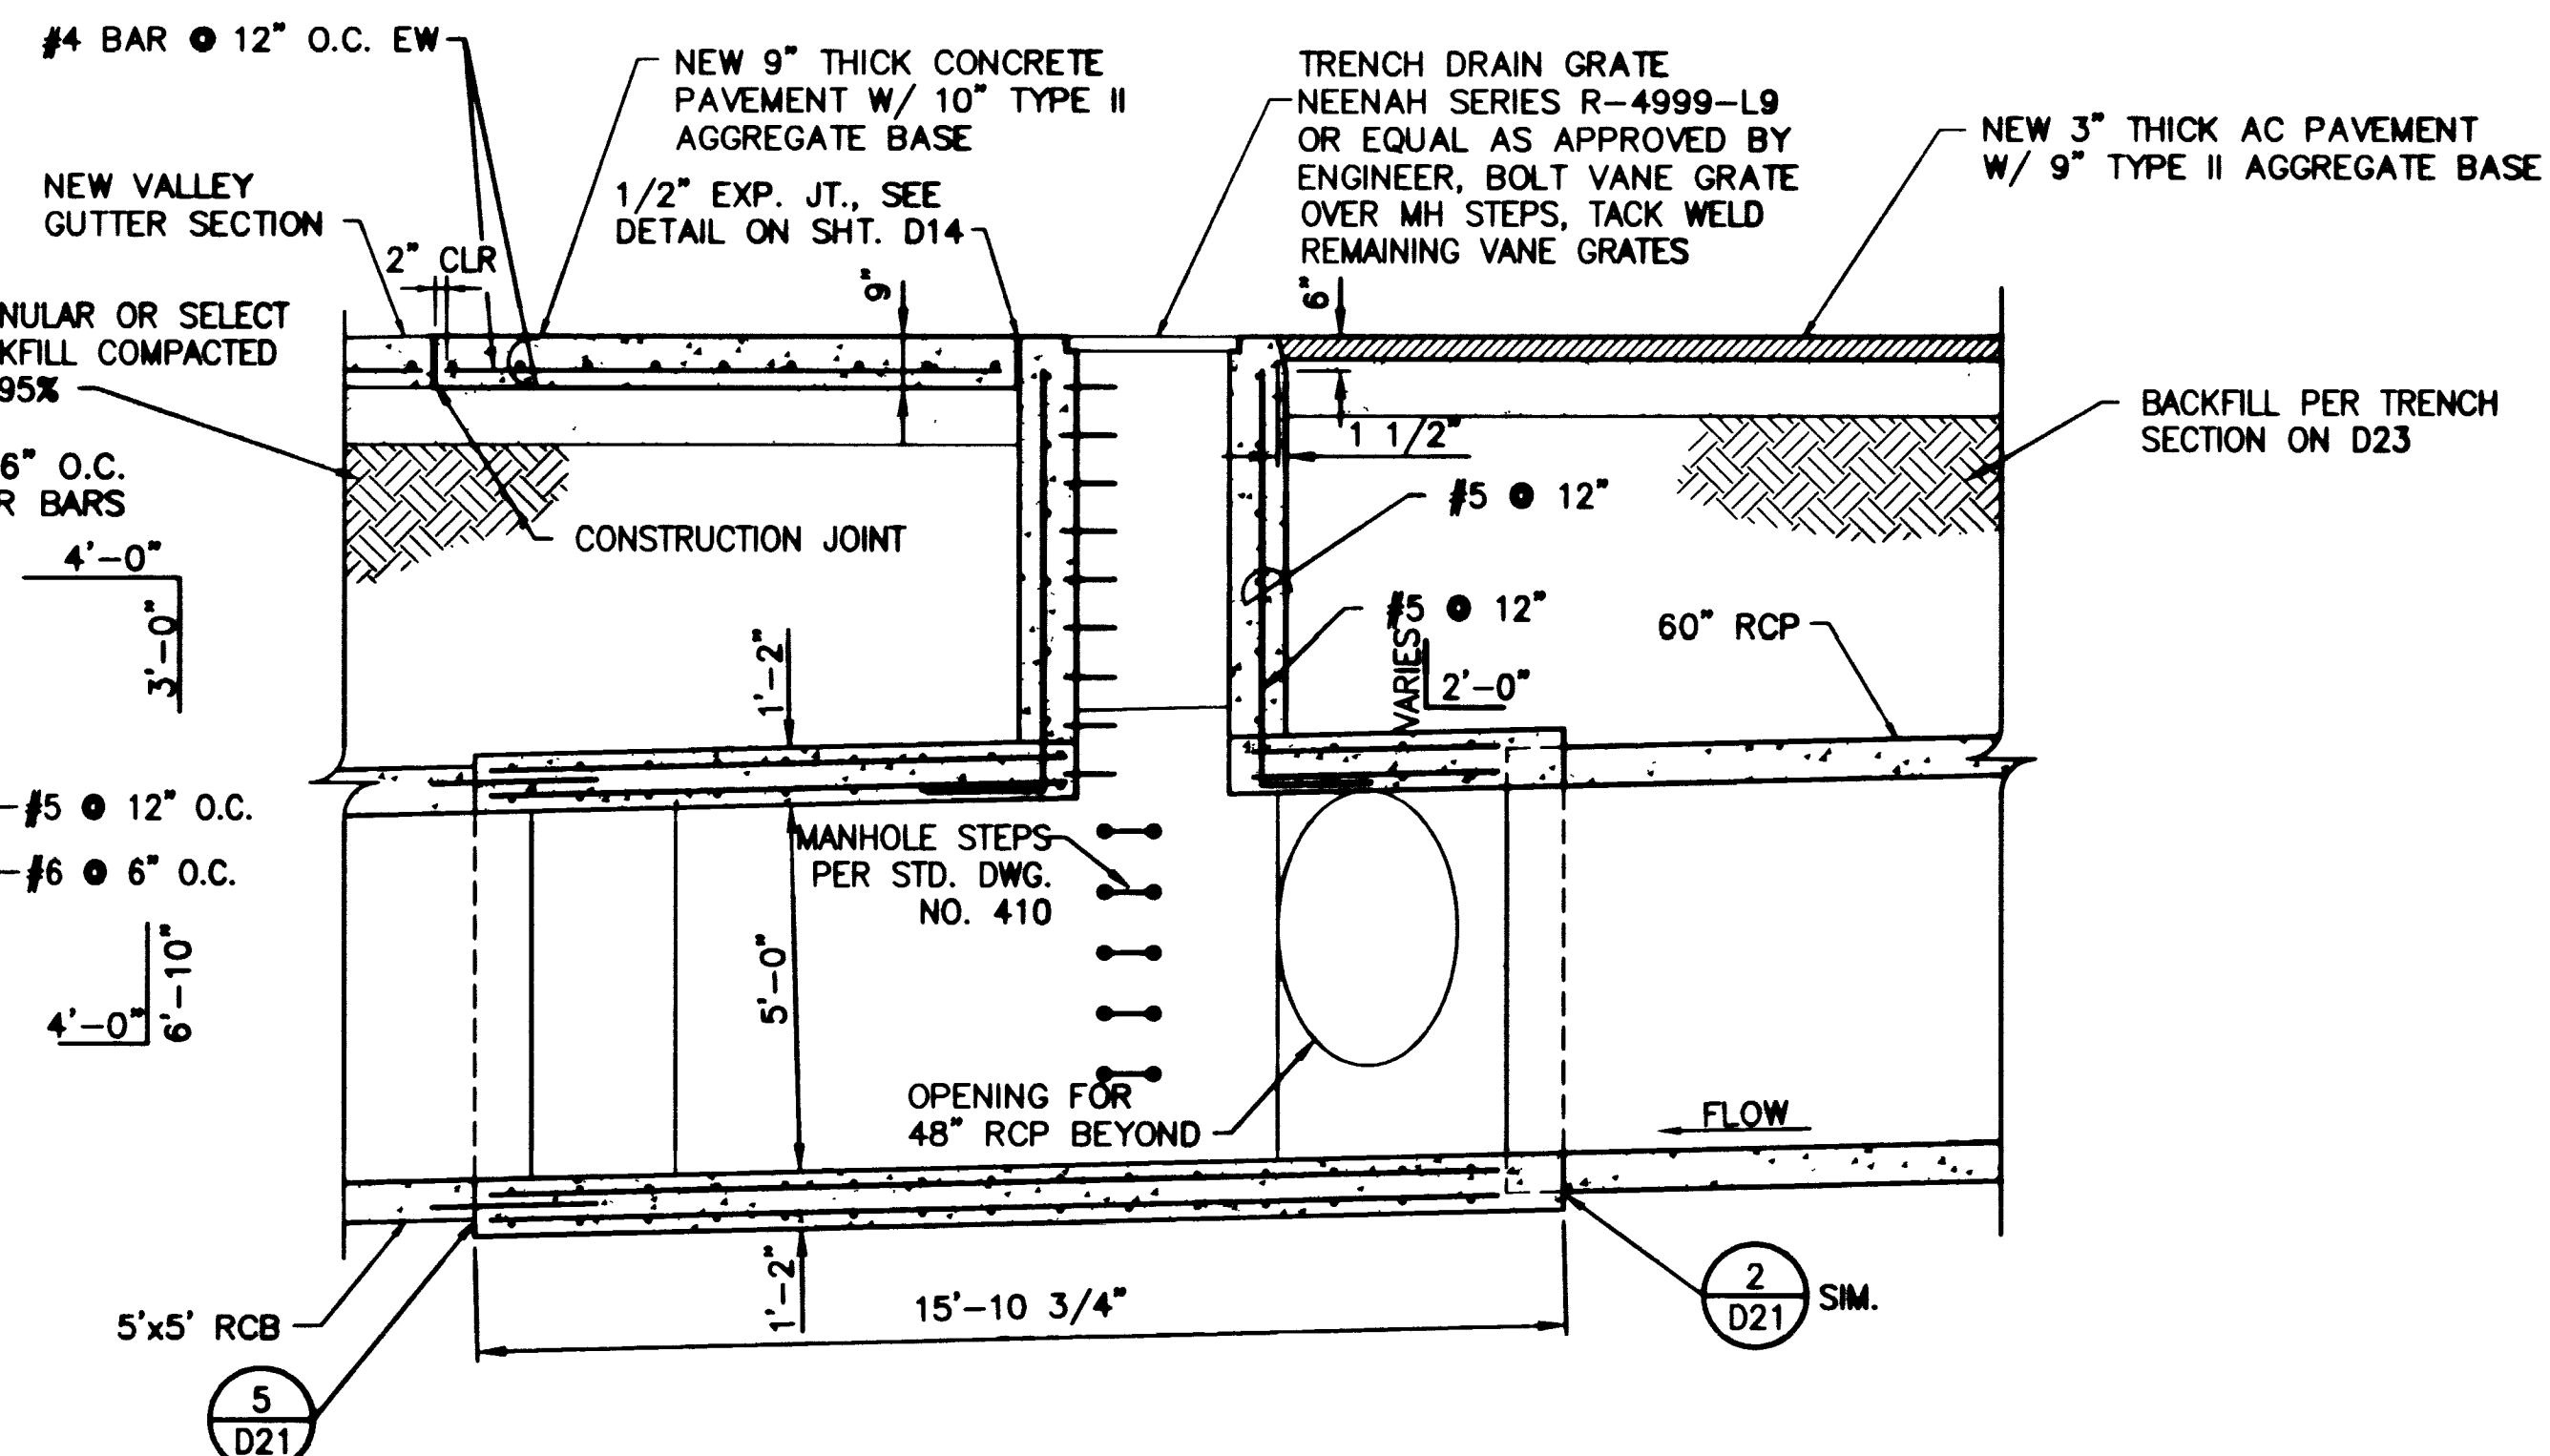

SECTION

3/8" = 1'-0"

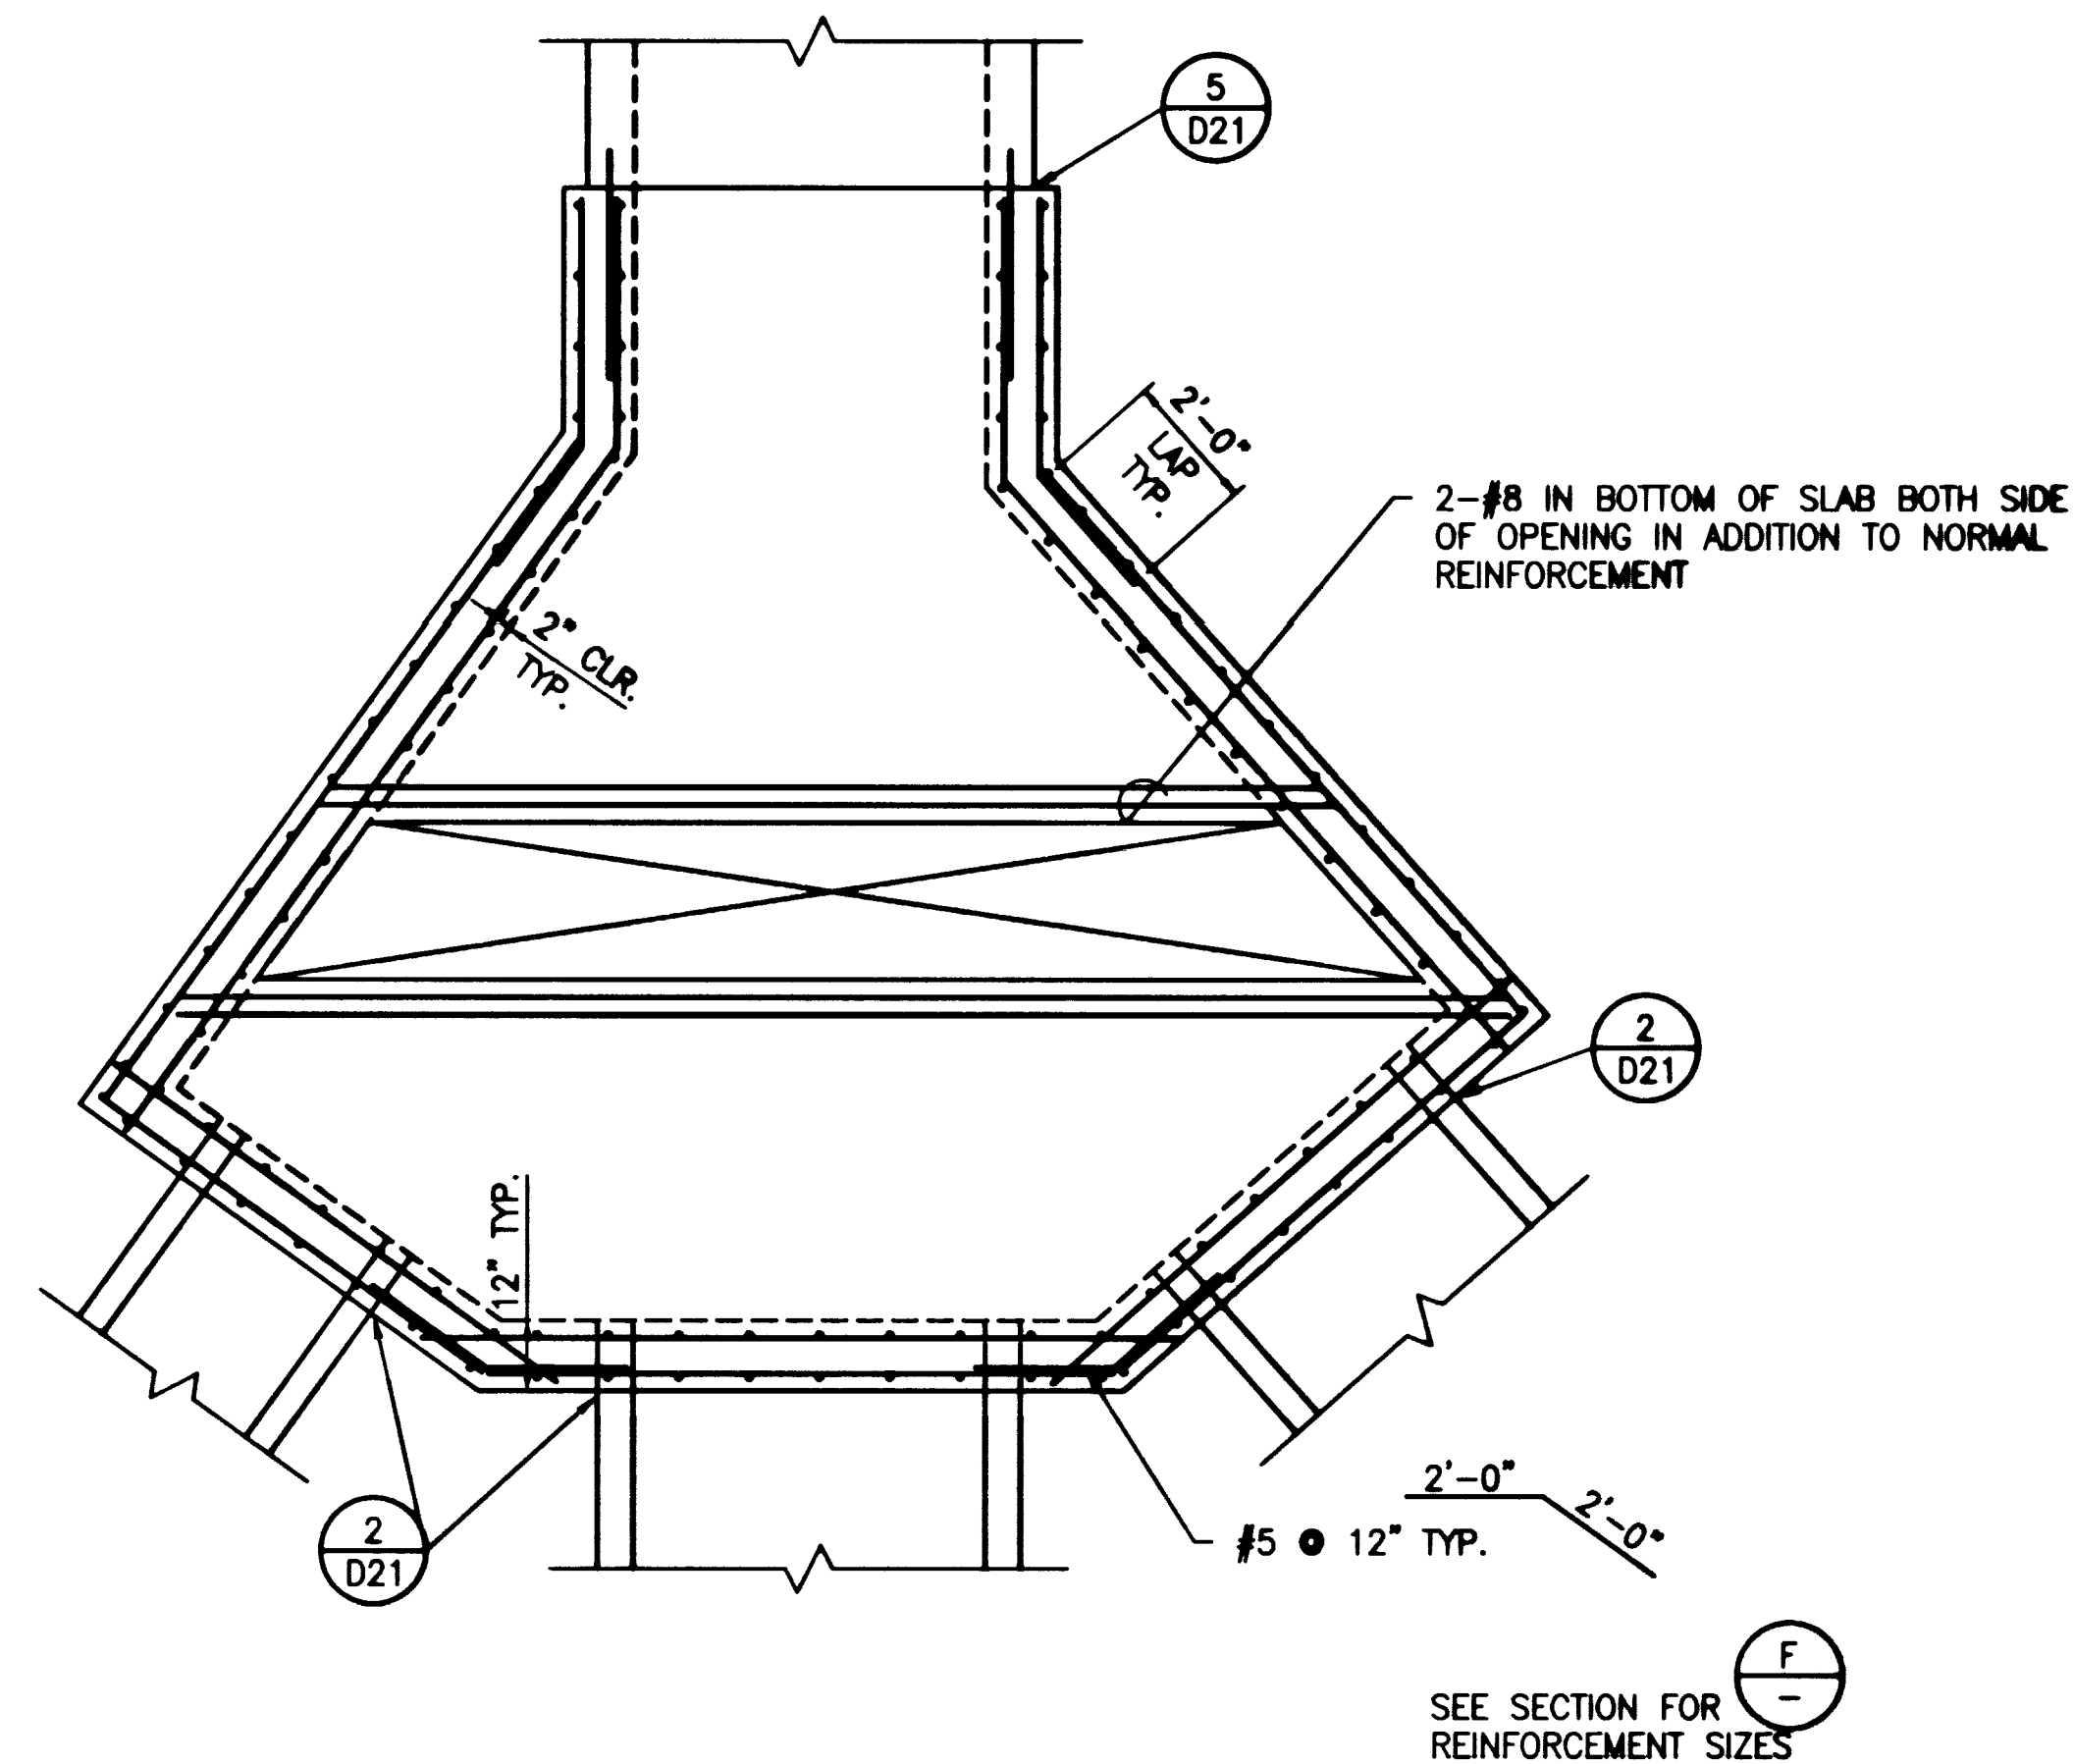

REINFORCEMENT PLAN

3/8" = 1'-0"

DEPARTMENT OF PUBLIC WORKS
CITY OF LAS VEGAS

vtm nevada

R2H
R2H CONSULTING ENGINEERS & PLANNERS & LAND SURVEYORS
1400 SOUTH MOUNTAIN ROAD, SUITE 200
LAS VEGAS, NEVADA 89102
PHONE (702) 735-1100
FAX (702) 735-1101

TITLE
JUNCTION STRUCTURE
AND VANE GRATE TRENCH DETAILS
GILMORE STA. 9+38.85, 2' LT.
PROJECT
DURANGO DRIVE IMPROVEMENTS
CHEYENNE AVENUE TO LONE MOUNTAIN ROAD

NO. 5249
BY WSW
DATE 7/17/98
SCALE HORIZ. VERT.
DRAWING SHEET 21 OF 108
D15

RECORD DRAWING 03/23/01