


VIEW "PLT" (MS)
I:\CAD\PLT\5249\DETAILS\FID-PLAN.DWG


32207

NOTE:

1. FOR FIELD INLET DIMENSIONS AND SECTIONS, SEE SHEET D19.
2. SEE SECTION 610 OF THE SPECIAL PROVISIONS FOR FLEXIBLE CONCRETE REVETMENT.

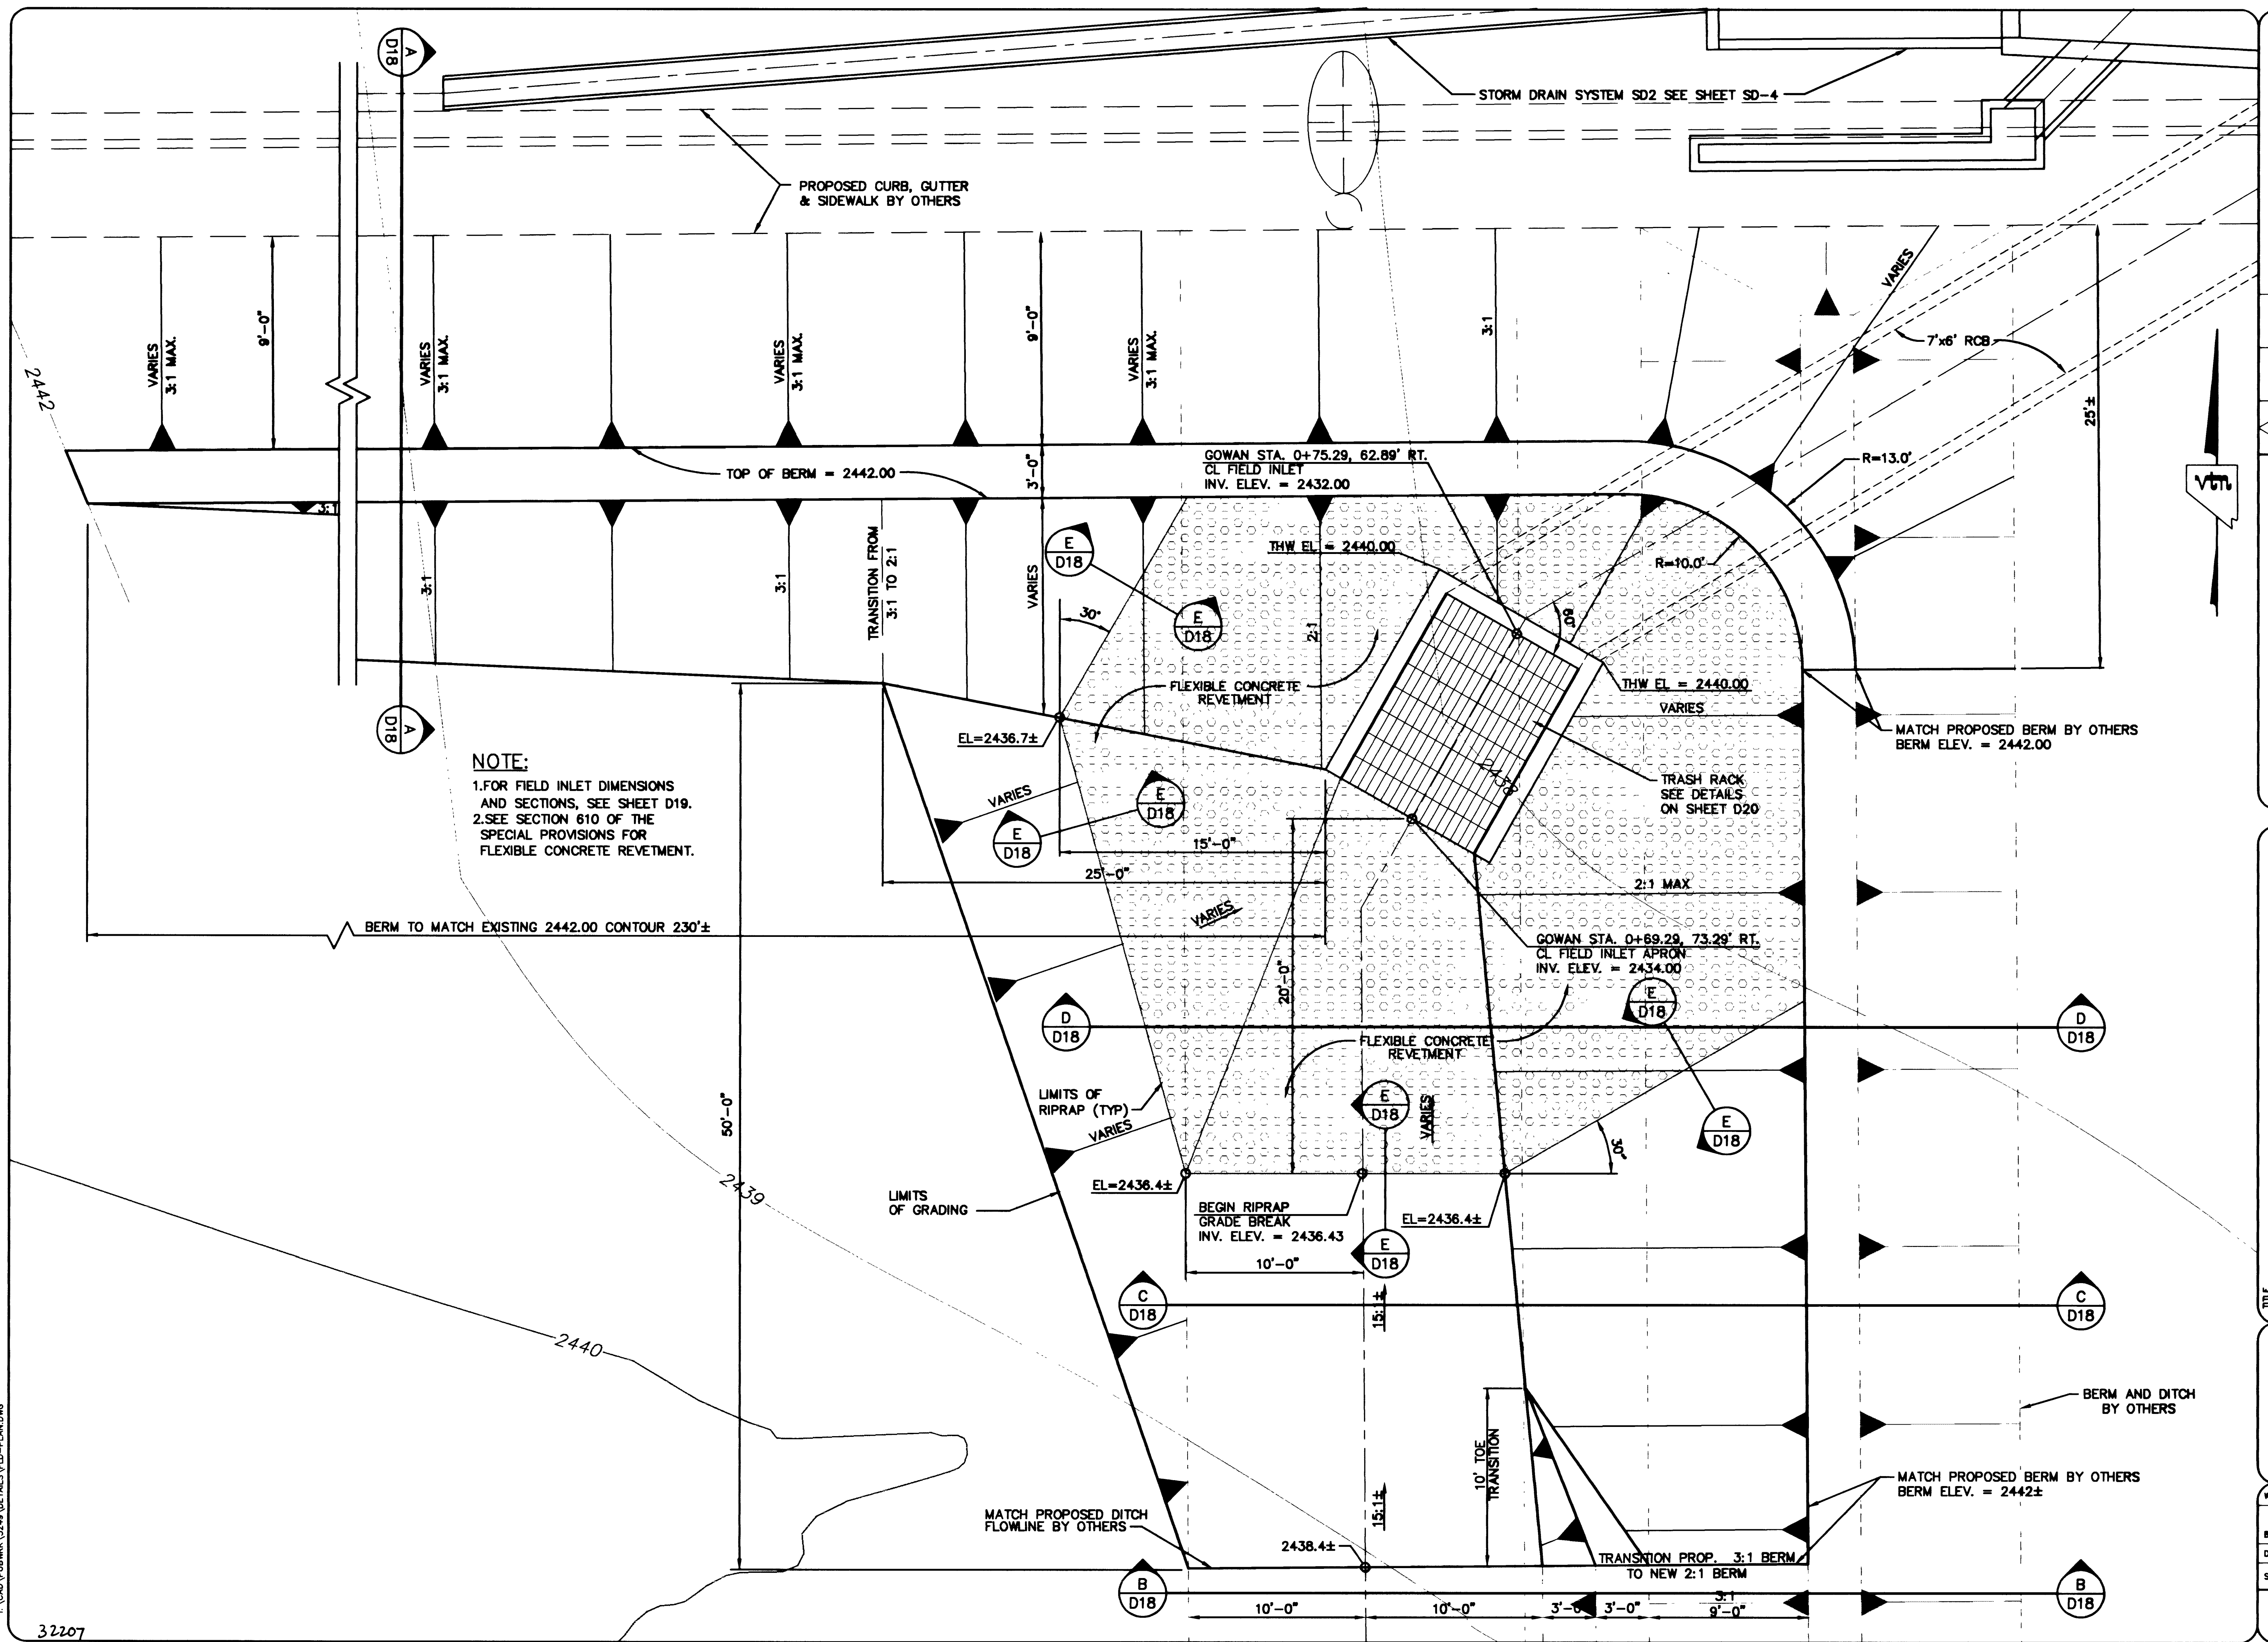

DEPARTMENT OF PUBLIC WORKS
CITY OF LAS VEGAS

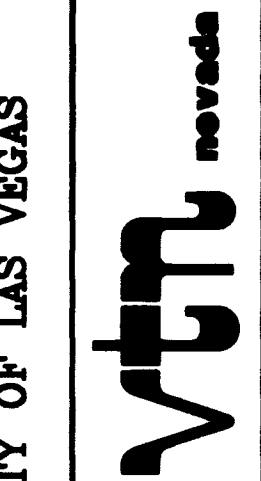

CONSULTING ENGINEERS • PLANNERS • LAND SURVEYORS
2727 SOUTH RAINBOW BOULEVARD
LAS VEGAS, NEVADA 89102-5148 PHONE (702) 873-7550 FAX (702) 362-2597

FIELD INLET LAYOUT PLAN

DURANGO DRIVE IMPROVEMENTS
CHEYENNE AVENUE TO LONE MOUNTAIN ROAD

PROJECT	
SEAL	
NO. NO. 5249	
BY JLWBM,LMW	
DATE 07/17/98	
SCALE HORIZ. 1/4"=1'-0"	
VERT. NONE	
DRAWING	SHEET
D17	23
OF 106 SHEETS	

RECORD DRAWING 03/23/01