




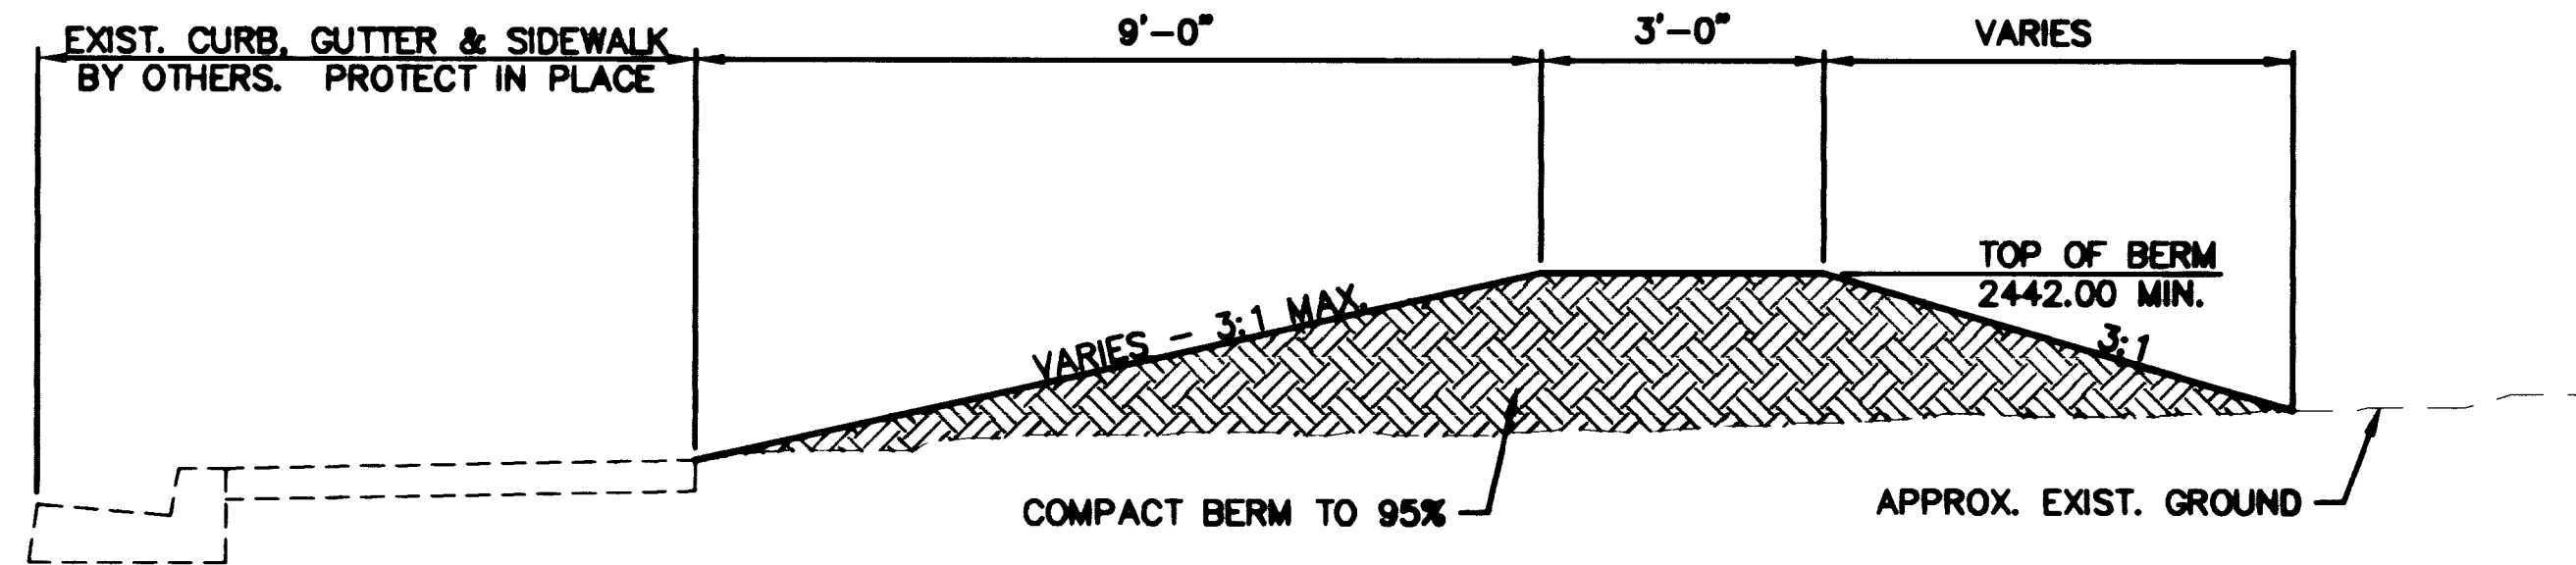


SECTION A-A
SCALE: 1/2"=1'-0"

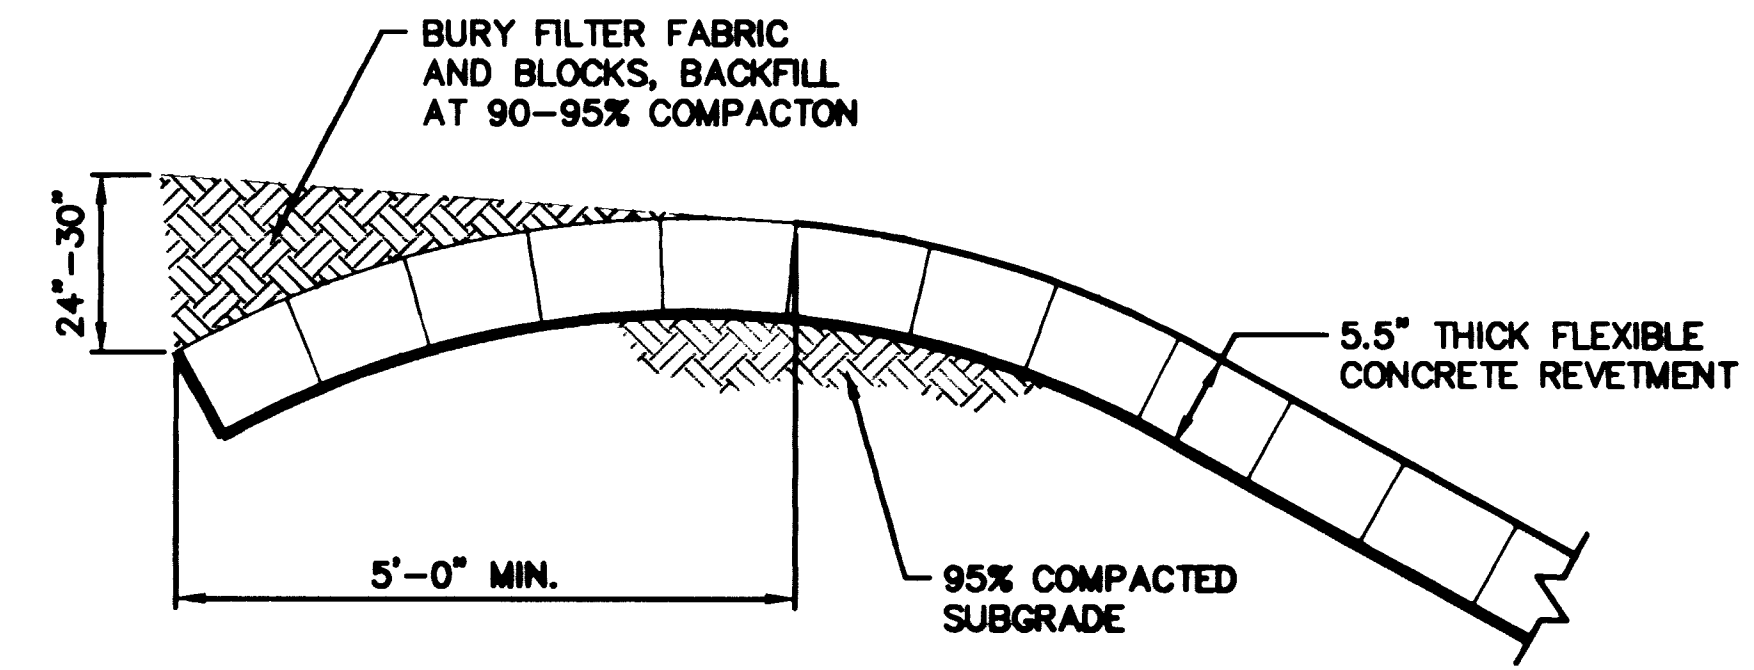


SECTION E-E
SCALE: 1/2"=1'-0"

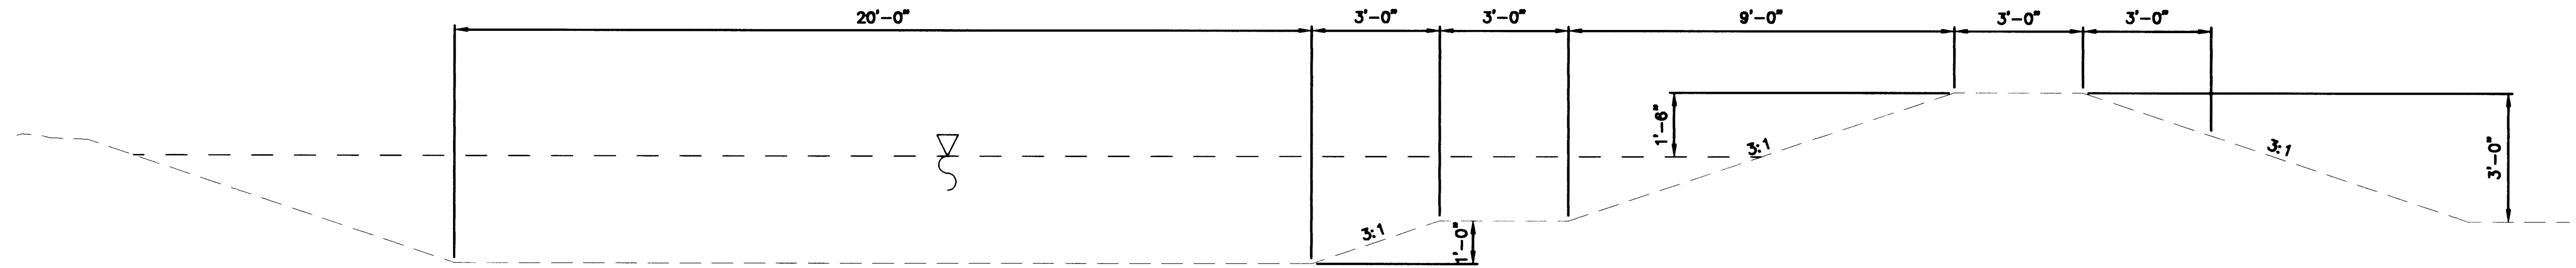

SECTION B-B (BERM & DITCH BY HLA FOR C.L.V. REC. CENTER)
SCALE: 1/2"=1'-0"

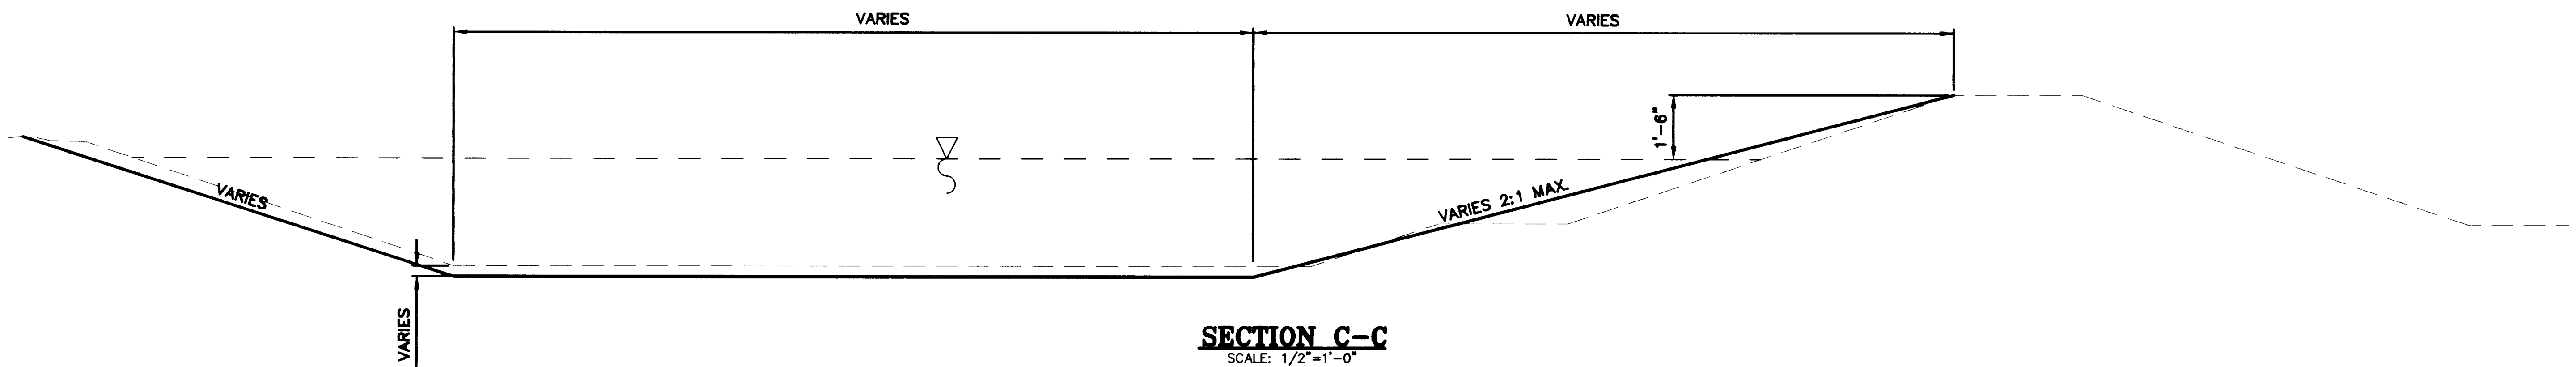

SECTION C-C
SCALE: 1/2"=1'-0"

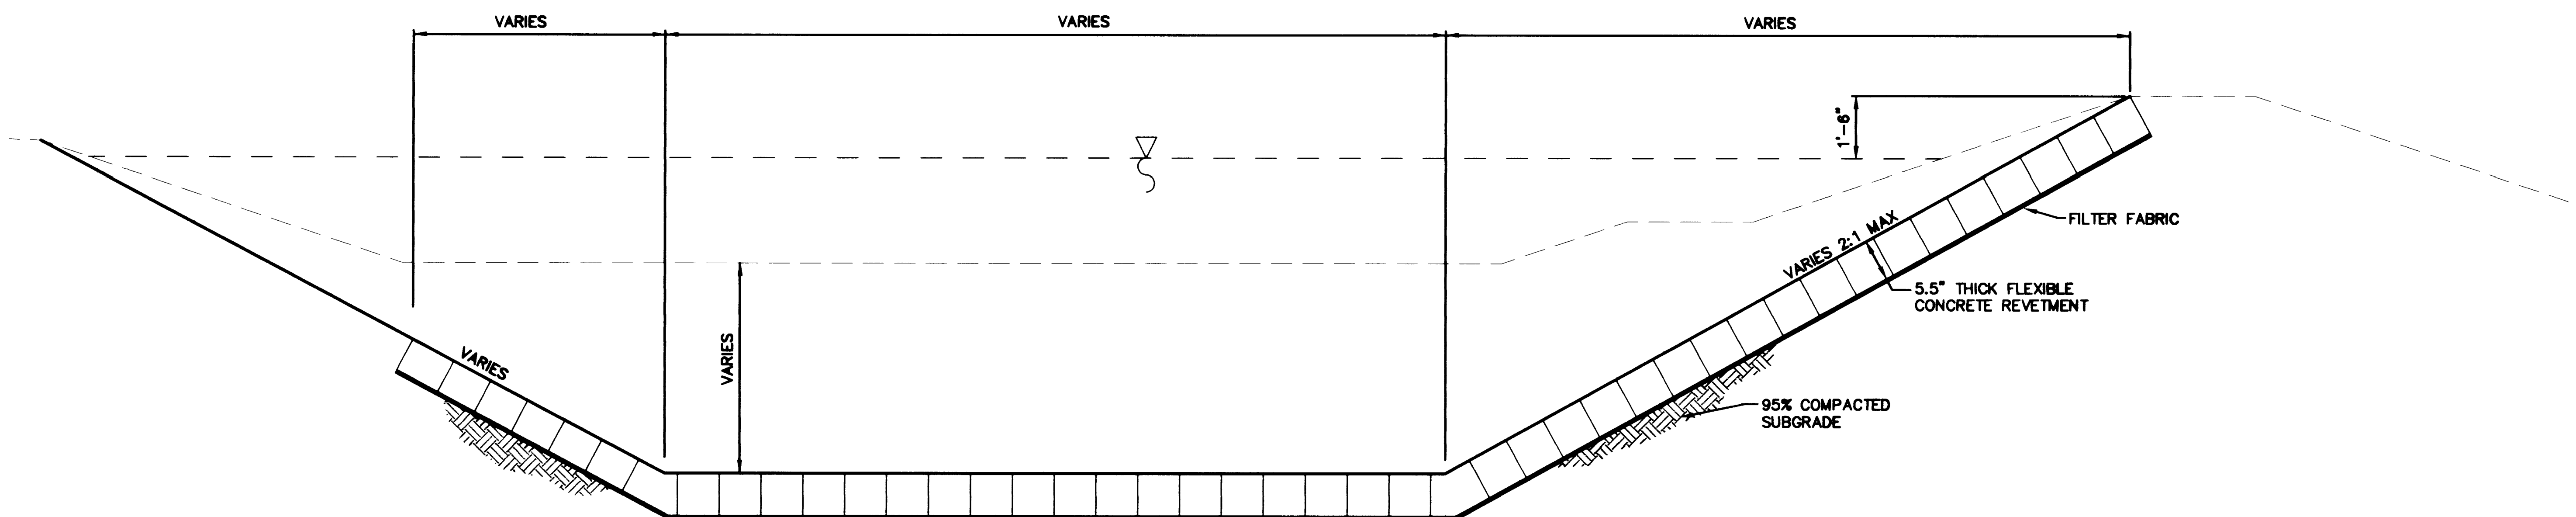

SECTION D-D
SCALE: 1/2"=1'-0"

DEPARTMENT OF PUBLIC WORKS
CITY OF LAS VEGAS



CONSULTING ENGINEERS • PLANNERS • LAND SURVEYORS
2727 SOUTH RAINBOW BOULEVARD
LAS VEGAS, NEVADA 89102-5148 PHONE (702) 873-7550 FAX (702) 362-2597

TYPICAL GRADING SECTIONS

DURANGO DRIVE IMPROVEMENTS
CHEYENNE AVENUE TO LONE MOUNTAIN ROAD

NO. NO. 5249
BY JLWBM,LMW
DATE 07/17/98
SCALE HORIZ. NONE
VERT. NONE
DRAWING D18
SHEET 24 OF 106 SHEETS

RECORD DRAWING 03/23/01