




VIEW "PLT" (MS)  
I:\CAD\WORK\5249\DETAILS\MISC-D22.DWG

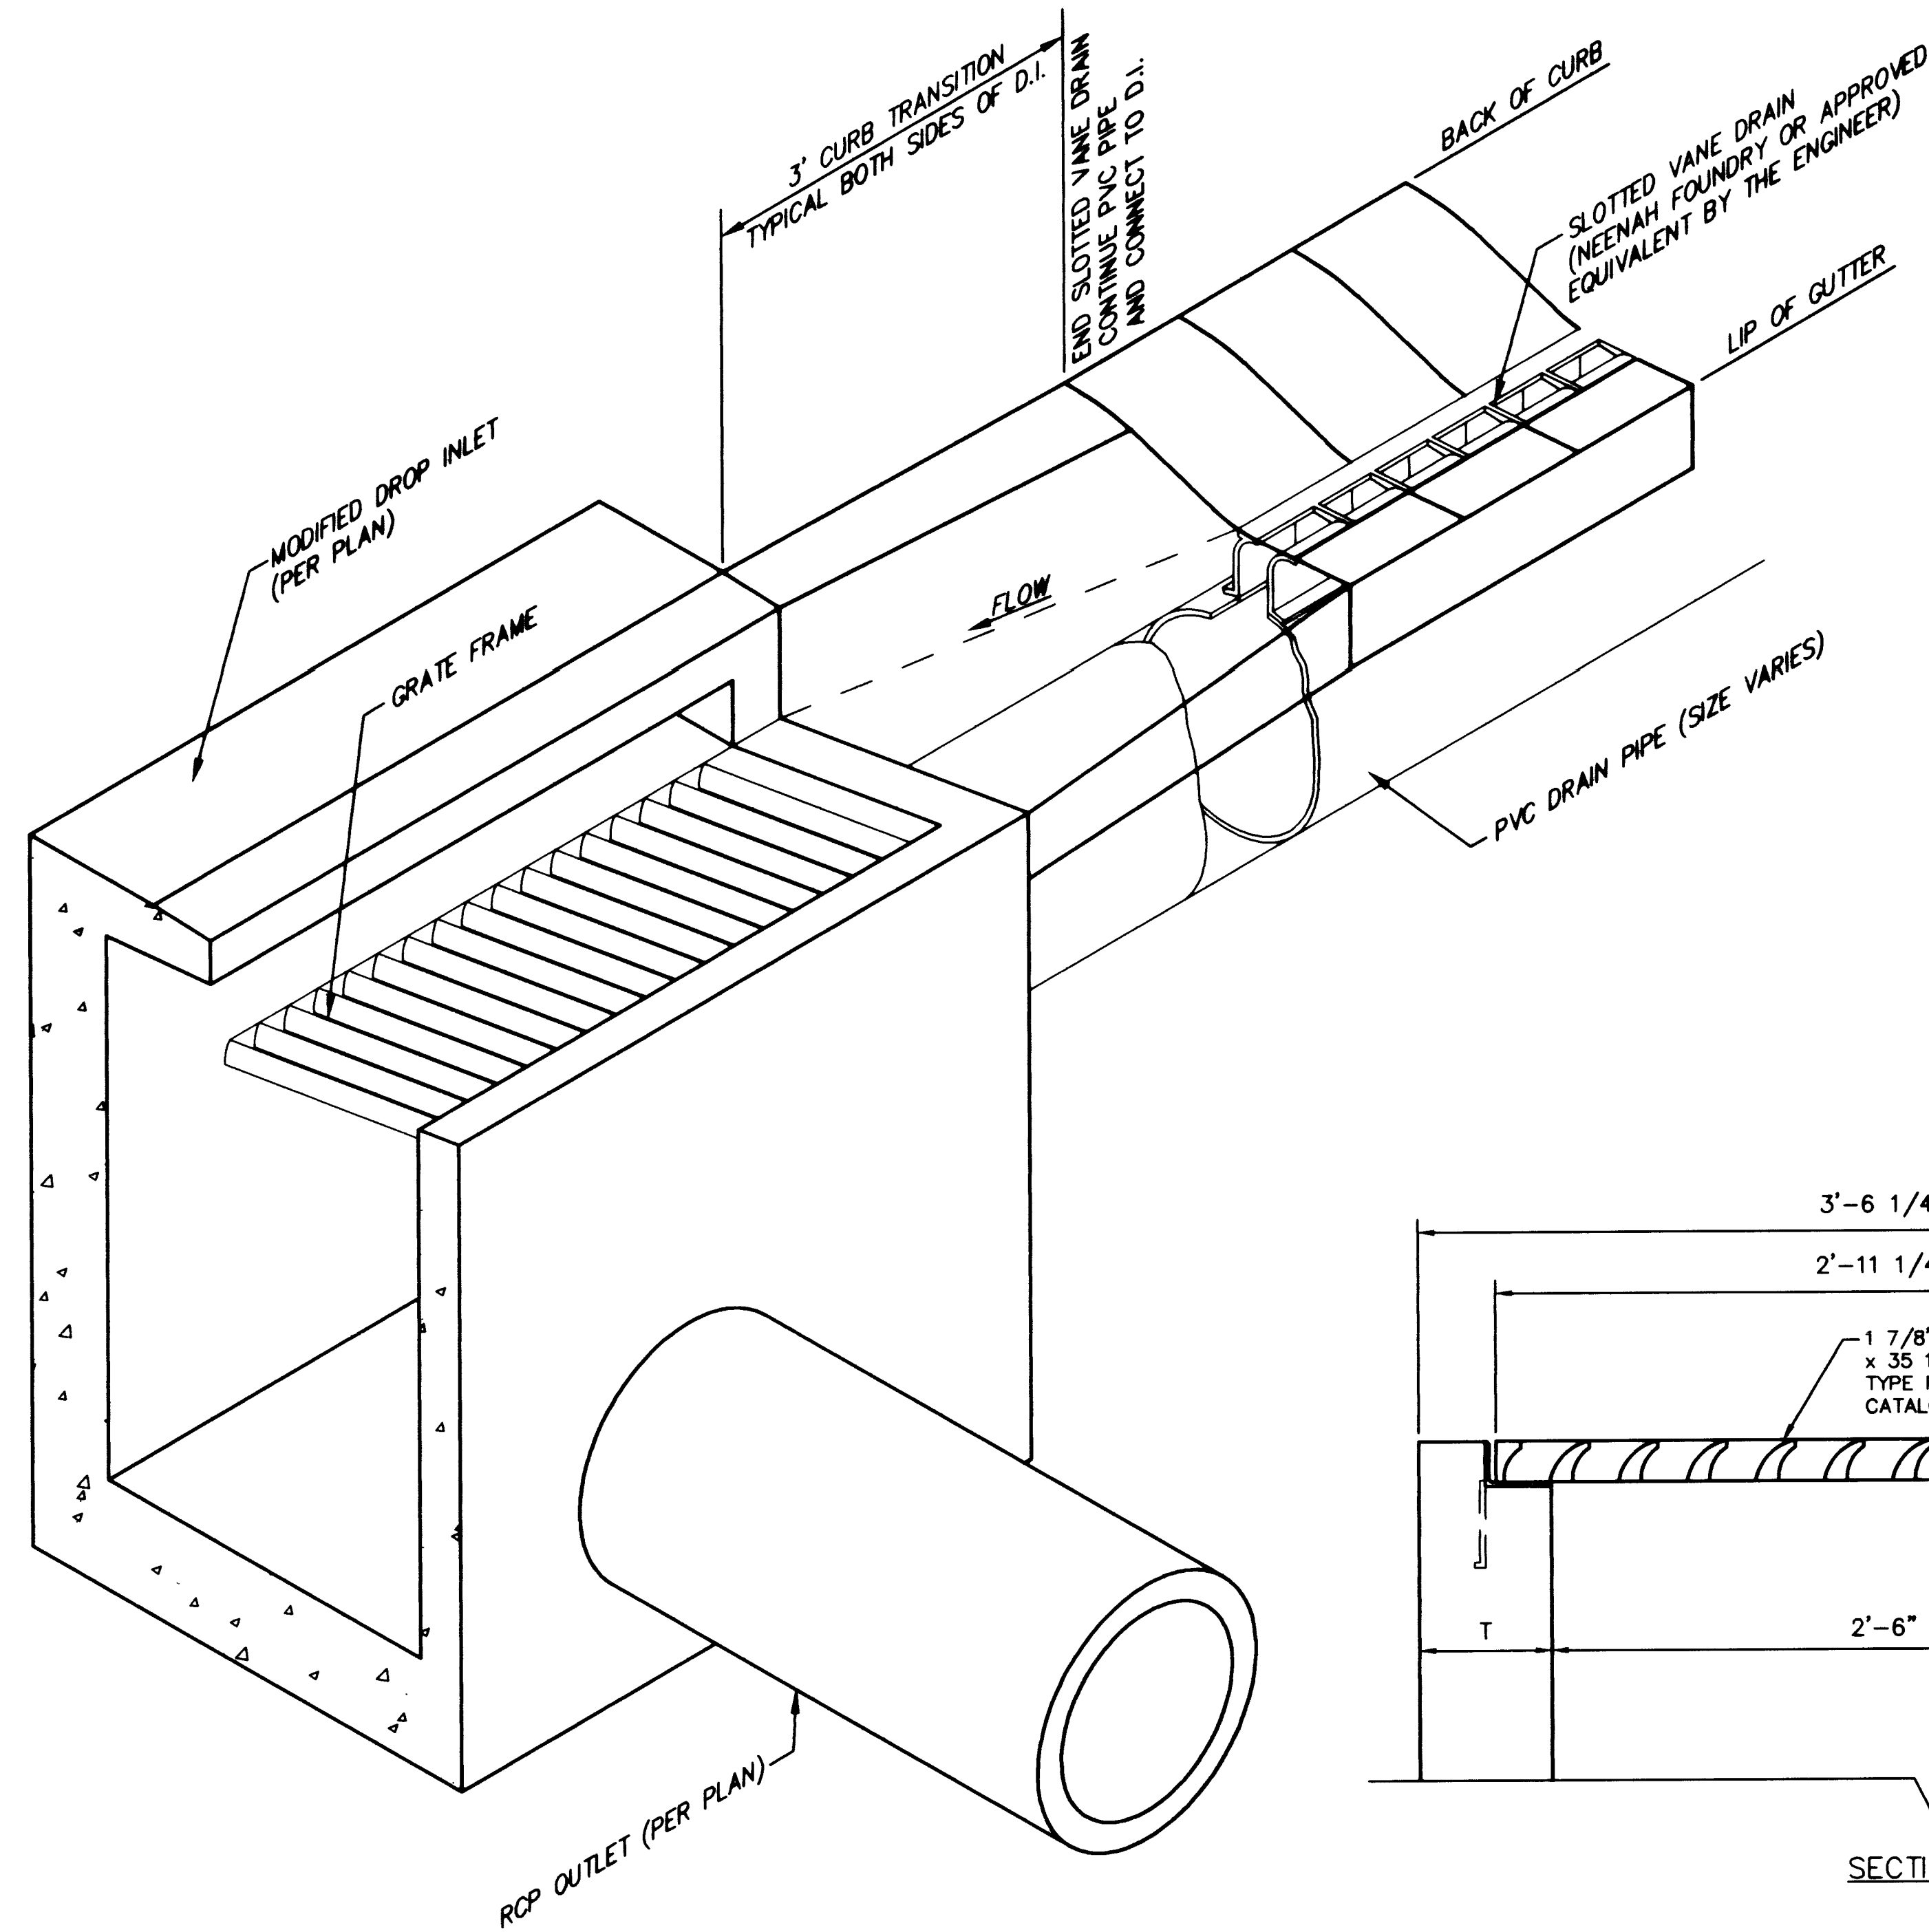


**SPECIAL DROP INLET WITH SLOTTED VANE DRAIN CURB GRATE DETAIL**

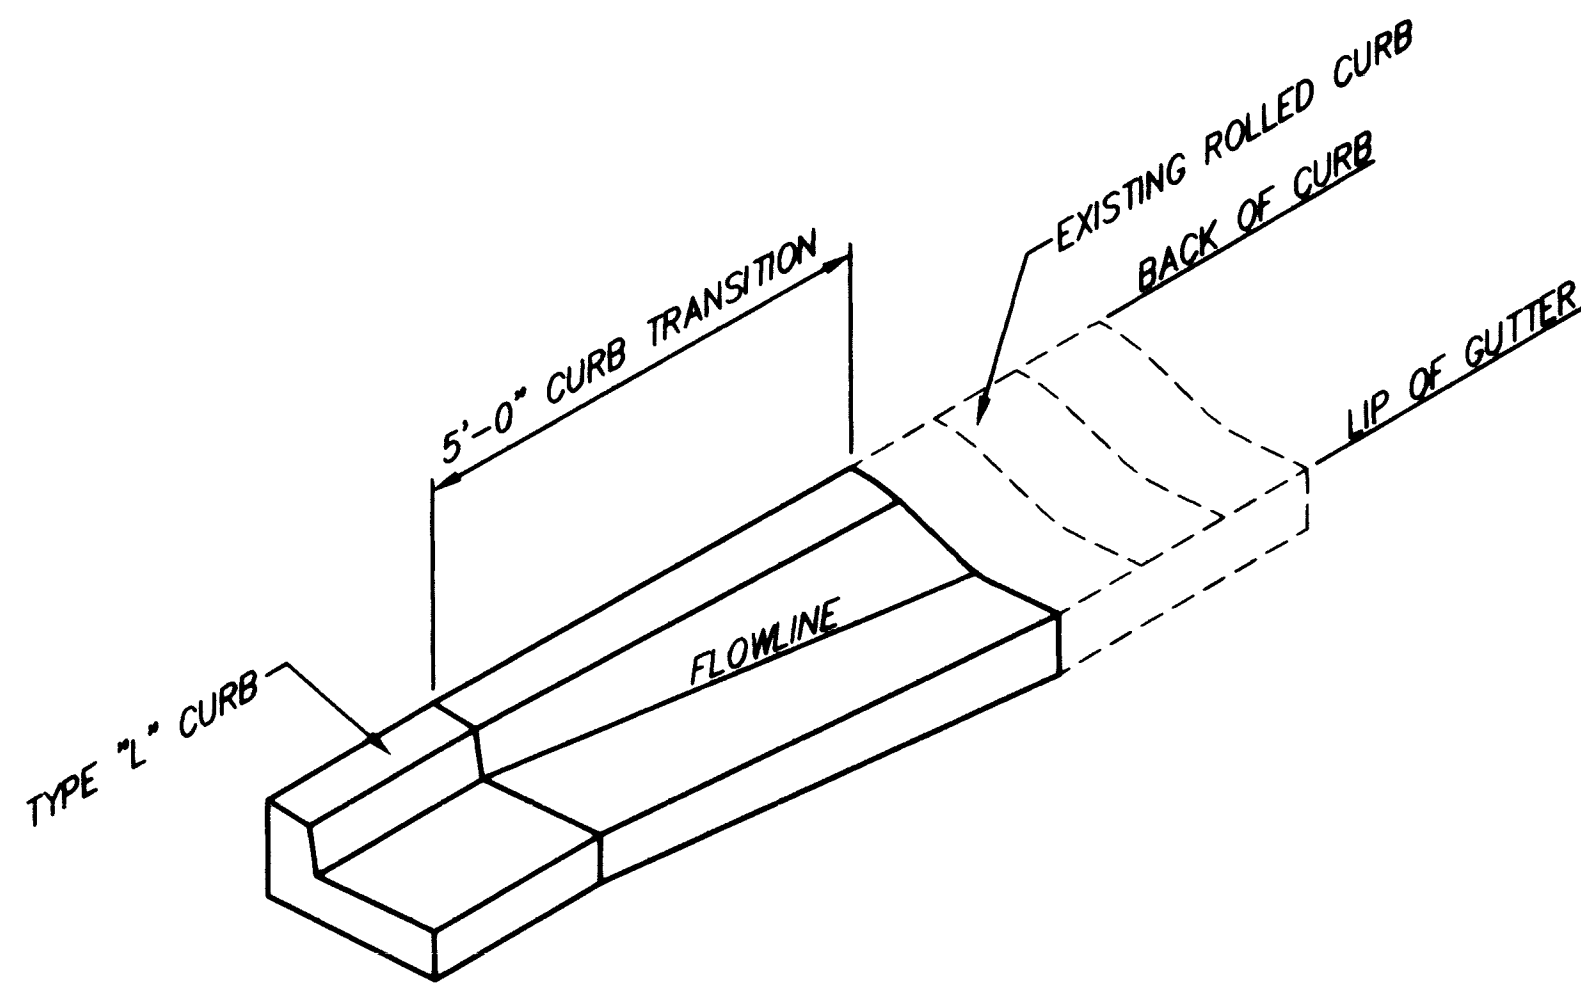


**CURB TRANSITION DETAIL**

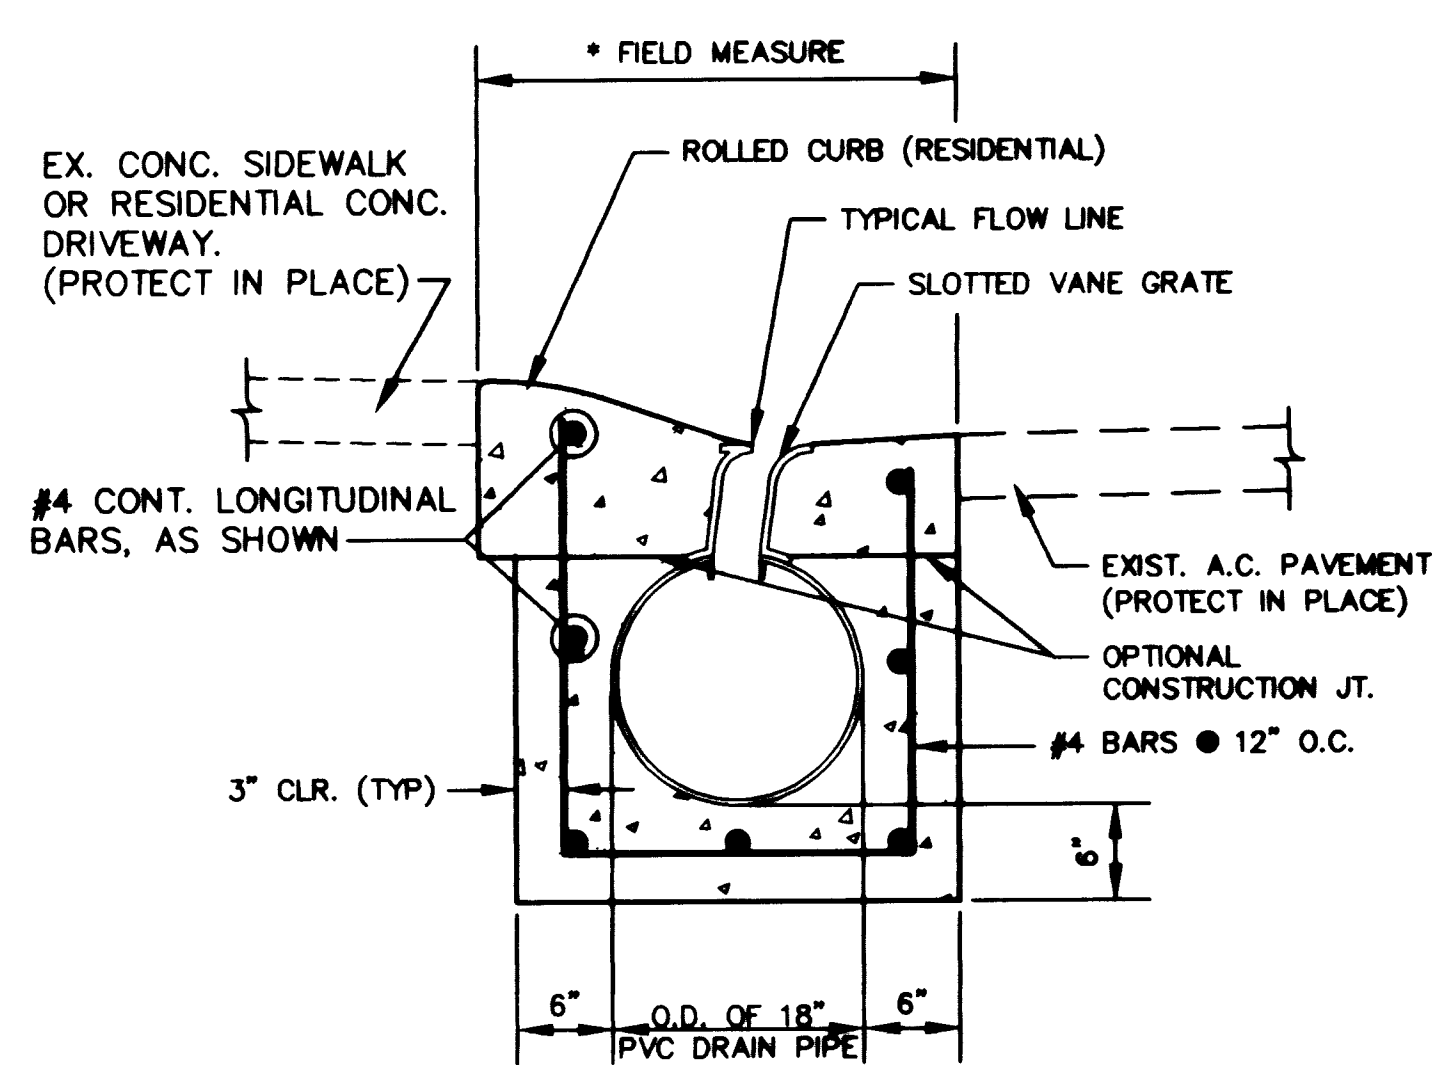


**SLOTTED VANE DRAIN CONCRETE ENCASEMENT DETAIL  
● ROLLED CURB**

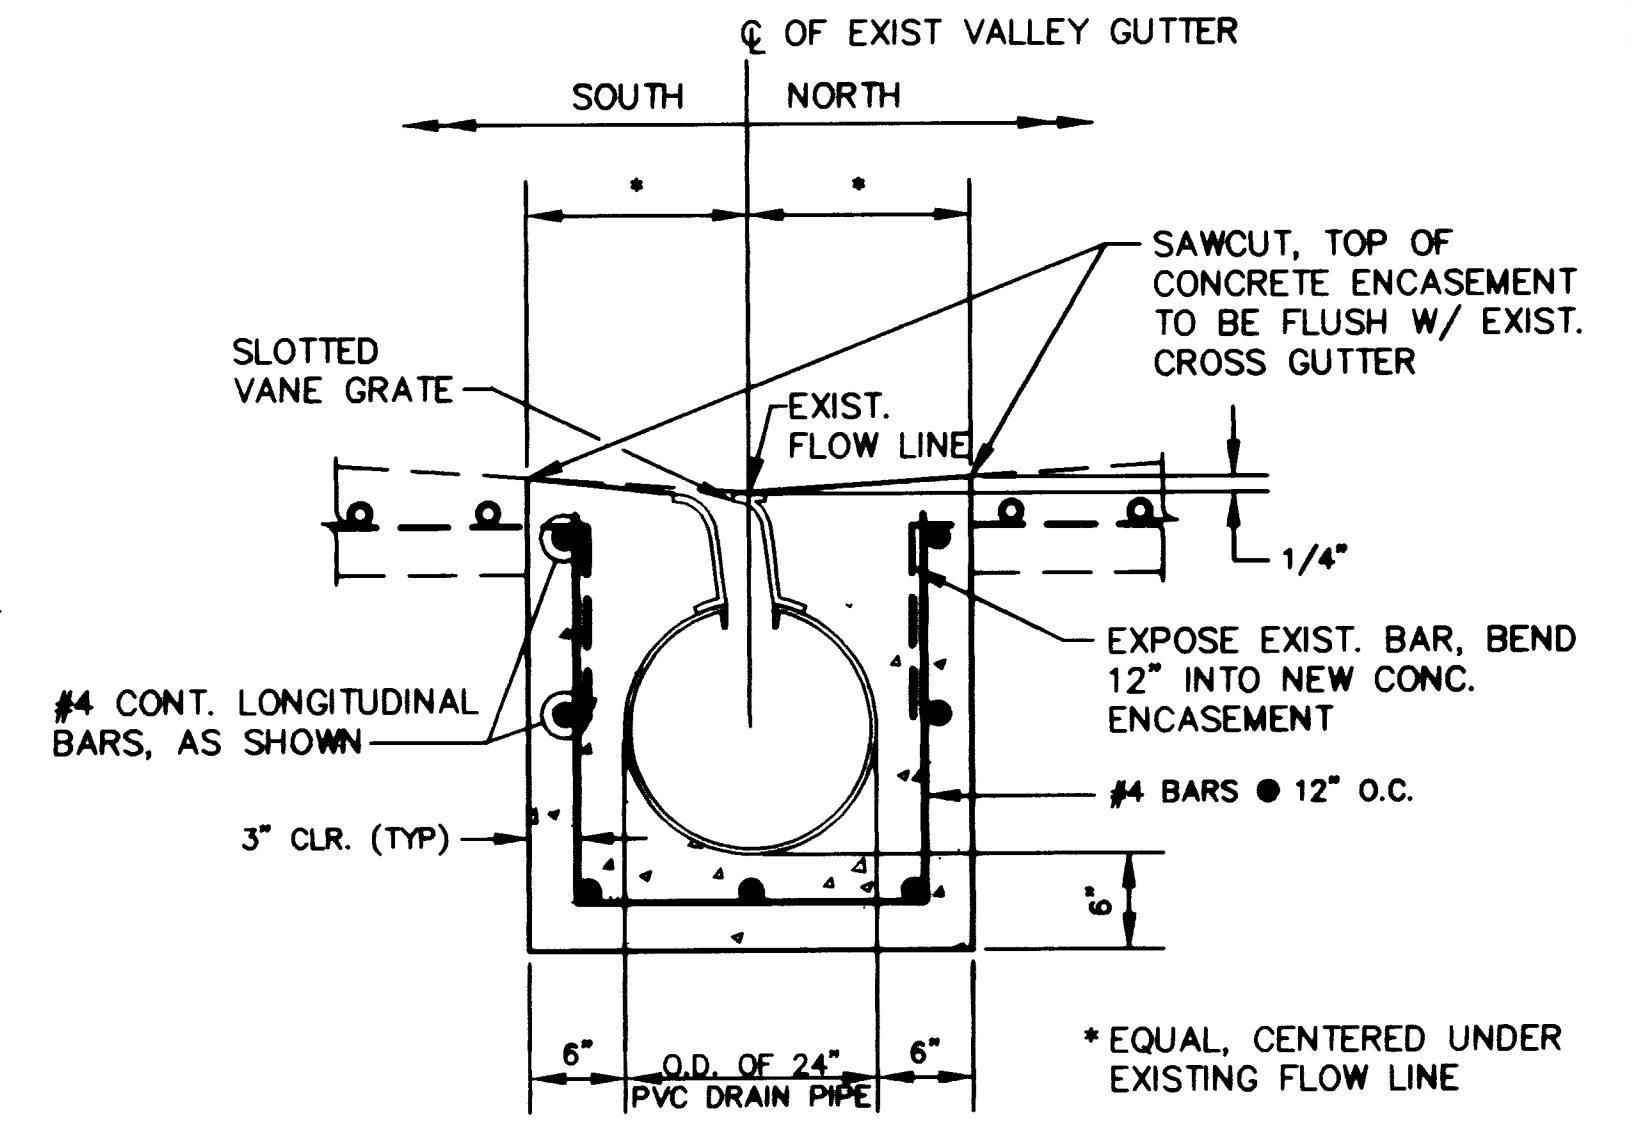


**SLOTTED VANE DRAIN CONCRETE ENCASEMENT DETAIL  
● EXISTING VALLEY GUTTER**

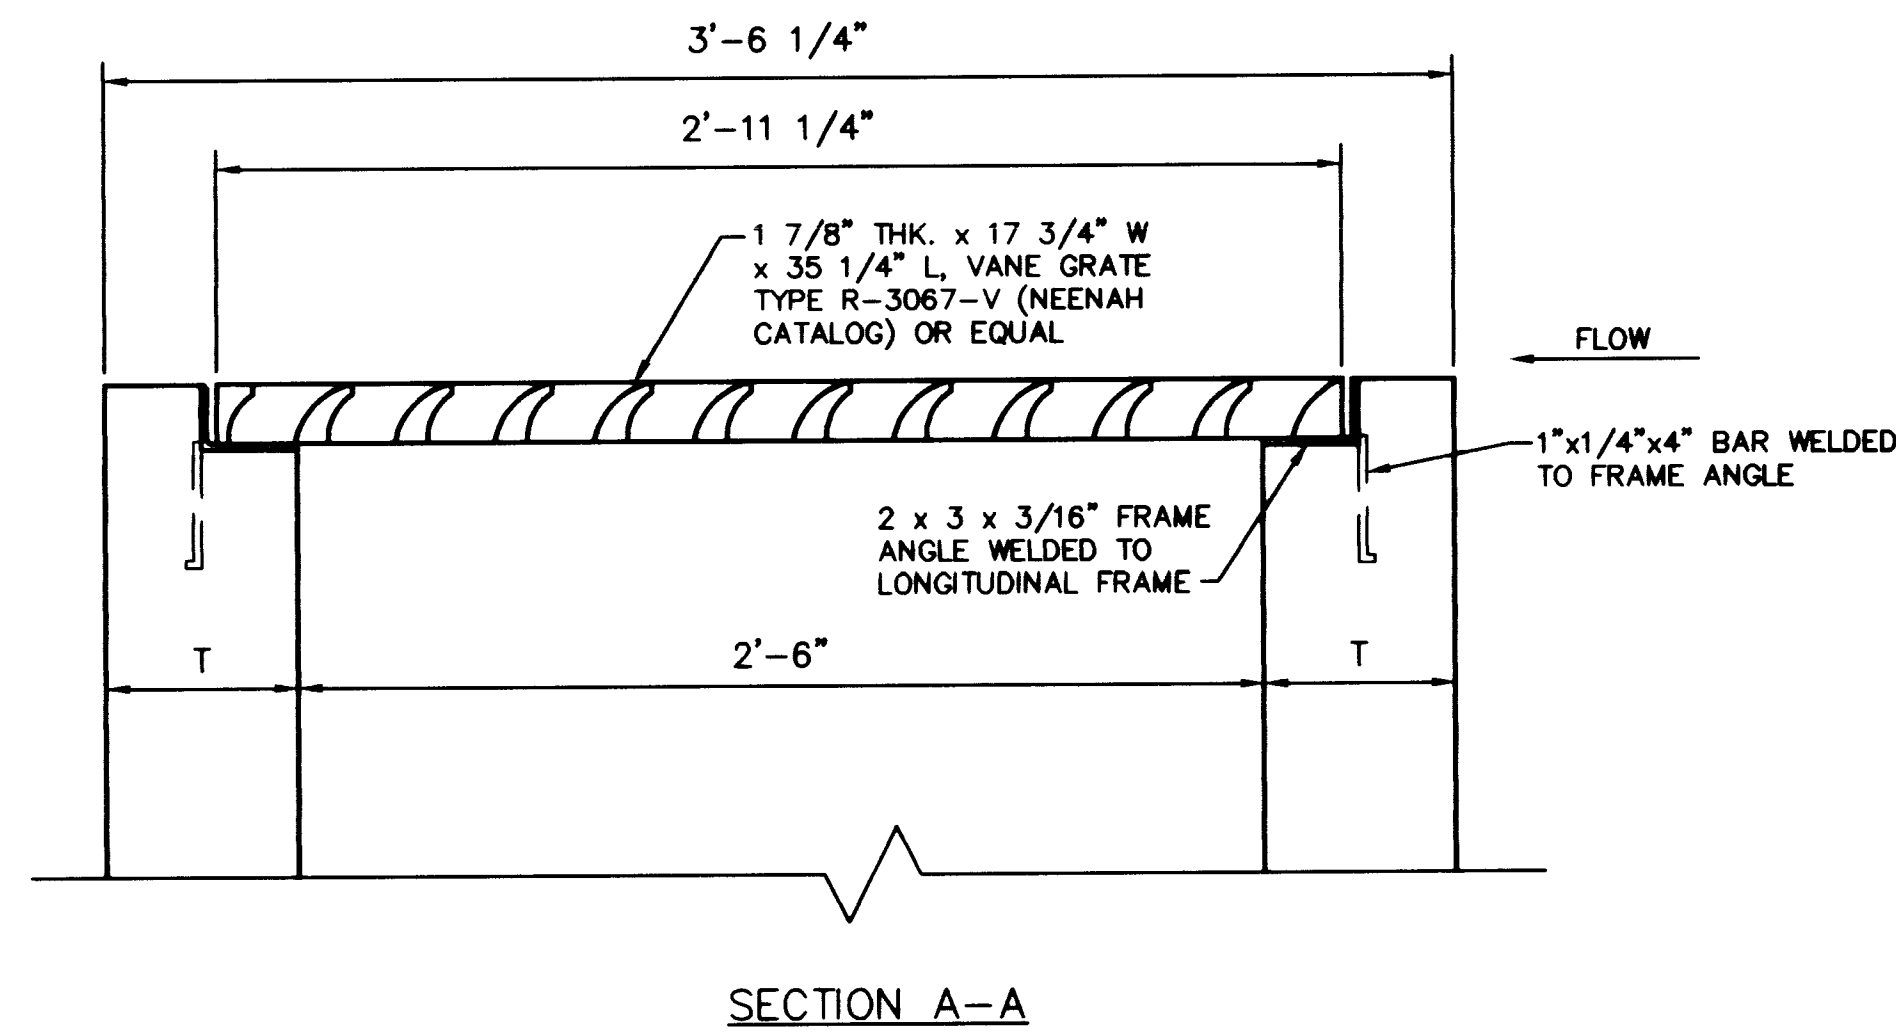


**SECTION A-A**

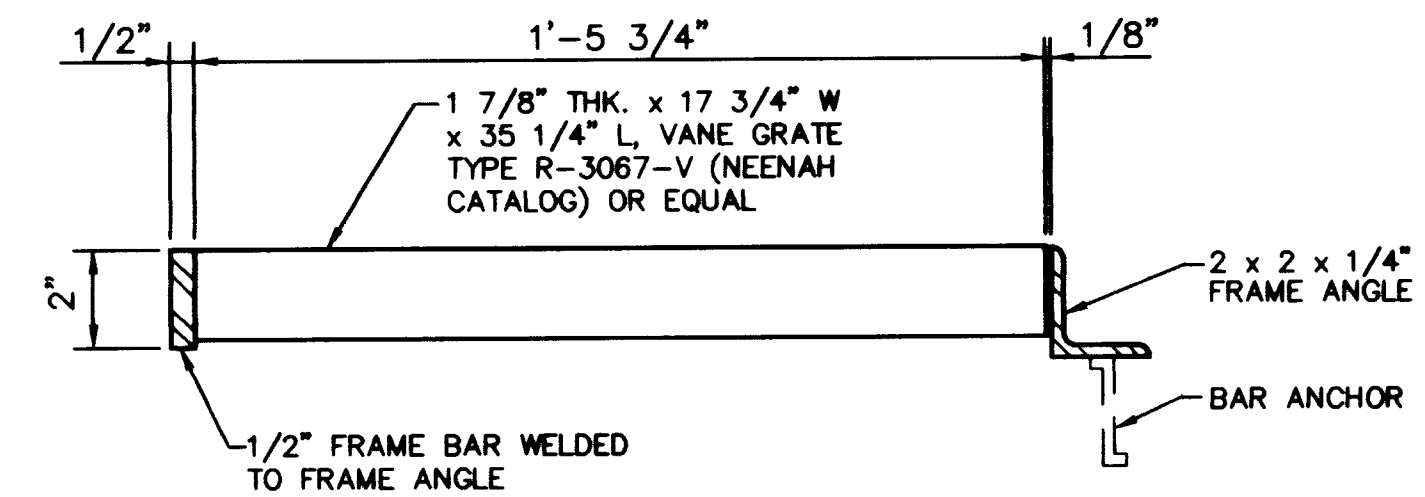

**SECTION B-B**

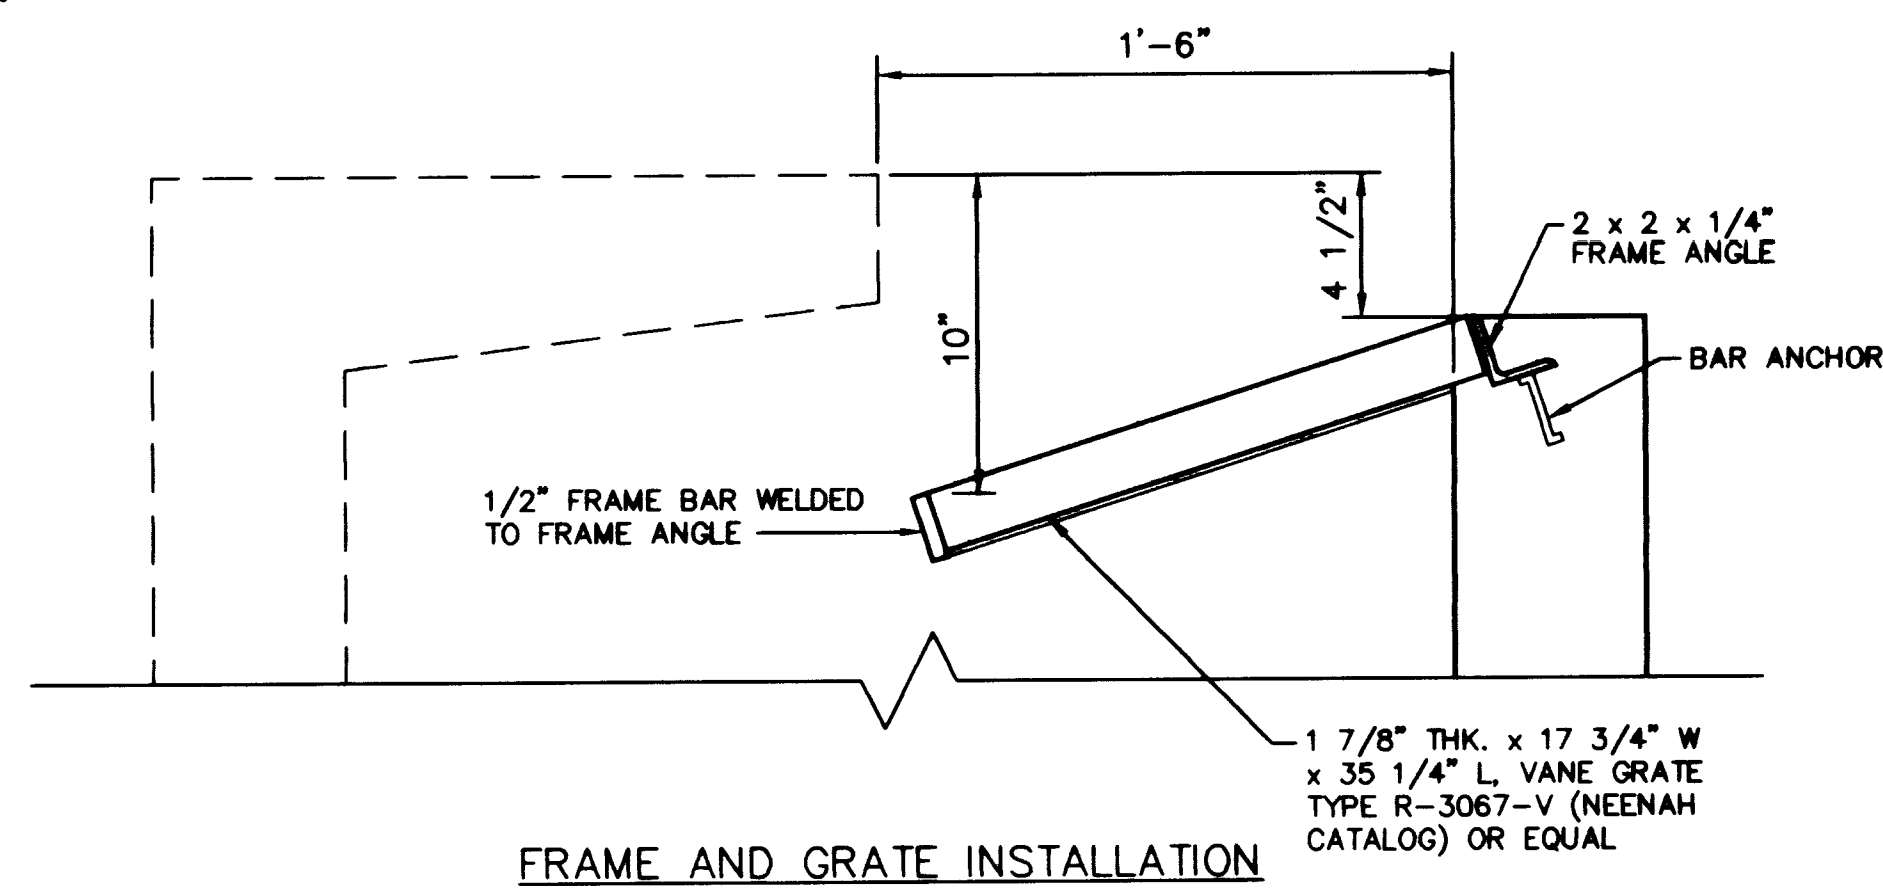

**FRAME AND GRATE INSTALLATION**

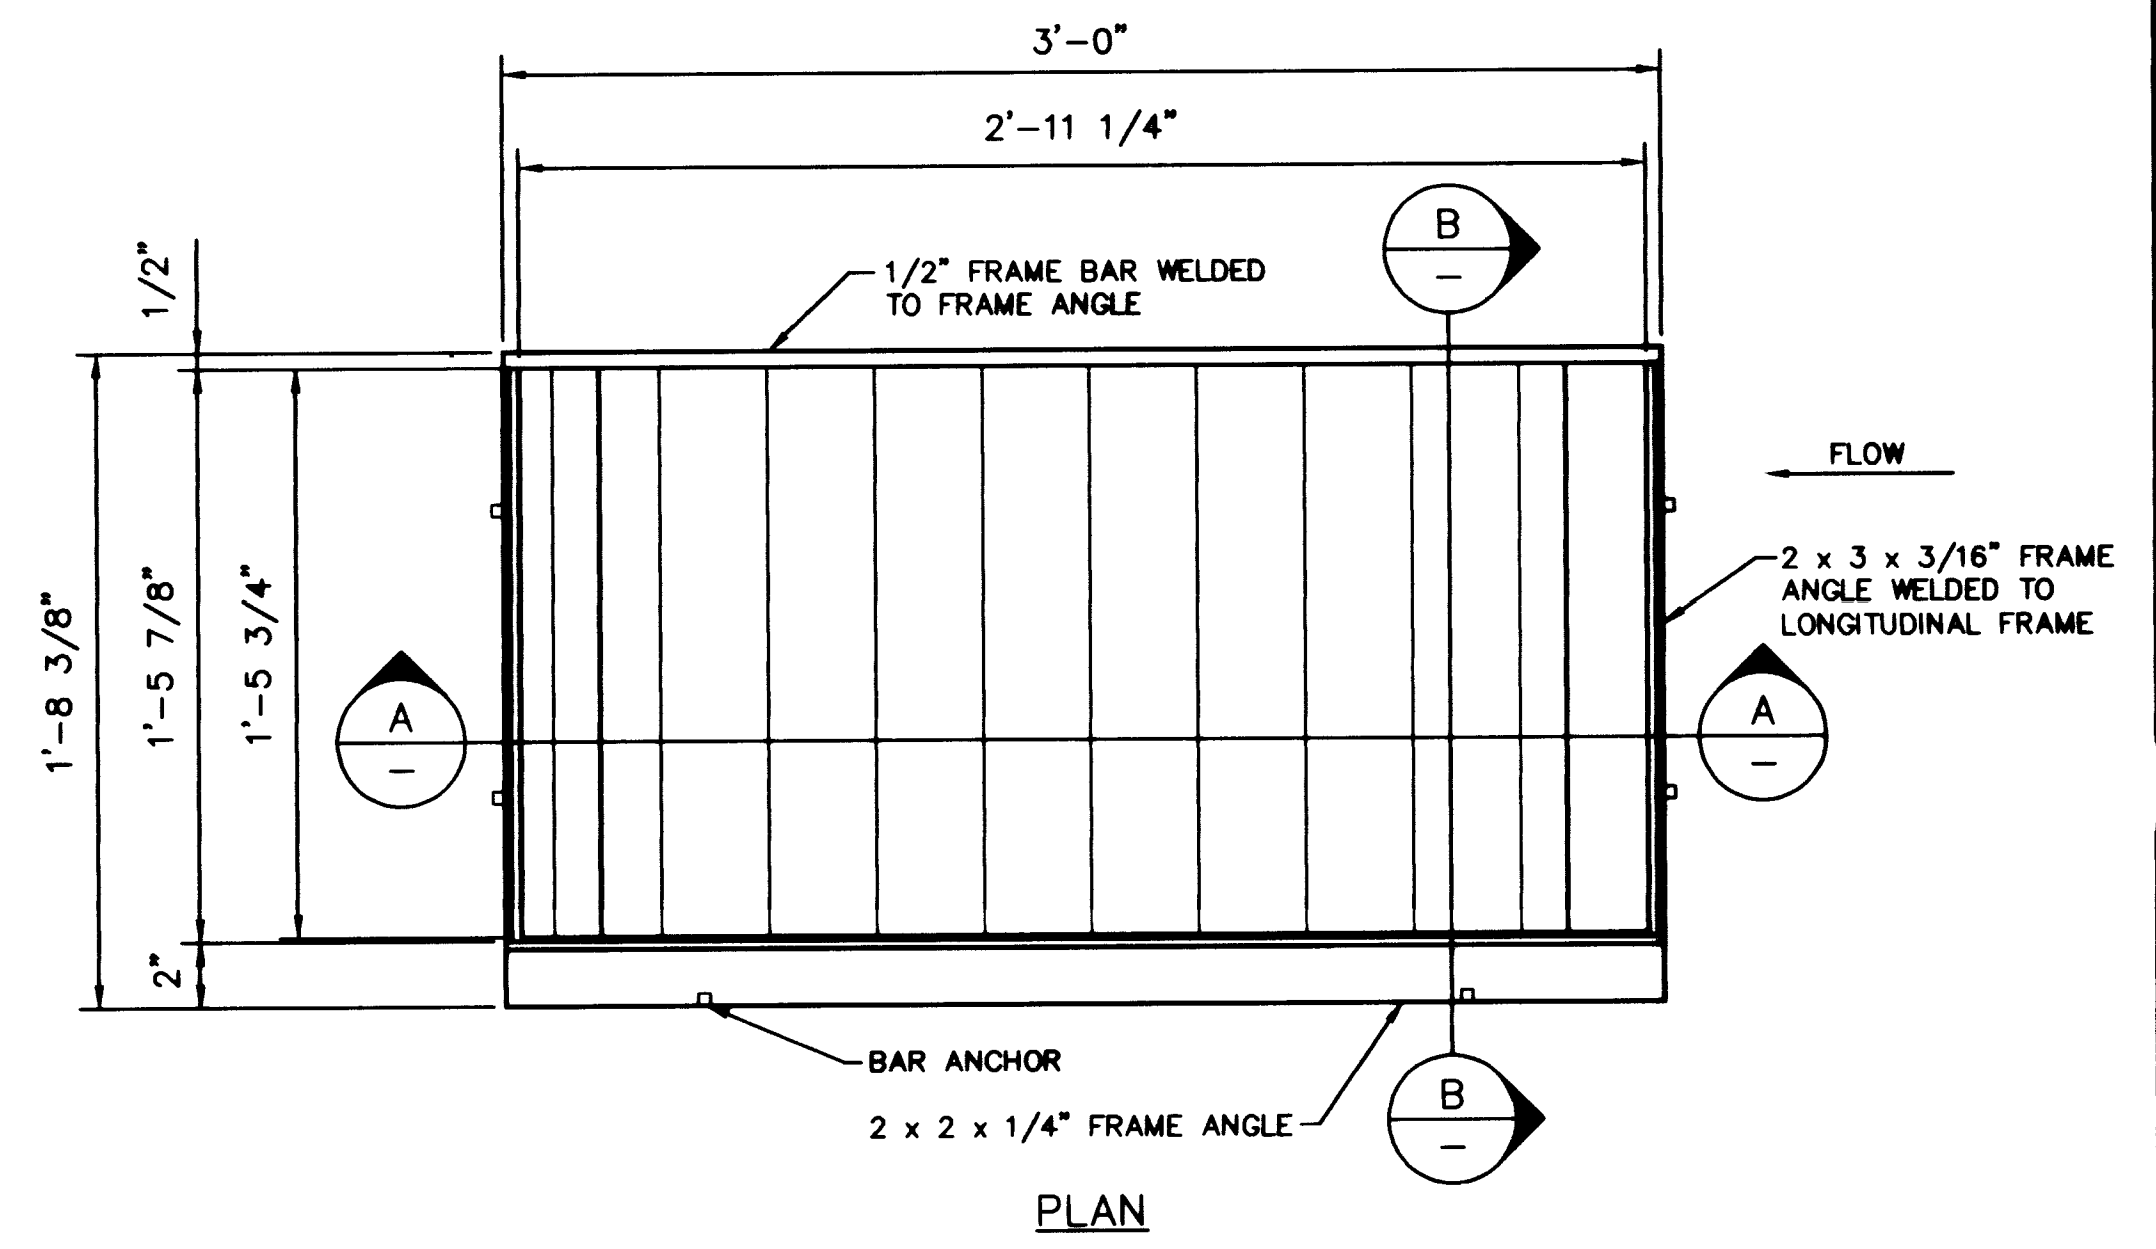

**PLAN**

**3 TYPE "CM1" AND "DM1" DROP INLET FRAME AND GRATE**  
NO SCALE

DEPARTMENT OF PUBLIC WORKS  
CITY OF LAS VEGAS

**vtn** nevada

CONSULTING ENGINEERS ● PLANNERS ● LAND SURVEYORS  
2727 SOUTH RAINBOW BOULEVARD  
LAS VEGAS, NEVADA 89102-5148 PHONE (702) 873-7550 FAX (702) 362-2597

MISCELLANEOUS  
STORM DRAIN DETAILS

PROJECT  
**DURANGO DRIVE IMPROVEMENTS**  
CHEYENNE AVENUE TO LONE MOUNTAIN ROAD

SEAL

WO. NO. 5249

BY JL, WBM

DATE 07/17/98

SCALE HORIZ. NONE

VERT. NONE

DRAWING D22

SHEET 28

106 SHEETS

RECORD DRAWING 03/23/01

32212