
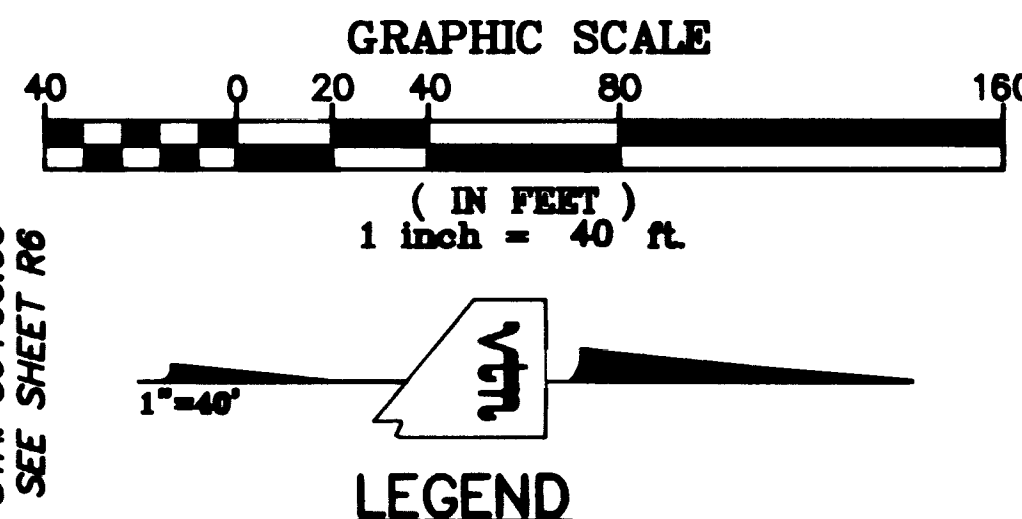


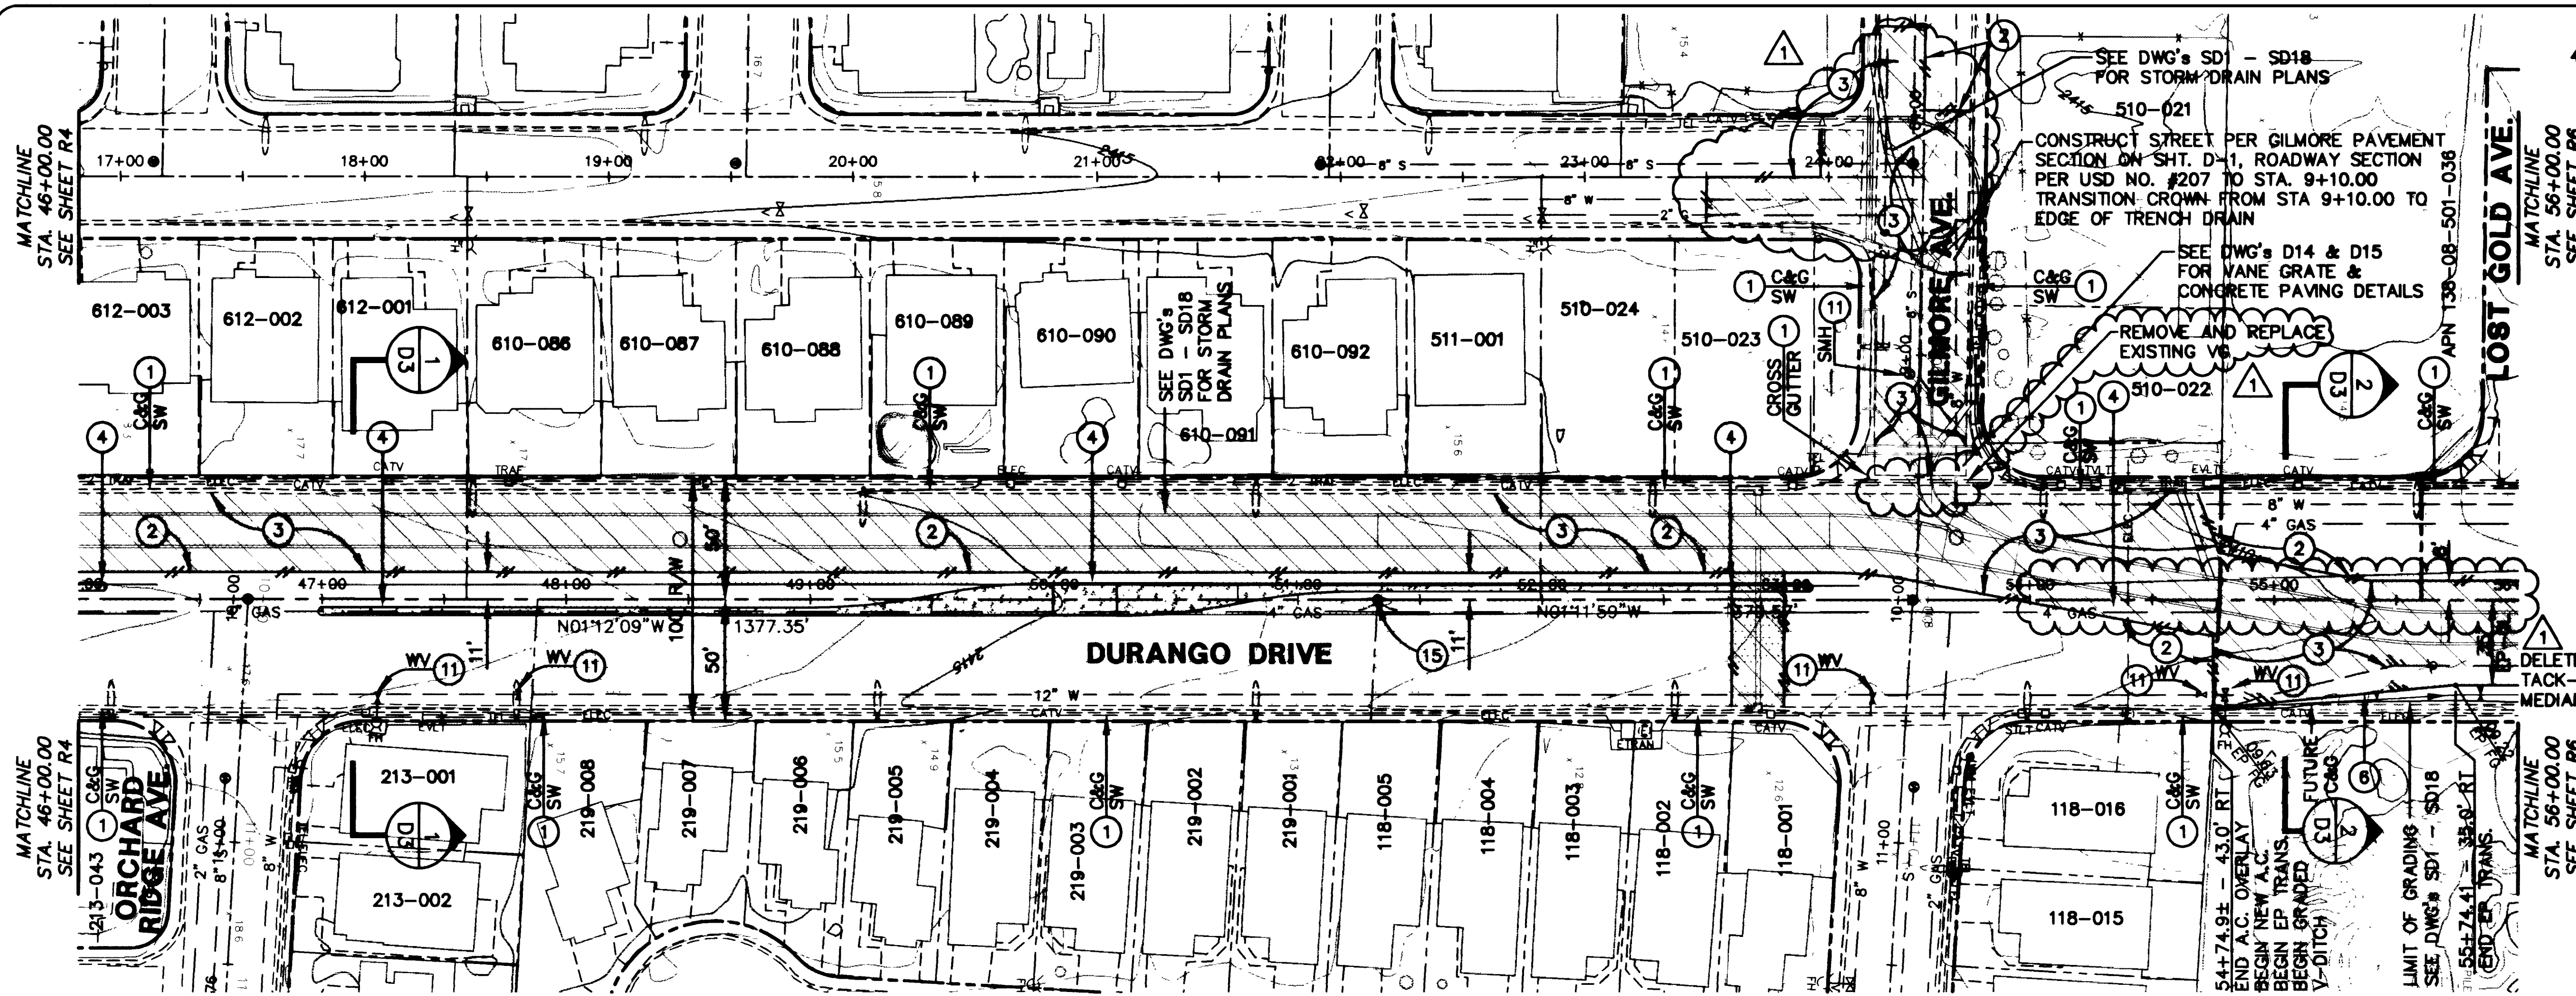


- LEGEND**
- NEW A.C. PAVEMENT (SEE TYPICAL X-SECTIONS)
 - EXISTING A.C. PAVEMENT TO BE REMOVED
 - EXISTING A.C. PAVEMENT TO REMAIN WITH NEW A.C. OVERLAY (SEE TYPICAL X-SECTIONS)
 - NEW TEMPORARY A.C. (SEE TYPICAL X-SECTIONS)
 - NEW CONCRETE MEDIAN

APPROVED

LAS VEGAS VALLEY WATER DISTRICT DATE

CONSTRUCTION NOTES

- PROTECT IN PLACE
 - SAWCUT & MATCH
 - REMOVE EXISTING A.C., AGGREGATE BASE AND/OR CONCRETE
 - CONSTRUCT MEDIAN ISLAND SEE MEDIAN ISLAND GEOMETRICS AND IRRIGATION PLAN DWG'S R17 - R21
 - CONSTRUCT PAVEMENT CROWN TRANSITION SEE MEDIAN ISLAND GEOMETRICS AND IRRIGATION PLAN DWG'S R17 - R21
 - EDGE OF NEW A.C. PAVEMENT
 - REMOVE A.C. WALKWAY
 - CONSTRUCT "L" TYPE CURB AND GUTTER PER USD NO. 216
 - CONSTRUCT CURB AND GUTTER AND SIDEWALK RAMP CASE II PER USD NO. 235
 - 18" CMP
 - ADJUST TO FINISH GRADE
 - CONSTRUCT 6" TYPE II AGGREGATE BASE AT 95% COMPACTION
 - RELOCATE
 - CONSTRUCT MEDIAN ISLAND IRRIGATION FACILITIES FOR FUTURE CONNECTION SEE MEDIAN ISLAND GEOMETRICS AND IRRIGATION PLAN DWG'S R17 - R21
 - REESTABLISH SURVEY MONUMENT TO FINISH GRADE PER STANDARD DWGS. AND STANDARD SPECS.
 - ESTABLISH SURVEY MONUMENT TO FINISH GRADE PER STANDARD DWGS. AND STANDARD SPECS.
 - CONSTRUCT CURB AND GUTTER AND MODIFIED SIDEWALK RAMP CASE II PER DETAIL 6 ON SHT D24
 - CONSTRUCT GUARDRAIL SEE DWG SD13
- FOR STRIPING, STREET LIGHTS AND TRAFFIC SIGNAL PLANS SEE DWG'S T1 - T15**

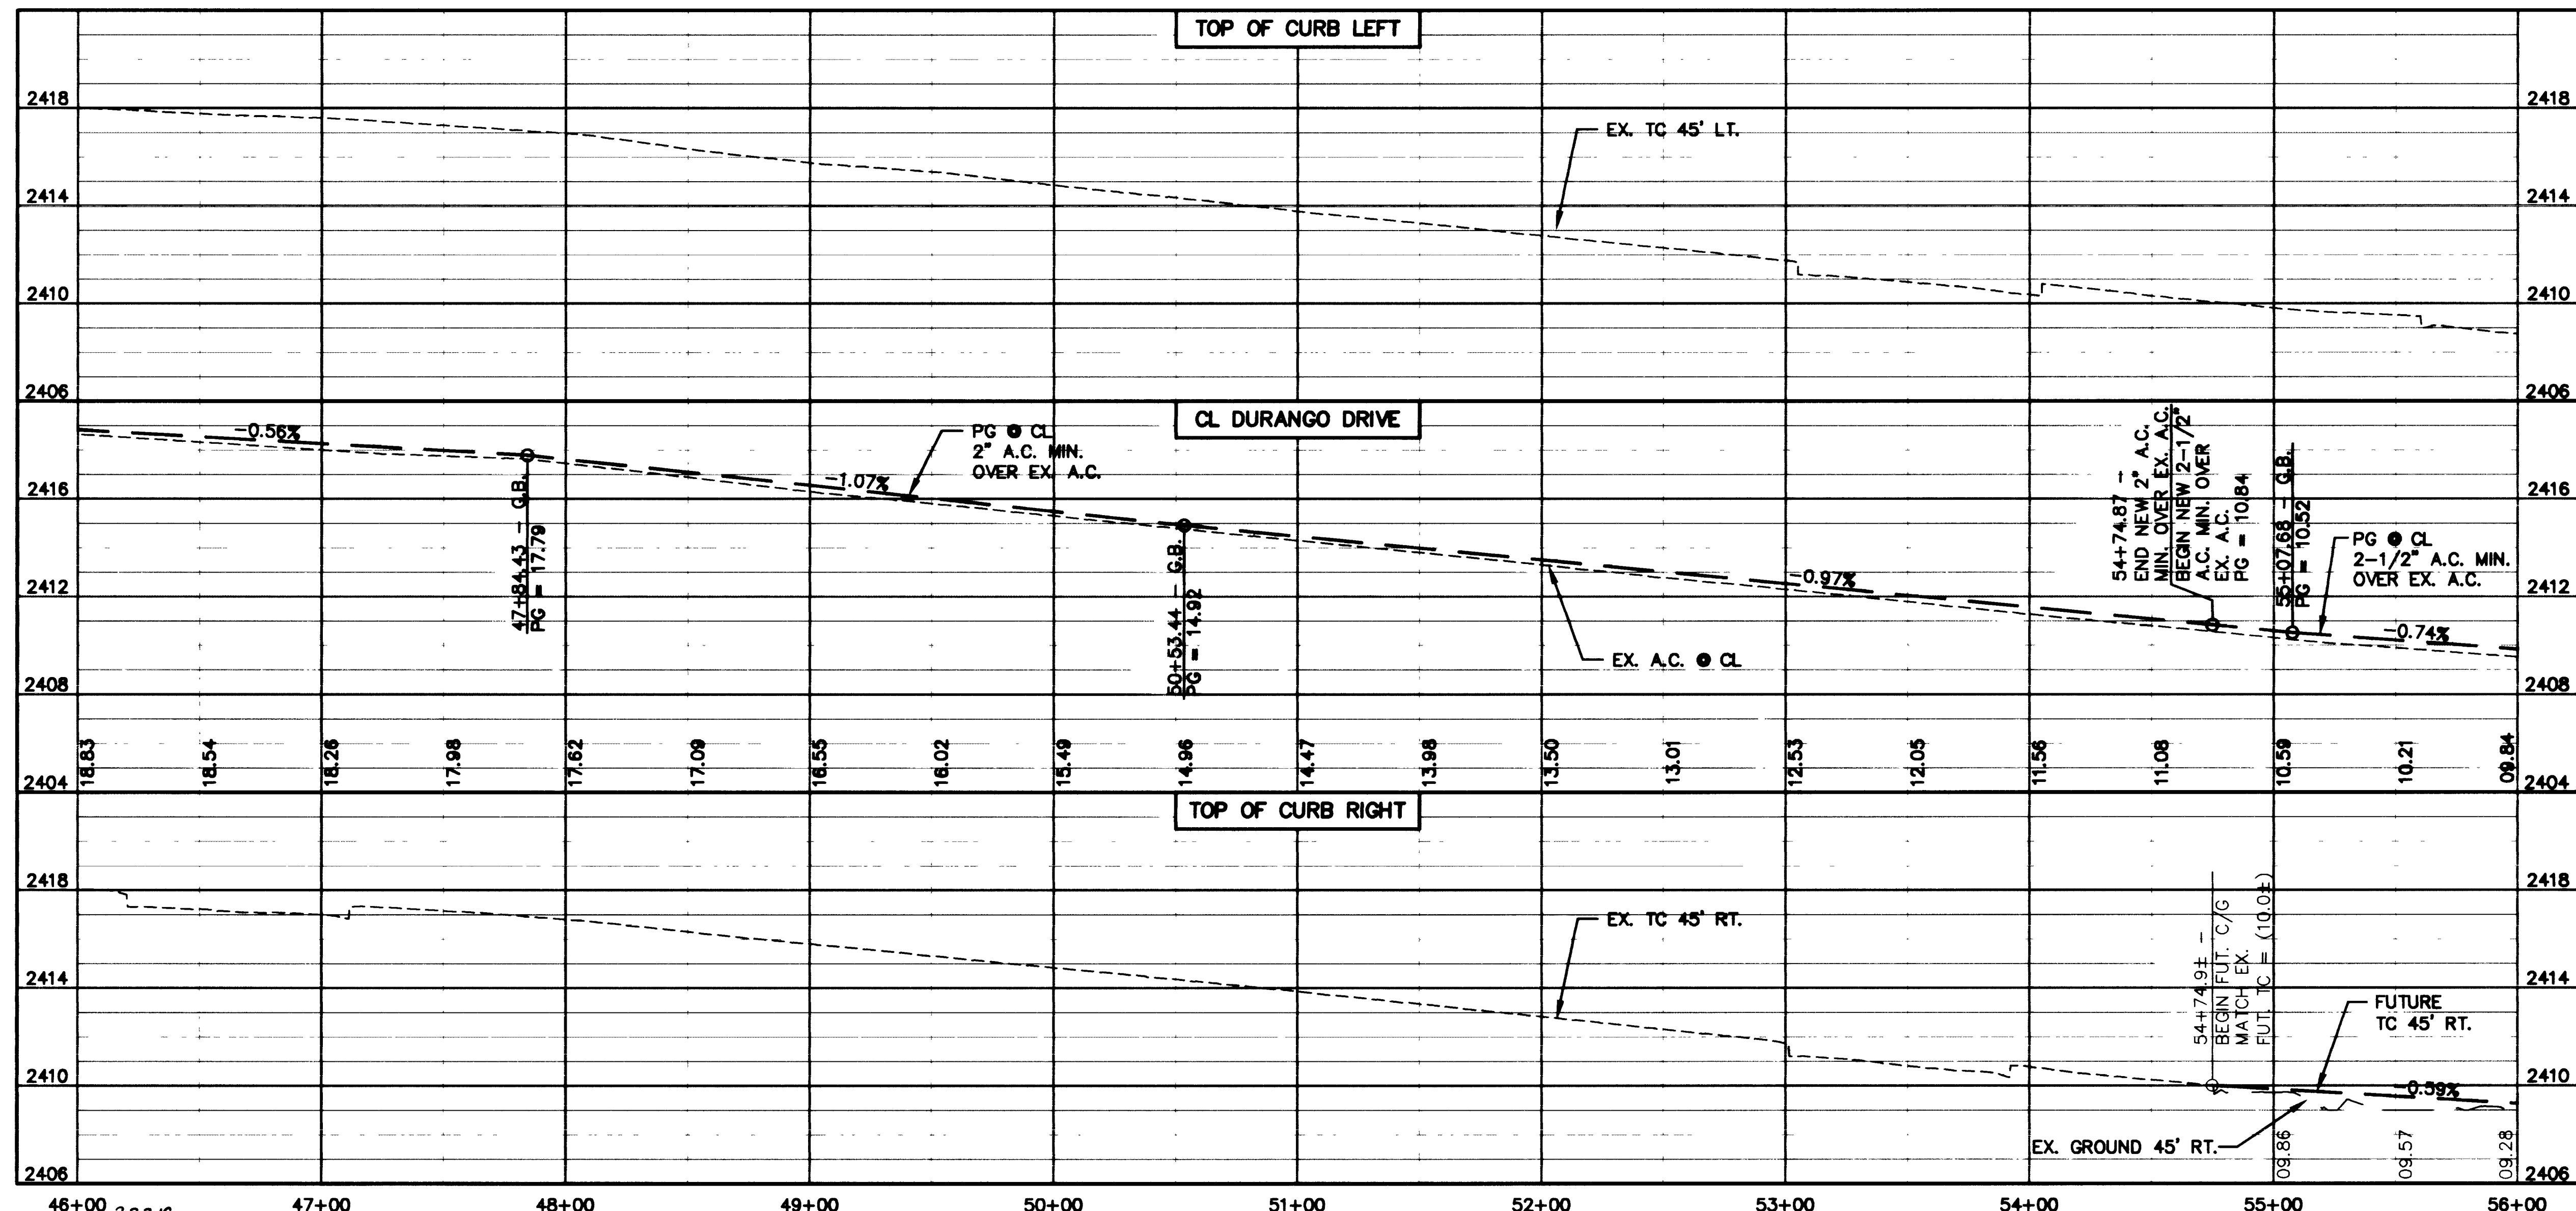

CONSULTING ENGINEERS • PLANNERS • LAND SURVEYORS
2727 SOUTH RAINBOW BOULEVARD
LAS VEGAS, NEVADA 89102-5148 PHONE (702) 873-7550 FAX (702) 362-2597

DEPARTMENT OF PUBLIC WORKS
CITY OF LAS VEGAS, NEVADA

REVISION

NO.	DATE	BY	REVISION
1	2/19/01	WJO	REMOVED PER AS-BUILT'S

ROADWAY PLAN AND PROFILE
STA. 46+00.00 TO STA. 56+00.00
DURANGO DRIVE
CHEYENNE AVENUE TO LONE MOUNTAIN ROAD

PROJECT

SEAL

NO. NO. 5249

BY JL/TMM

DATE 07/17/98

SCALE HORIZ. 1"=40' VERT. 1"=4'

DRAWING R5 SHEET 35 OF 106 SHEETS