

FOR V-DITCH GRADING PLANS
SEE DRAWINGS V1 THRU V5


LEGEND

- NEW A.C. PAVEMENT
(SEE TYPICAL X-SECTIONS)
- EXISTING A.C. PAVEMENT OR
CONCRETE TO BE REMOVED
- NEW CONCRETE DRIVEWAY
- NEW TYPE II DRIVEWAY


CONSTRUCTION NOTES

- 1 PROTECT IN PLACE
- 2 SAWCUT AND MATCH
- 4 CONSTRUCT RESIDENTIAL DRIVEWAY PER USD NO. 223
- 23 REMOVE
- 30 REMOVE AND RECONSTRUCT CONCRETE DRIVEWAY
TO NEW GRADE, SEE DETAIL ON DWG D15
- 31 REMOVE AND REPLACE LANDSCAPING
AND IRRIGATION SYSTEM

GRAPHIC SCALE

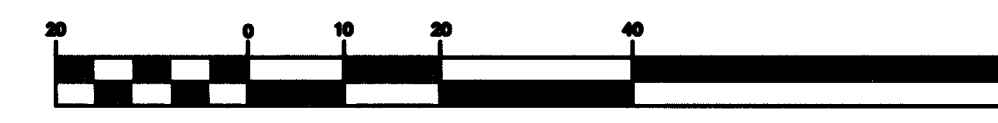

1" = 20'

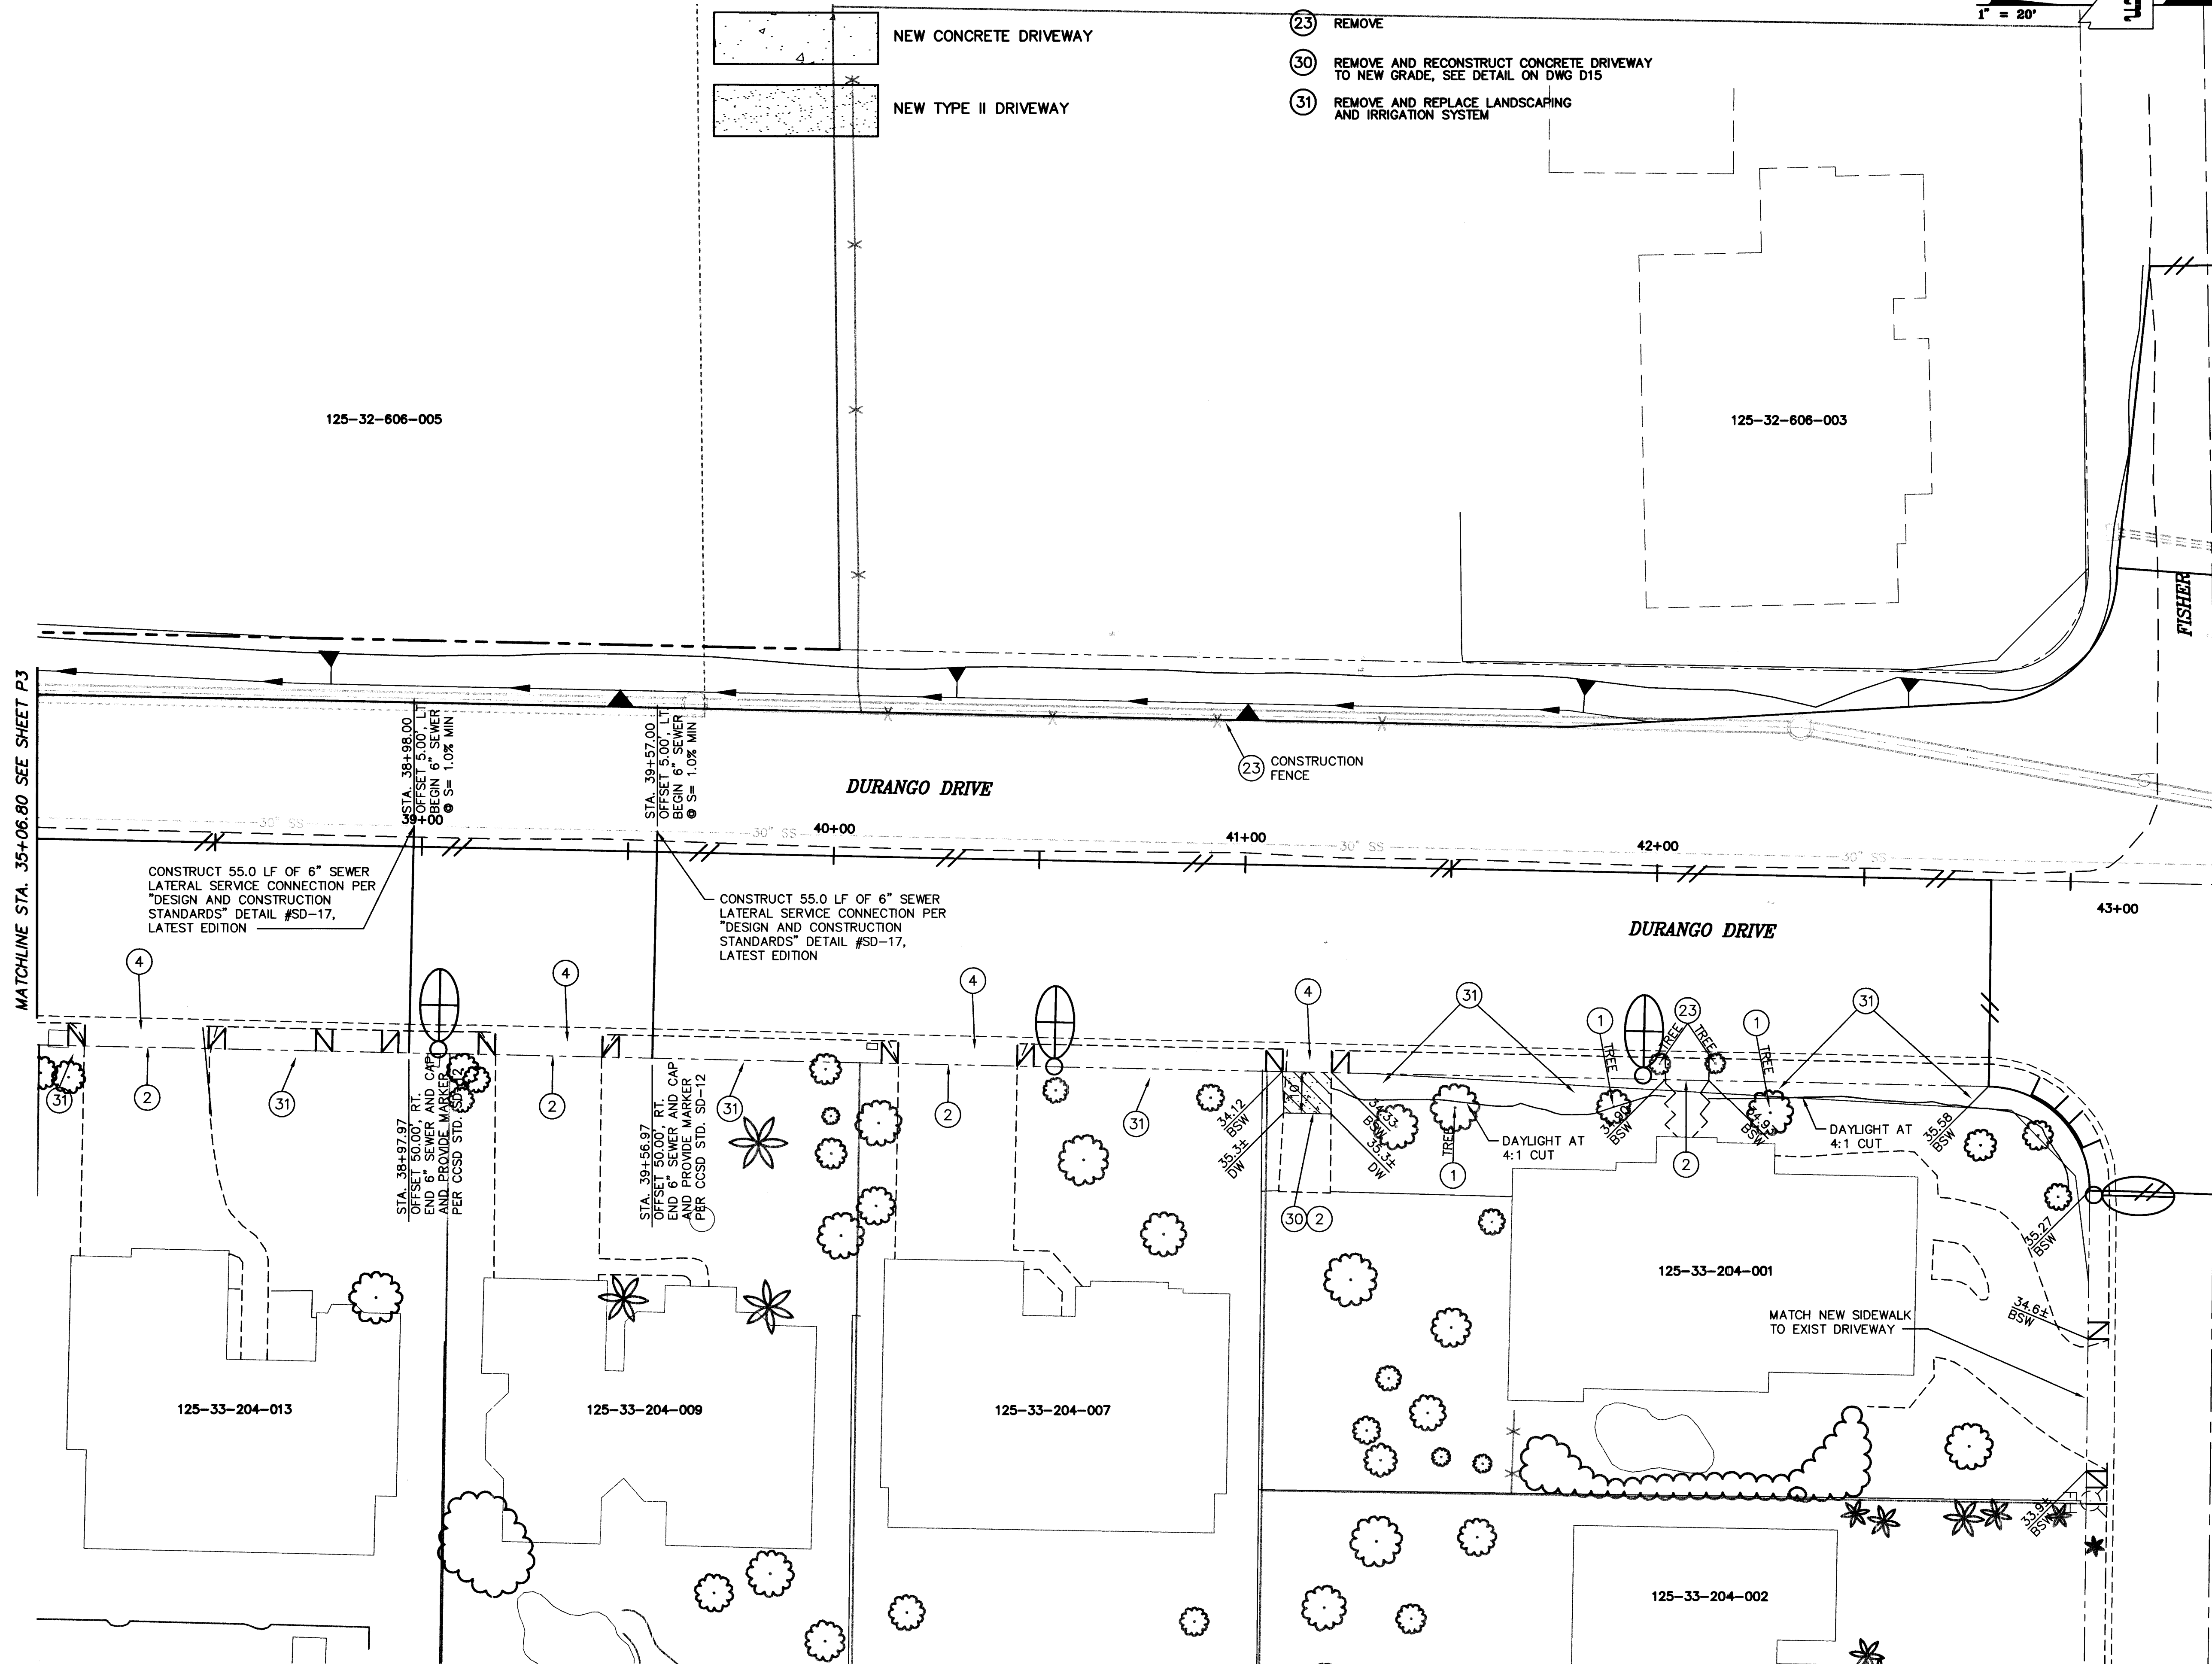

DEPARTMENT OF PUBLIC WORKS
CITY OF LAS VEGAS



CONSULTING ENGINEERS • PLANNERS • LAND SURVEYORS
2727 SOUTH RAINBOW BOULEVARD
LAS VEGAS, NEVADA 89102-5148 PHONE (702) 873-7550 FAX (702) 362-2597

PROPERTY DETAILS
STA 35+06.80 TO STA 43+35.44
PROJECT
DURANGO DRIVE IMPROVEMENTS
LONE MOUNTAIN ROAD TO TROPICAL PARKWAY

SEAL
ORIGINAL CONSTRUCTION
DRAWINGS ARE ON FILE WITH
THE CITY OF LAS VEGAS.
THE
DOCUMENTS WERE SEALED ON
8/13/02
BY
KEN D. GILBRETH
UNDER LICENSE NO.
9177

WO. NO. 5346

BY LMW

DATE 08/13/02

SCALE HORIZ. 1"=20'
VERT. NONE

DRAWING P4
SHEET 51
OF 84
SHEETS

RECORD DRAWINGS INFORMATION SUPPLIED BY CONTRACTOR - APRIL 2004