

FOR V-DITCH GRADING PLANS
SEE DRAWINGS V1 THRU V5



LEGEND

- NEW A.C. PAVEMENT
(SEE TYPICAL X-SECTIONS)
- EXISTING A.C. PAVEMENT OR
CONCRETE TO BE REMOVED
- NEW CONCRETE DRIVEWAY
- NEW TYPE II DRIVEWAY

CONSTRUCTION NOTES


- PROTECT IN PLACE
- SAWCUT AND MATCH
- CONSTRUCT RESIDENTIAL DRIVEWAY PER USD NO. 223
- GRADE TO MATCH EXISTING DRIVEWAY
- REMOVE
- REMOVE AND RECONSTRUCT CONCRETE DRIVEWAY
TO NEW GRADE, SEE DETAIL ON DWG D15
- REMOVE AND REPLACE LANDSCAPING
AND IRRIGATION SYSTEM
- 4" TYPE II AGGREGATE ON 6" OF
RECOMPACTED SUBGRADE
- CONSTRUCT AC DRIVEWAY PER
AC PAVEMENT SECTION ON DWG D-5

GRAPHIC SCALE

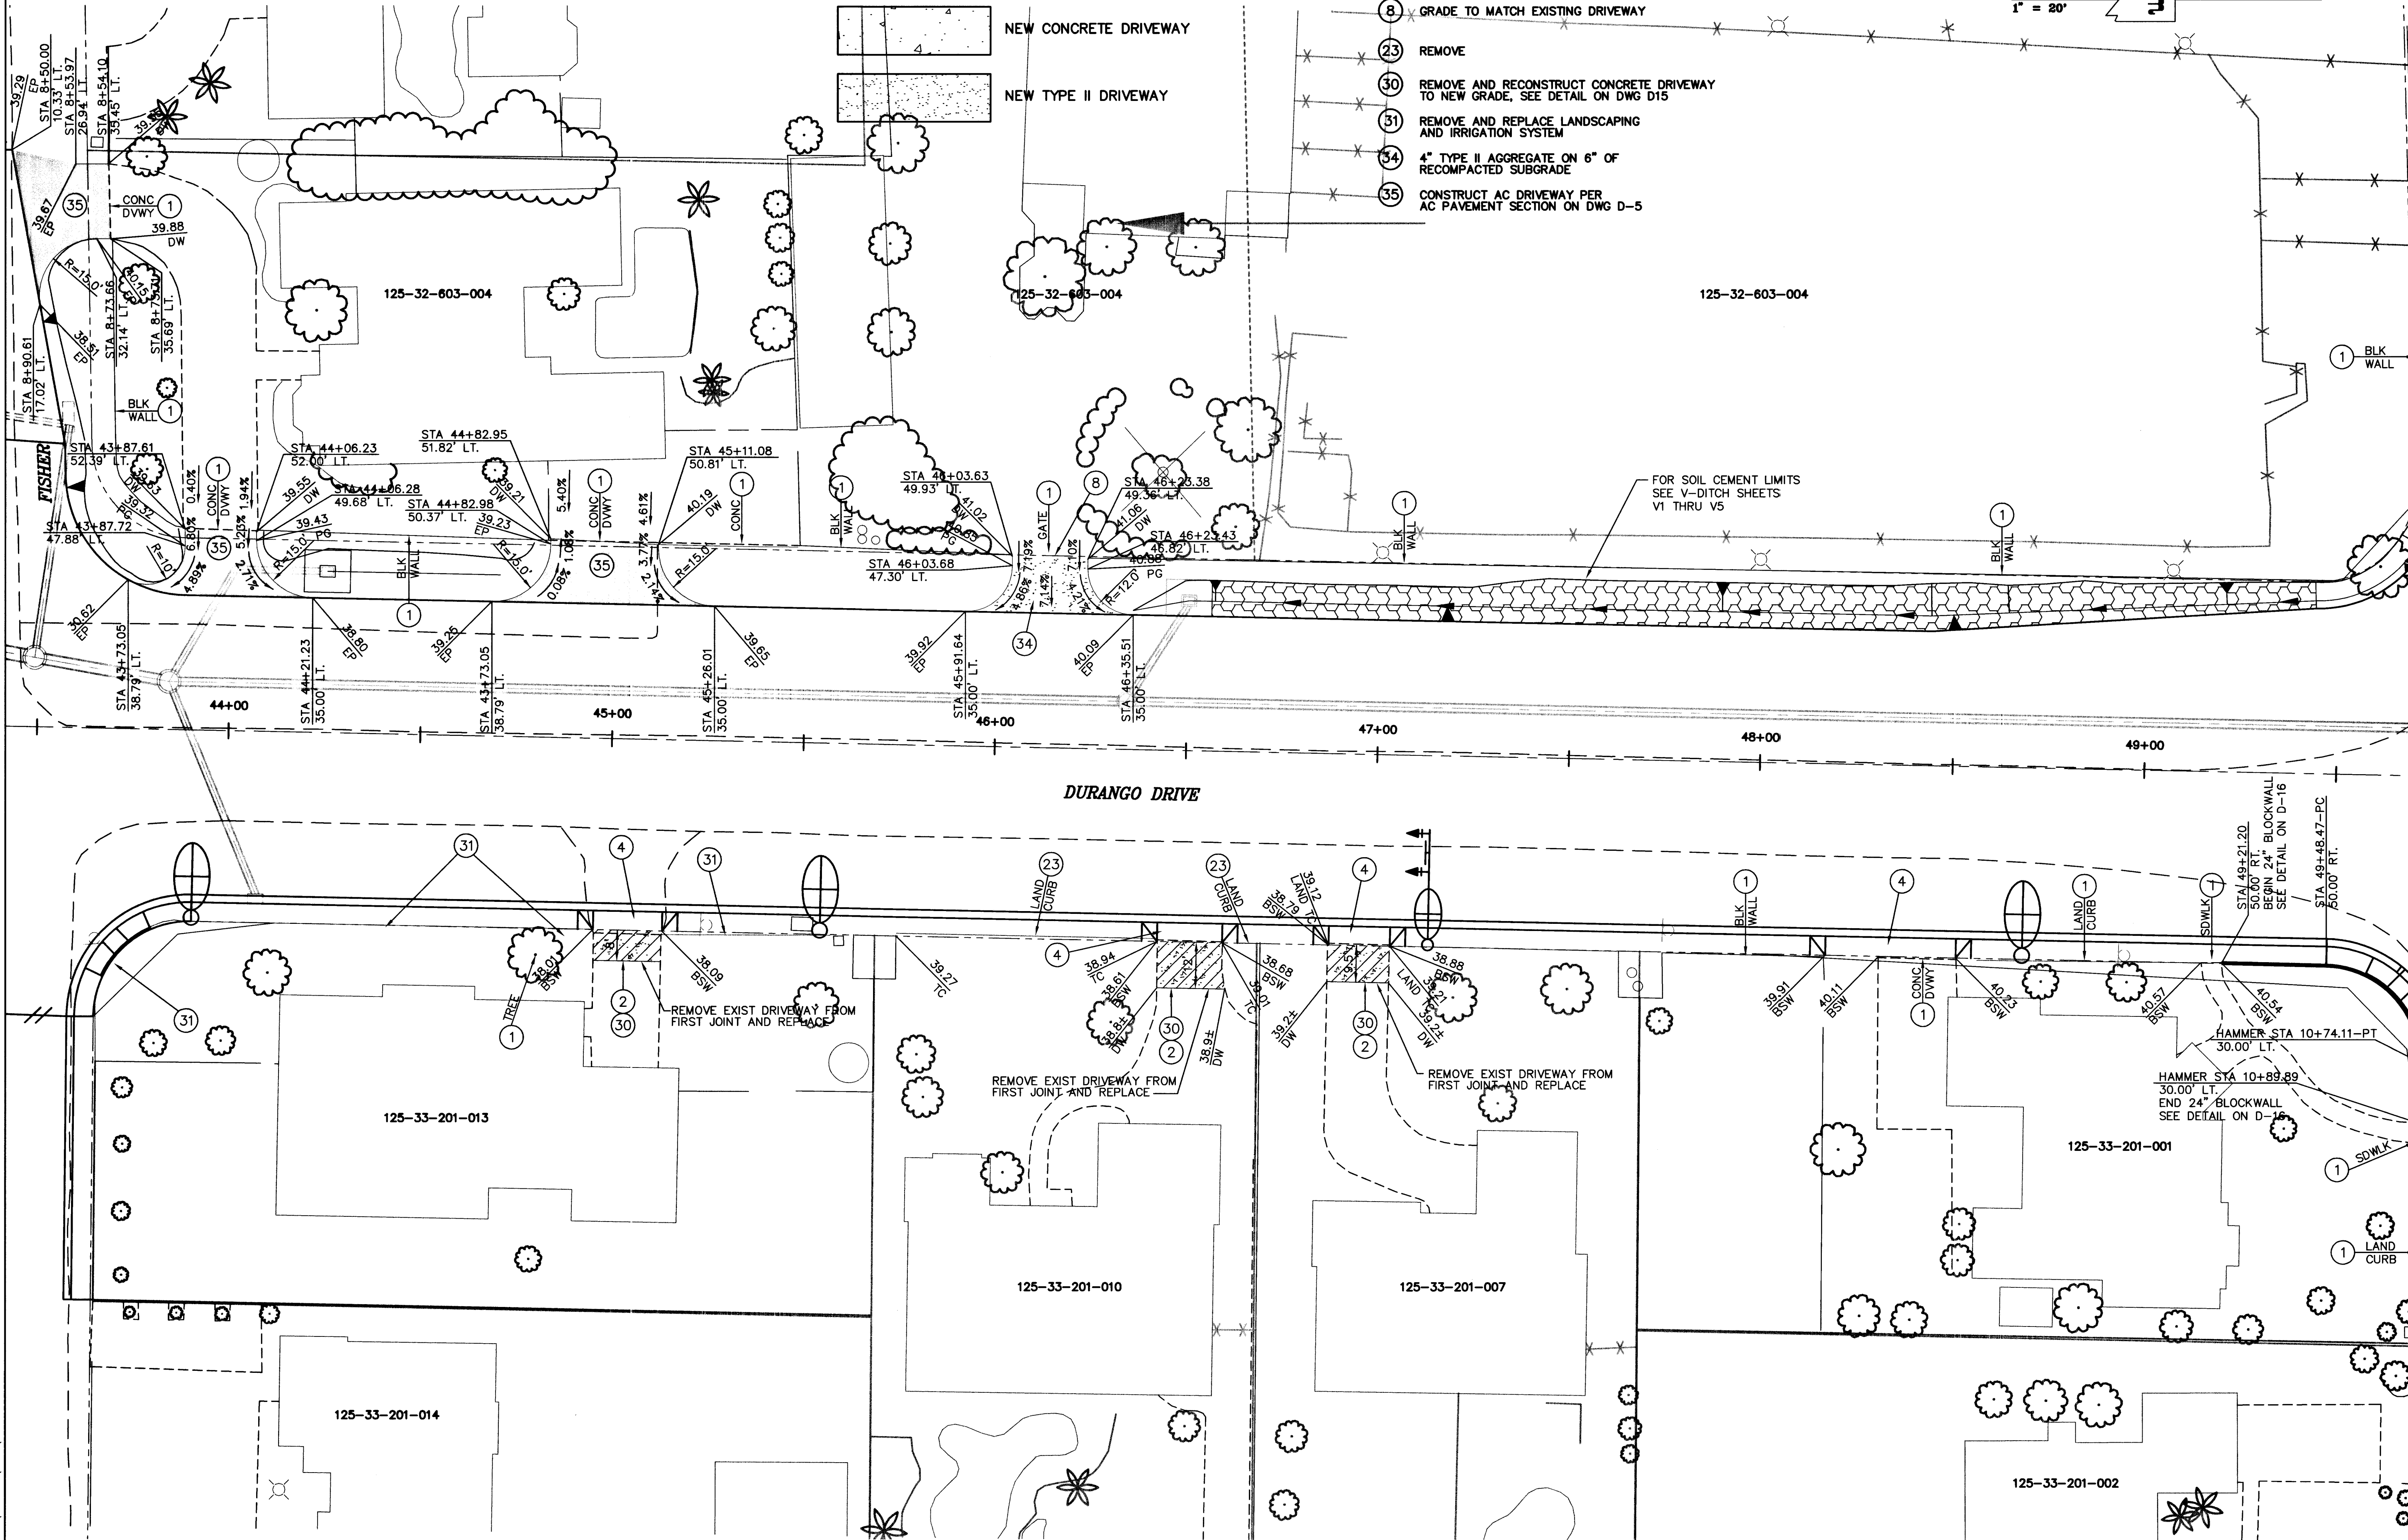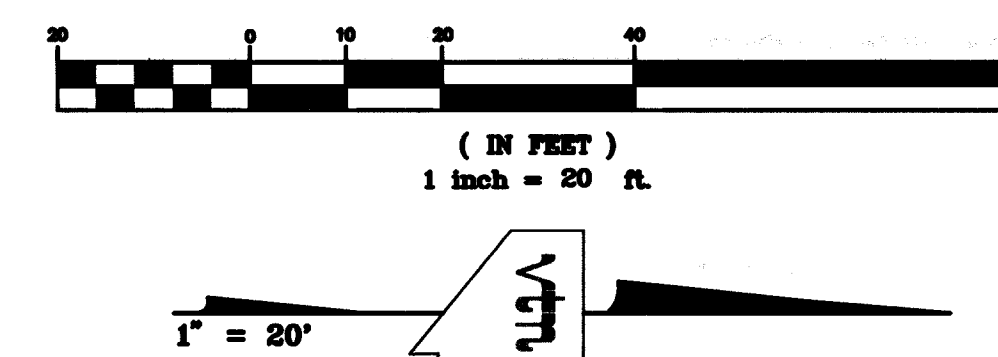

DEPARTMENT OF PUBLIC WORKS

CITY OF LAS VEGAS

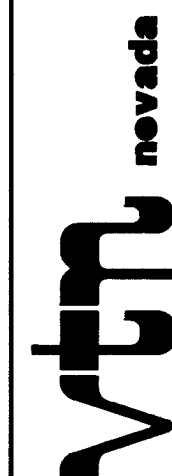

CONSULTING ENGINEERS • PLANNERS • LAND SURVEYORS
2727 SOUTH RAINBOW BOULEVARD
LAS VEGAS, NEVADA 89102-5148 PHONE (702) 873-7550 FAX (702) 362-2597

PROPERTY DETAILS

STA 43+49.58 TO STA 49+84.71

DURANGO DRIVE IMPROVEMENTS
LONE MOUNTAIN ROAD TO TROPICAL PARKWAY

ORIGINAL CONSTRUCTION
DRAWINGS ARE ON FILE WITH
THE CITY OF LAS VEGAS.
THE
DOCUMENTS WERE SEALED ON
8/13/02
BY
KEN D. GILBRETH
UNDER LICENSE NO.
9177

WO. NO. 5346

BY LMW

DATE 08/13/02

SCALE HORIZ. 1"=20'

VERT. NONE

DRAWING P5 SHEET 52 OF 84 SHEETS

RECORD DRAWINGS INFORMATION SUPPLIED BY CONTRACTOR - APRIL 2004