

FOR V-DITCH GRADING PLANS
SEE DRAWINGS V1 THRU V5



LEGEND

- NEW A.C. PAVEMENT
(SEE TYPICAL X-SECTIONS)
- EXISTING A.C. PAVEMENT OR
CONCRETE TO BE REMOVED
- NEW CONCRETE DRIVEWAY
- NEW TYPE II DRIVEWAY

CONSTRUCTION NOTES

- ① PROTECT IN PLACE
- ② SAWCUT AND MATCH
- ②3 REMOVE
- ②9 CONSTRUCT NEW RETAINING WALL. SEE DETAIL
ON DWG D13
- ③5 CONSTRUCT AC DRIVEWAY PER
AC PAVEMENT SECTION ON DWG D-5

GRAPHIC SCALE

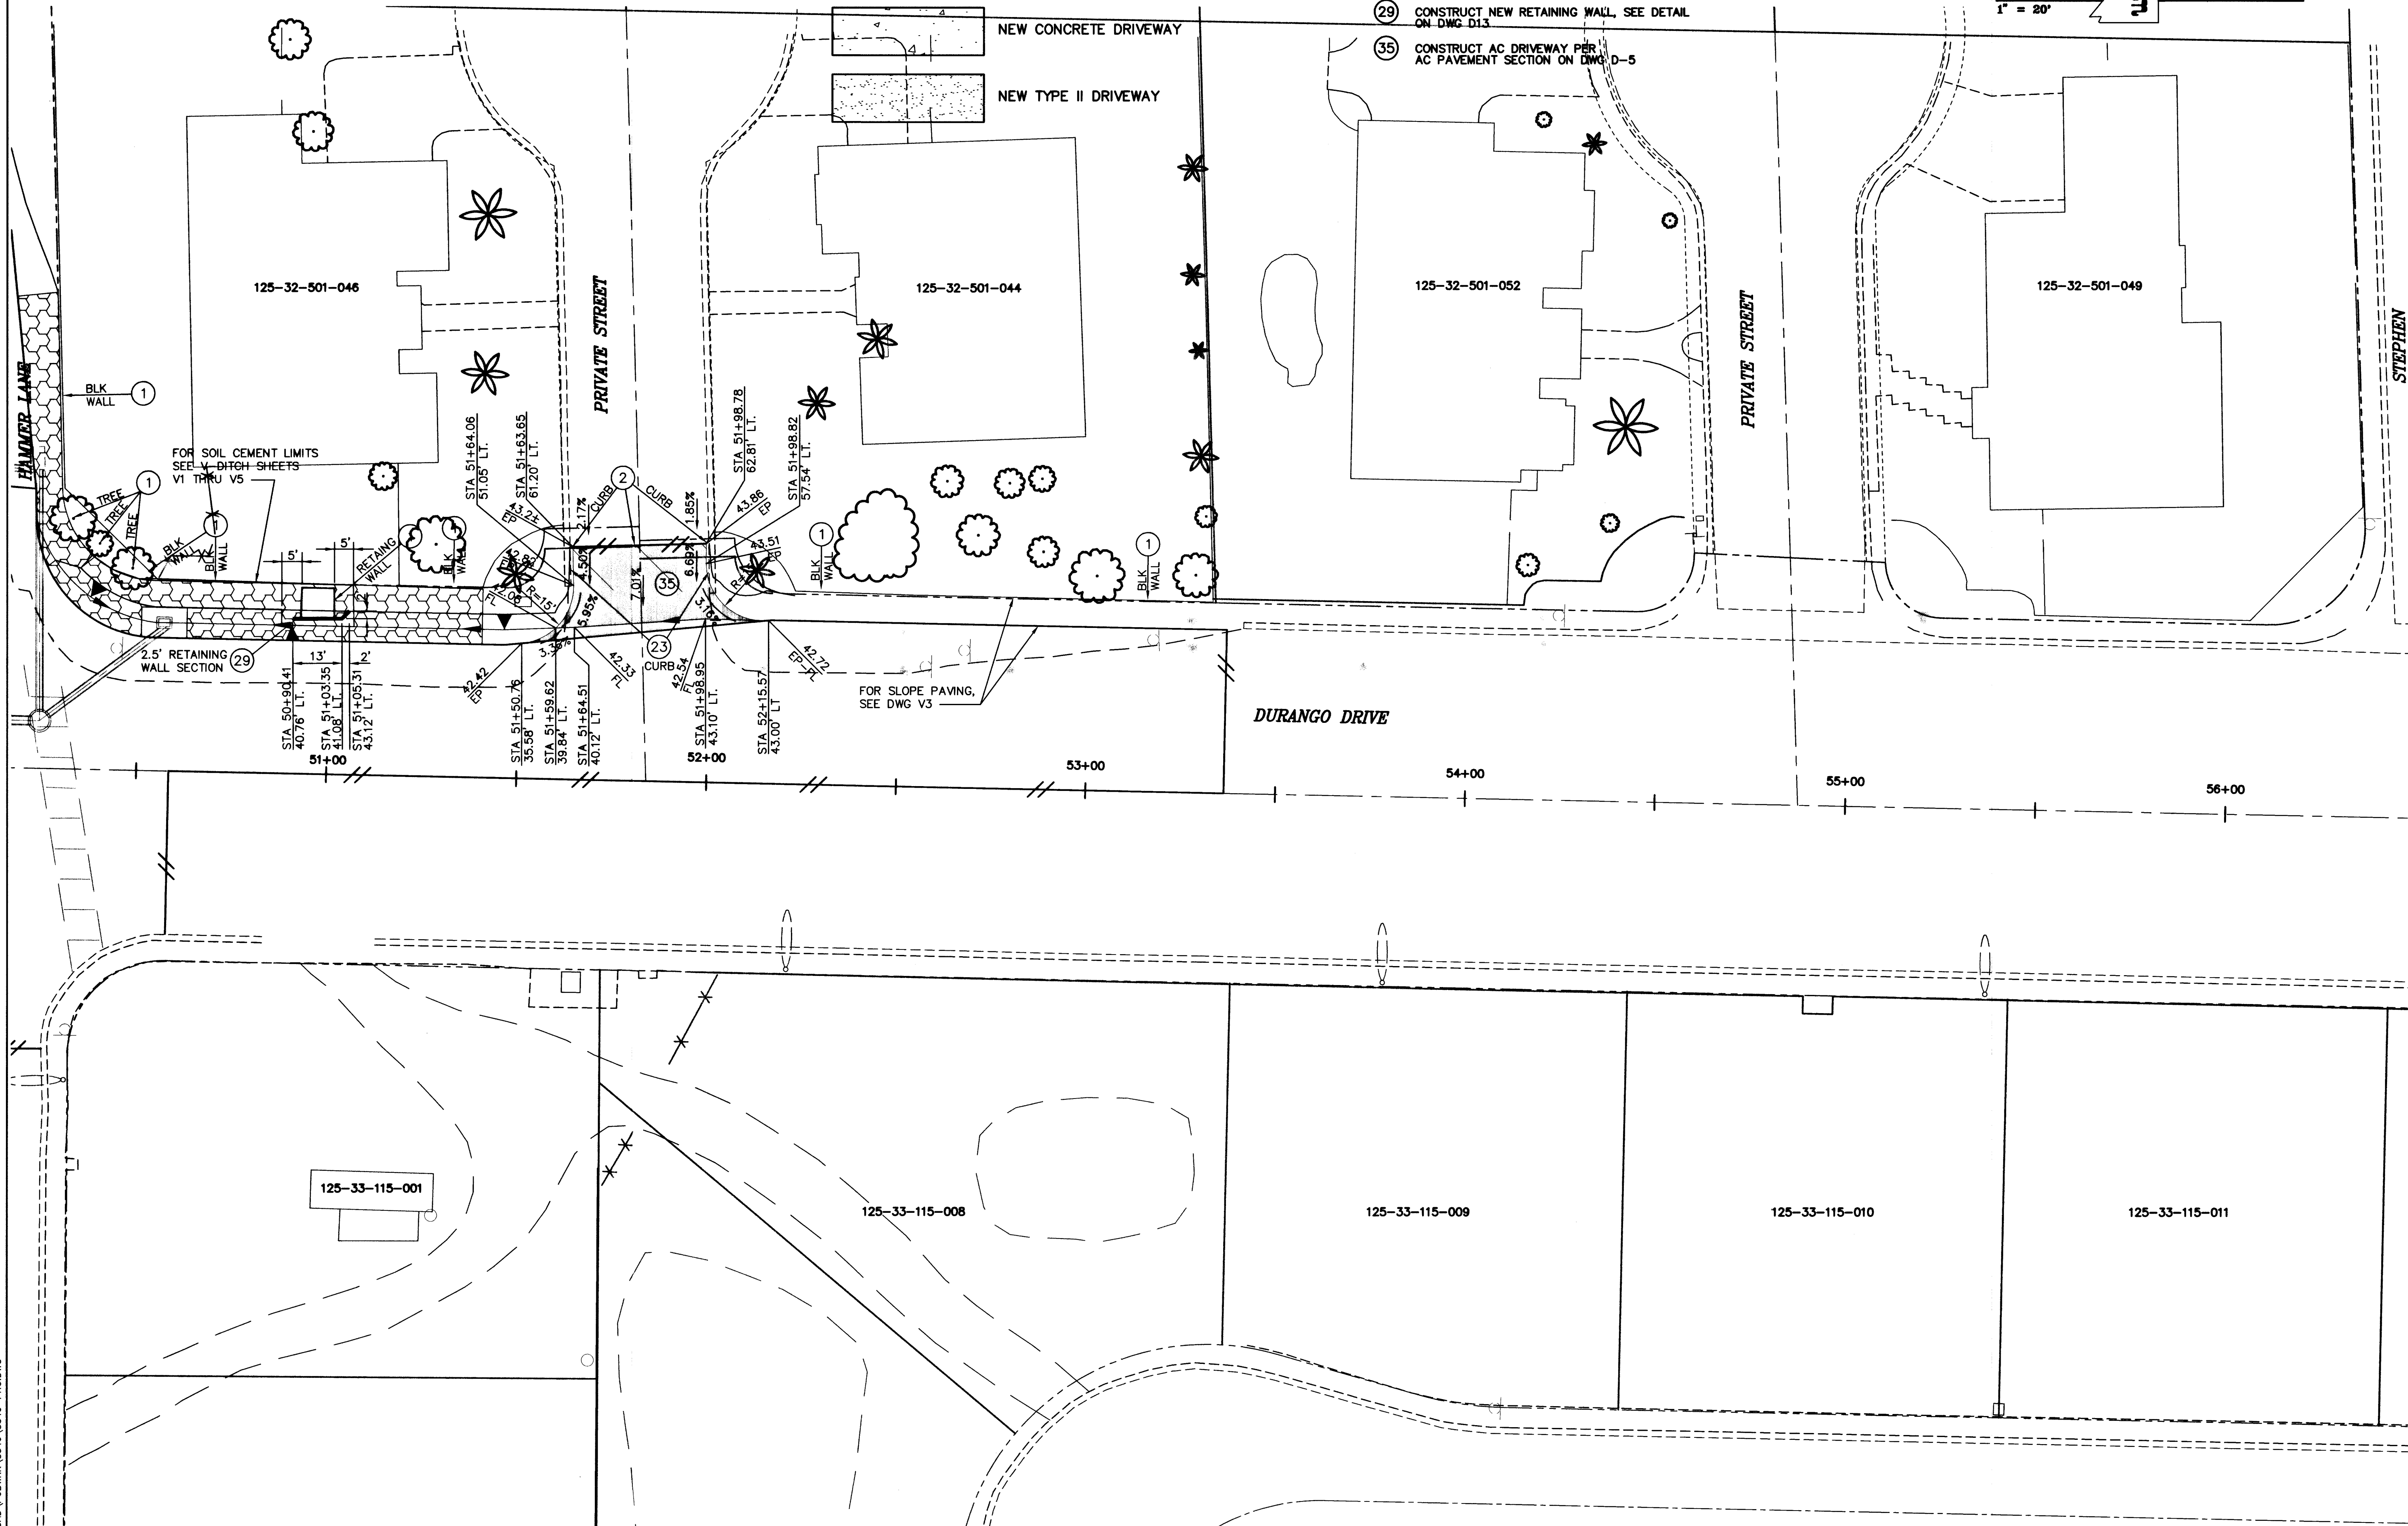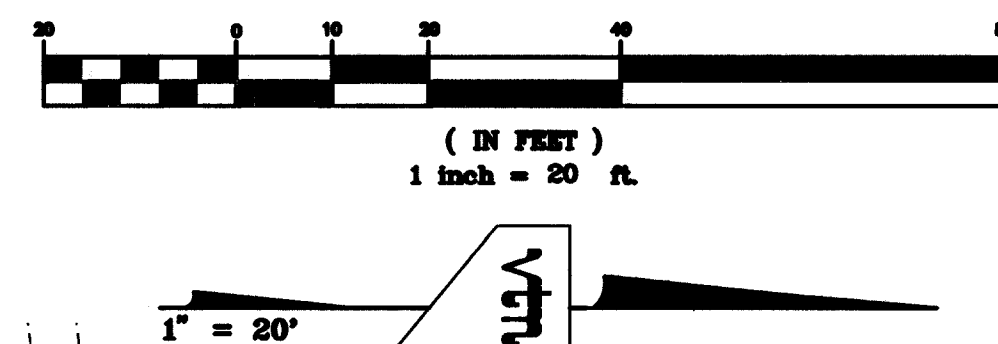

DEPARTMENT OF PUBLIC WORKS

CITY OF LAS VEGAS



CONSULTING ENGINEERS • PLANNERS • LAND SURVEYORS
2727 SOUTH RAINBOW BOULEVARD
LAS VEGAS, NEVADA 89102-5148 PHONE (702) 873-7550 FAX (702) 362-2597

PROPERTY DETAILS
STA 50+15.02 TO STA 56+55.16

DURANGO DRIVE IMPROVEMENTS
LONE MOUNTAIN ROAD TO TROPICAL PARKWAY

SEAL
ORIGINAL CONSTRUCTION
DRAWINGS ARE ON FILE WITH
THE CITY OF LAS VEGAS.
THE
DOCUMENTS WERE SEALED ON
8/13/02
BY
KEN D. GILBRETH
UNDER LICENSE NO.
9177

WO. NO. 5346

BY LMW

DATE 08/13/02

SCALE HORIZ. 1"=20'

VERT. NONE

DRAWING P6

SHEET 53 OF 84 SHEETS

RECORD DRAWINGS INFORMATION SUPPLIED BY CONTRACTOR - APRIL 2004