
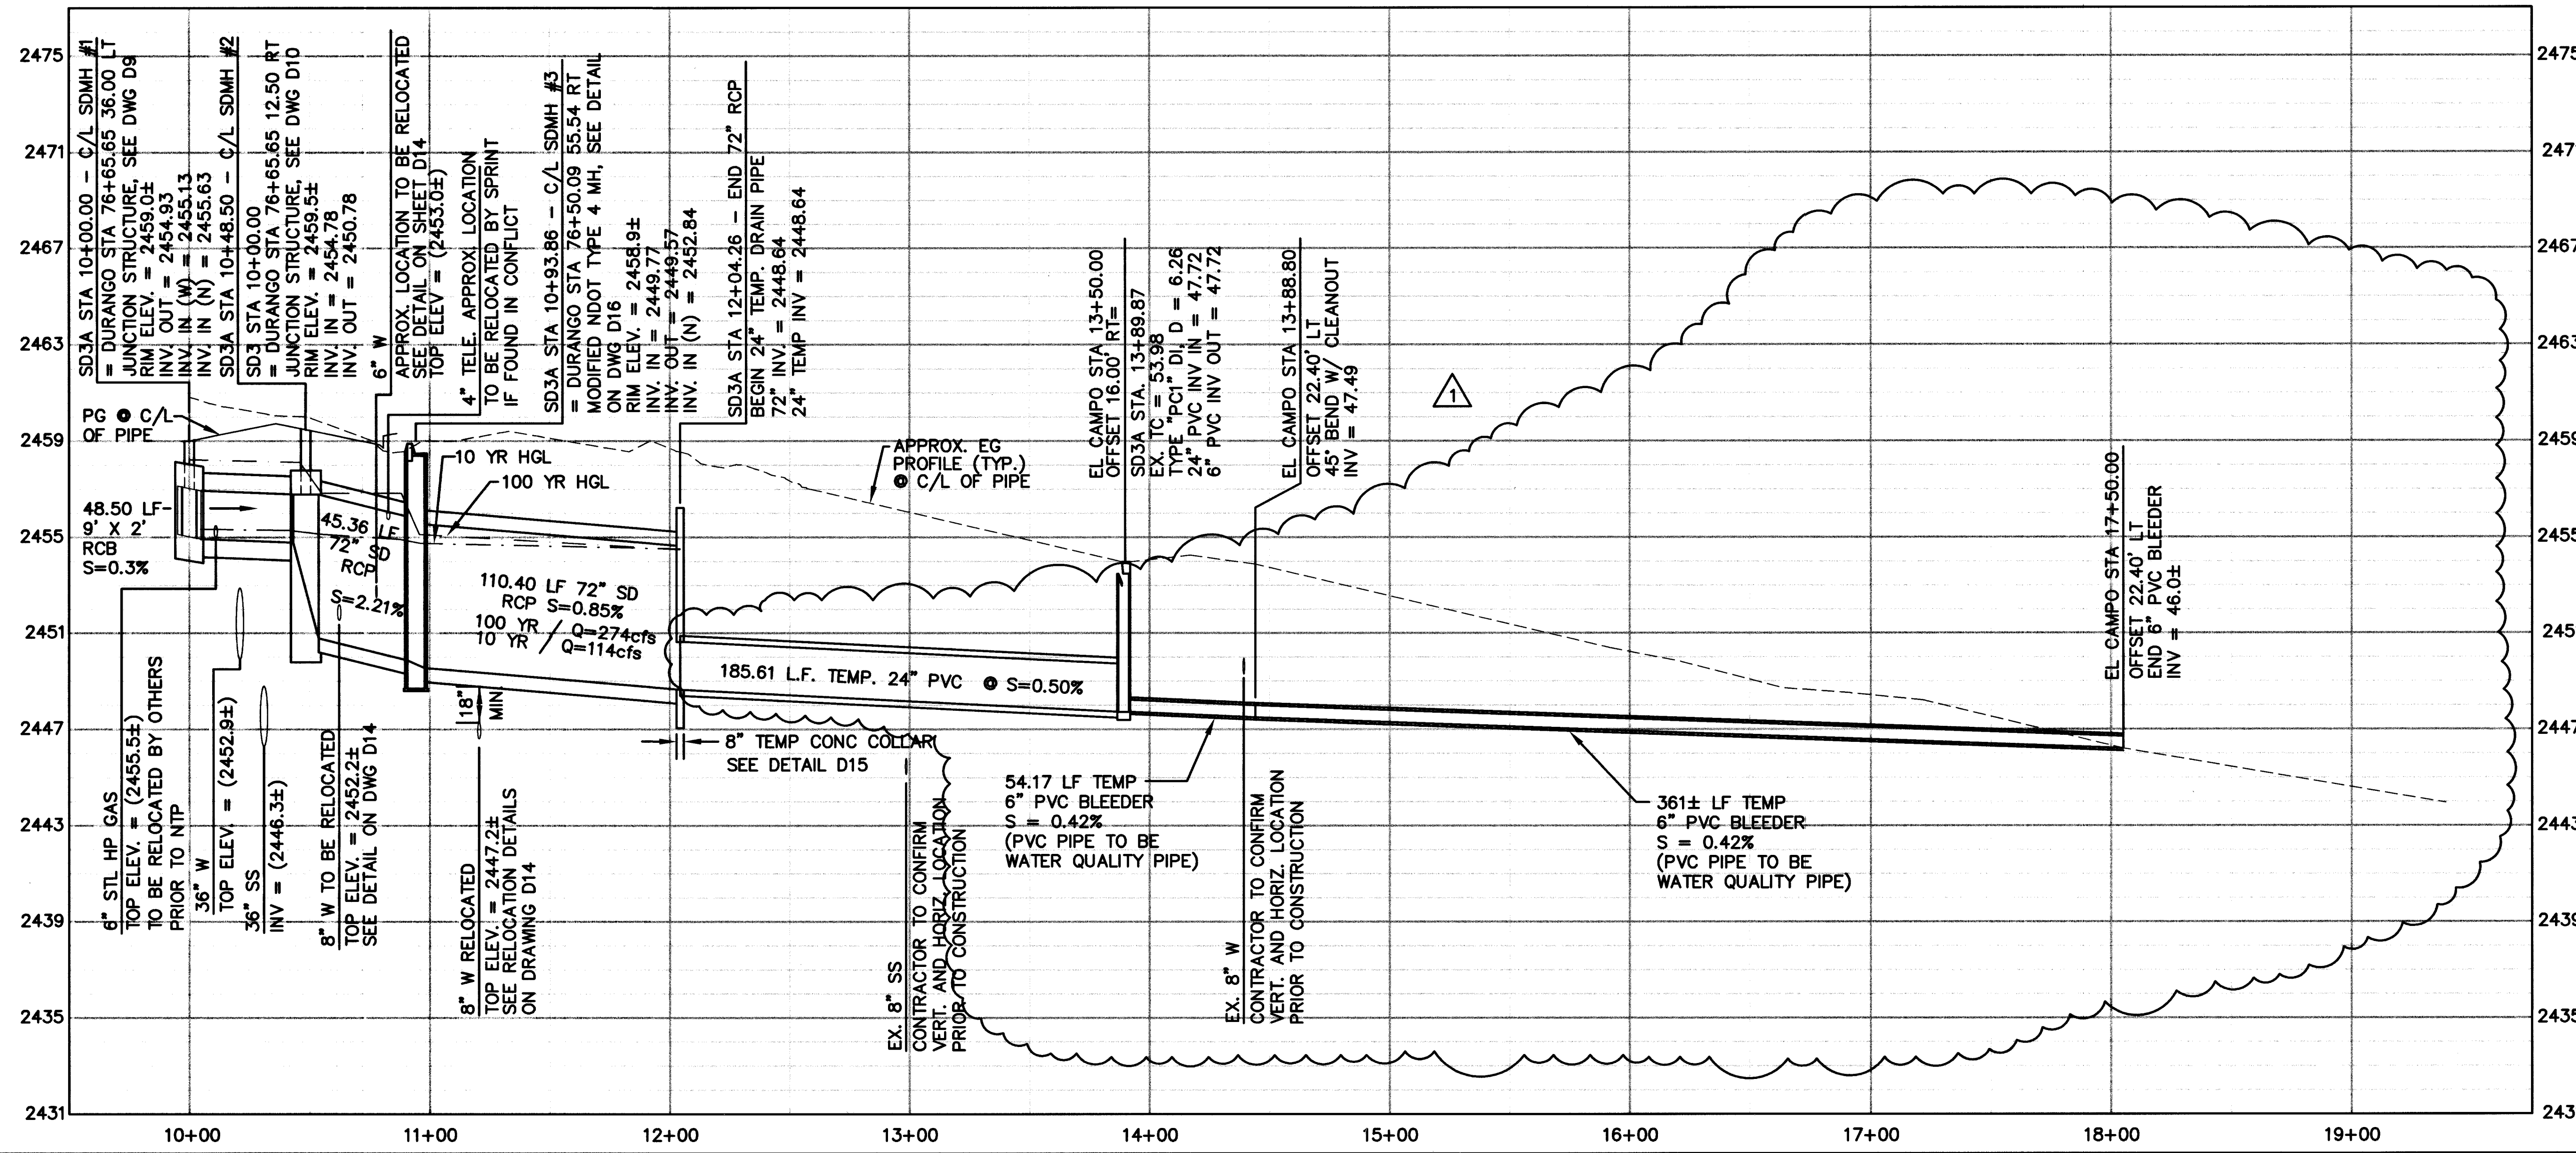


MS "BUTLER", "PRF-BUTLER", PS "PLT"
I:\CAD\WORK\3346\3346-DWG

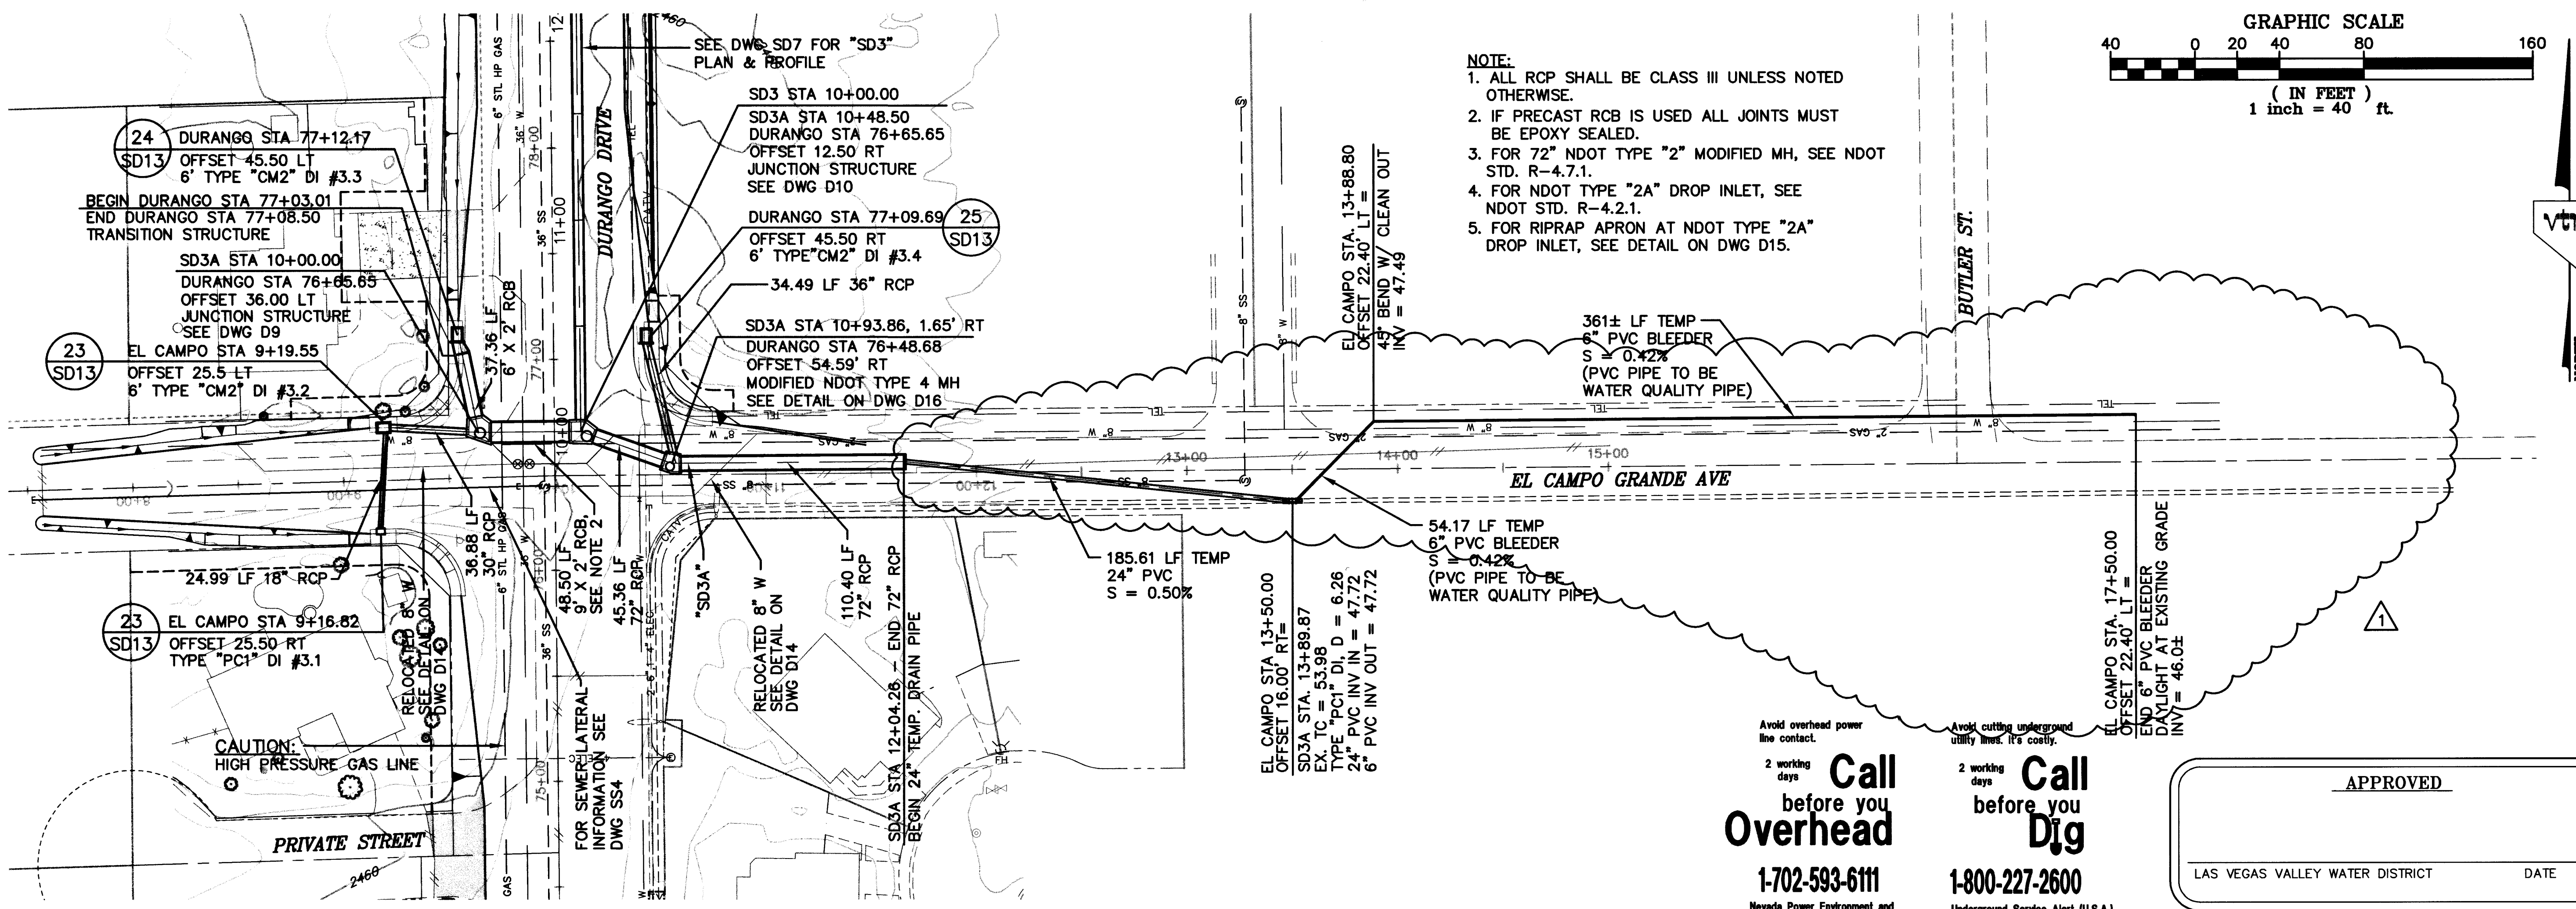

RECORD DRAWINGS INFORMATION SUPPLIED BY CONTRACTOR - APRIL 2004

CONSULTING ENGINEERS • PLANNERS • LAND SURVEYORS
2727 SOUTH RAINBOW BOULEVARD
LAS VEGAS, NEVADA 89102-5148 PHONE (702) 873-7550 FAX (702) 362-2597

vtm nevada