




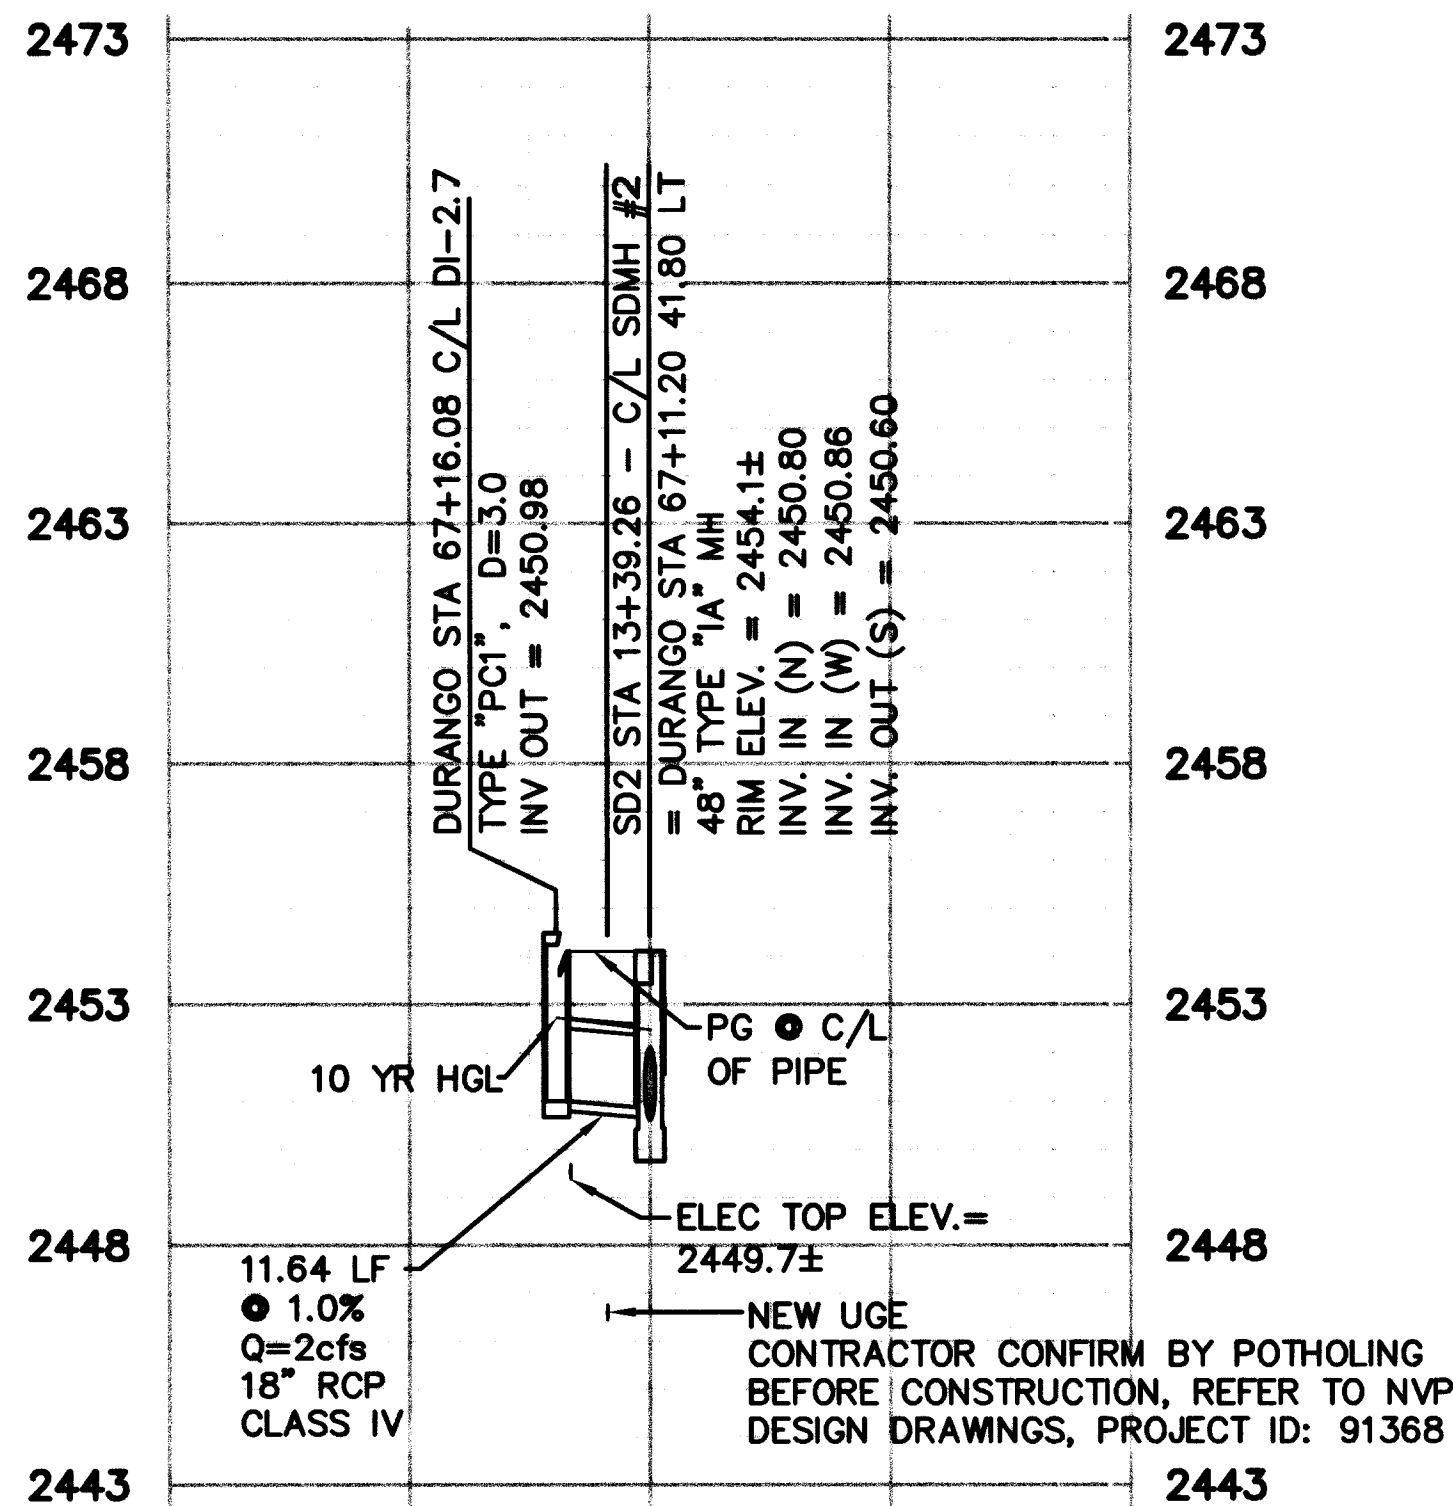


19 STA. 67+11.20

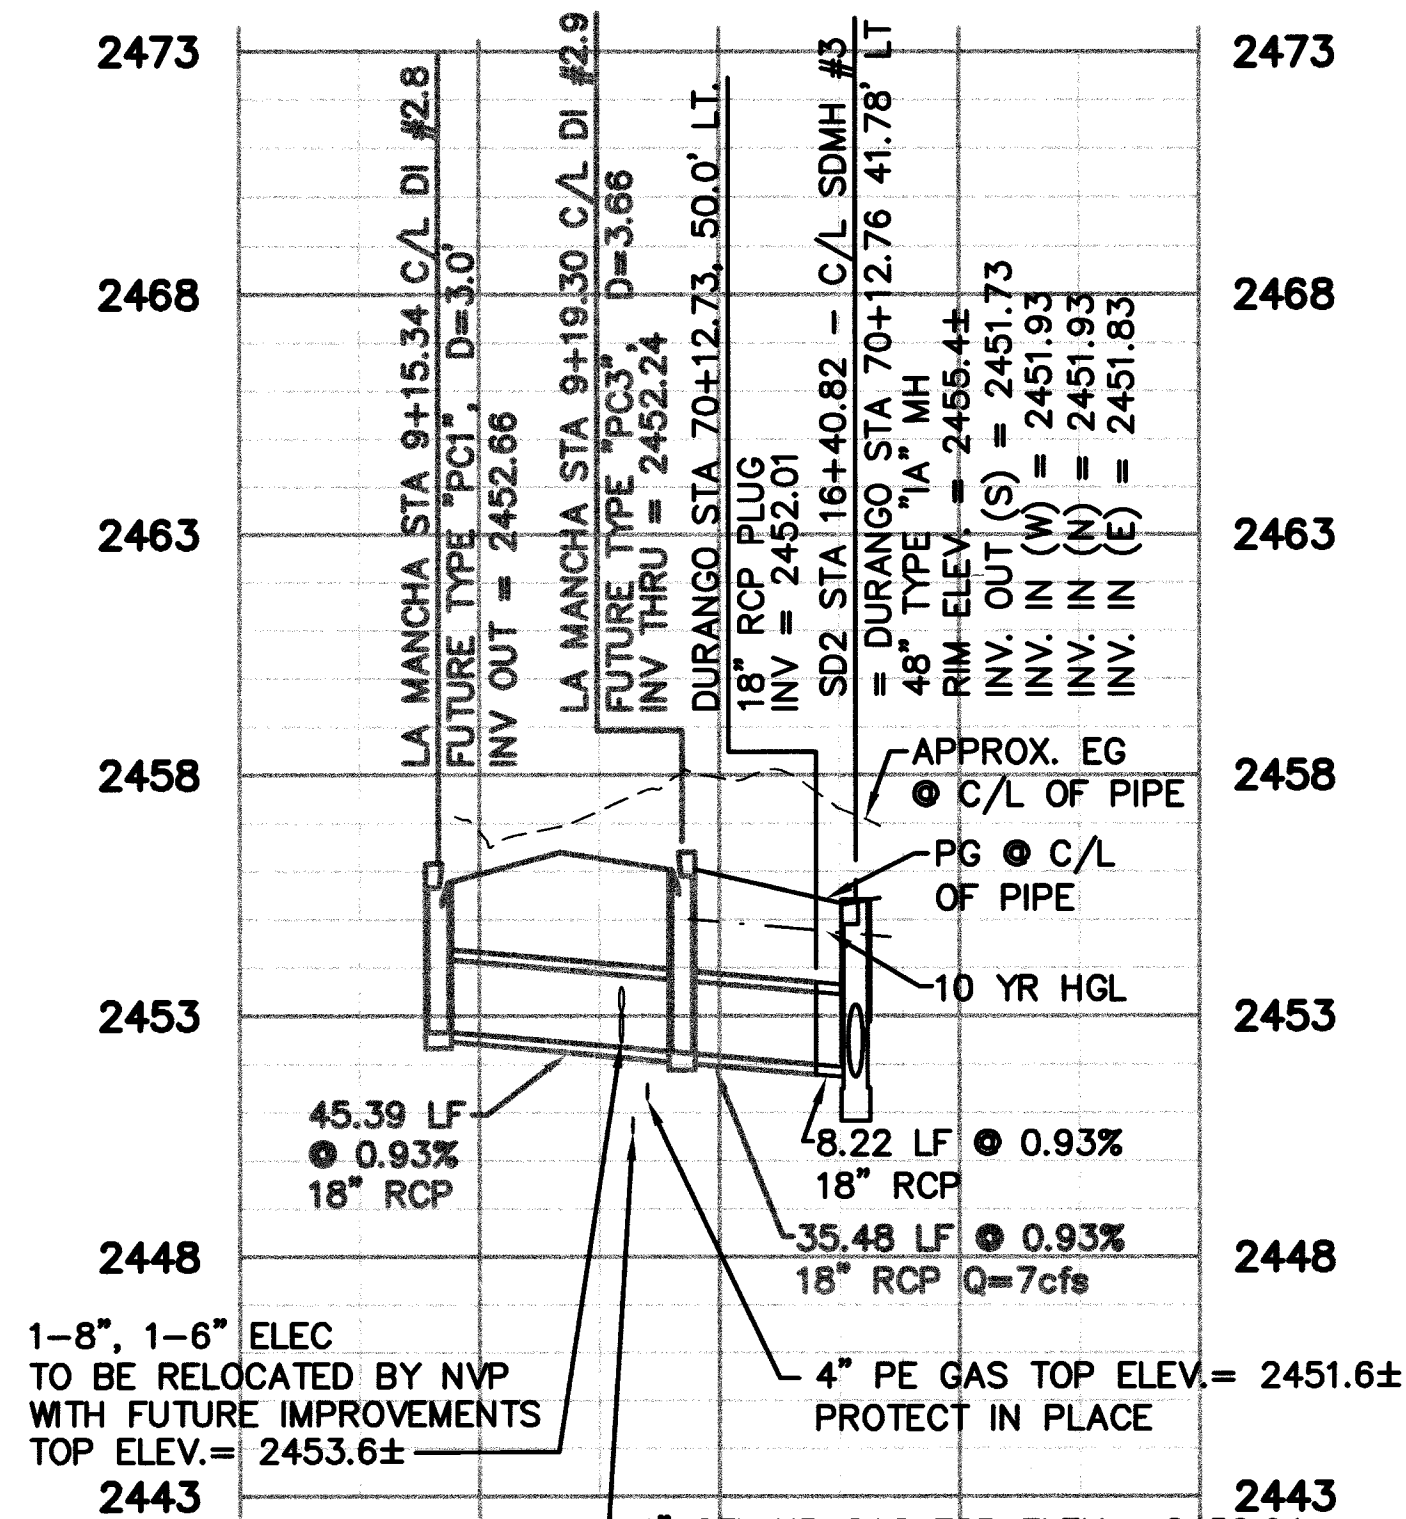


20 STA. 70+12.79

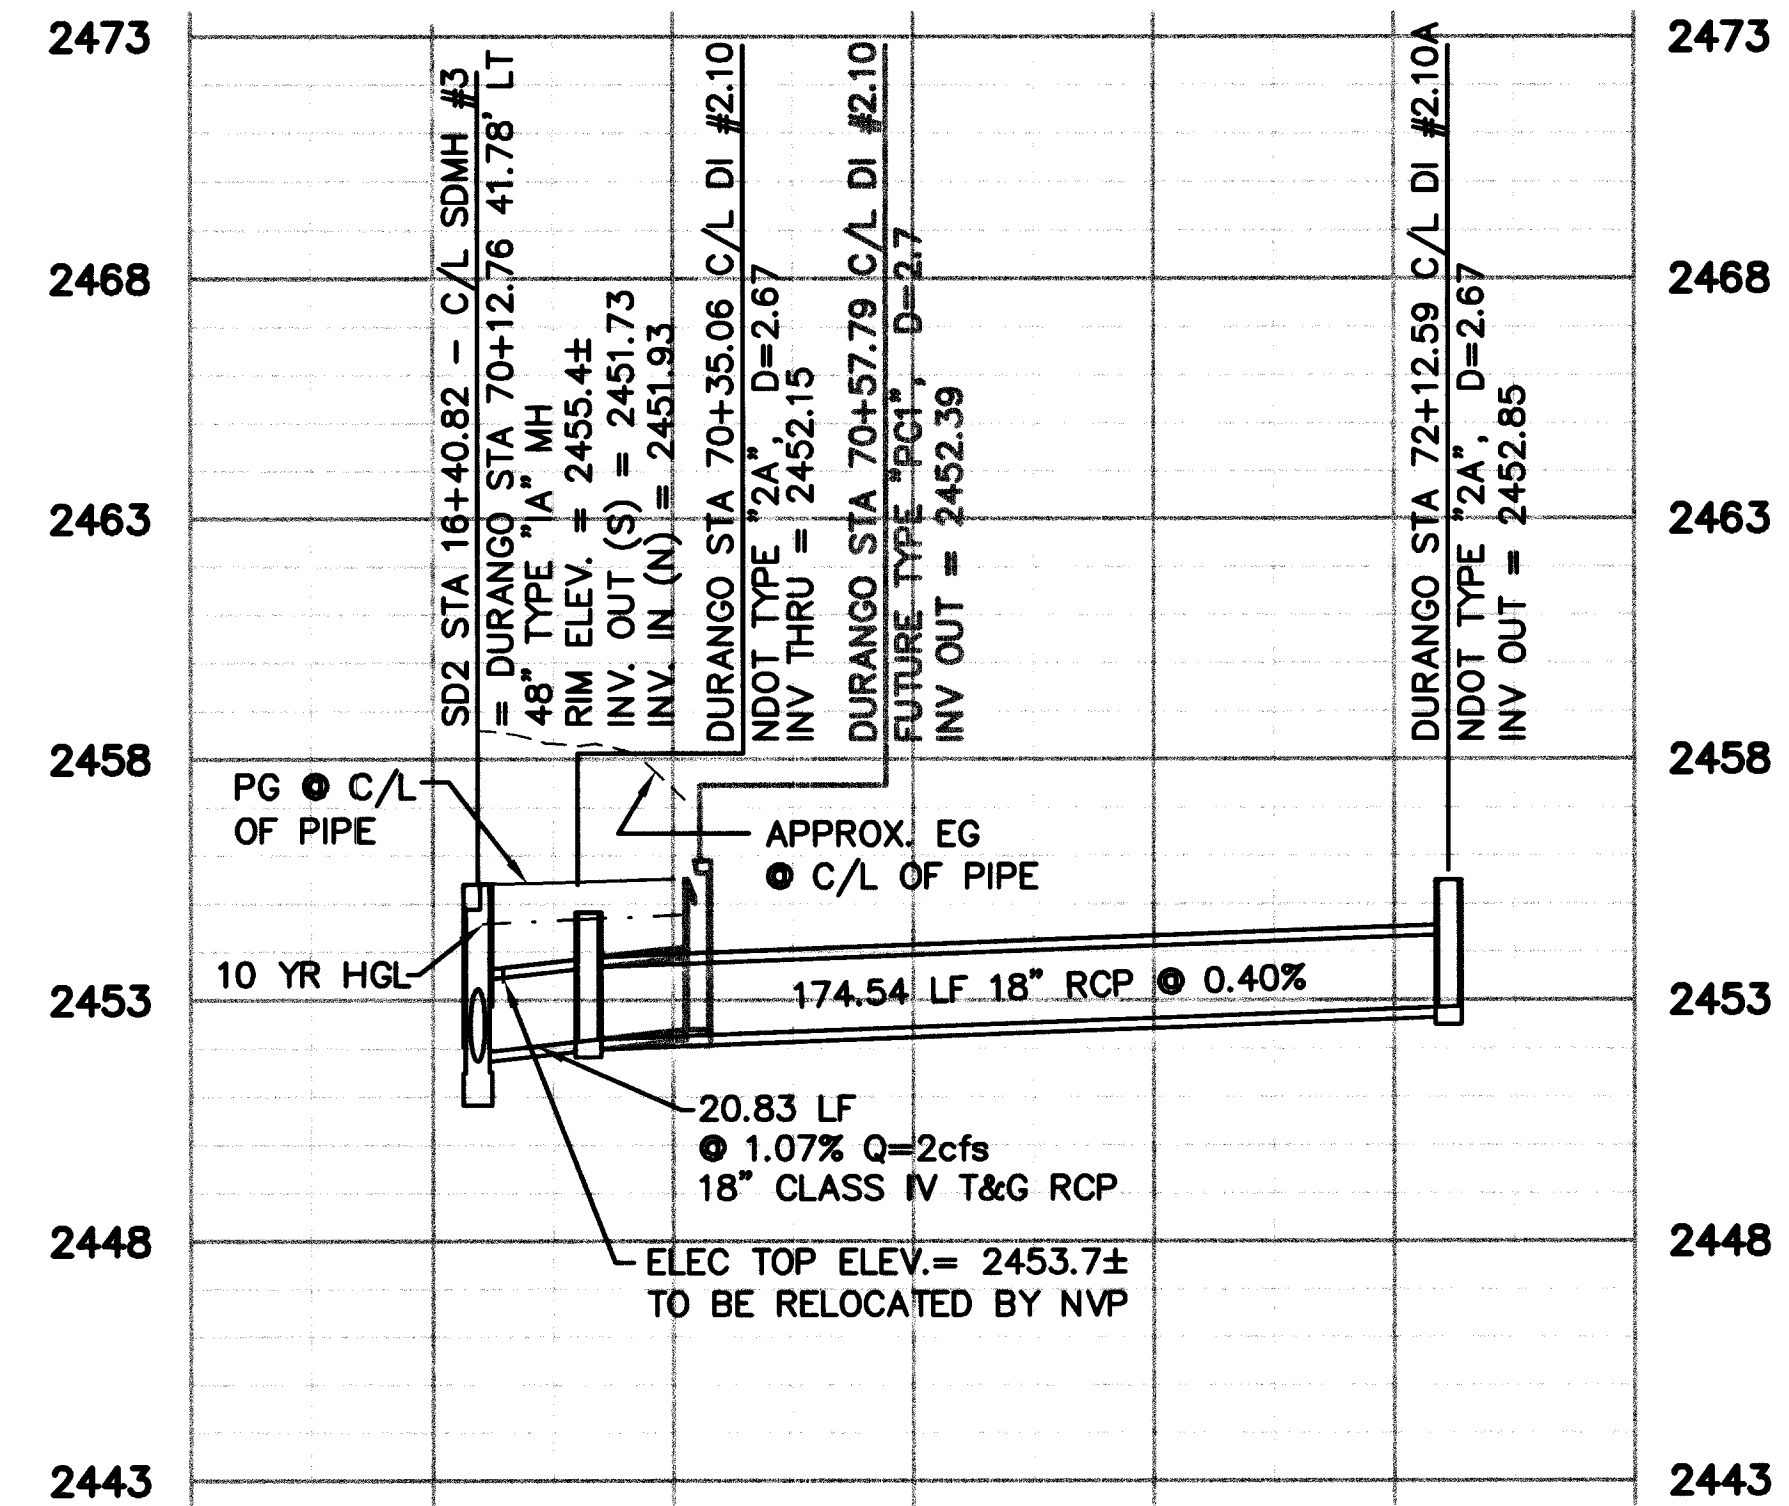


21 STA. 70+12.79

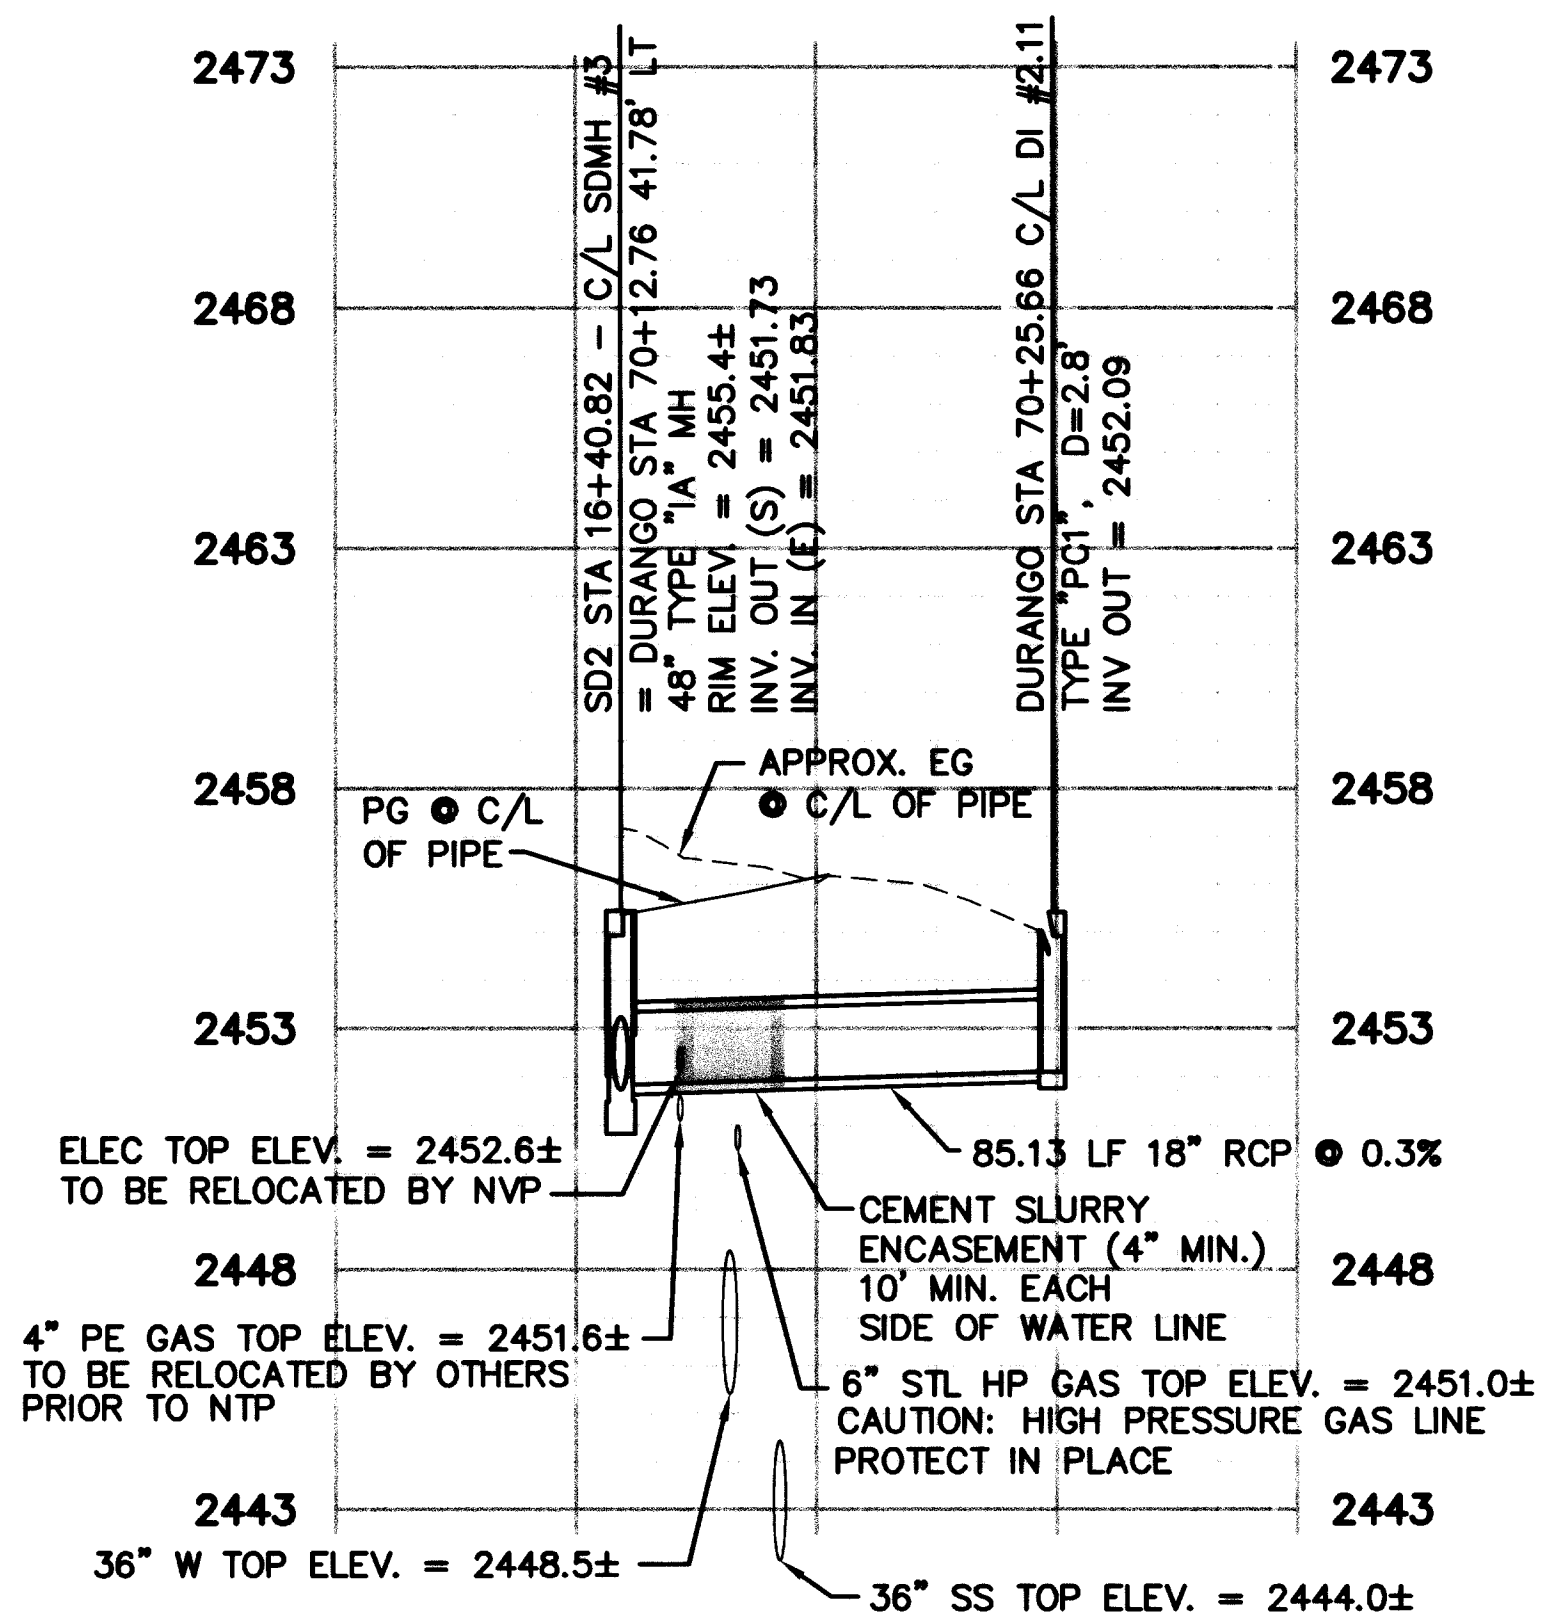

22 STA. 70+12.79

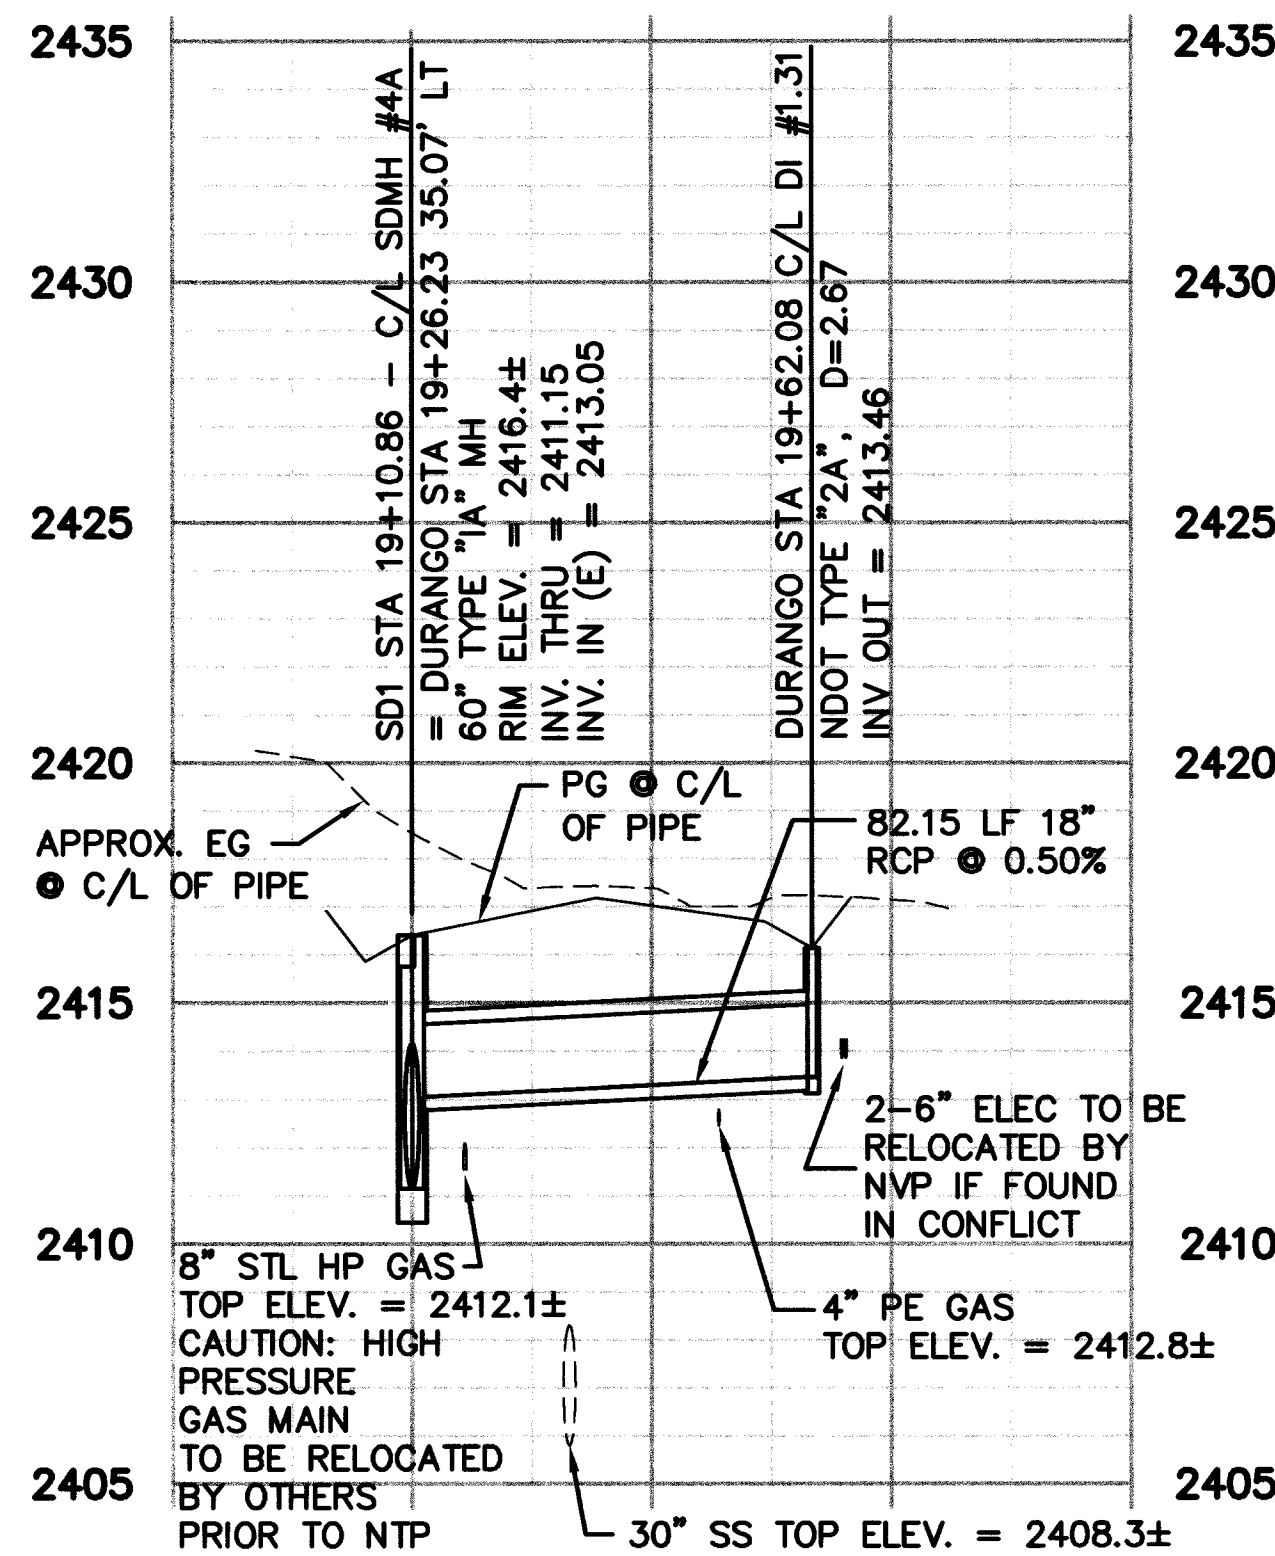

22A STA. 19+26.23

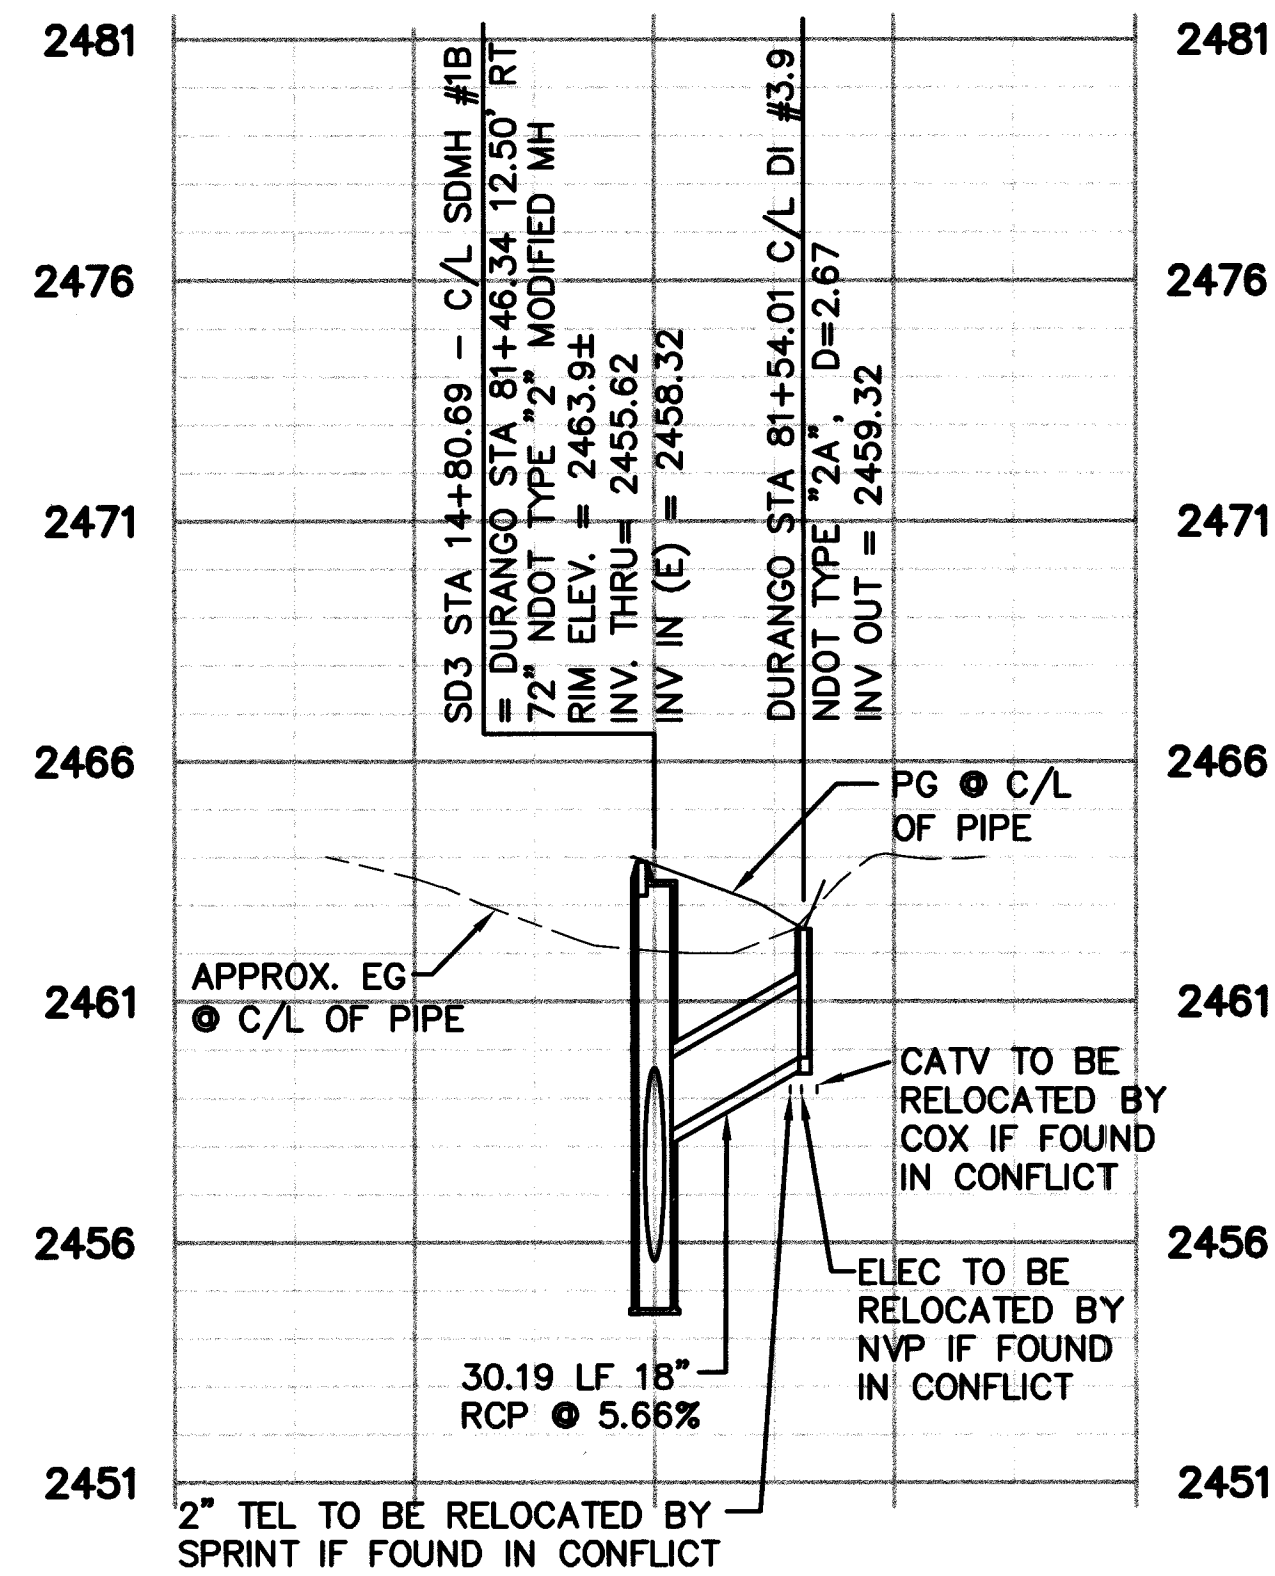

22B STA. 81+46.34

- NOTE:
1. ALL RCP SHALL BE CLASS III UNLESS NOTED OTHERWISE.
 2. FOR 72" NDOT TYPE "2" MODIFIED MH, SEE NDOT STD. R-4.7.1.
 3. FOR NDOT TYPE "2A" DROP INLET, SEE NDOT STD. R-4.2.1.
 4. FOR RIPRAP APRON AT NDOT TYPE "2A" DROP INLET, SEE DETAIL ON DWG D15.

Avoid overhead power line contact.
2 working days
Call before you Overhead
1-702-593-6111
Nevada Power Environment and Safety Services Department

Avoid cutting underground utility lines. It's costly.
2 working days
Call before you Dig
1-800-227-2600
Underground Service Alert (U.S.A.)

APPROVED
LAS VEGAS VALLEY WATER DISTRICT
DATE

THE STORM DRAIN LATERAL PROFILES
DURANGO DRIVE
PROJECT
DURANGO DRIVE IMPROVEMENTS
LONE MOUNTAIN ROAD TO TROPICAL PARKWAY

ORIGINAL CONSTRUCTION DRAWINGS ARE ON FILE WITH THE CITY OF LAS VEGAS. THE DOCUMENTS WERE SEALED ON 8/13/02 BY KEN D. GILBRETH UNDER LICENSE NO. 9177

WD. NO. 5346
BY JPL
DATE 08/13/02
SCALE HORIZ. 1"=40' VERT. 1"=4'
DRAWING SHEET 73 OF 84
SD12

DEPARTMENT OF PUBLIC WORKS
CITY OF LAS VEGAS, NEVADA

vtm nevada

CONSULTING ENGINEERS • PLANNERS • LAND SURVEYORS
2727 SOUTH RAINBOW BOULEVARD
LAS VEGAS, NEVADA 89102-5148 PHONE (702) 873-7550 FAX (702) 362-2597

RECORD DRAWINGS INFORMATION SUPPLIED BY CONTRACTOR - APRIL 2004