




L:\5678\CAD\5678\RECORDINGS\5678-SD.LAT.DWG

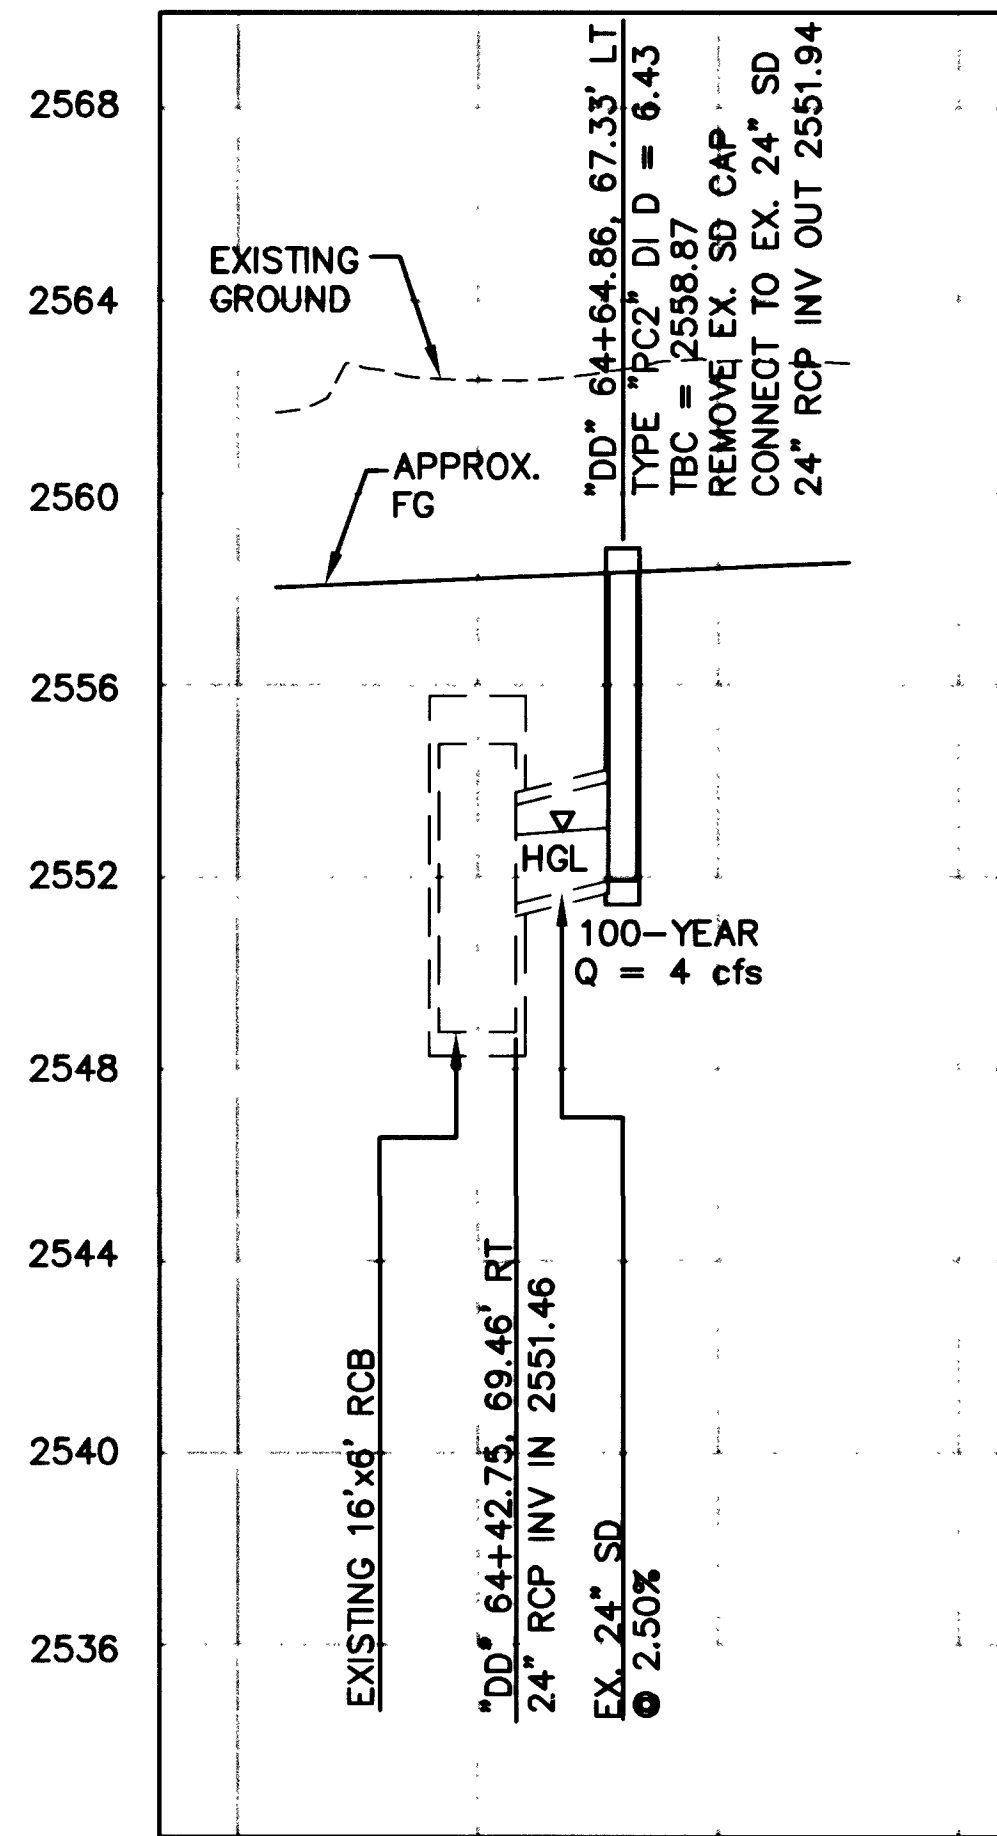


1 "DD" 64+64.86, 67.33' LT

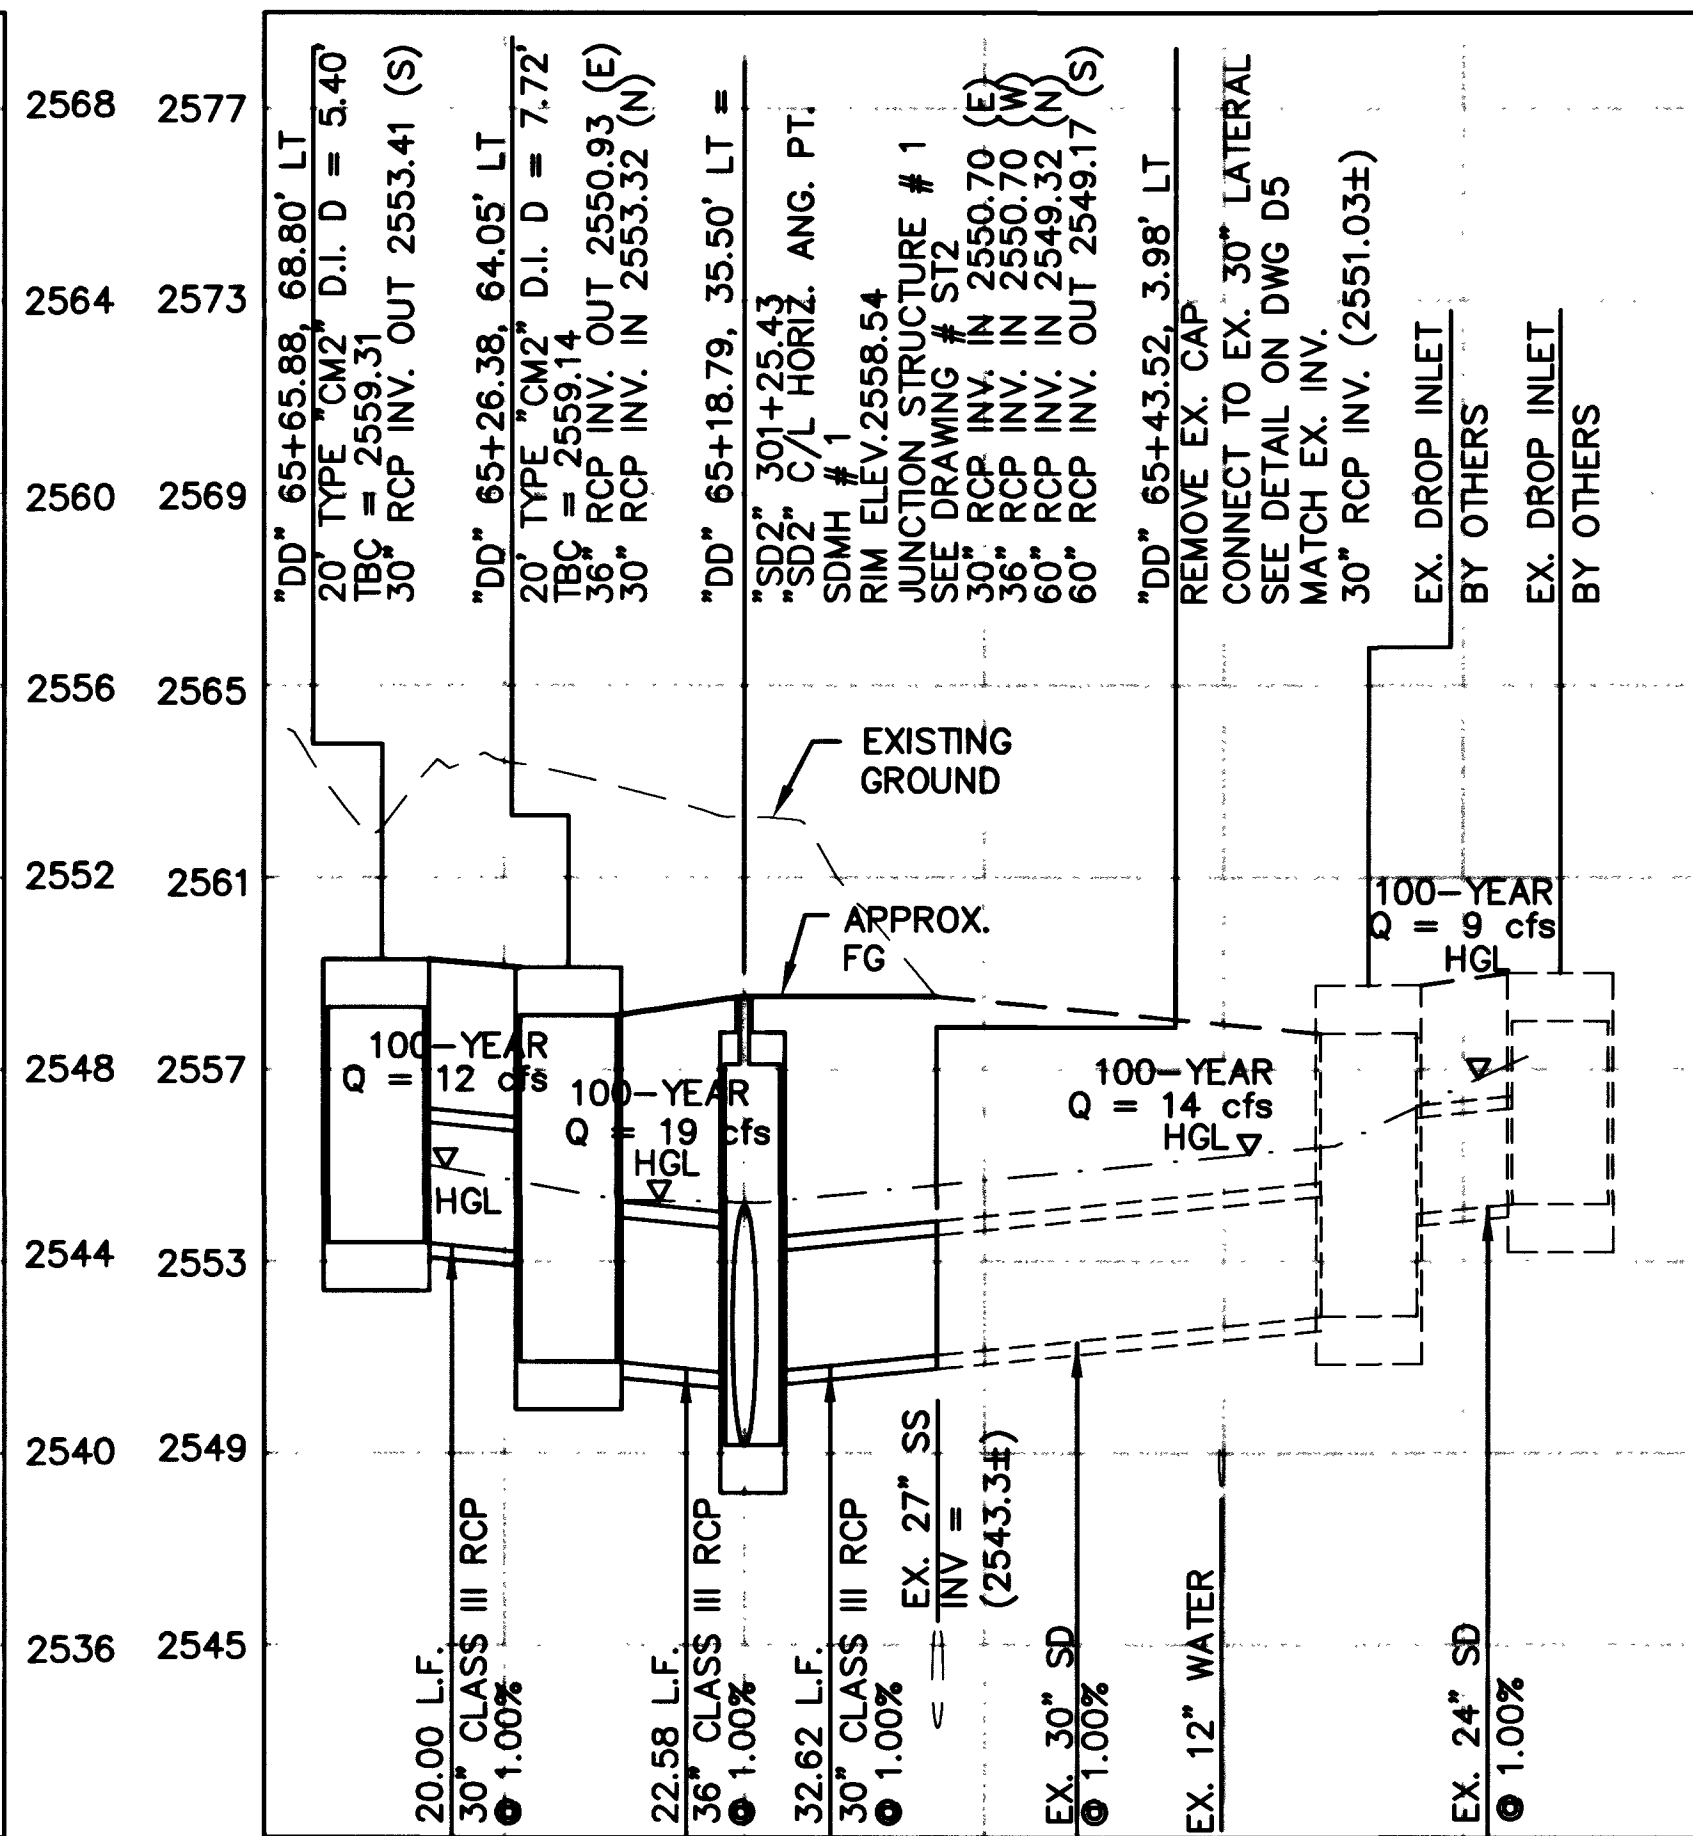


2 "DD" 65+21.10, 30.29' LT

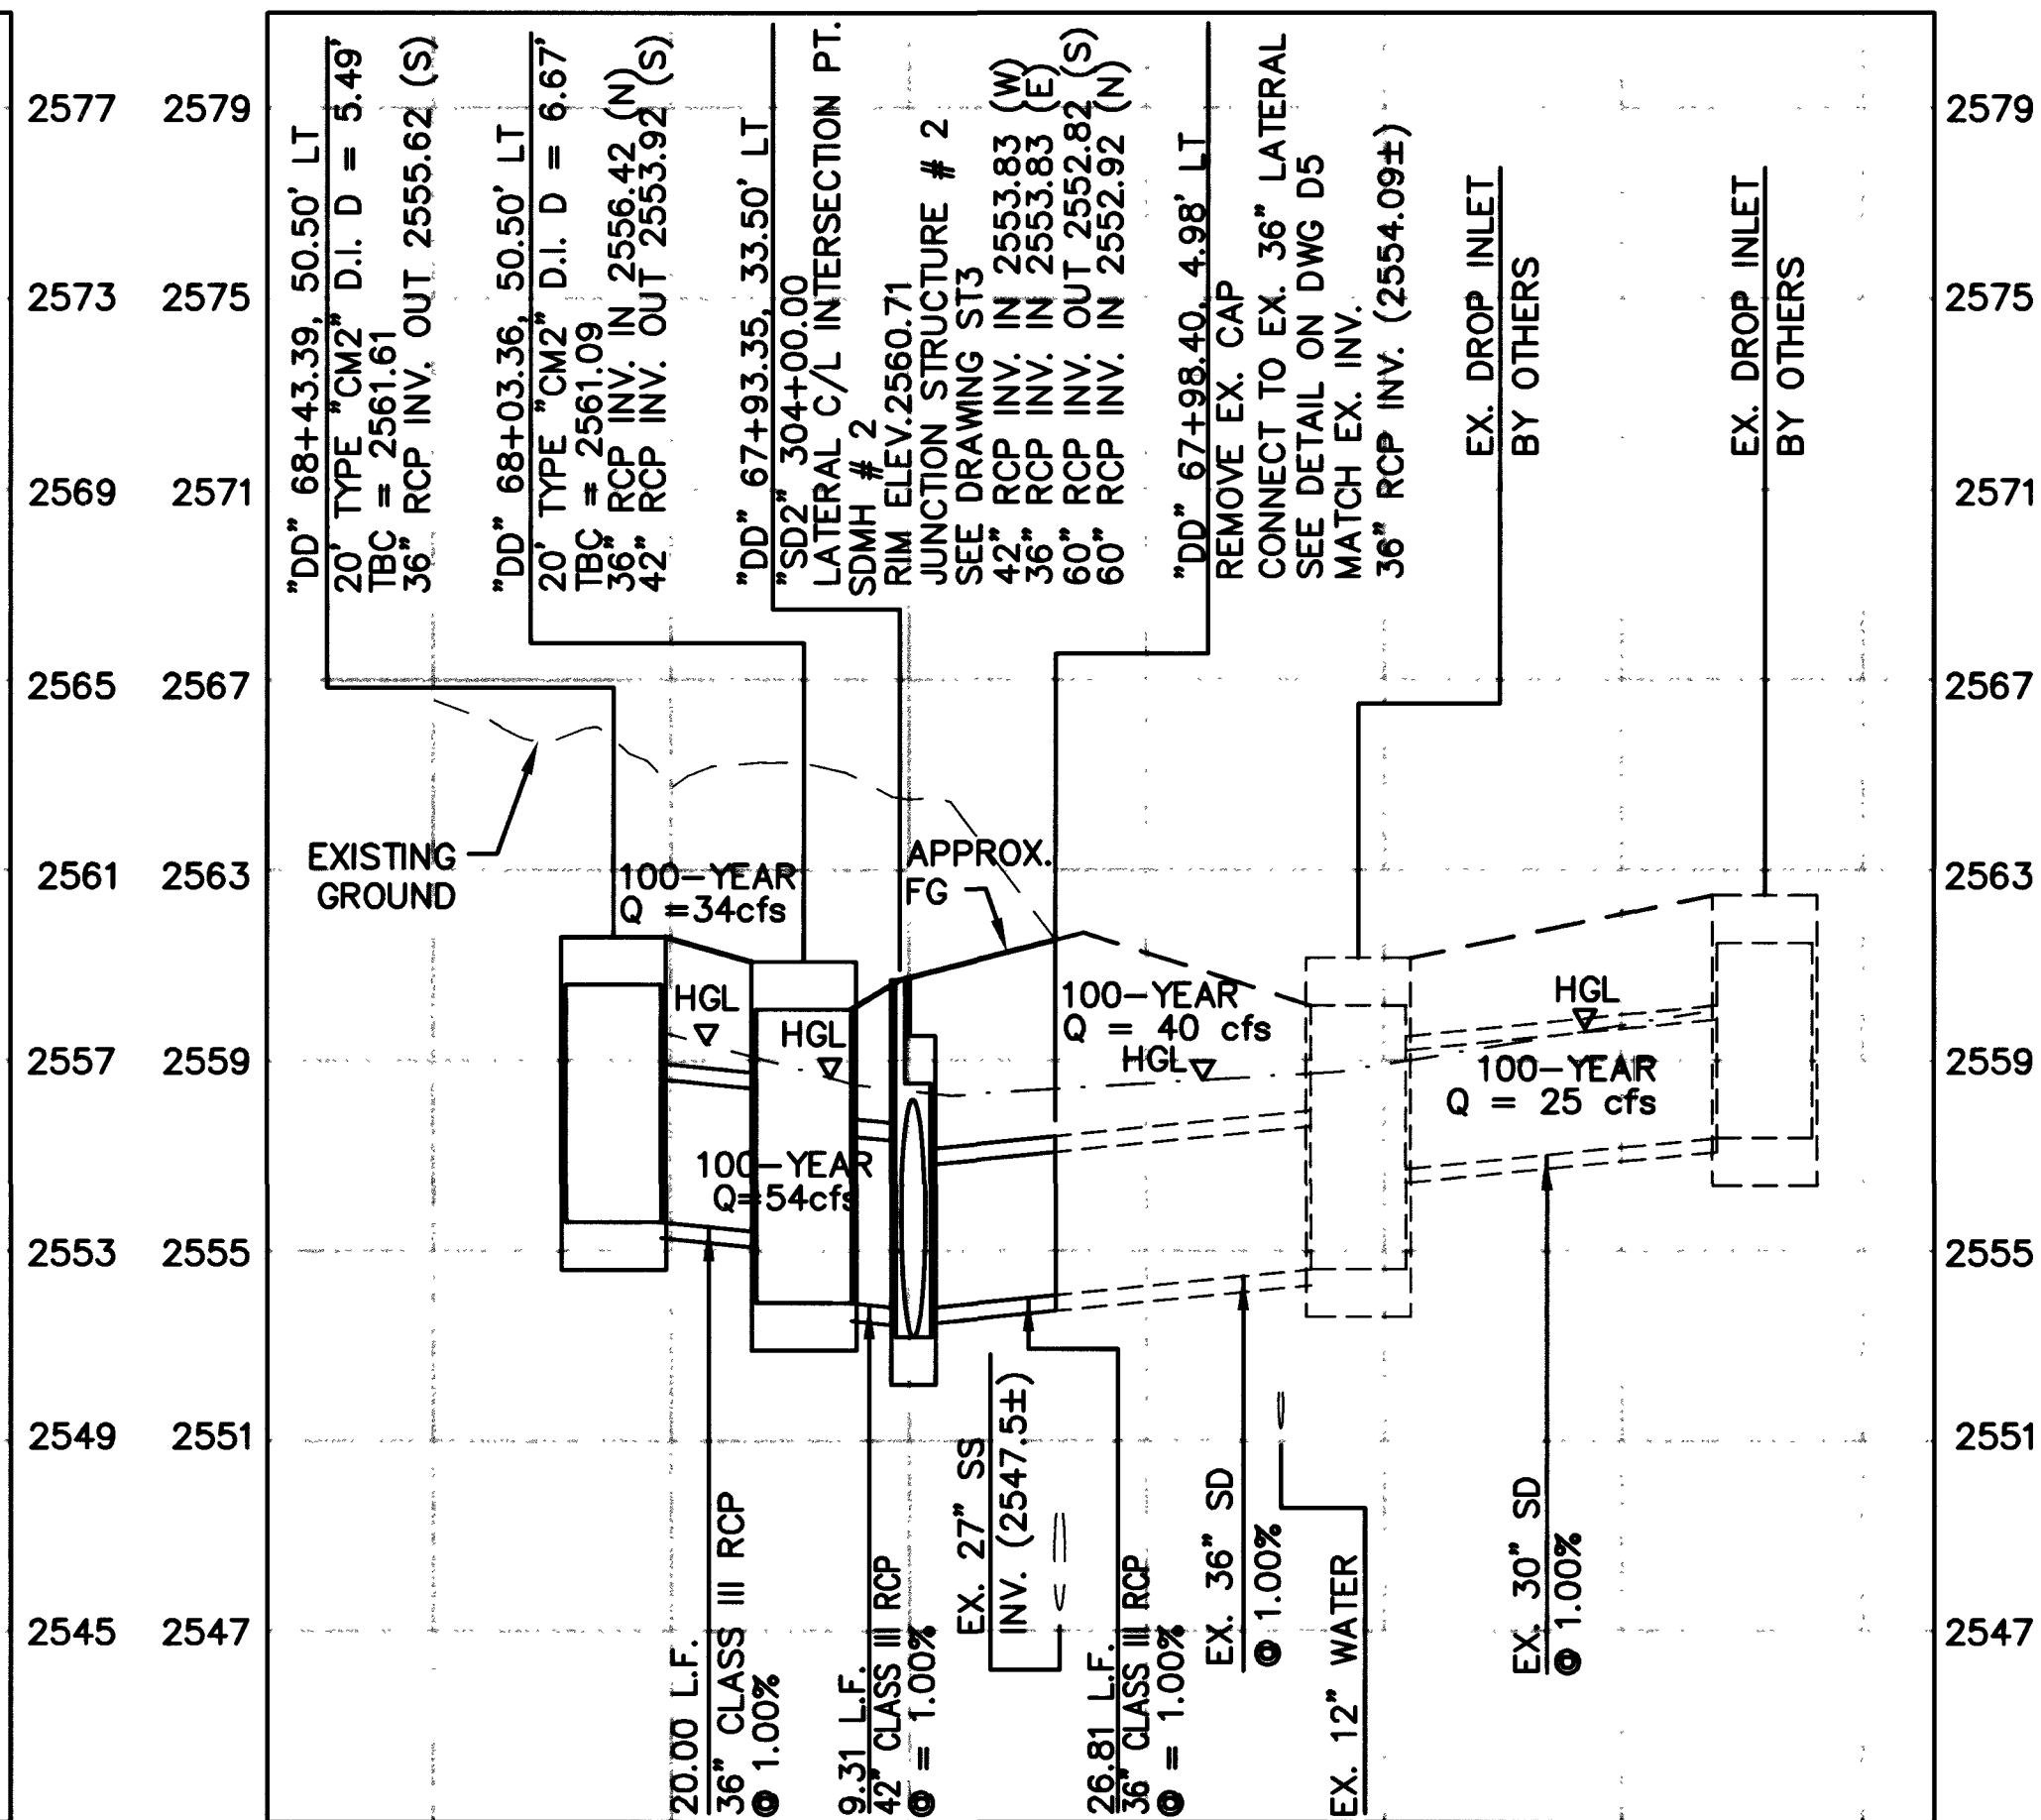


3 "DD" 67+91.53, 33.50' LT

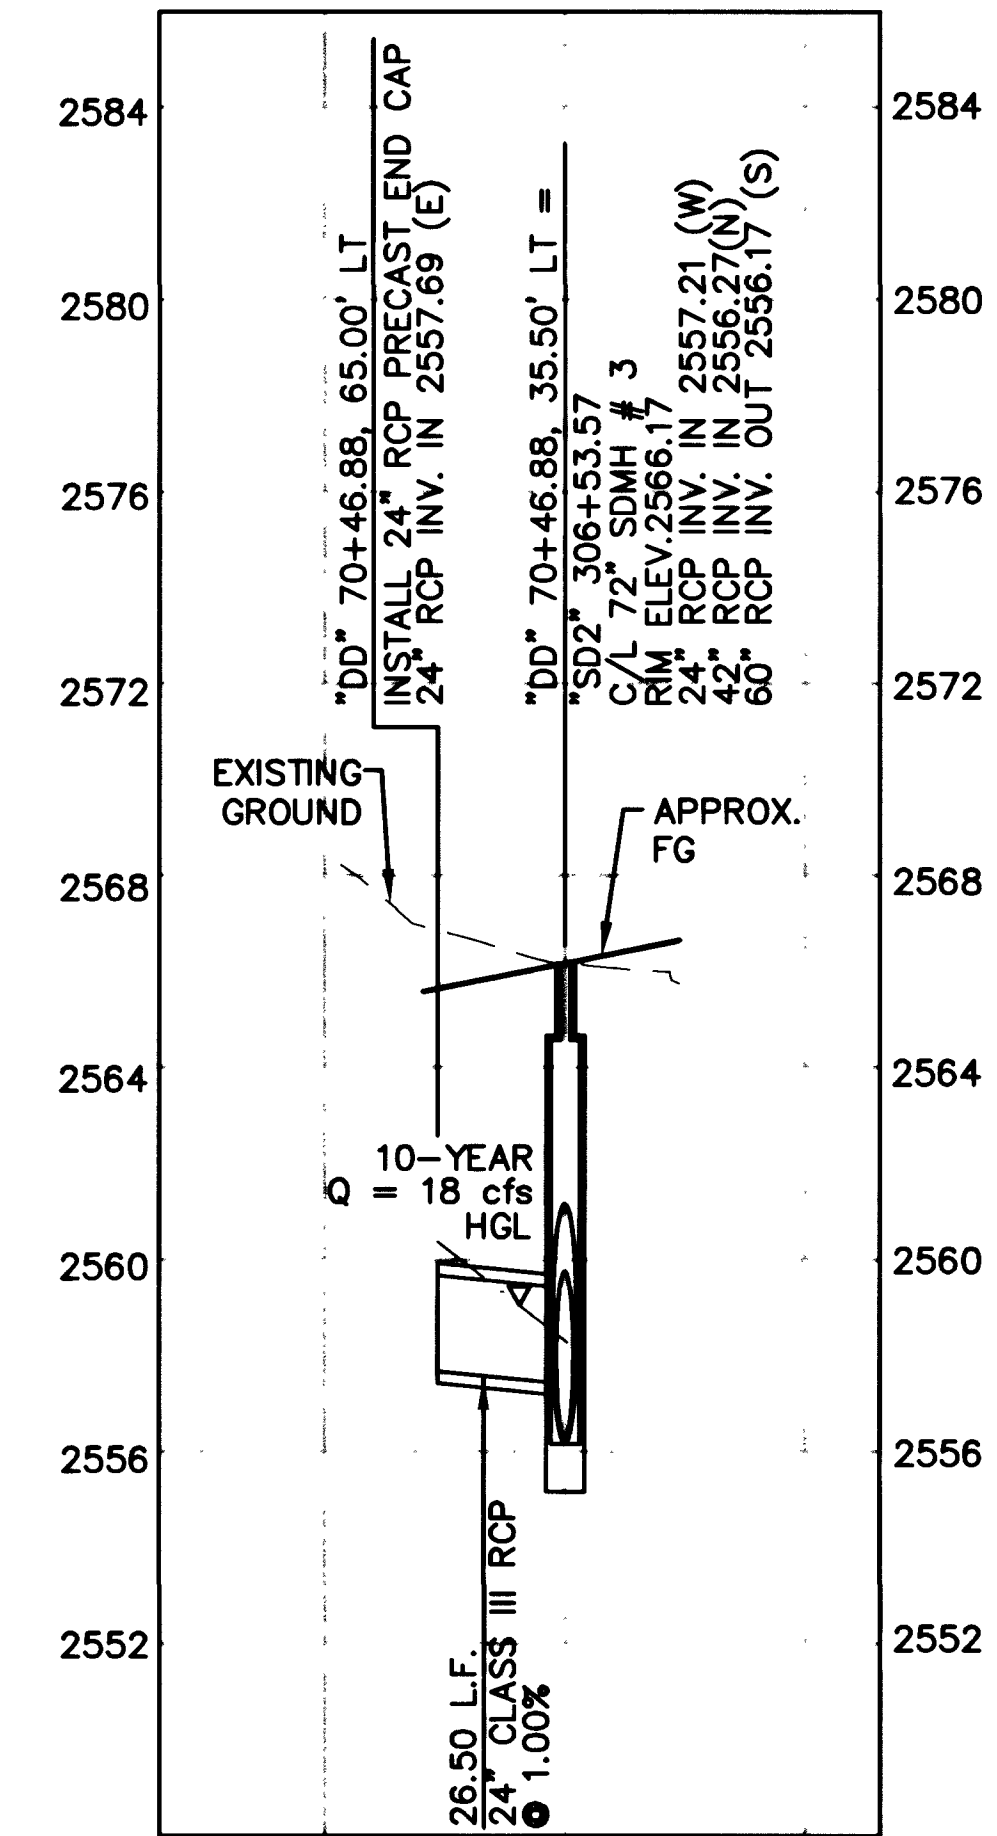


4 "DD" 70+46.88, 65.00' LT

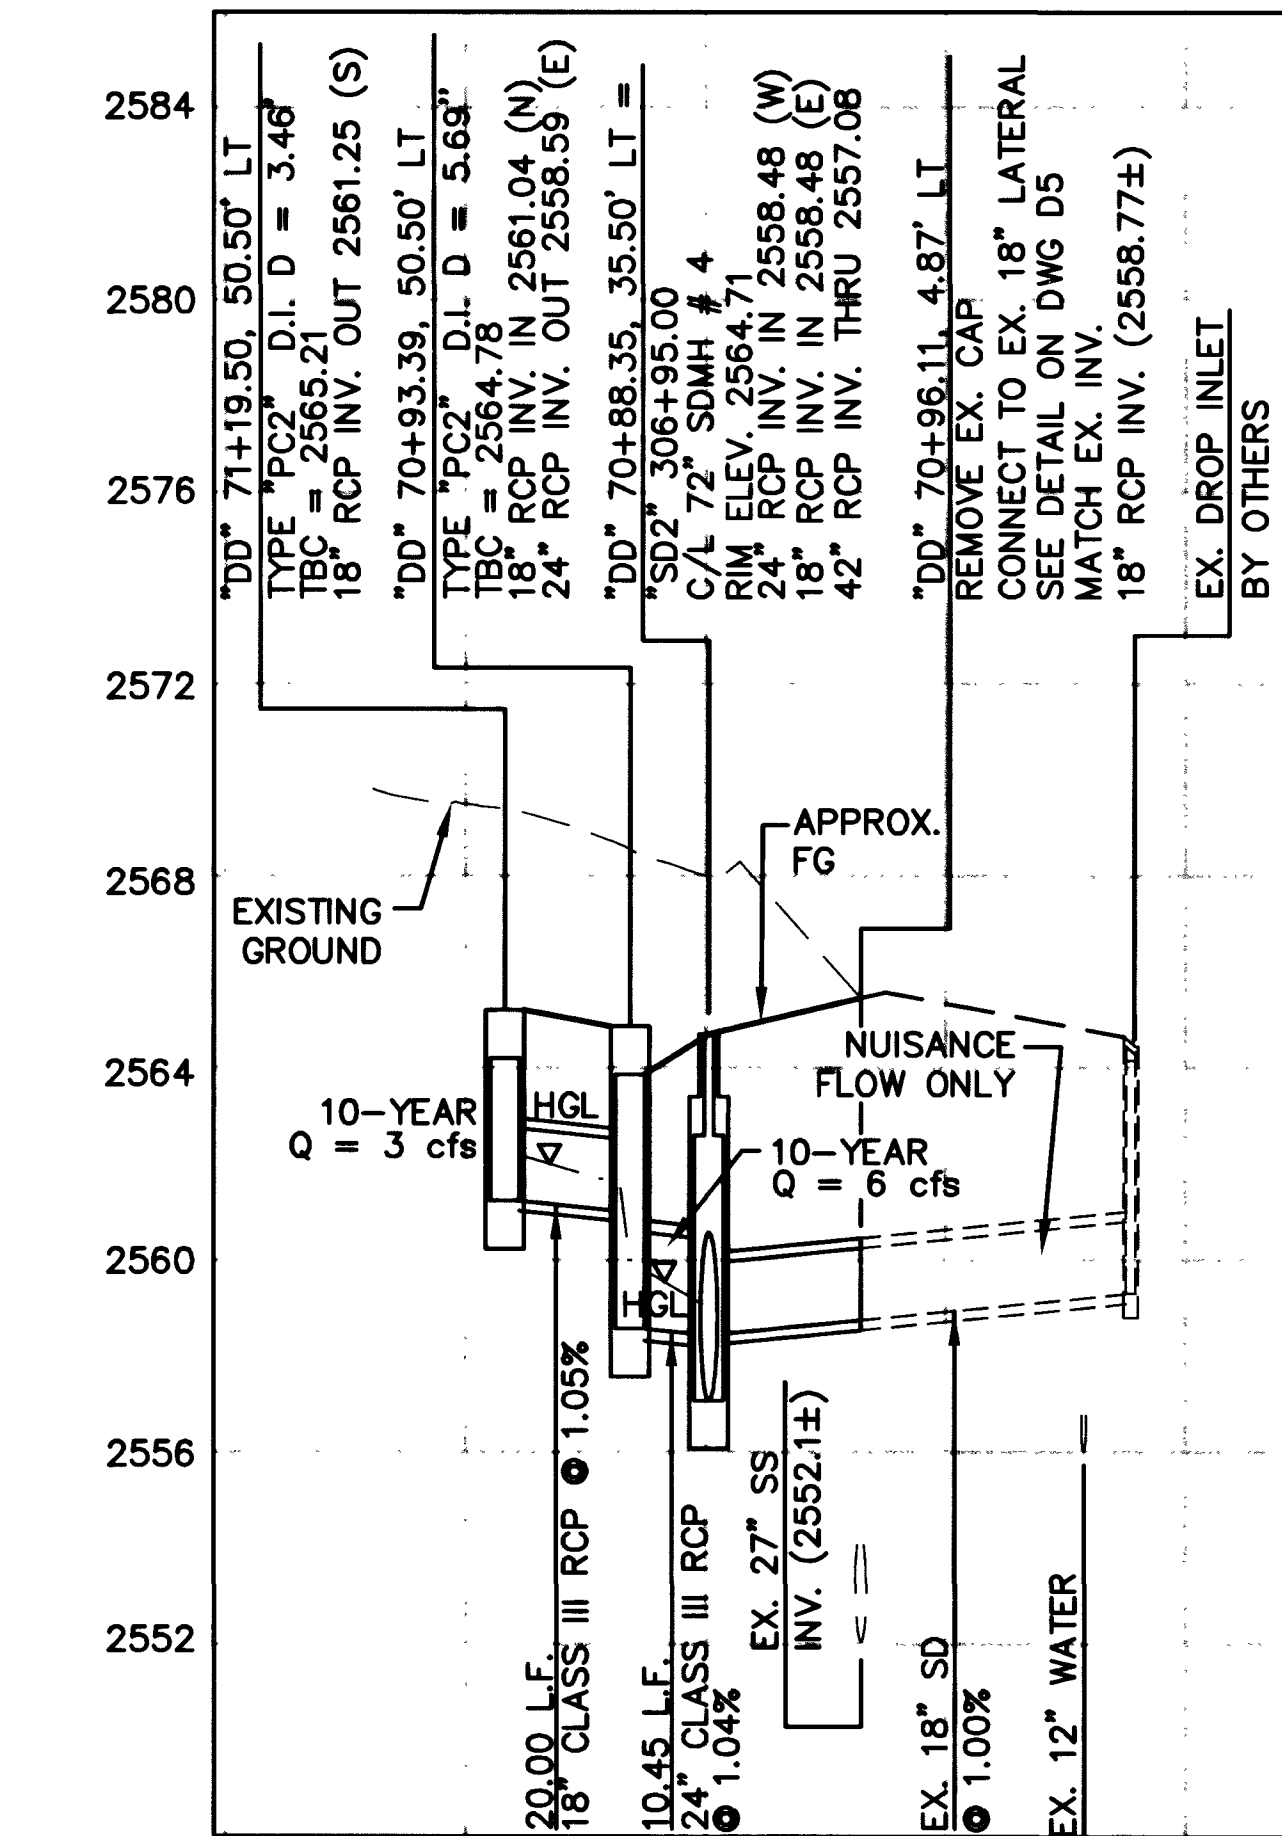

5 "DD" 70+88.35, 35.50' LT

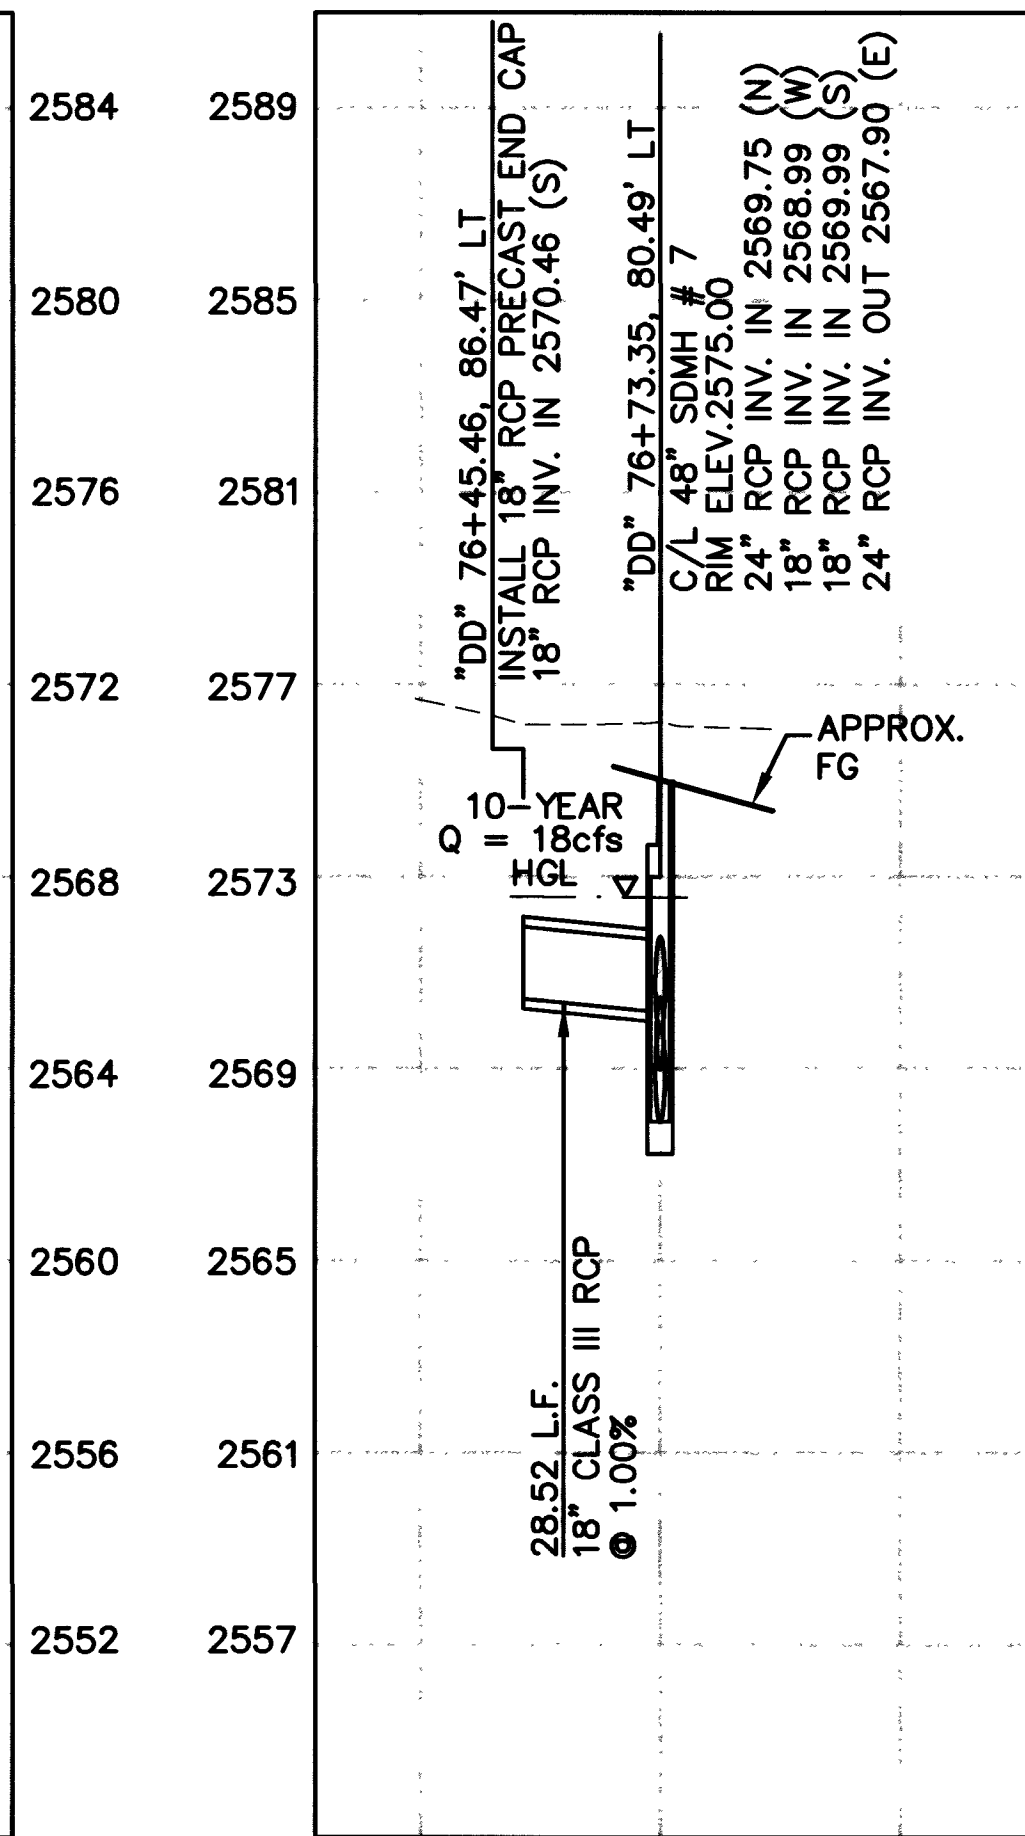

6 "DD" 76+73.35, 80.49' LT

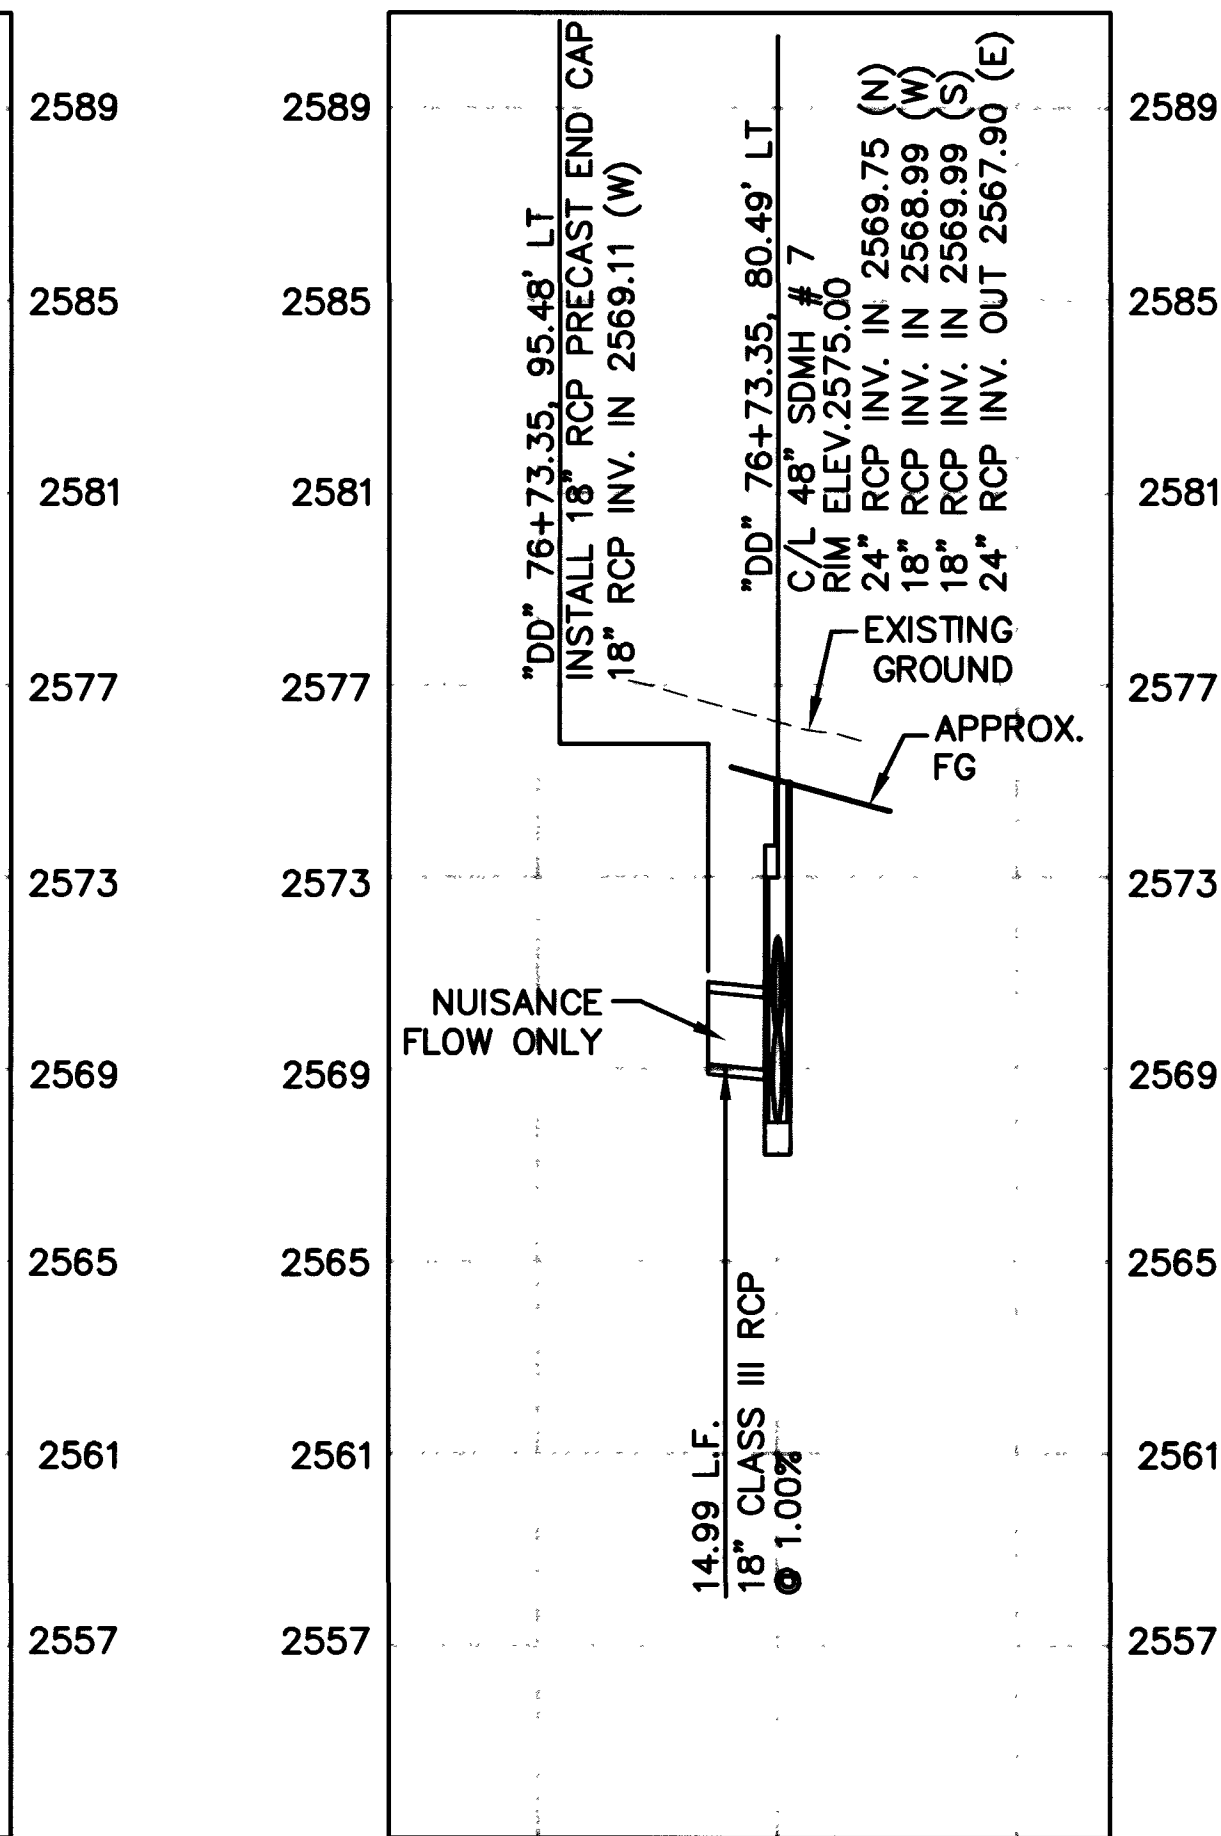

7 "DD" 76+73.35, 80.49' LT

NOTES

1. SEE DRAWING 12 FOR GENERAL NOTES.
2. SEE DRAWING D1 FOR STORM DRAIN MANHOLE AND DROP INLET SCHEDULE.
3. CONTRACTOR SHALL VERIFY ALL HORIZONTAL AND VERTICAL LOCATIONS OF EXISTING UTILITIES PRIOR TO COMMENCEMENT OF CONSTRUCTION.

APPROVED	
LAS VEGAS VALLEY WATER DISTRICT	DATE

2 working days
Call before you Dig
1-800-227-2600
Underground Service Alert (U.S.A.)


2 working days
Call before you Overhead
1-702-593-6111
Nevada Power Environment and Safety Services Department

STORM DRAIN LATERAL PROFILES

ORIGINAL CONSTRUCTION DRAWINGS ARE ON FILE WITH THE CITY OF LAS VEGAS. THE DOCUMENTS WERE SEALED ON 12/7/02 BY KEN D. GILBRETH UNDER LICENSE NO. 9177

WO. NO. 5878
DESIGNED BY JPL
DRAWN BY BAH, TMM
DATE 11/27/02
SCALE HORIZ. 1" = 40'
VERT. 1" = 4'
DRAWING SHEET 54 OF 80
SD9

DEPARTMENT OF PUBLIC WORKS
CITY OF LAS VEGAS

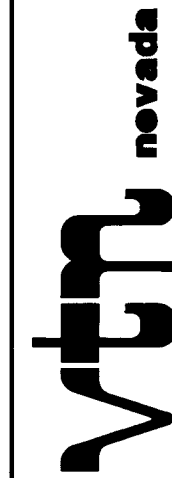

CONSULTING ENGINEERS • PLANNERS • LAND SURVEYORS
2727 SOUTH RAINBOW BOULEVARD
LAS VEGAS, NEVADA 89146-5148 PHONE (702) 873-7550 FAX (702) 362-2597

RECORD DRAWINGS INFORMATION SUPPLIED BY CONTRACTOR — DECEMBER 2003