



4 STA. 26+50.00 TO STA. 31+34.03
 SLOPE -2% - WEST
 SLOPE +2% - EAST

FOR MEDIAN ISLAND GEOMETRICS,
 SEE DWGS R12 THRU R16

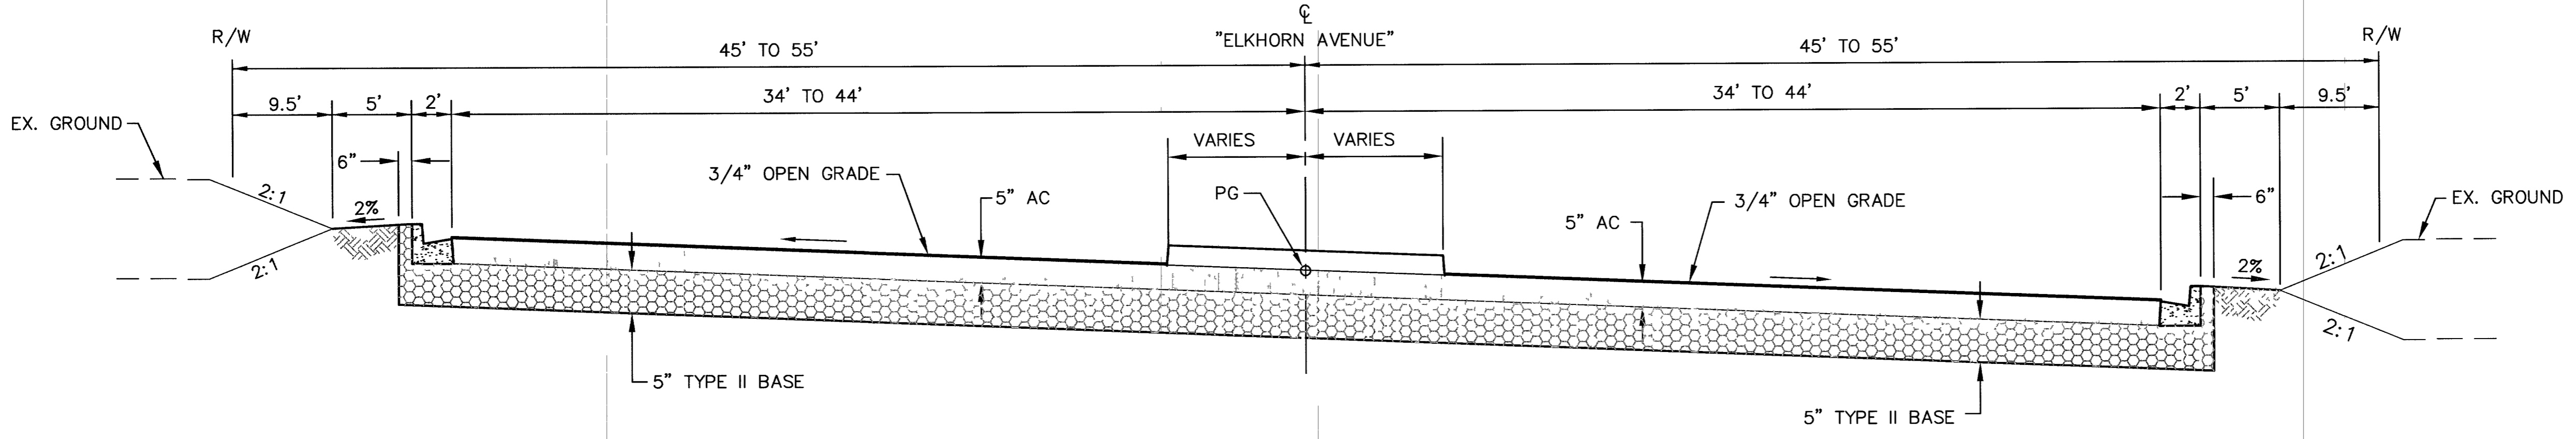

5 STA. 9+02± TO STA. 13+00.00
 SLOPE VARIES - NORTH, SEE PLAN
 SLOPE VARIES - SOUTH, SEE PLAN

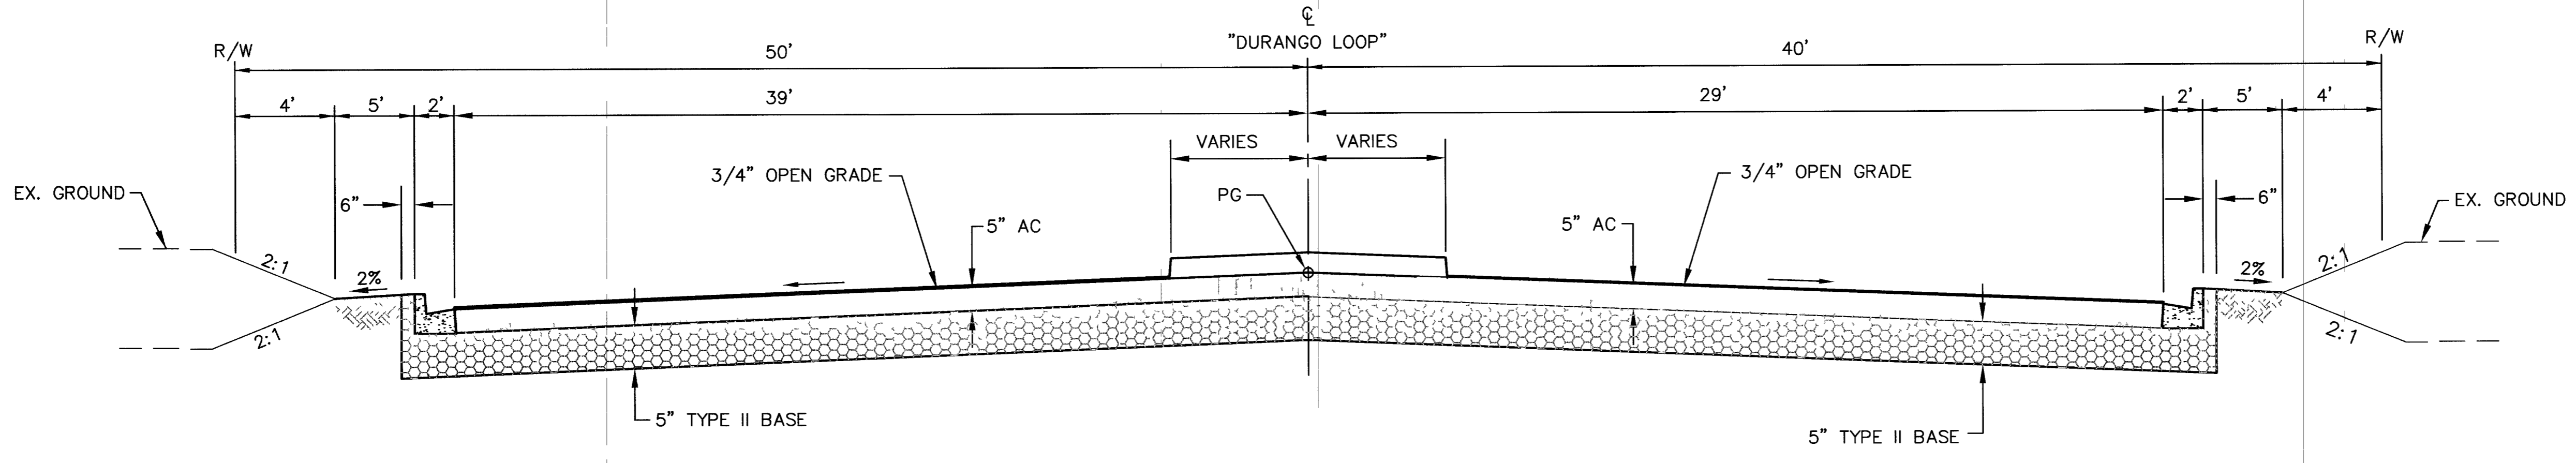

6 DURANGO LOOP RD. STA. 12+00.00 TO STA. 16+32.01
 SLOPE -2% ± - NORTH
 SLOPE +2% ± - SOUTH

VIEW = "D1"
 I:\CAD\PLIB\WKS\5678\5678-XSECT.DWG

84384

RECORD DRAWING INFORMATION AS PROVIDED BY TAB CONTRACTORS, INC.

REV	DATE	BY
1	10/19/05	CGM

DEPARTMENT OF PUBLIC WORKS
 CITY OF LAS VEGAS, NEVADA

CONSULTING ENGINEERS • PLANNERS • LAND SURVEYORS
 2727 SOUTH RAINBOW BOULEVARD
 LAS VEGAS, NEVADA 89146-5148 PHONE (702) 873-7550 FAX (702) 362-2597

vtm nevada

TITLE

TYPICAL X-SECTIONS

PROJECT

**DURANGO DRIVE IMPROVEMENTS
 TROPICAL PARKWAY TO I-215**

SEAL

ORIGINAL CONSTRUCTION DRAWINGS ARE ON FILE WITH THE CITY OF LAS VEGAS. THE DOCUMENTS WERE SEALED ON 12/5/05 BY KEN D GILBRETH UNDER LICENSE NO 9177

WO. NO. **5678**

BY **LMW**

DATE **12/05/03**

SCALE HORIZ. NO SCALE
 VERT. NO SCALE

DRAWING SHEET
TSS2 OF **7**
 SHEETS

RECORD DRAWINGS INFORMATION SUPPLIED BY CONTRACTOR - SEPTEMBER 2005